




WINDOW TYPE "A" JAMB
SCALE: 1/4" = 1'-0"

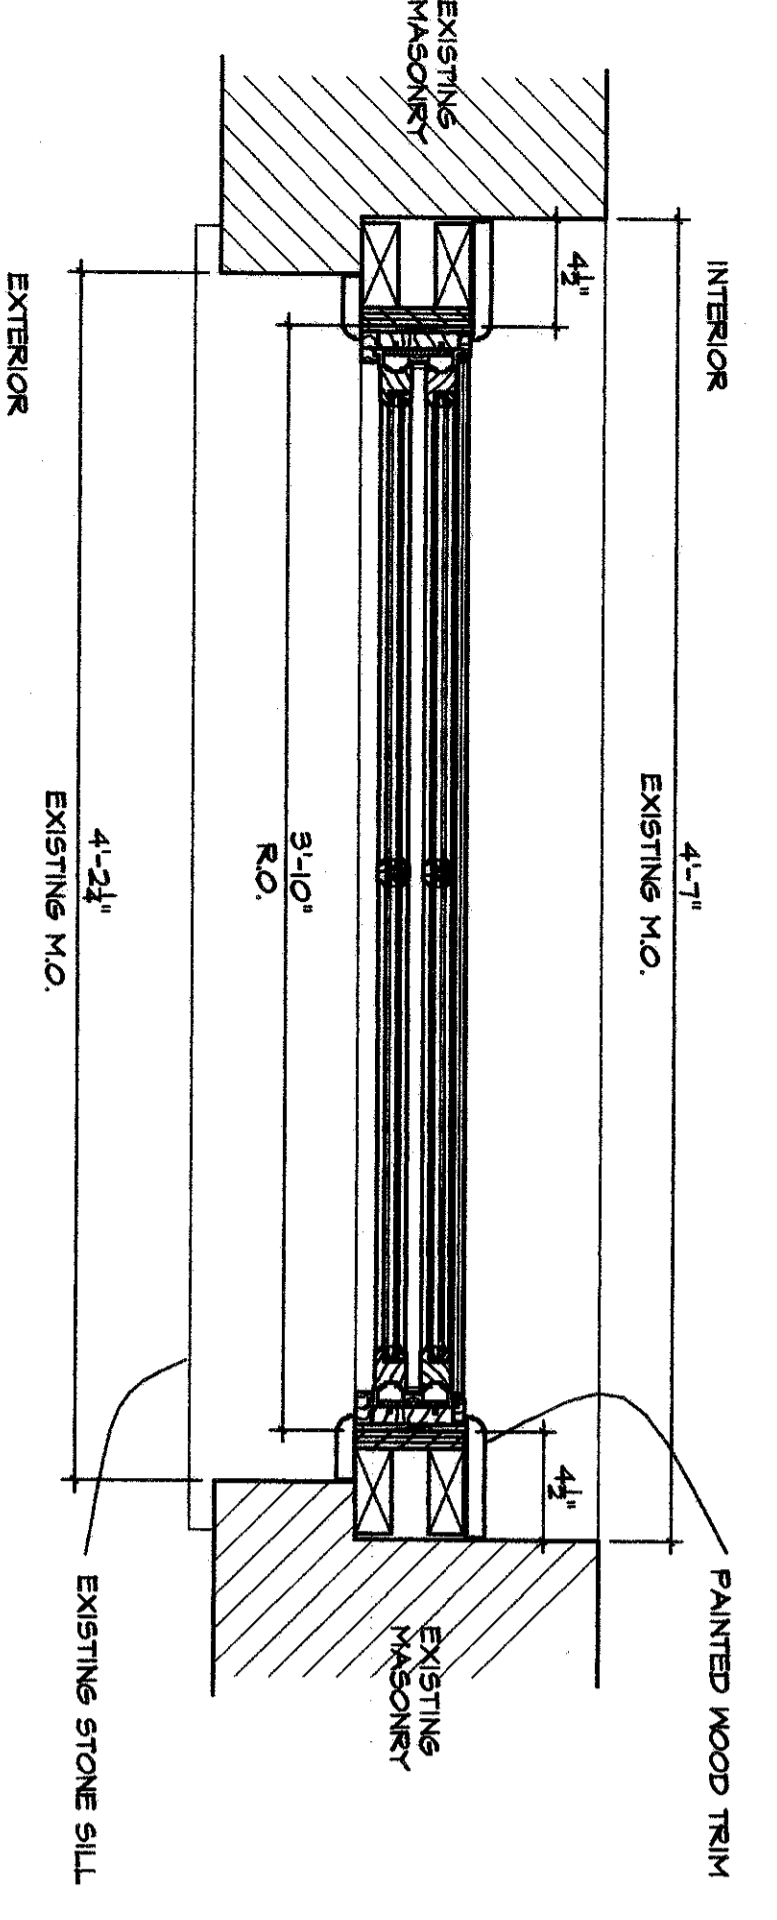


WINDOW TYPE "B" JAMB
SCALE: 1/4" = 1'-0"

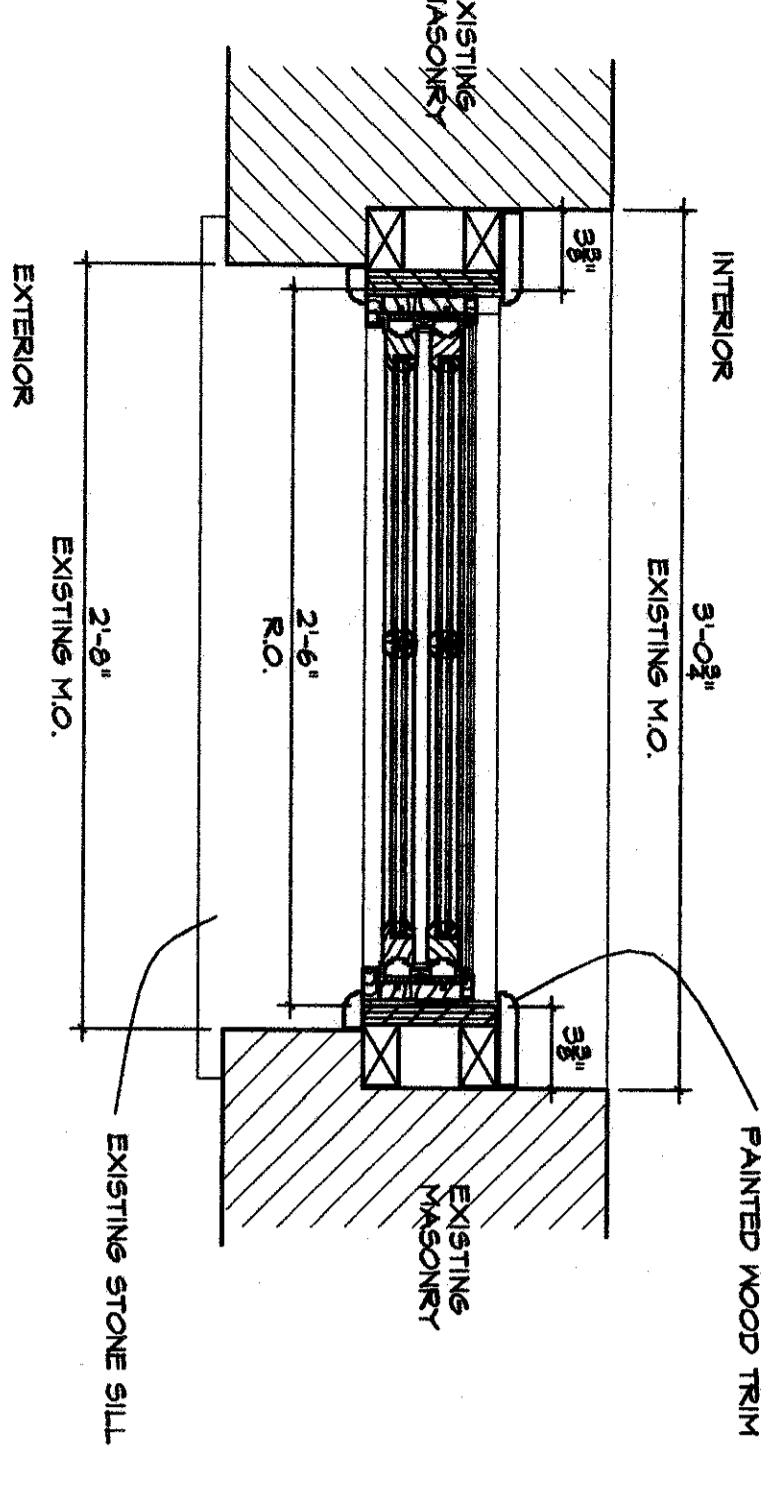






WINDOW TYPE "C" JAMB
SCALE: 1/4" = 1'-0"

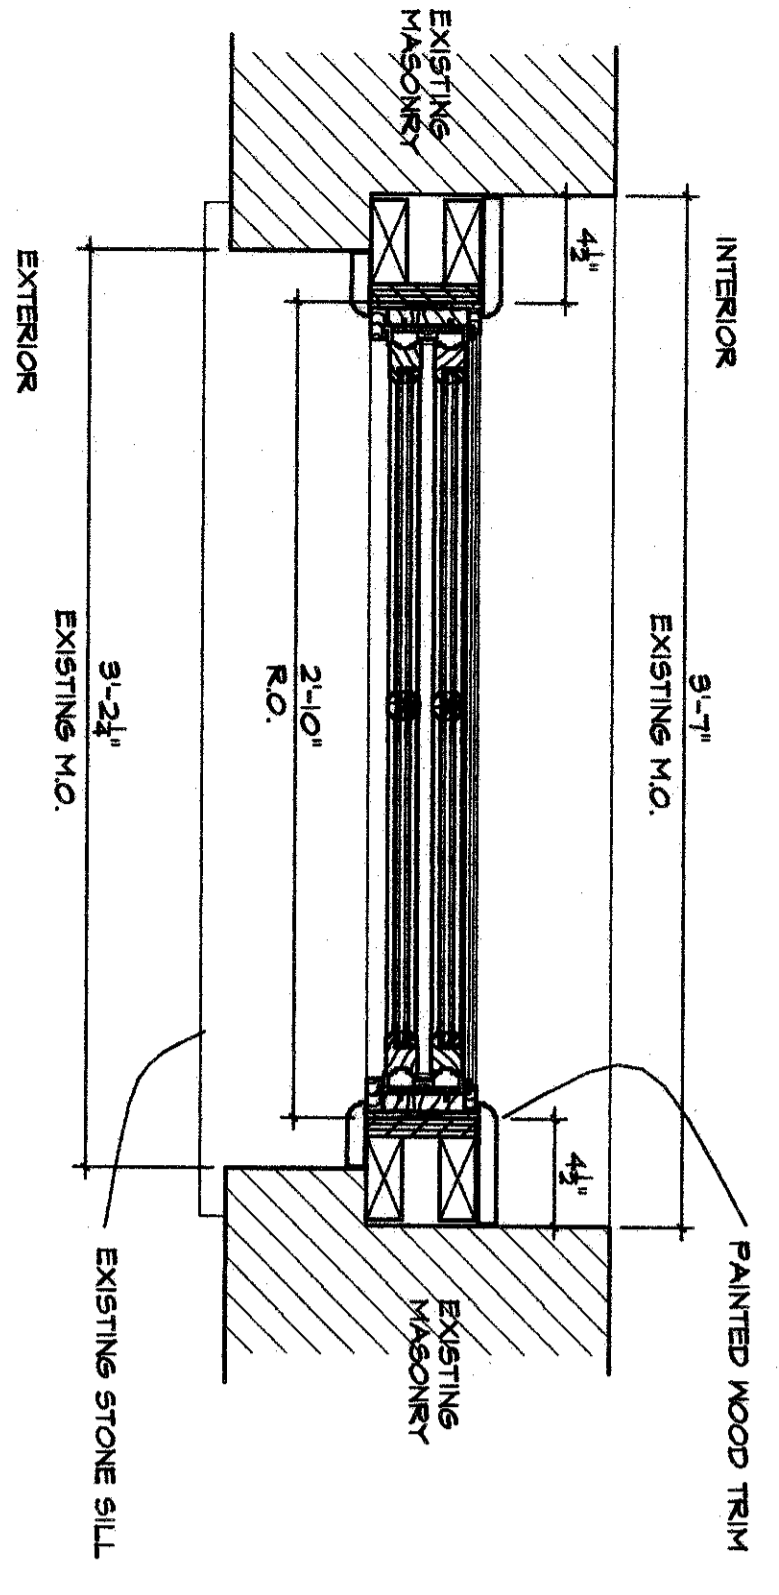


WINDOW TYPE "D" JAMB
SCALE: 1/4" = 1'-0"

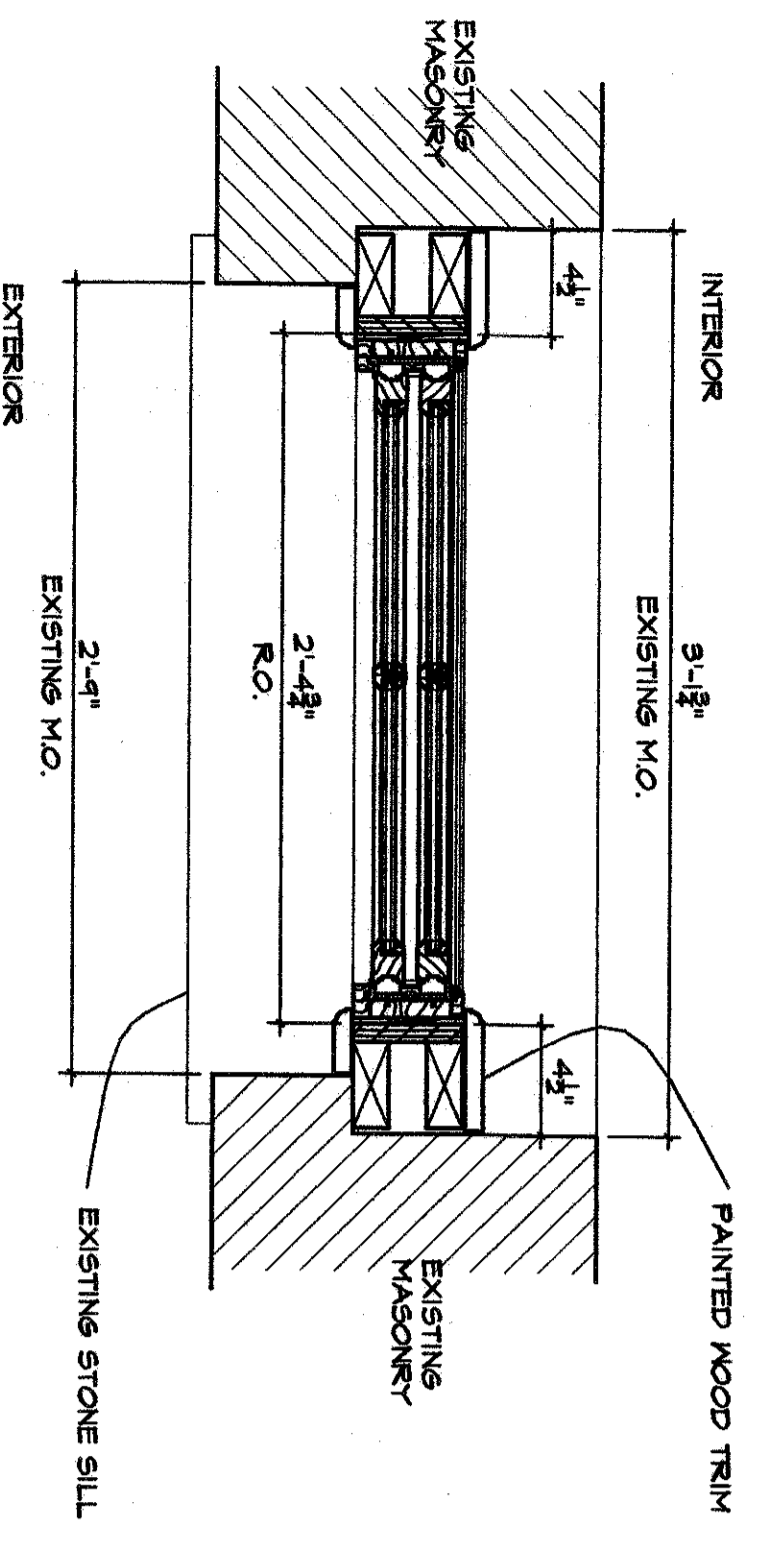

WINDOW TYPE "E" JAMB
SCALE: 1/4" = 1'-0"

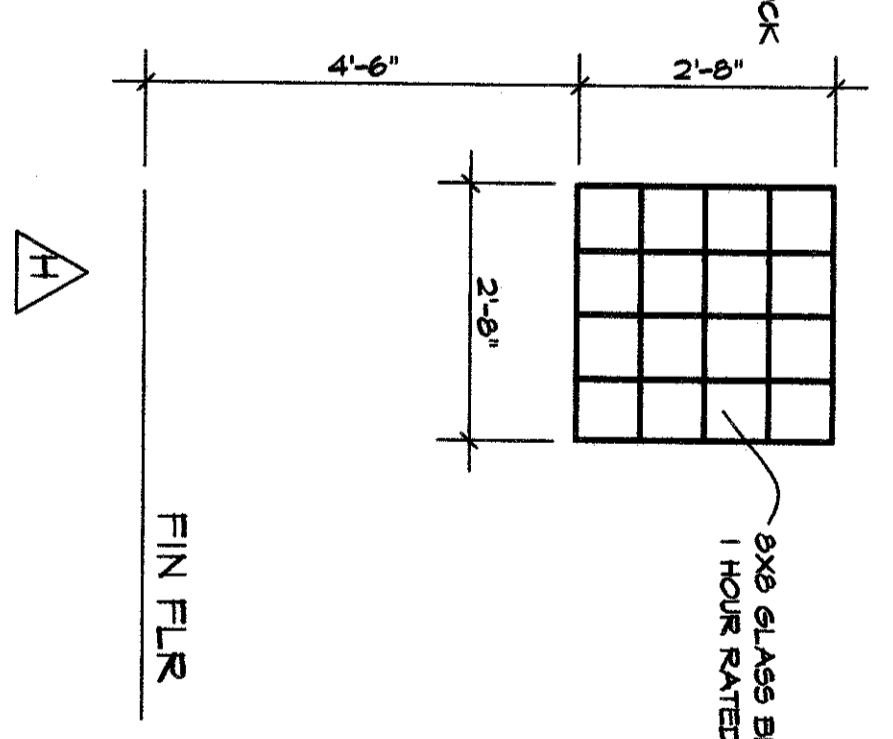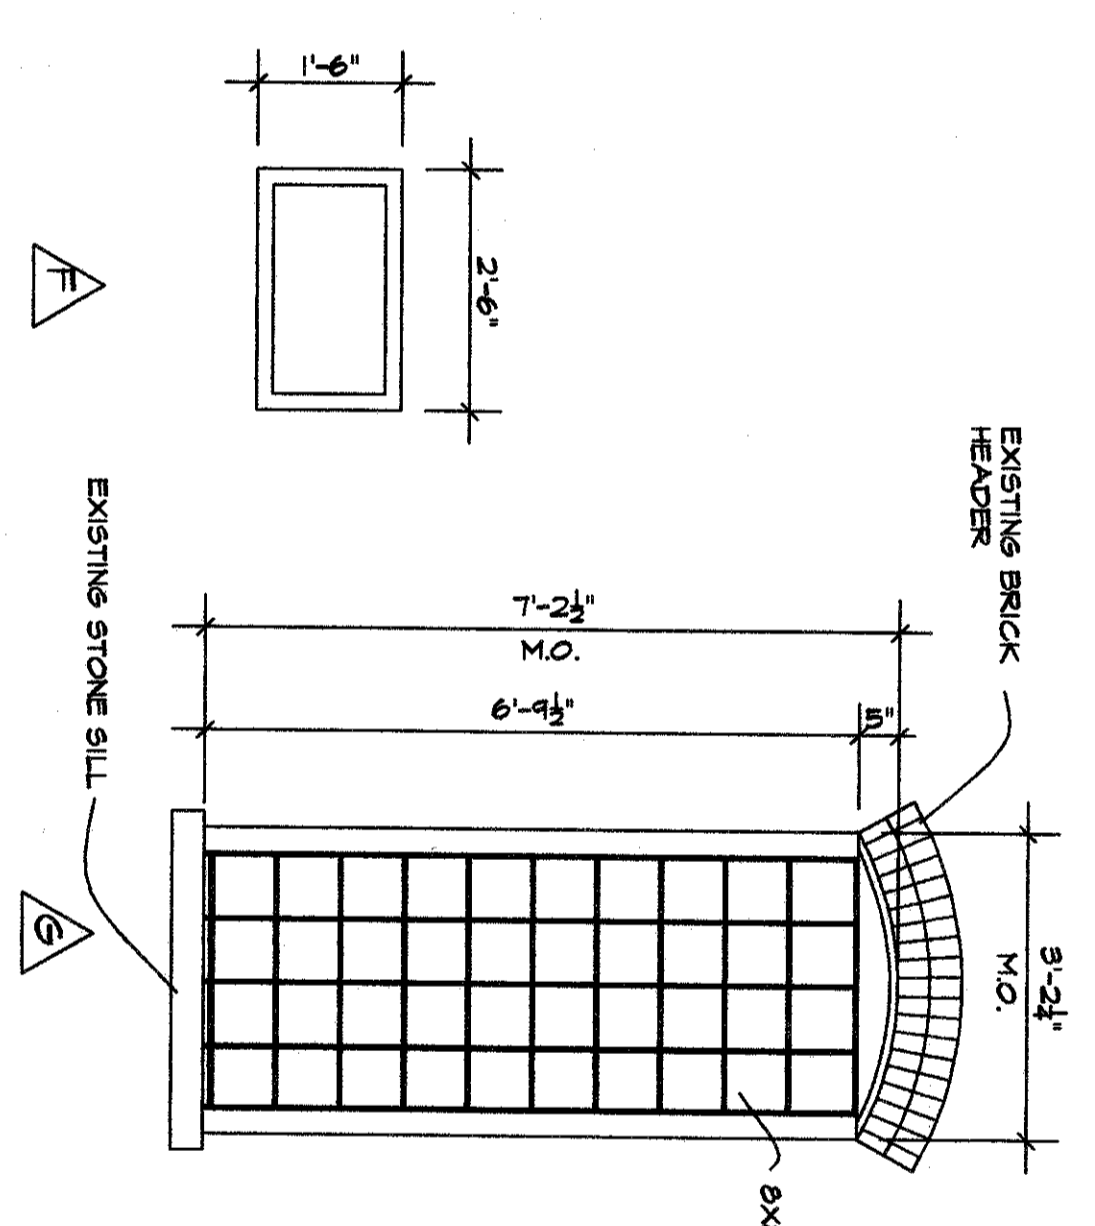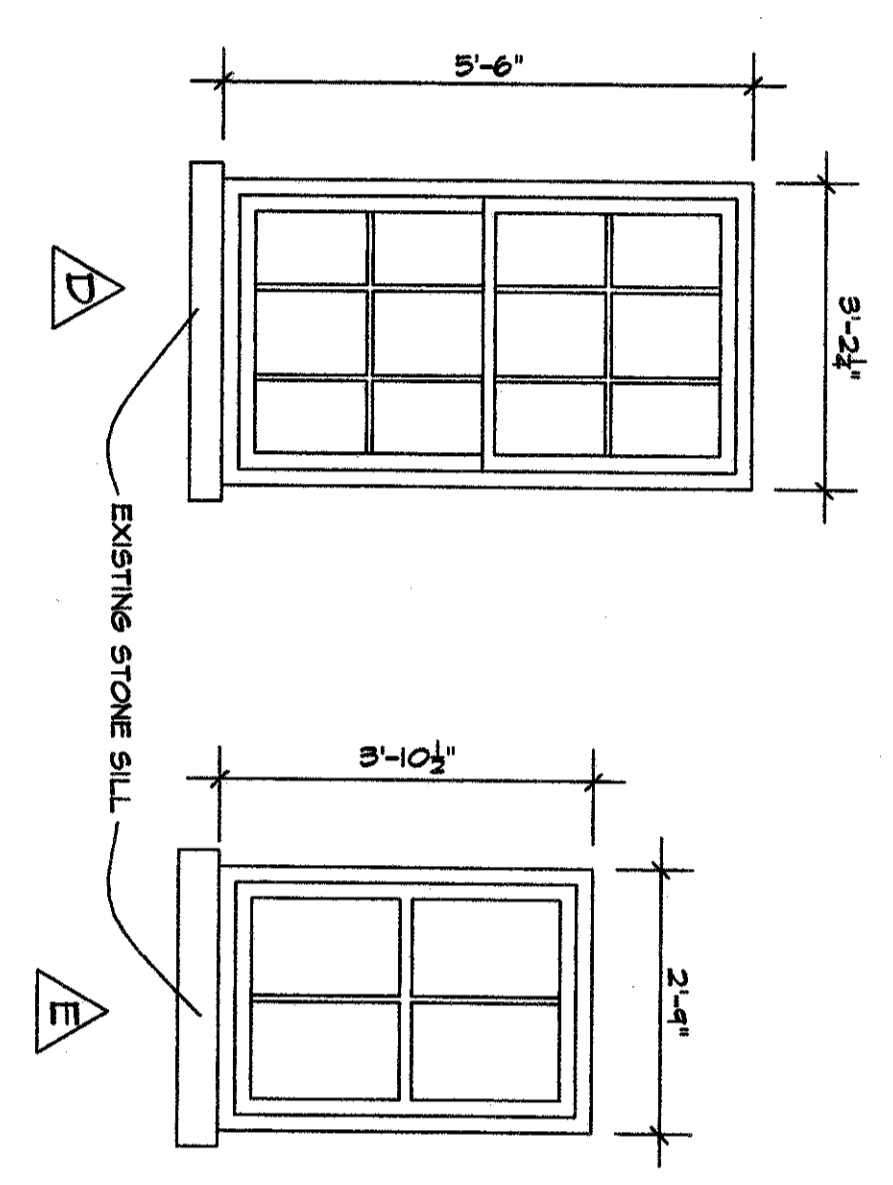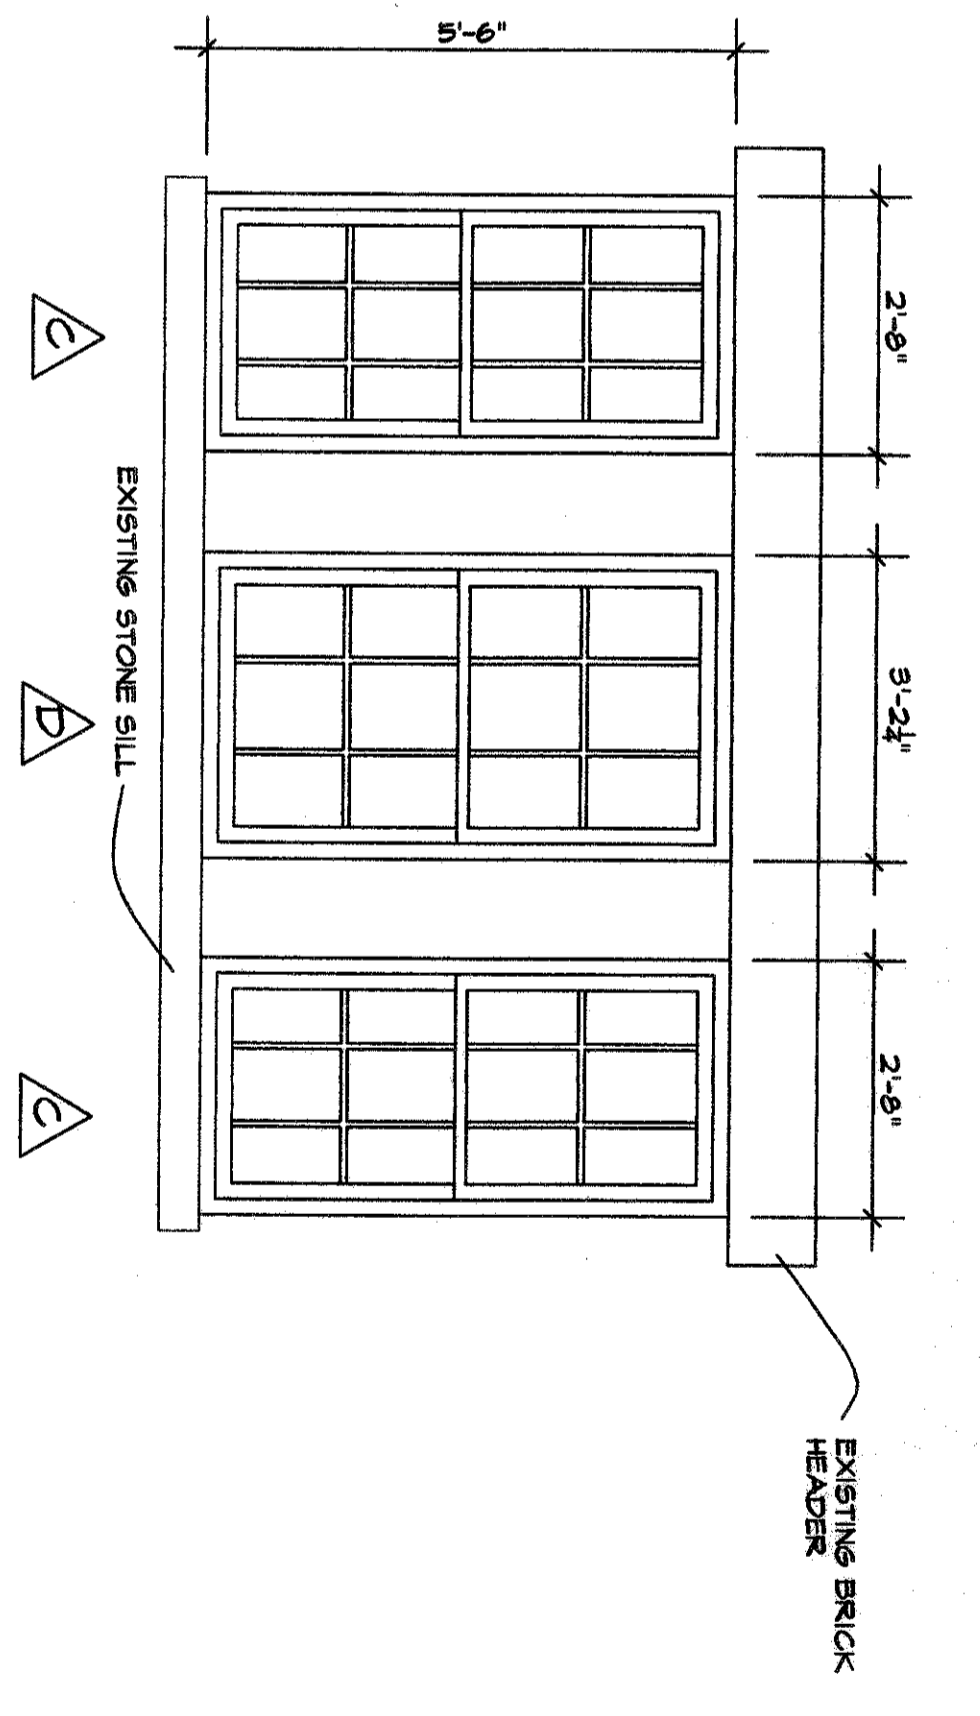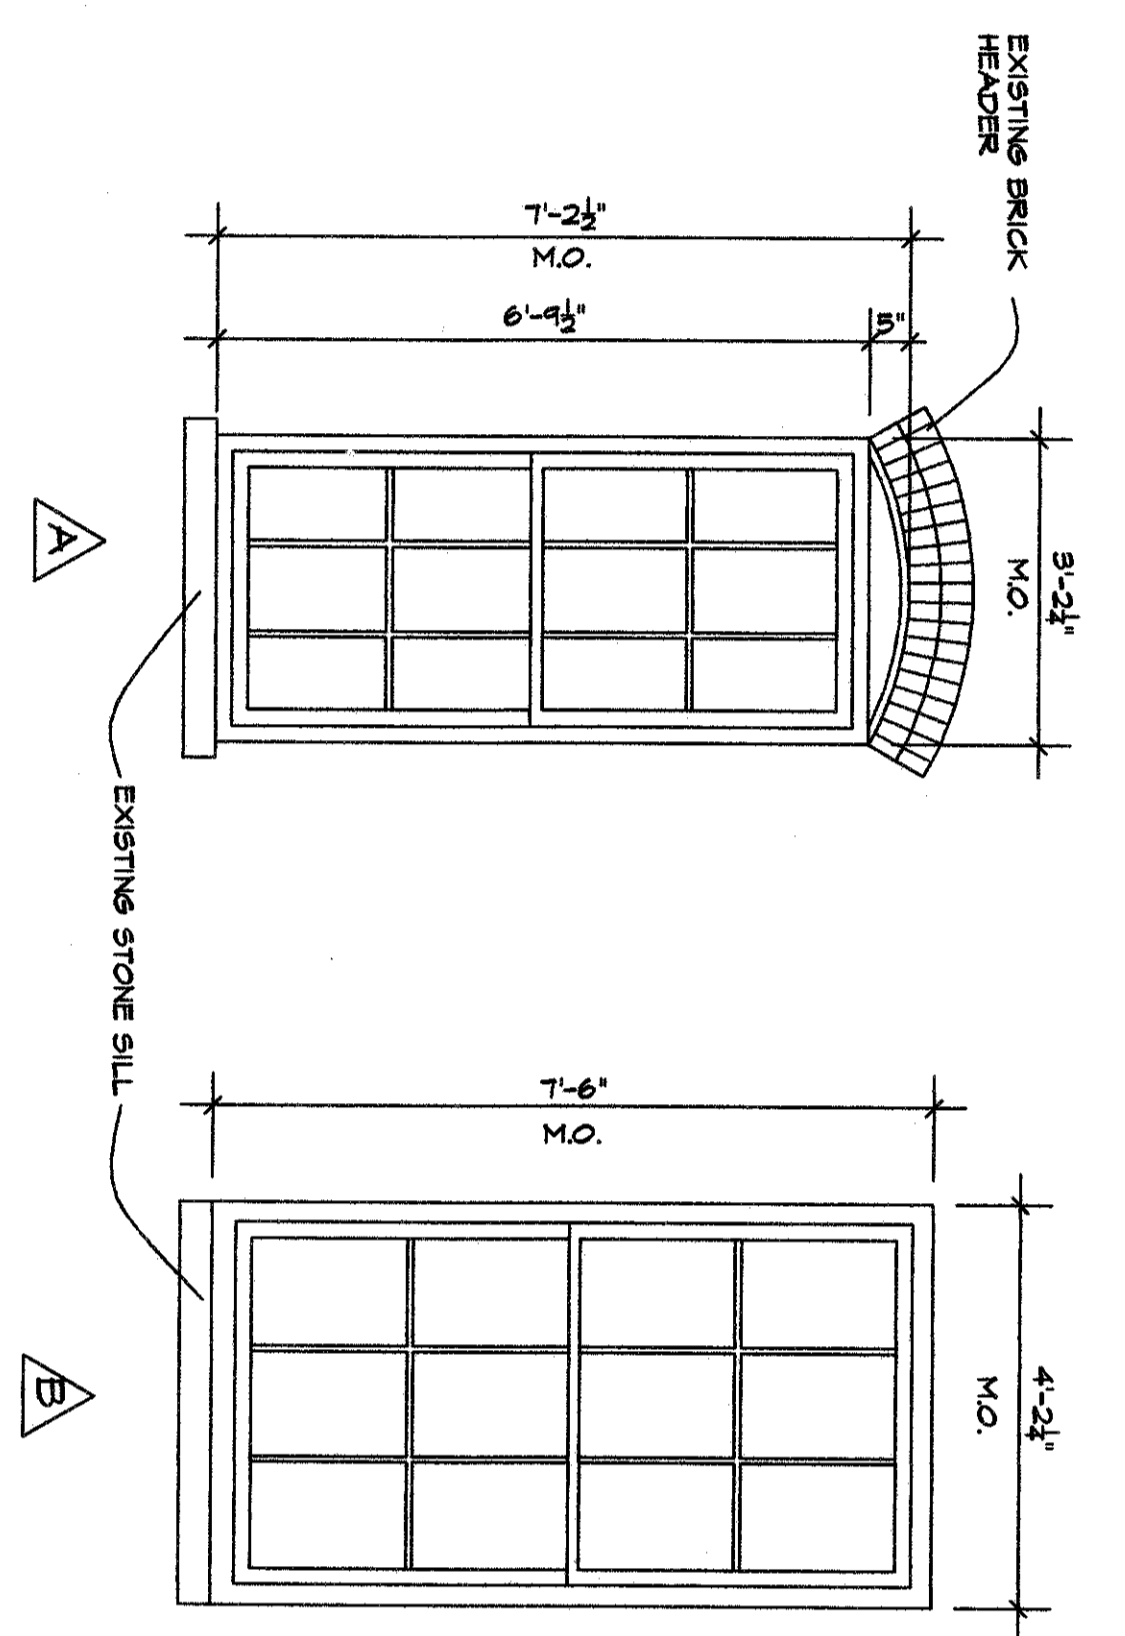

WINDOW TYPES

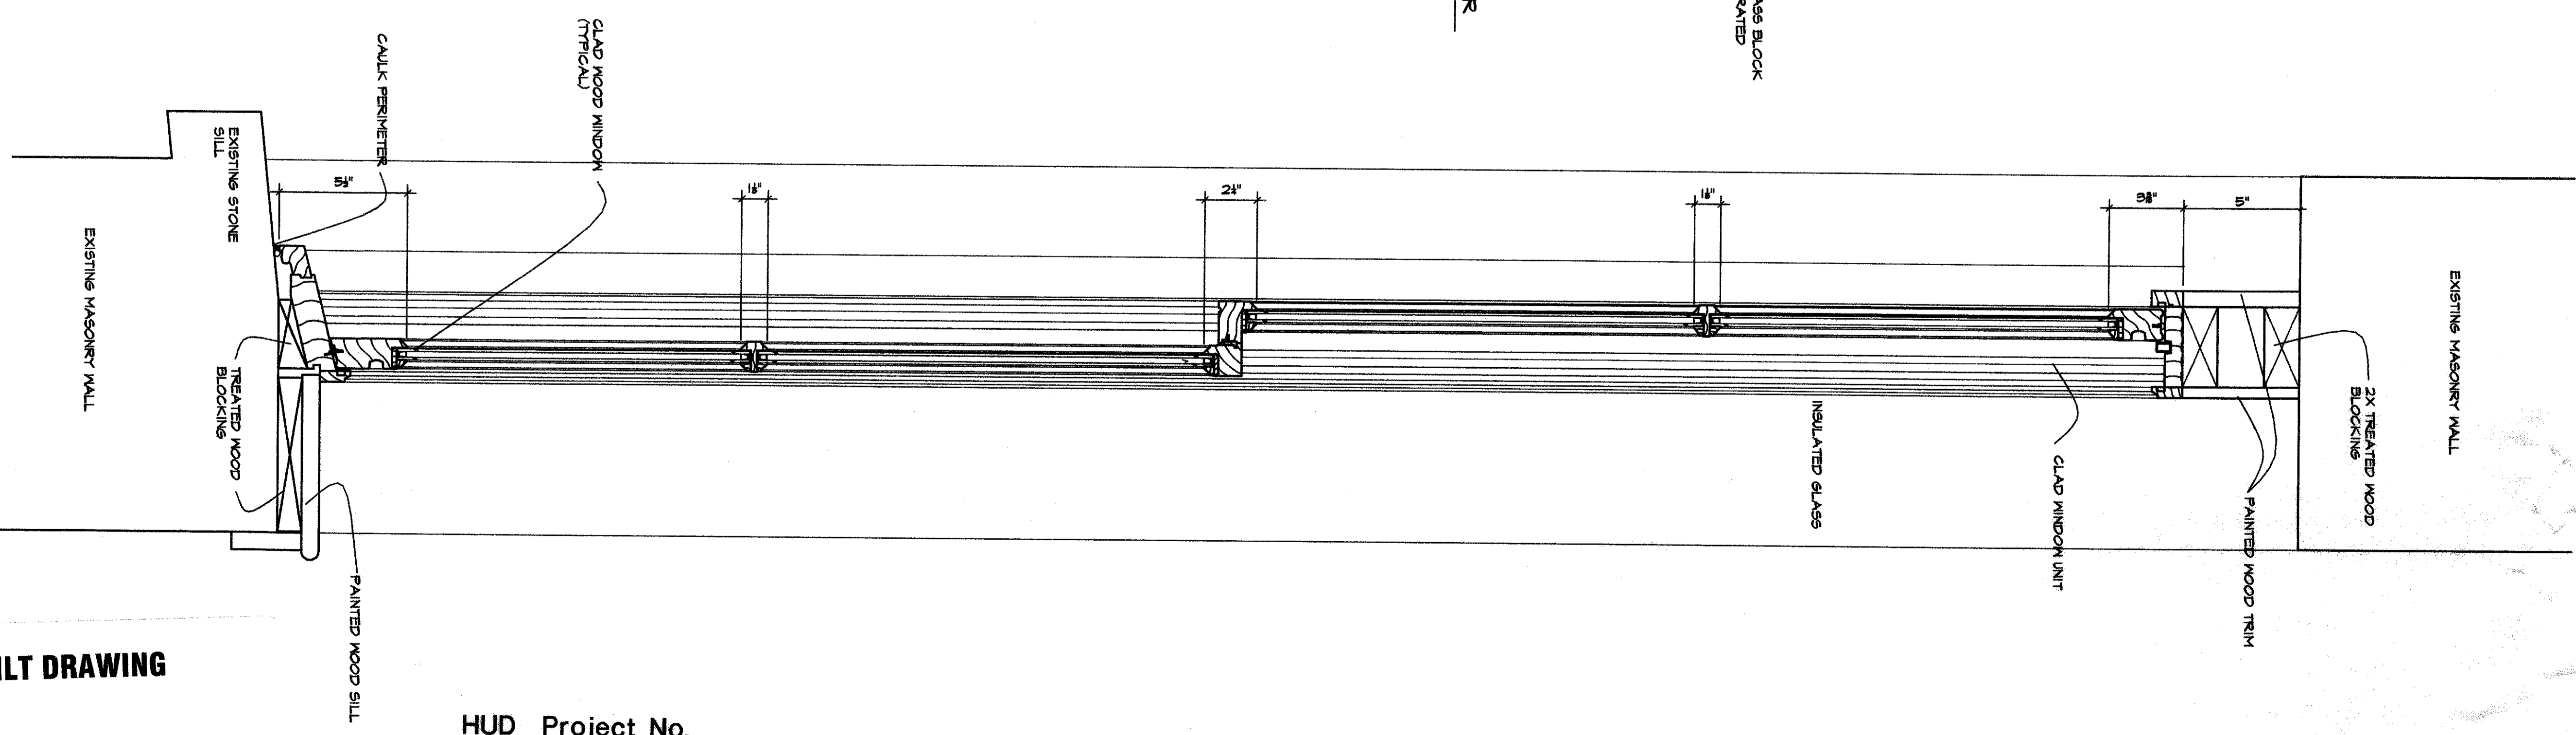

TYPICAL WINDOW SECTION
SCALE: 1/4" = 1'-0"

AS-BUILT DRAWING

HUD Project No.

SHEET NO. A-12

DATE	8/16/02
DRAWN BY	M.L.K.
REVISIONS	1/01/02
	8/29/04

PROJECT:	LEXINGTON LOFTS 200 BOLIVAR STREET LEXINGTON, KENTUCKY
DRAWING:	WINDOW SCHEDULE

The McGoodwin Company
Commercial Real Estate

HERRICK & ASSOCIATES
Consulting Engineers
859 271 0483 LEXINGTON KY
DESIGN-ENGINEERING
601 BROOKFARM COURT
LEXINGTON, KY 40517
O. DAVID PRESTON, P.E.

MICHAEL L. KNOLL
ARCHITECT
348 South Main Street
Versailles, Kentucky 40383
Phone: 858-873-1900
Email: 3mknoll@gte.net

