




FIRST FLOOR  
ENLARGED STAIR PLAN B  
SCALE: 1/4" = 1'-0"

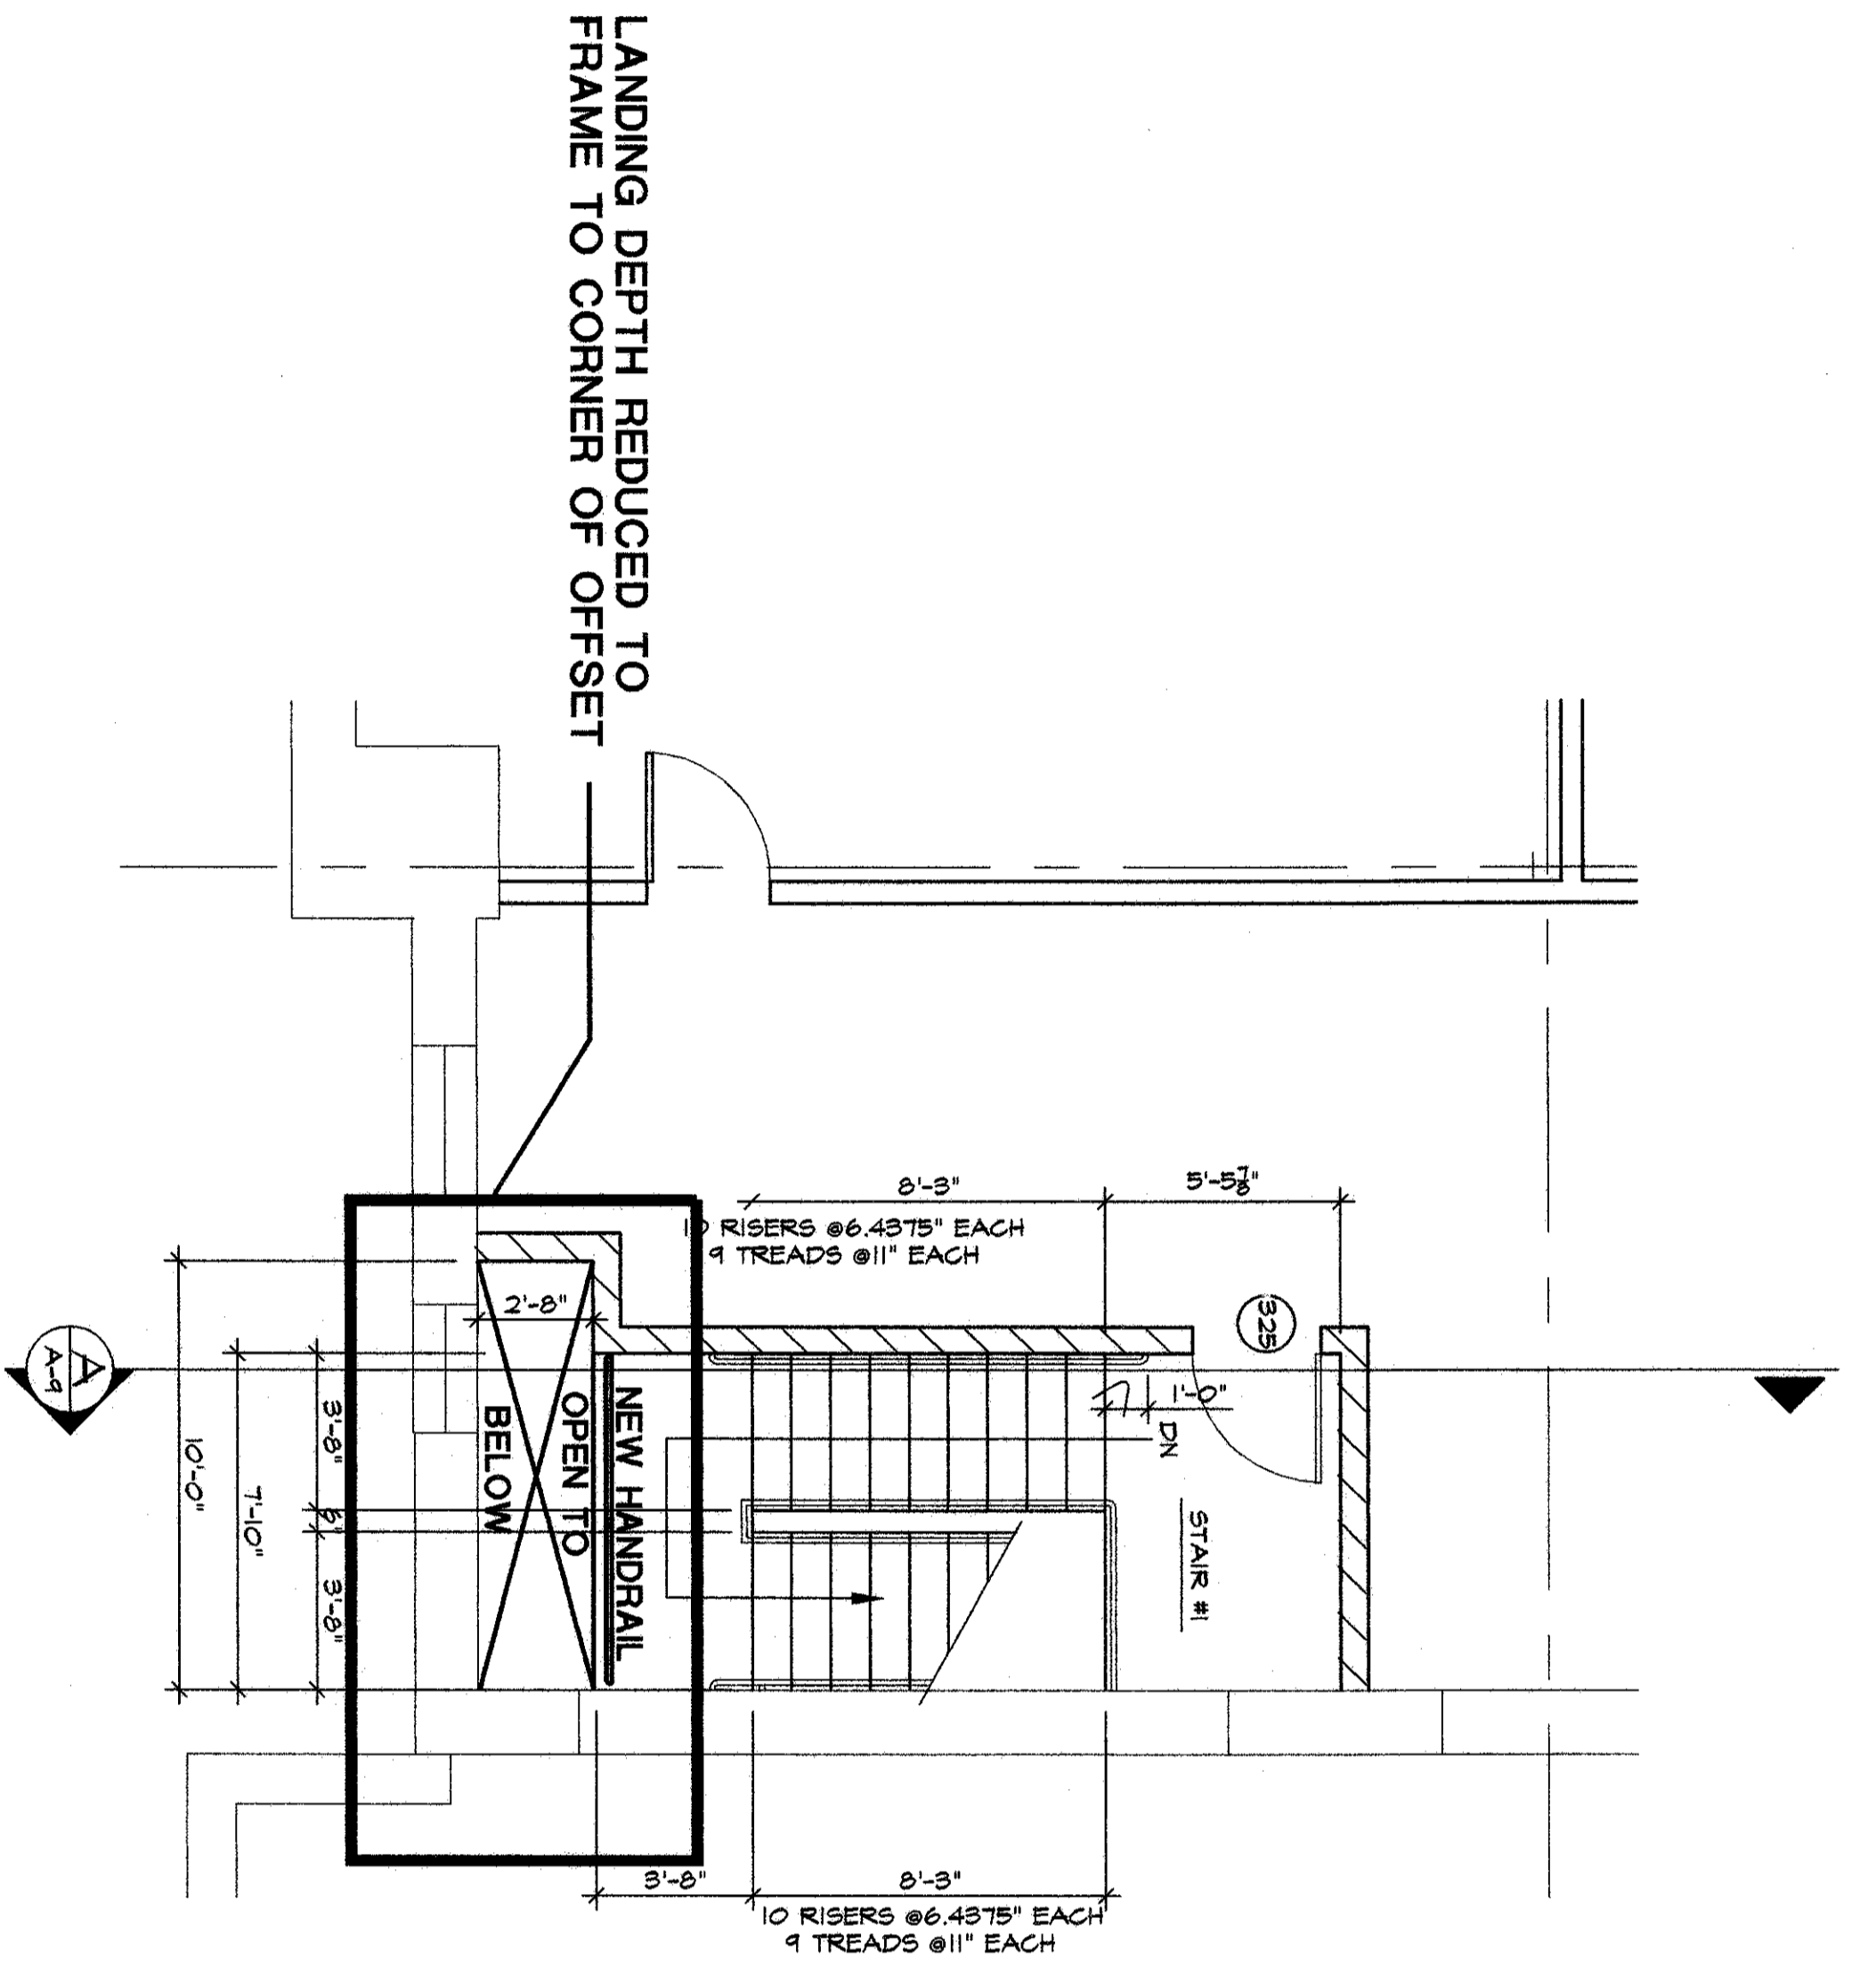


THIRD FLOOR  
ENLARGED STAIR PLAN D  
SCALE: 1/4" = 1'-0"

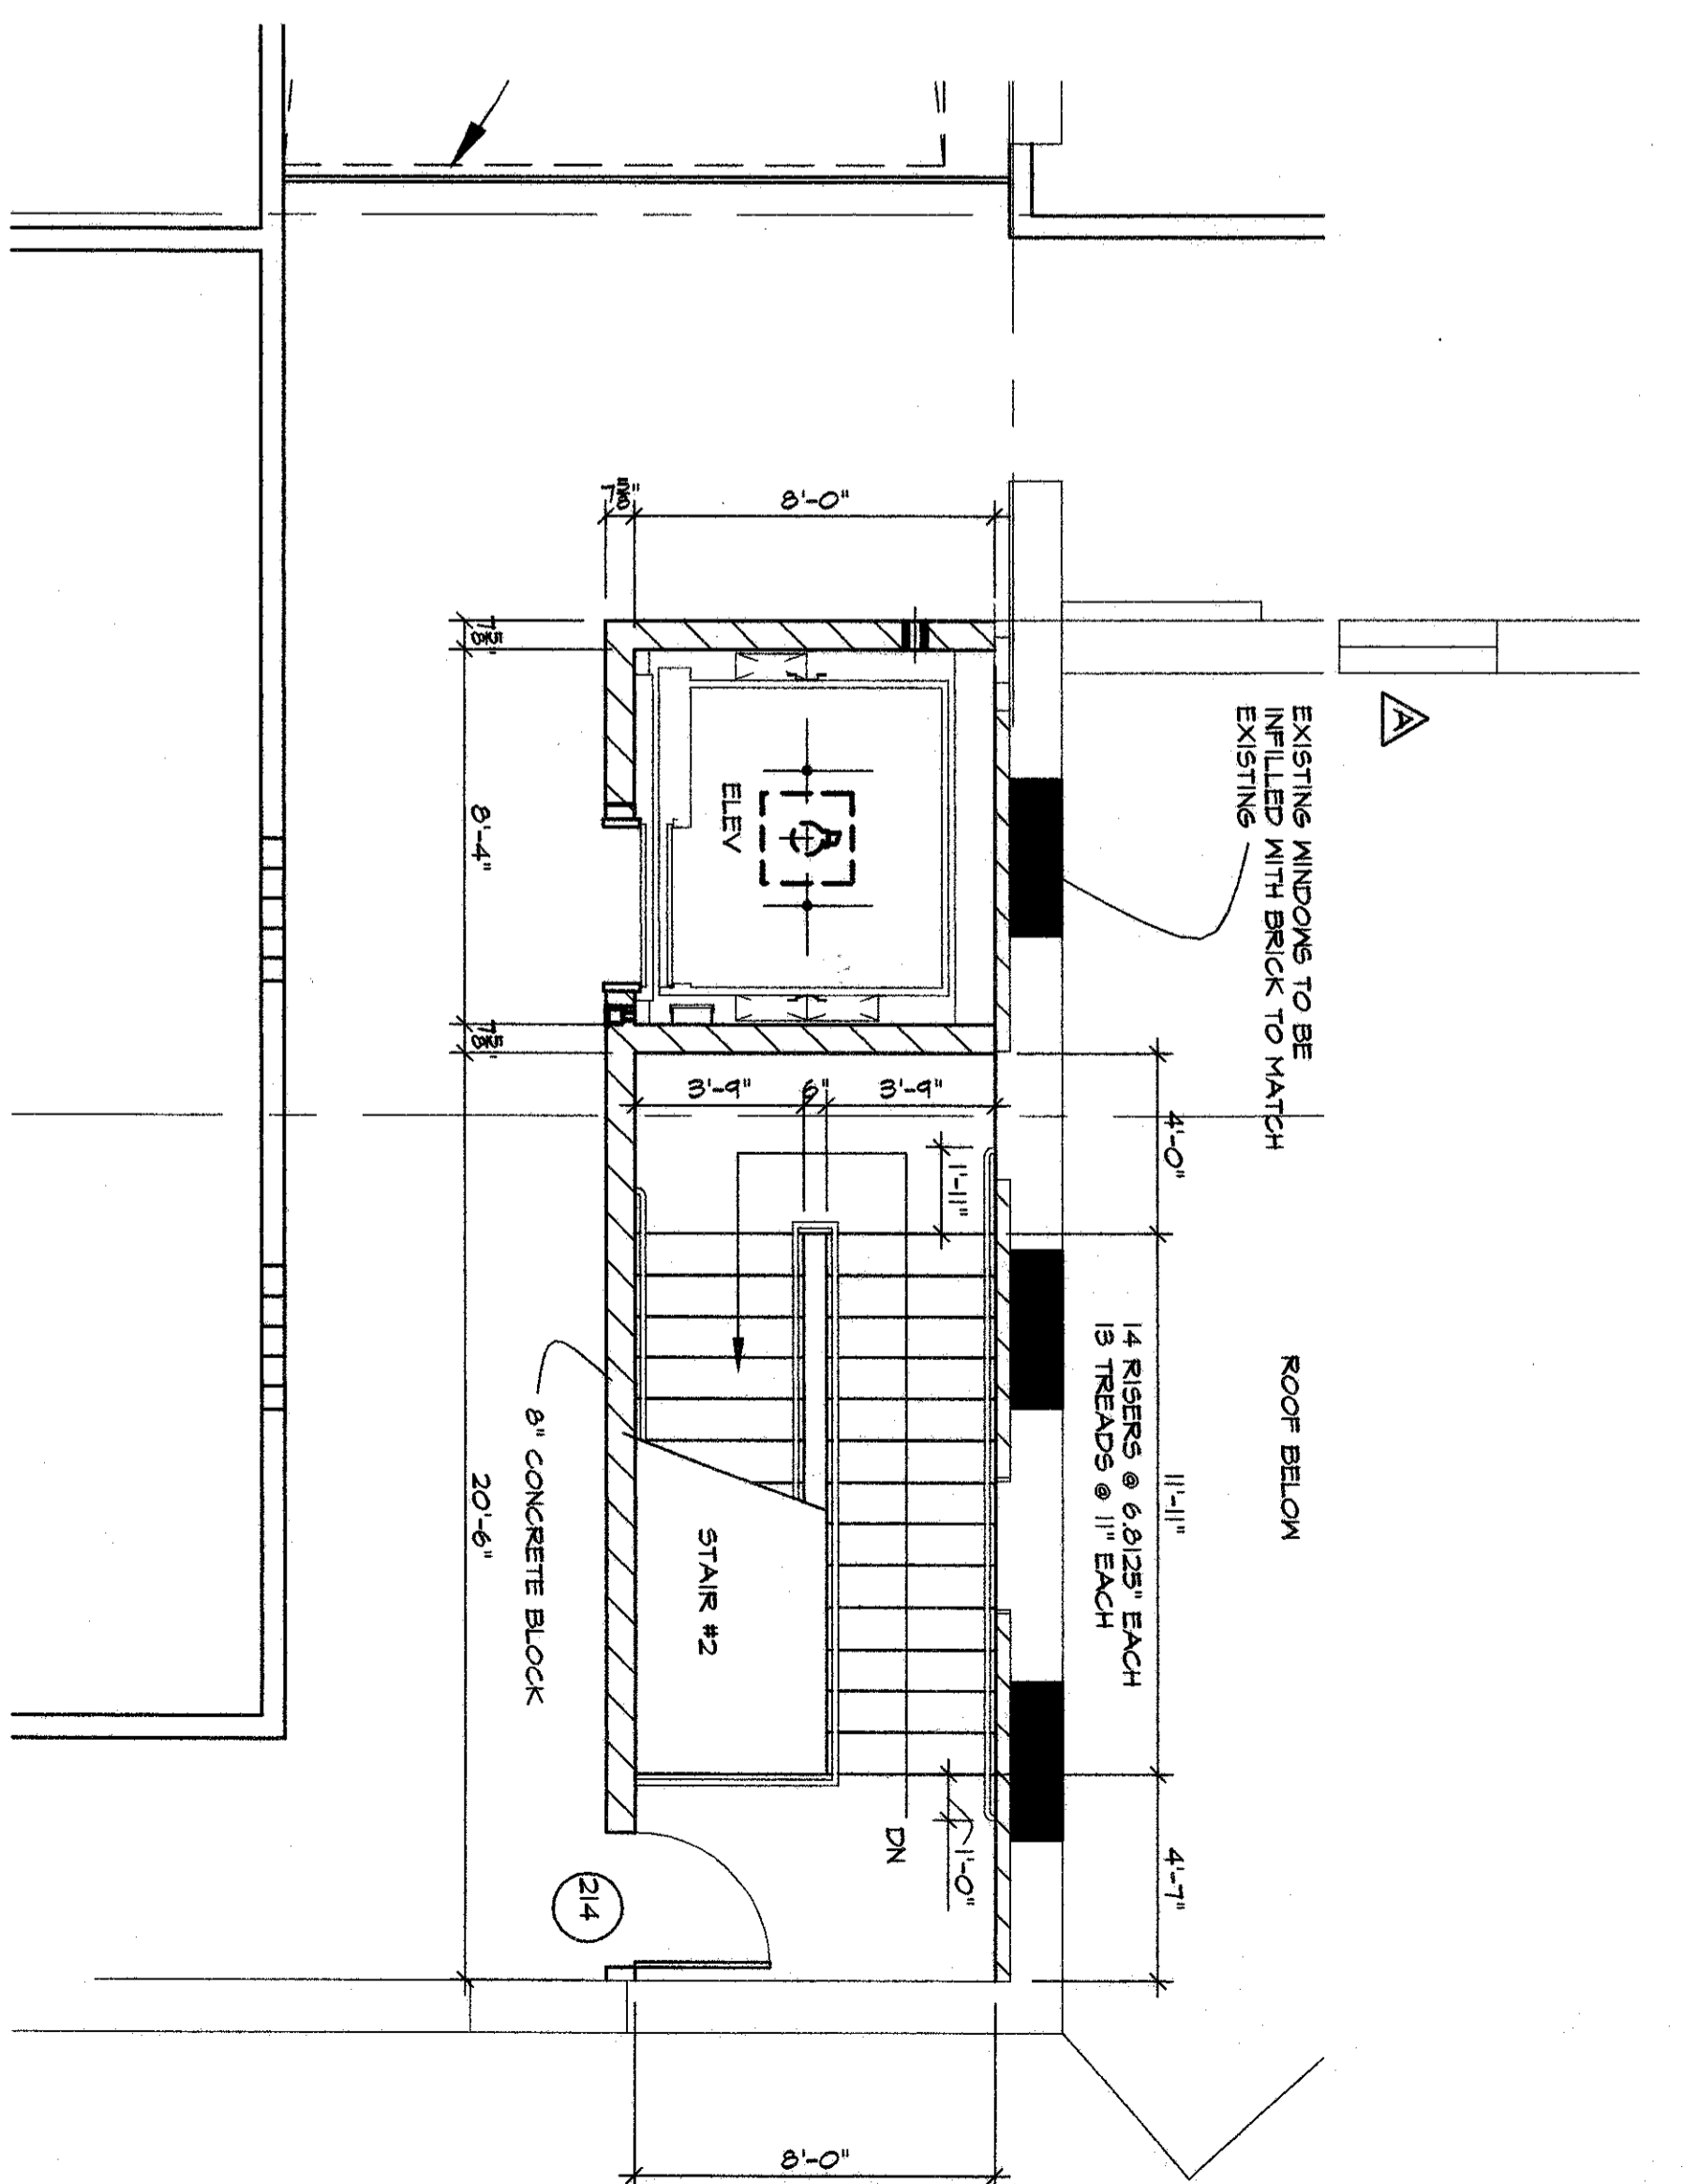


SECOND FLOOR  
ENLARGED STAIR/ELEVATOR PLAN F  
SCALE: 1/4" = 1'-0"

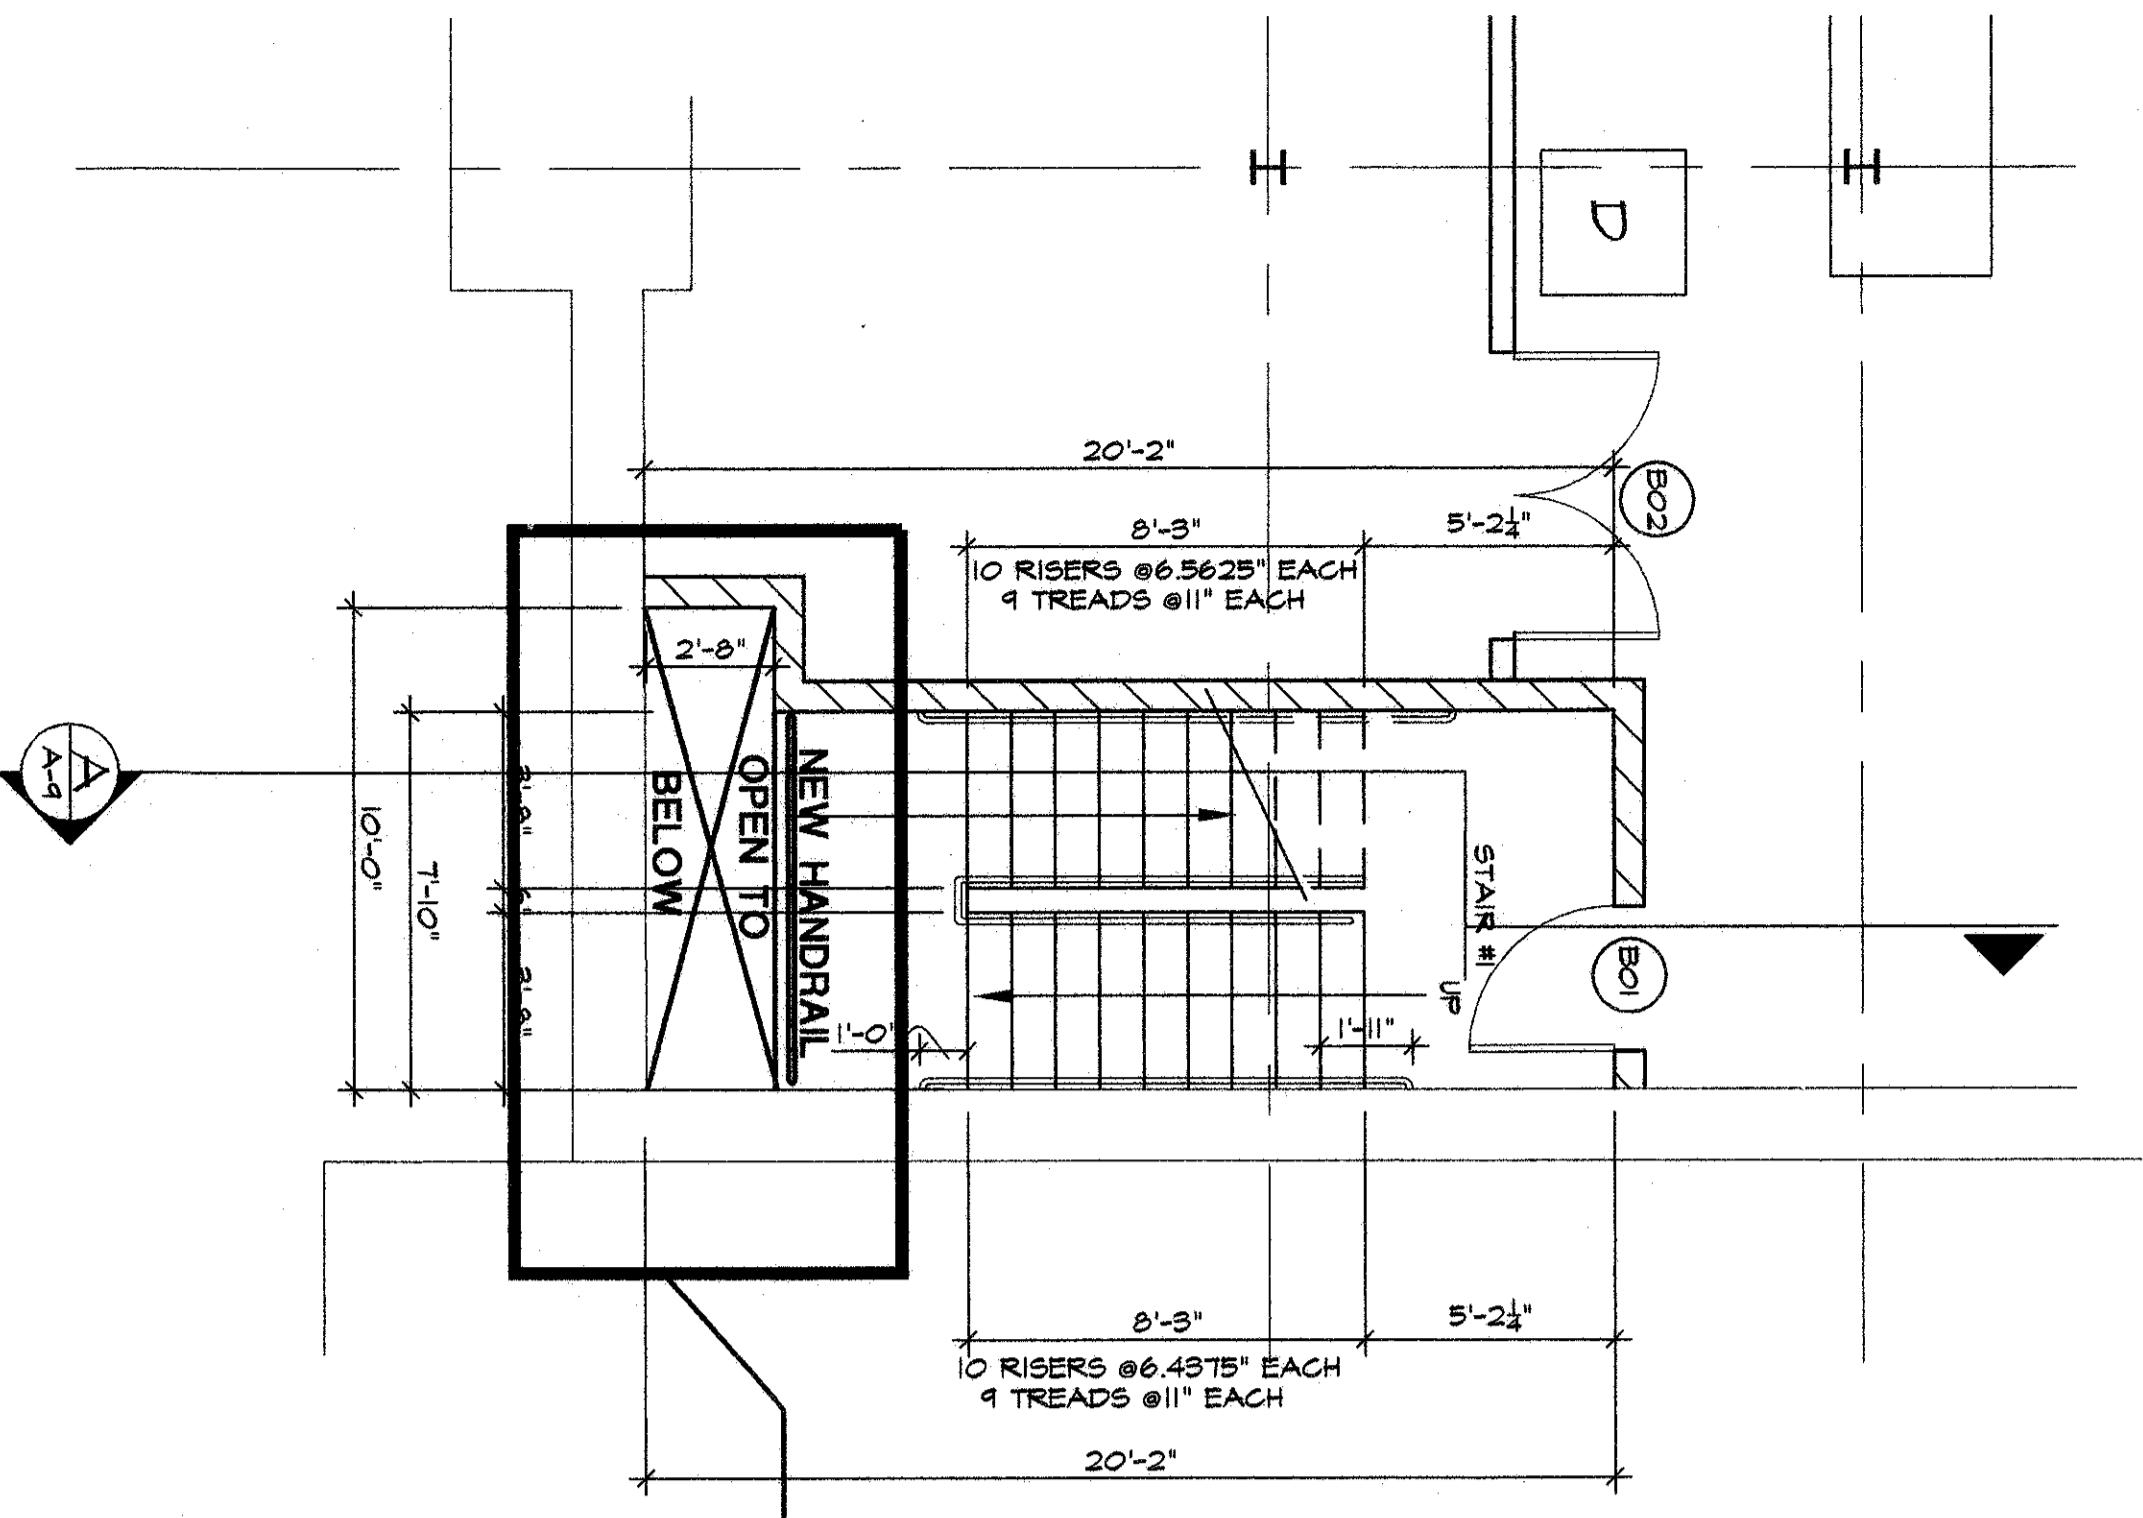

FIRST FLOOR  
ENLARGED STAIR PLAN A  
SCALE: 1/4" = 1'-0"

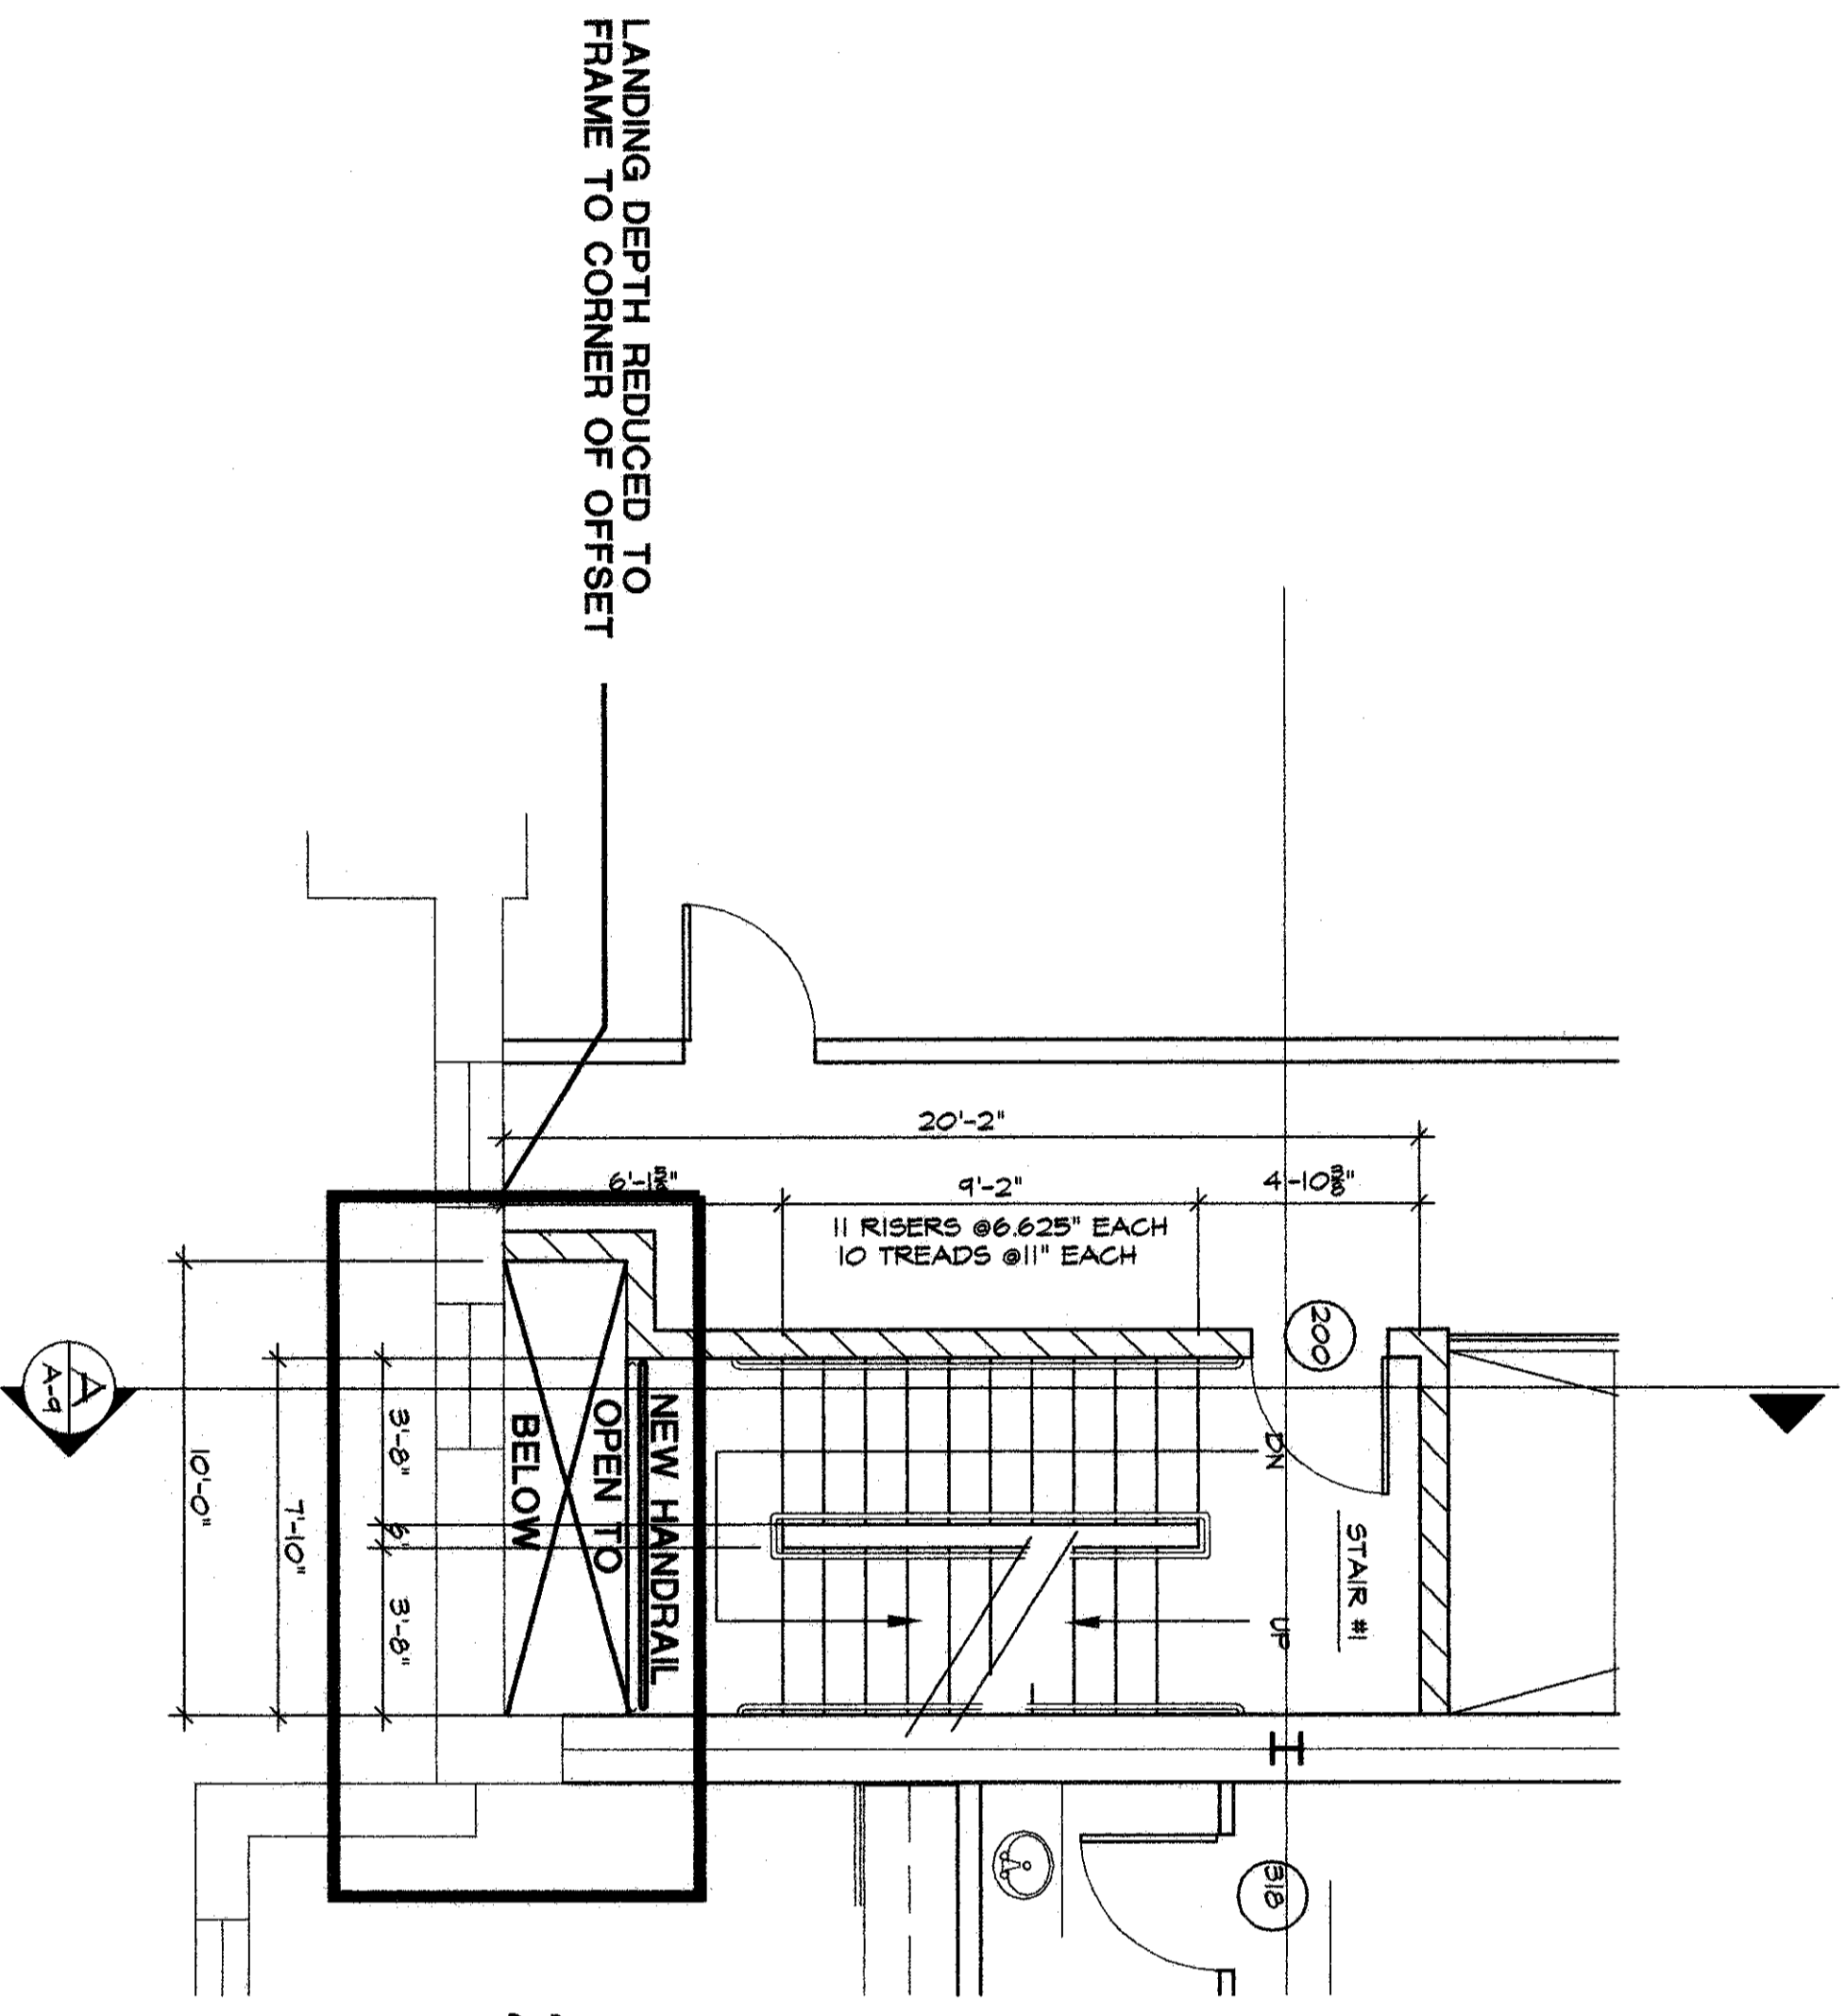

SECOND FLOOR  
ENLARGED STAIR PLAN C  
SCALE: 1/4" = 1'-0"

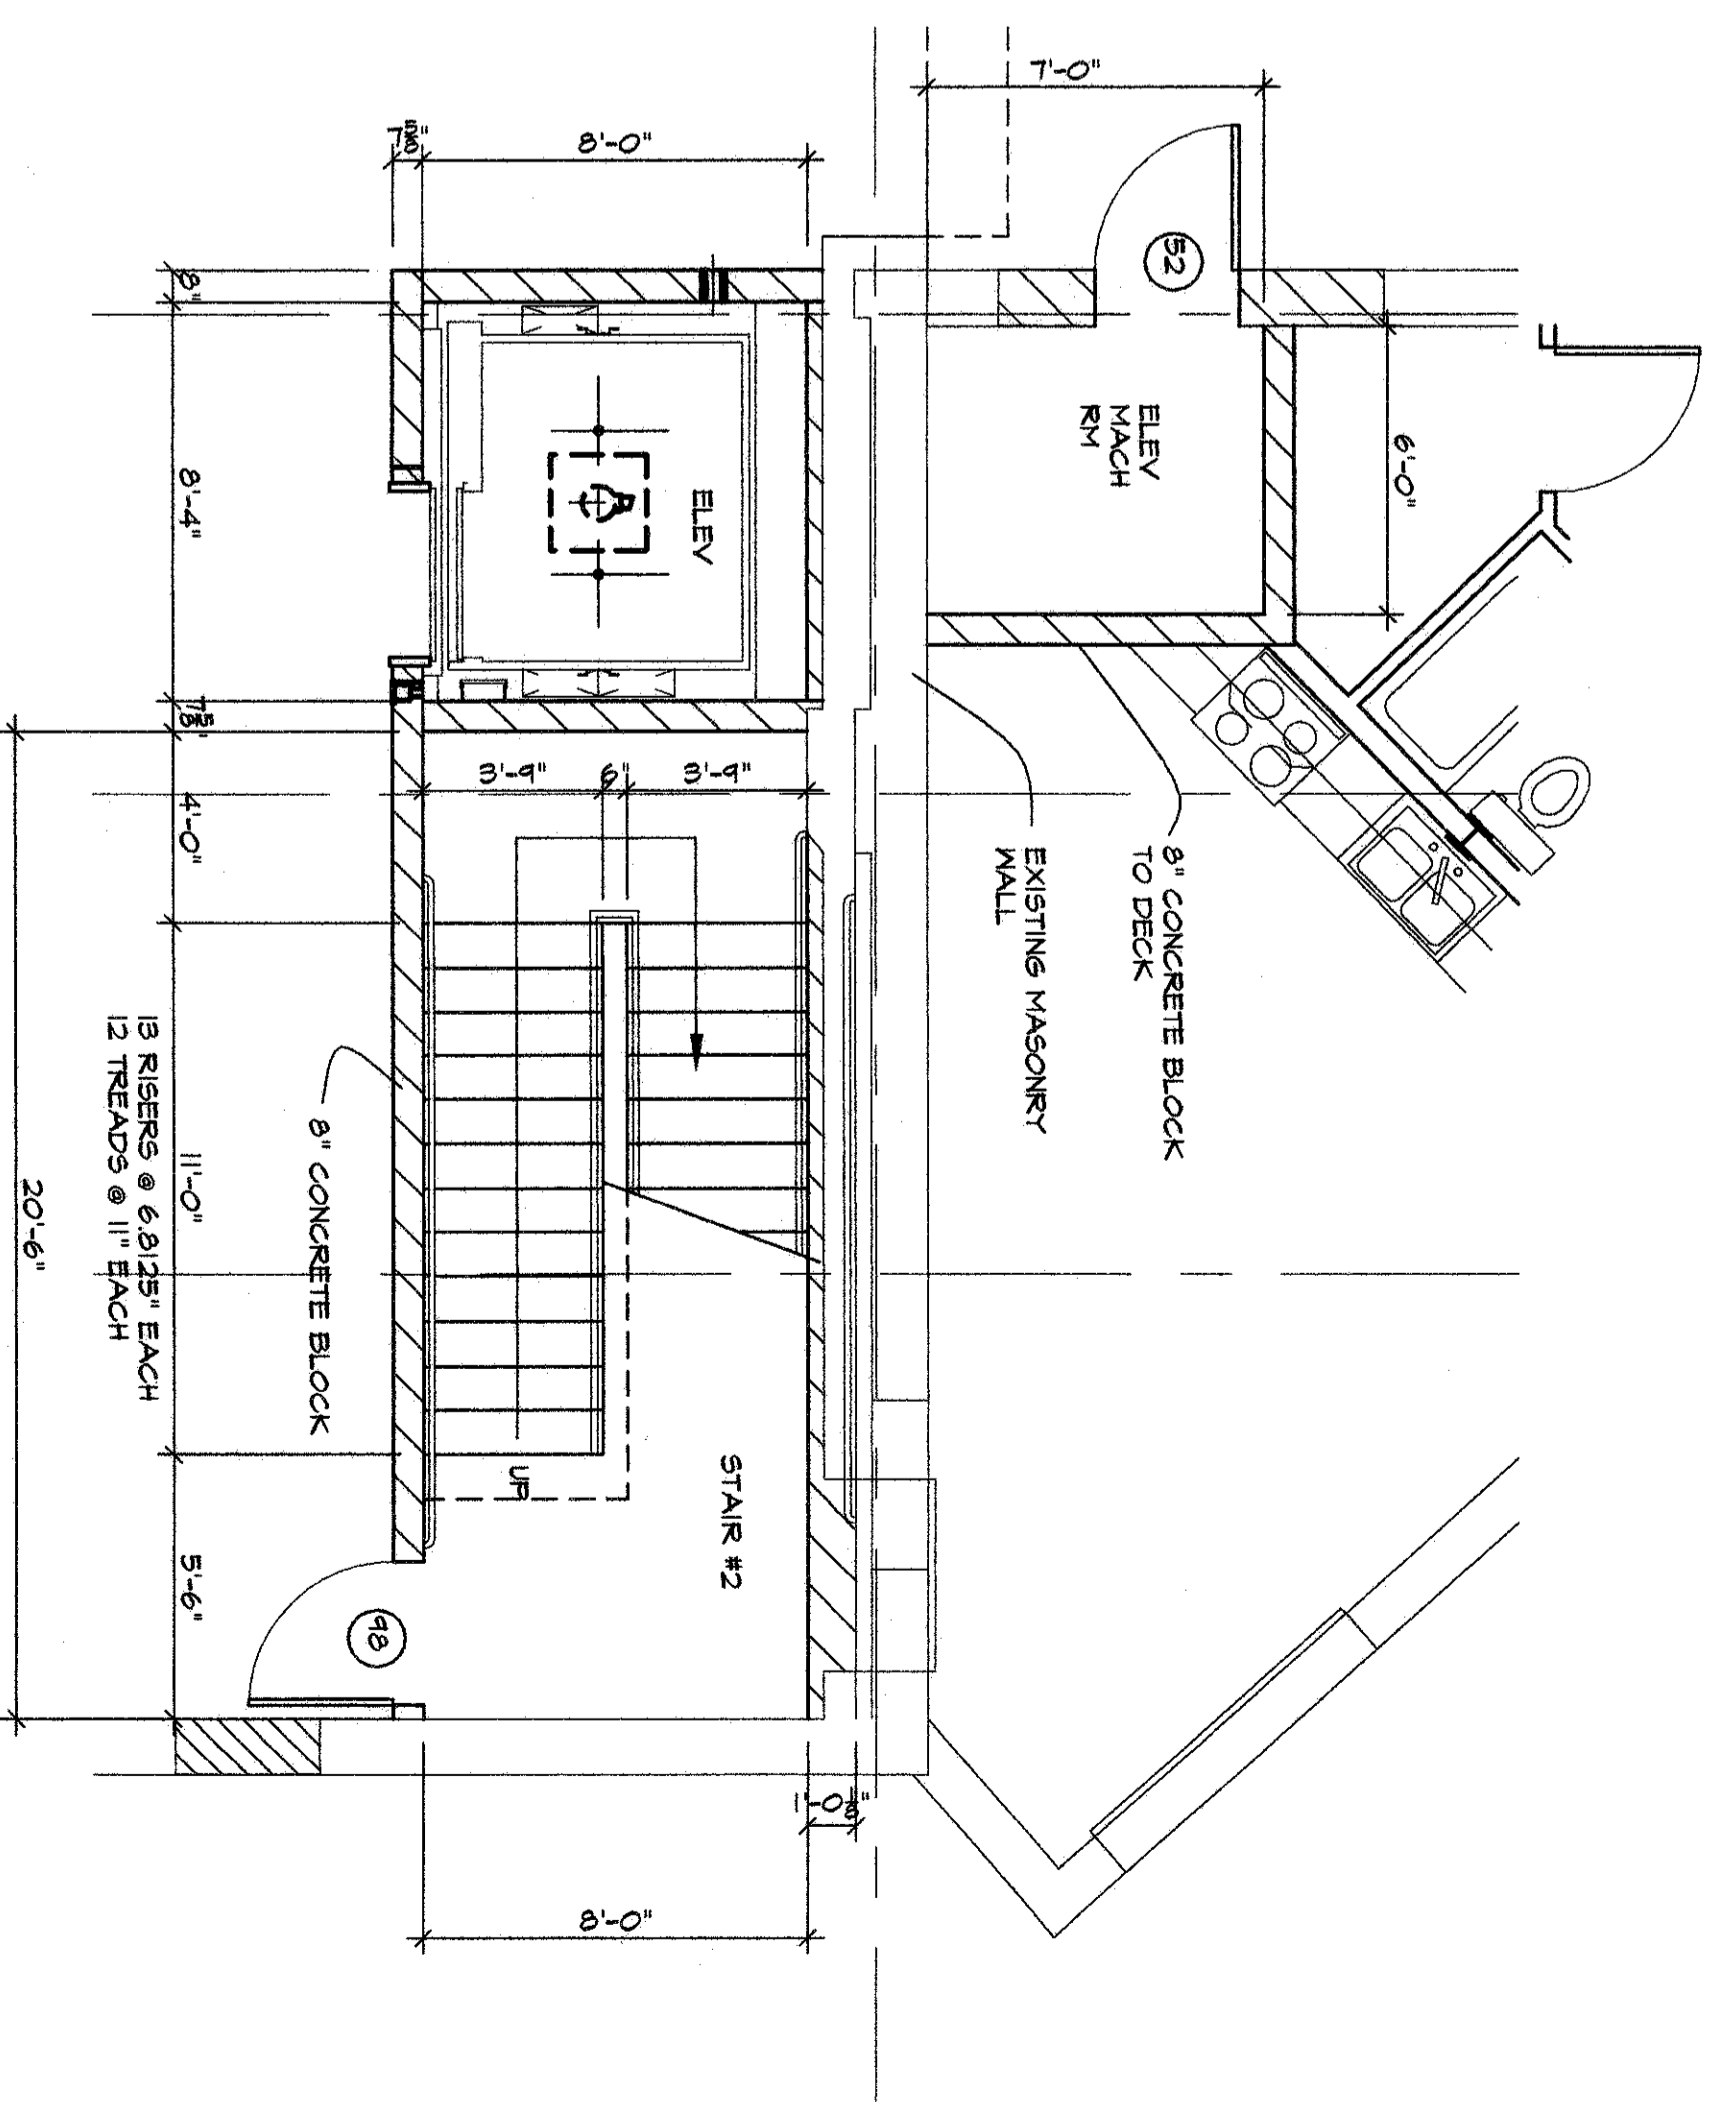

FIRST FLOOR  
ENLARGED STAIR/ELEVATOR PLAN E  
SCALE: 1/4" = 1'-0"

238


AS-BUILT DRAWING 8/25/04

DATE	8/20/02
DRAWN BY	MLK
REVISIONS	10/1/02
	8/25/04


PROJECT:  
**LEXINGTON LOFTS**  
200 BOLIVAR STREET  
LEXINGTON, KENTUCKY

DRAWING:  
**ENLARGED STAIR PLANS**


  
**The McGoodwin Company**  
Commercial Real Estate

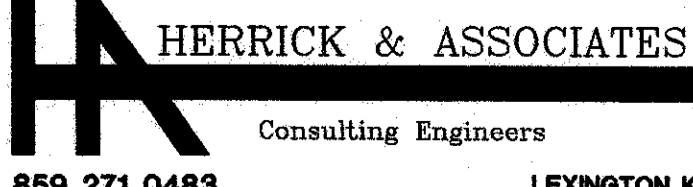  
HERRICK & ASSOCIATES  
Consulting Engineers  
555 271 0483 LEXINGTON KY

DESIGN-ENGINEERING  
501 BROOKFARM COURT  
LEXINGTON, KY 40517  
O. DAVID PRESTON, P.E.

  
MICHAEL L. KNOLL  
ARCHITECT

348 South Main Street  
Versailles, Kentucky 40383  
Phone: 858-873-1900  
Email: 3mcknoll@gte.net

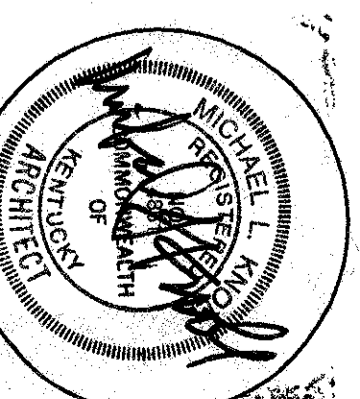

SHEET NO. **A-15**