



ENLARGED STAIR PLAN A
SCALE: 1/4" = 1'-0"

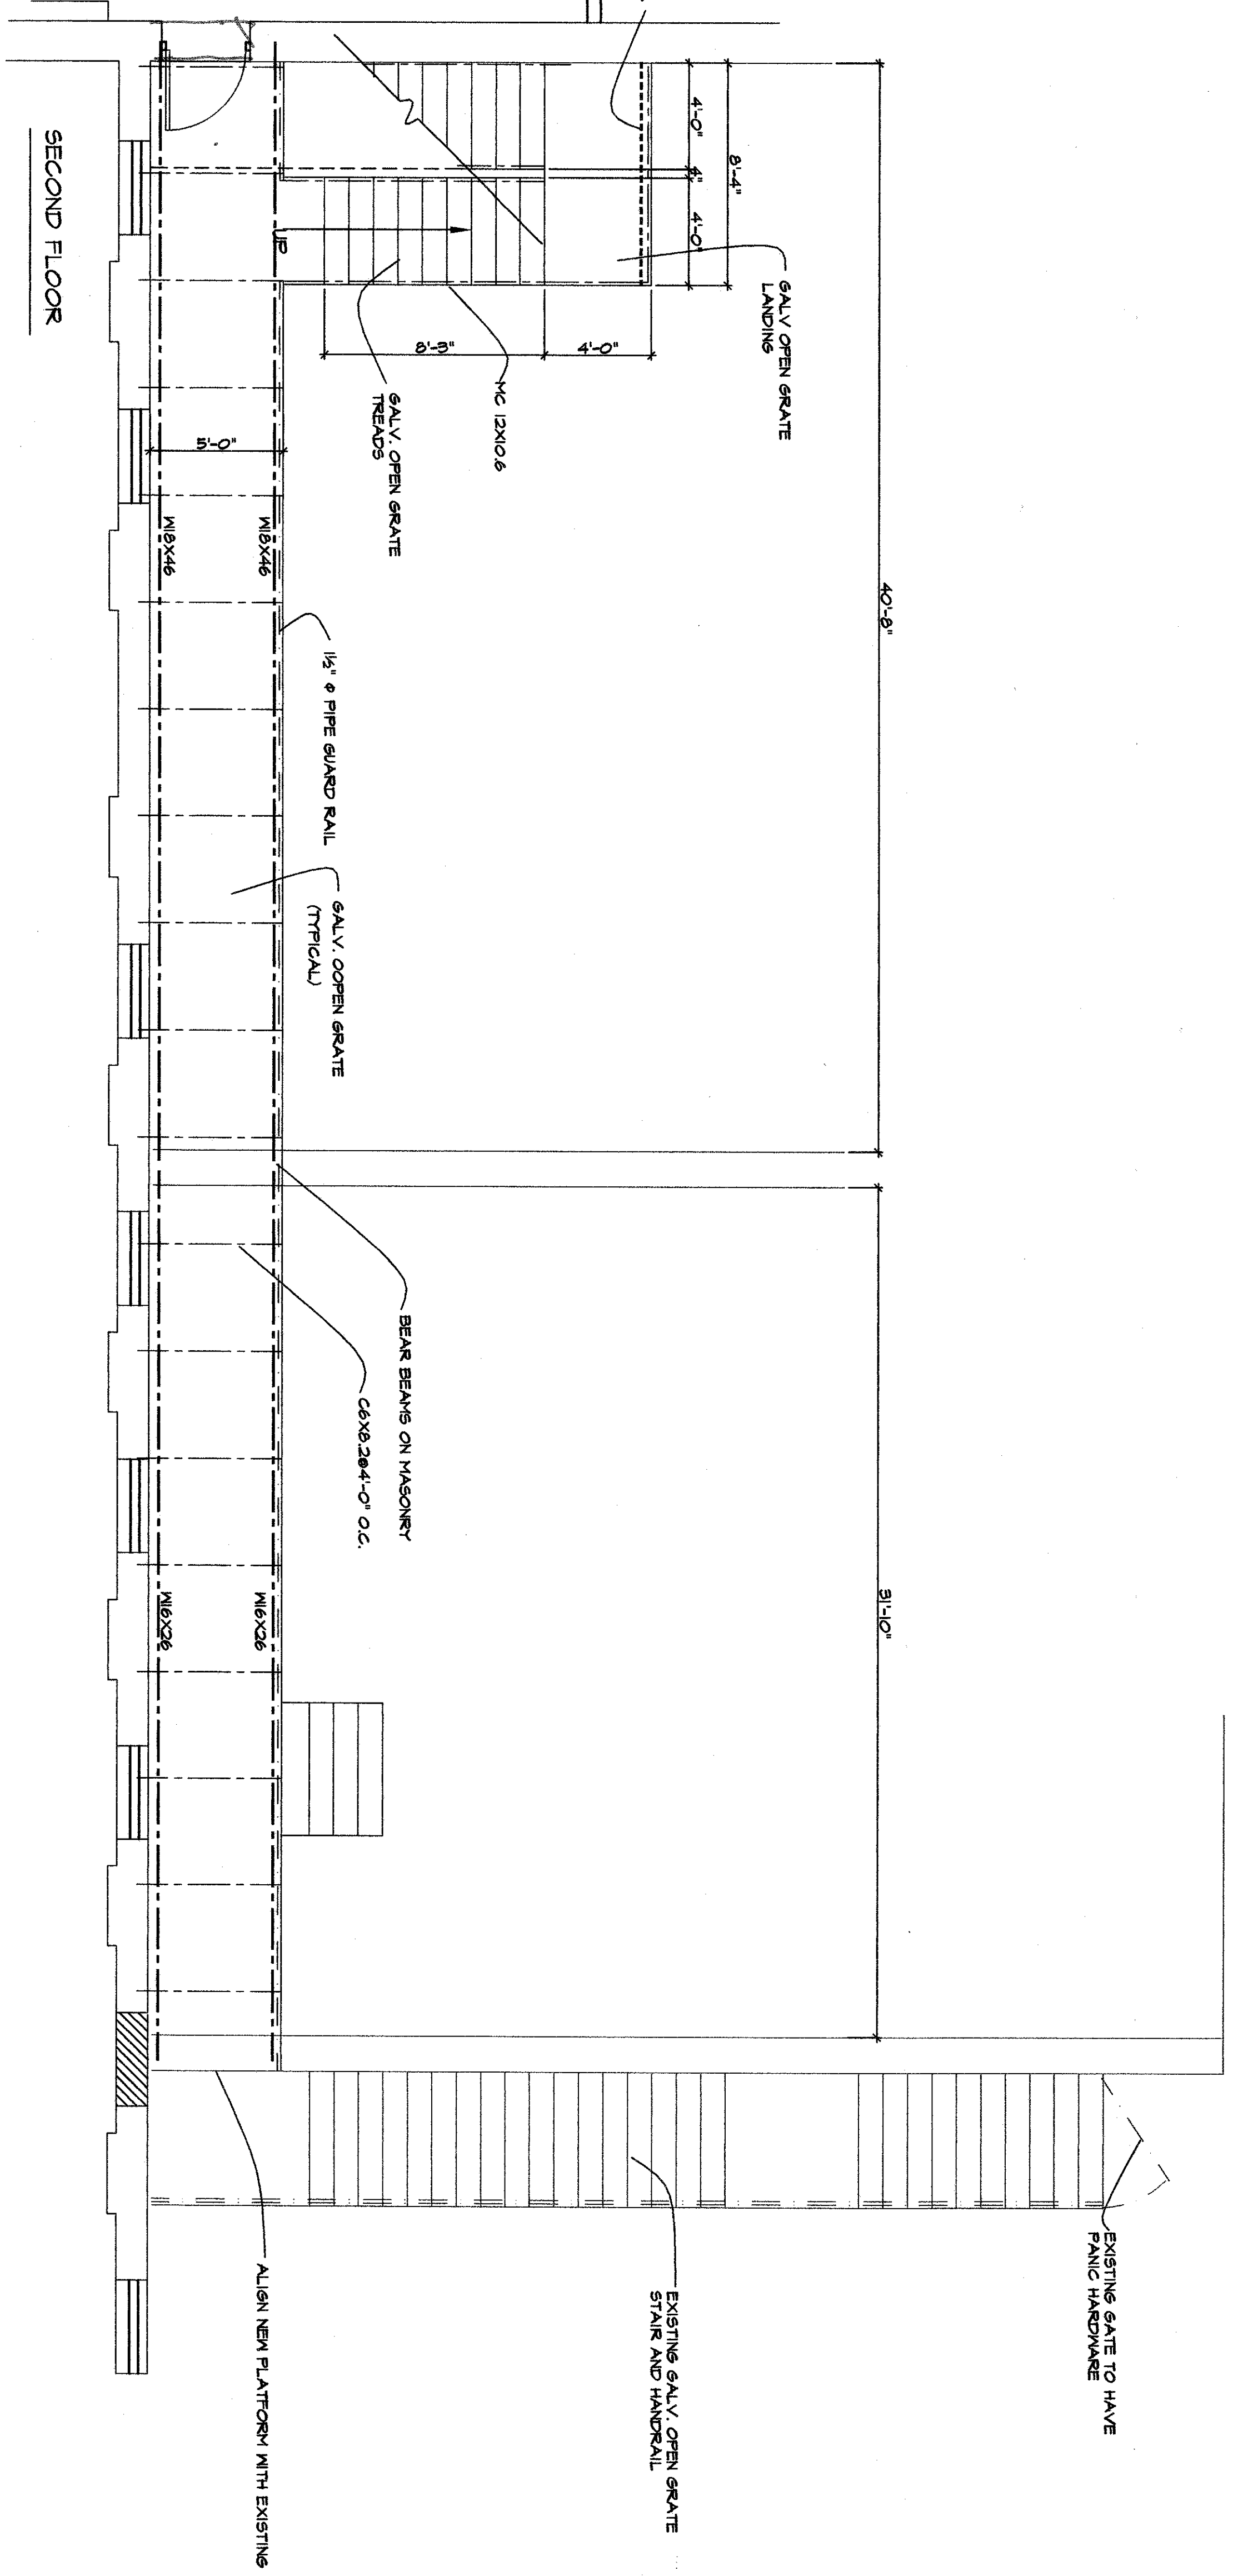


ENLARGED STAIR PLAN B
SCALE: 1/4" = 1'-0"

NOTE: SEE SHEET A-16b FOR PARTITIONS

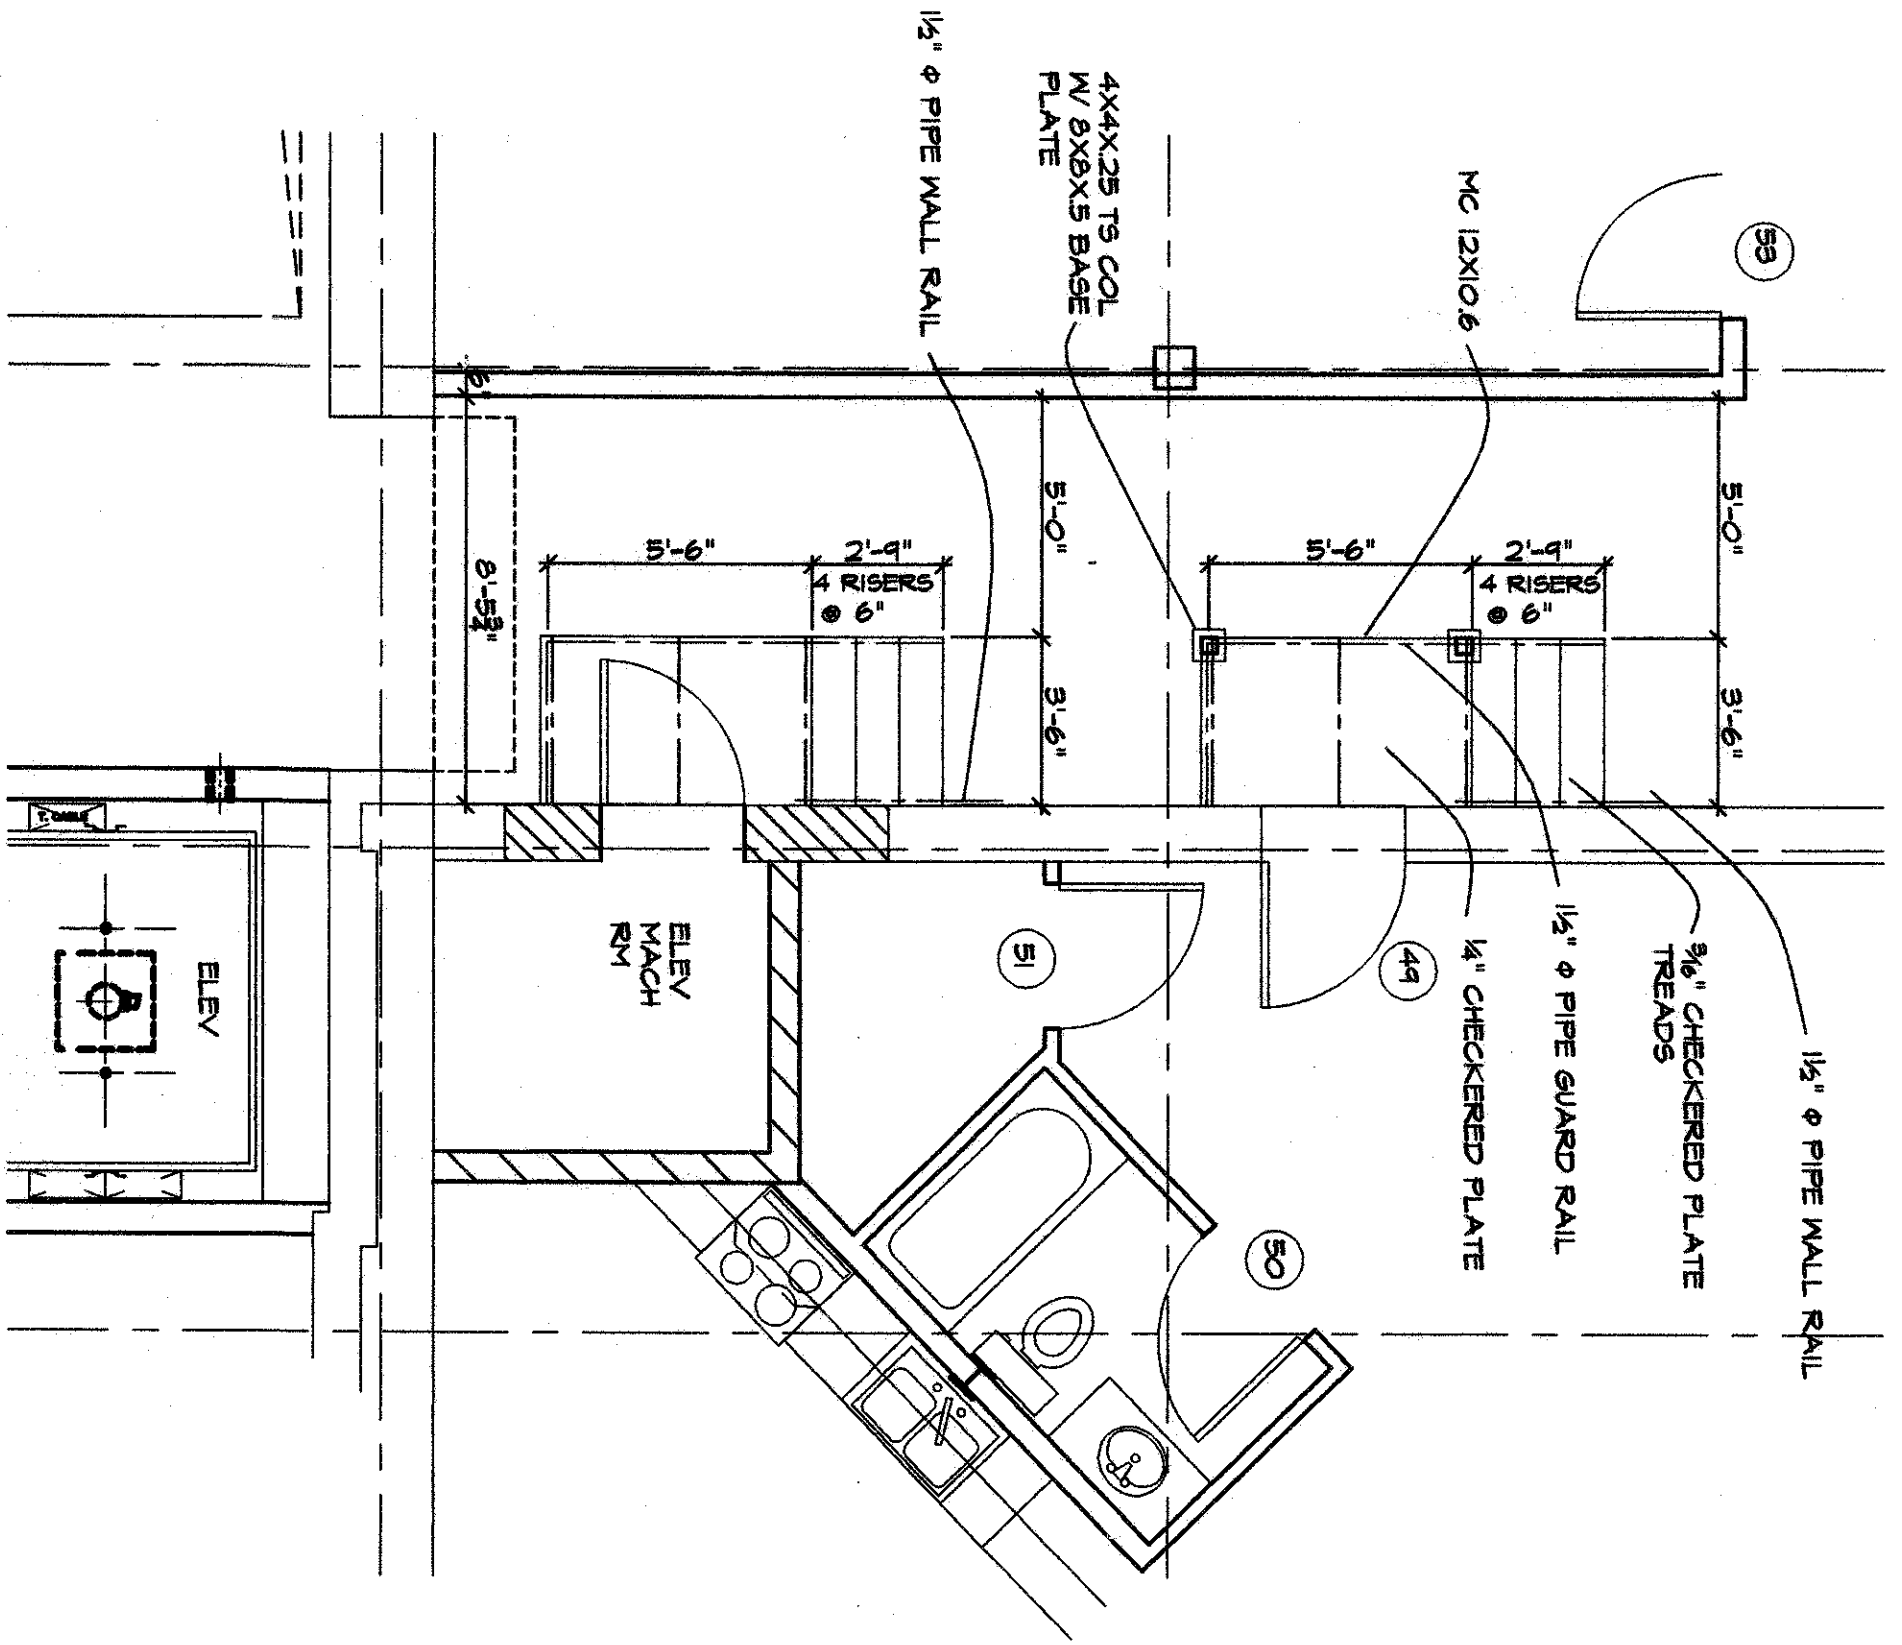


ENLARGED PLAN C
SCALE: 1/4" = 1'-0"

NOTE: SEE SHEET A-16a FOR REVISIONS

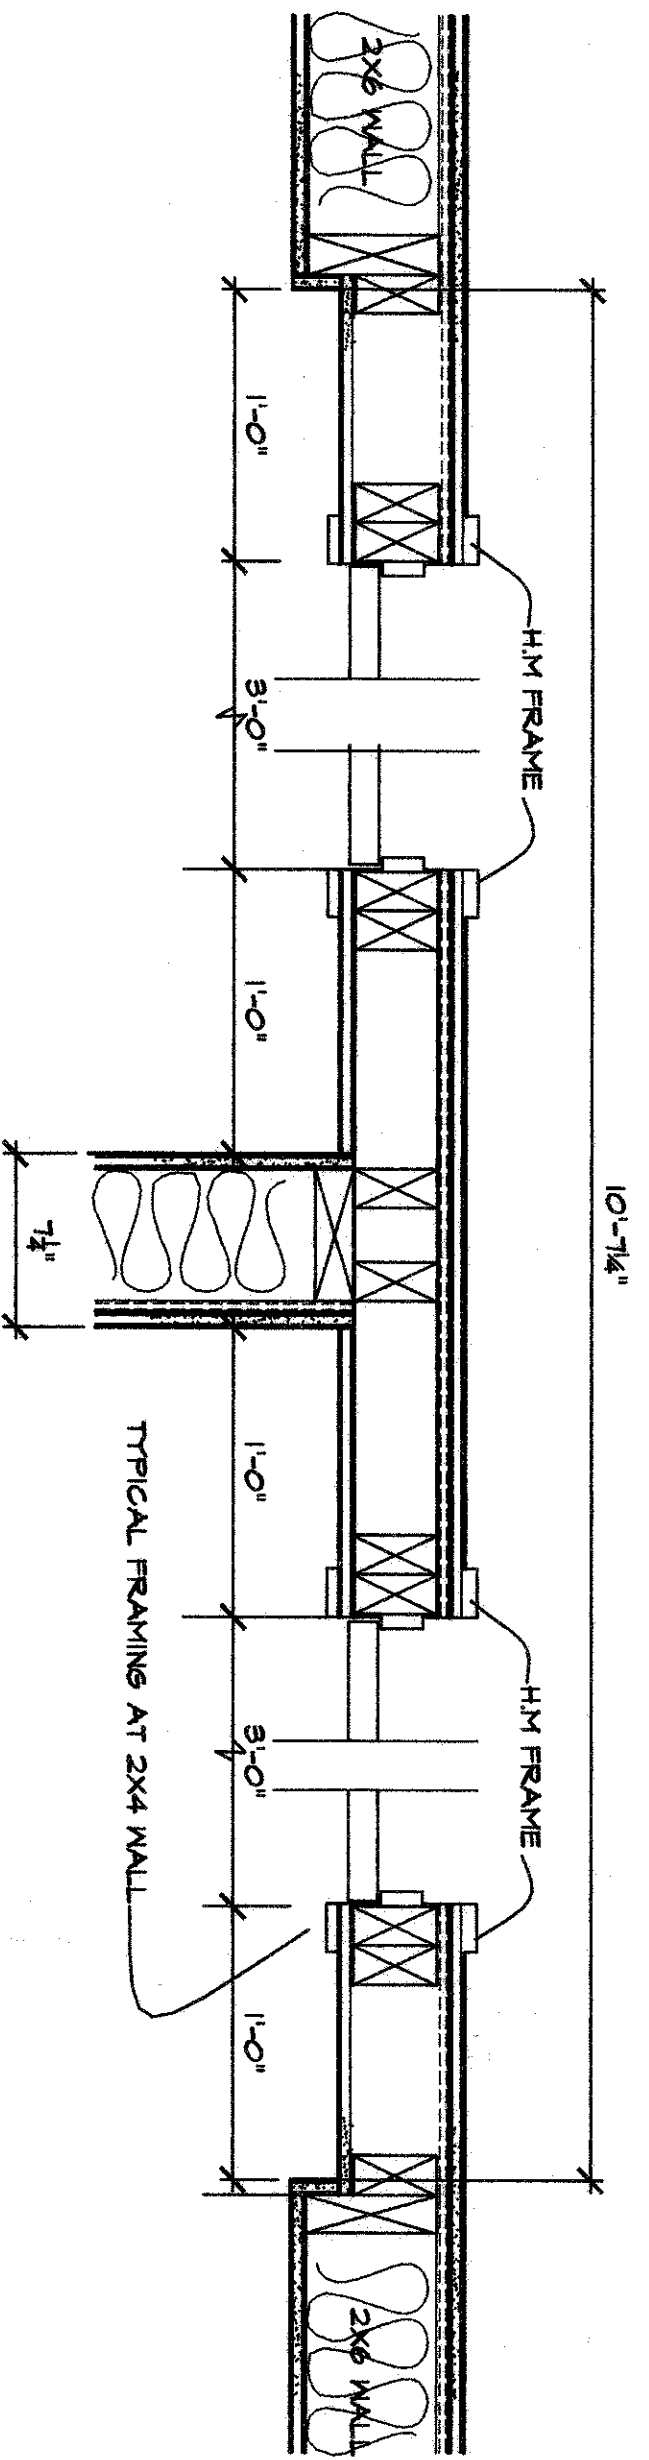

DOOR FRAMING PLAN D
SCALE: 1/4" = 1'-0"

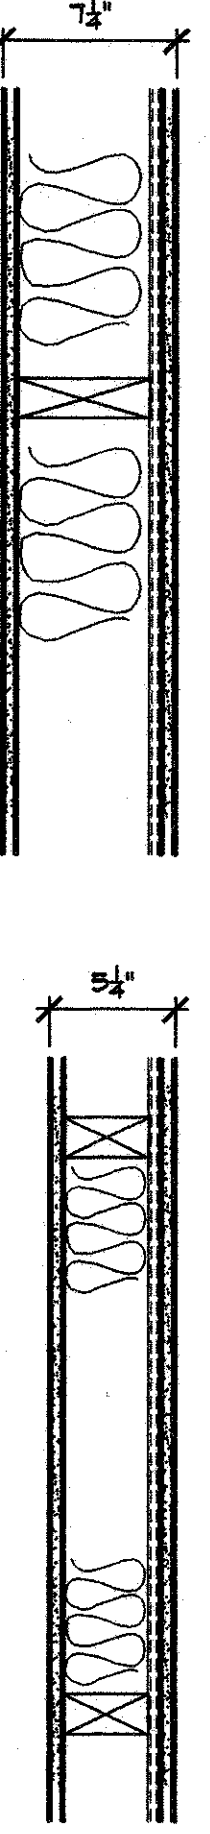

PARTITION TYPE E
SCALE: 1/4" = 1'-0"

REEL STUD DRYWALL - 3/8" STRIP PANELS
RECCOPE 1" COME - 2x8 STUDS @ 16" ON CENTER
ONE SIDE SPACED @ 24" O.C. SCREEN ATTACHED TO STUDS - SINGLE LAYER GYPSUM PANELS SCREEN STAGGERED AND FIN - FINISHES CALLED
SIC RATING = 50

REEL STUD DRYWALL - 3/8" STRIP PANELS
RECCOPE 1" COME - 2x4 STUDS @ 16" ON CENTER
ONE SIDE SPACED @ 24" O.C. SCREEN ATTACHED TO STUDS - SINGLE LAYER GYPSUM PANELS SCREEN STAGGERED AND FIN - FINISHES CALLED
SIC RATING = 50

HUD Project No.

DATE:	10/28/02
DESIGNED BY:	MLK
DRAWN BY:	MLK
CHECKED BY:	MLK
DATE:	10/29/04

PROJECT:
LEXINGTON LOFTS
200 BOLIVAR STREET
LEXINGTON, KENTUCKY

DRAWING:
ENLARGED PLANS / DETAILS


The McGoodwin Company
Commercial Real Estate

HERRICK & ASSOCIATES
Consulting Engineers
859 271 0483 LEXINGTON KY

DESIGN-ENGINEERING
601 BROOKFARM COURT
LEXINGTON, KY 40517
O. DAVID PRESTON, P.E.

MICHAEL L KNOLL
ARCHITECT

346 South Main Street
Versailles, Kentucky 40383
Phone: 859-873-1900
Email: 3mknoll@gtg.net

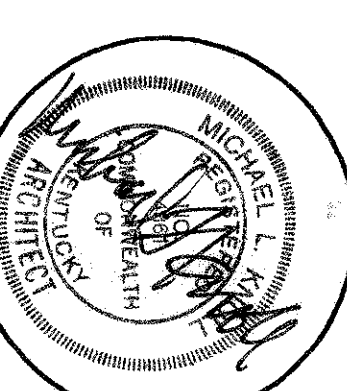

AS-BUILT DRAWING

SHEET NO. **A-16**