




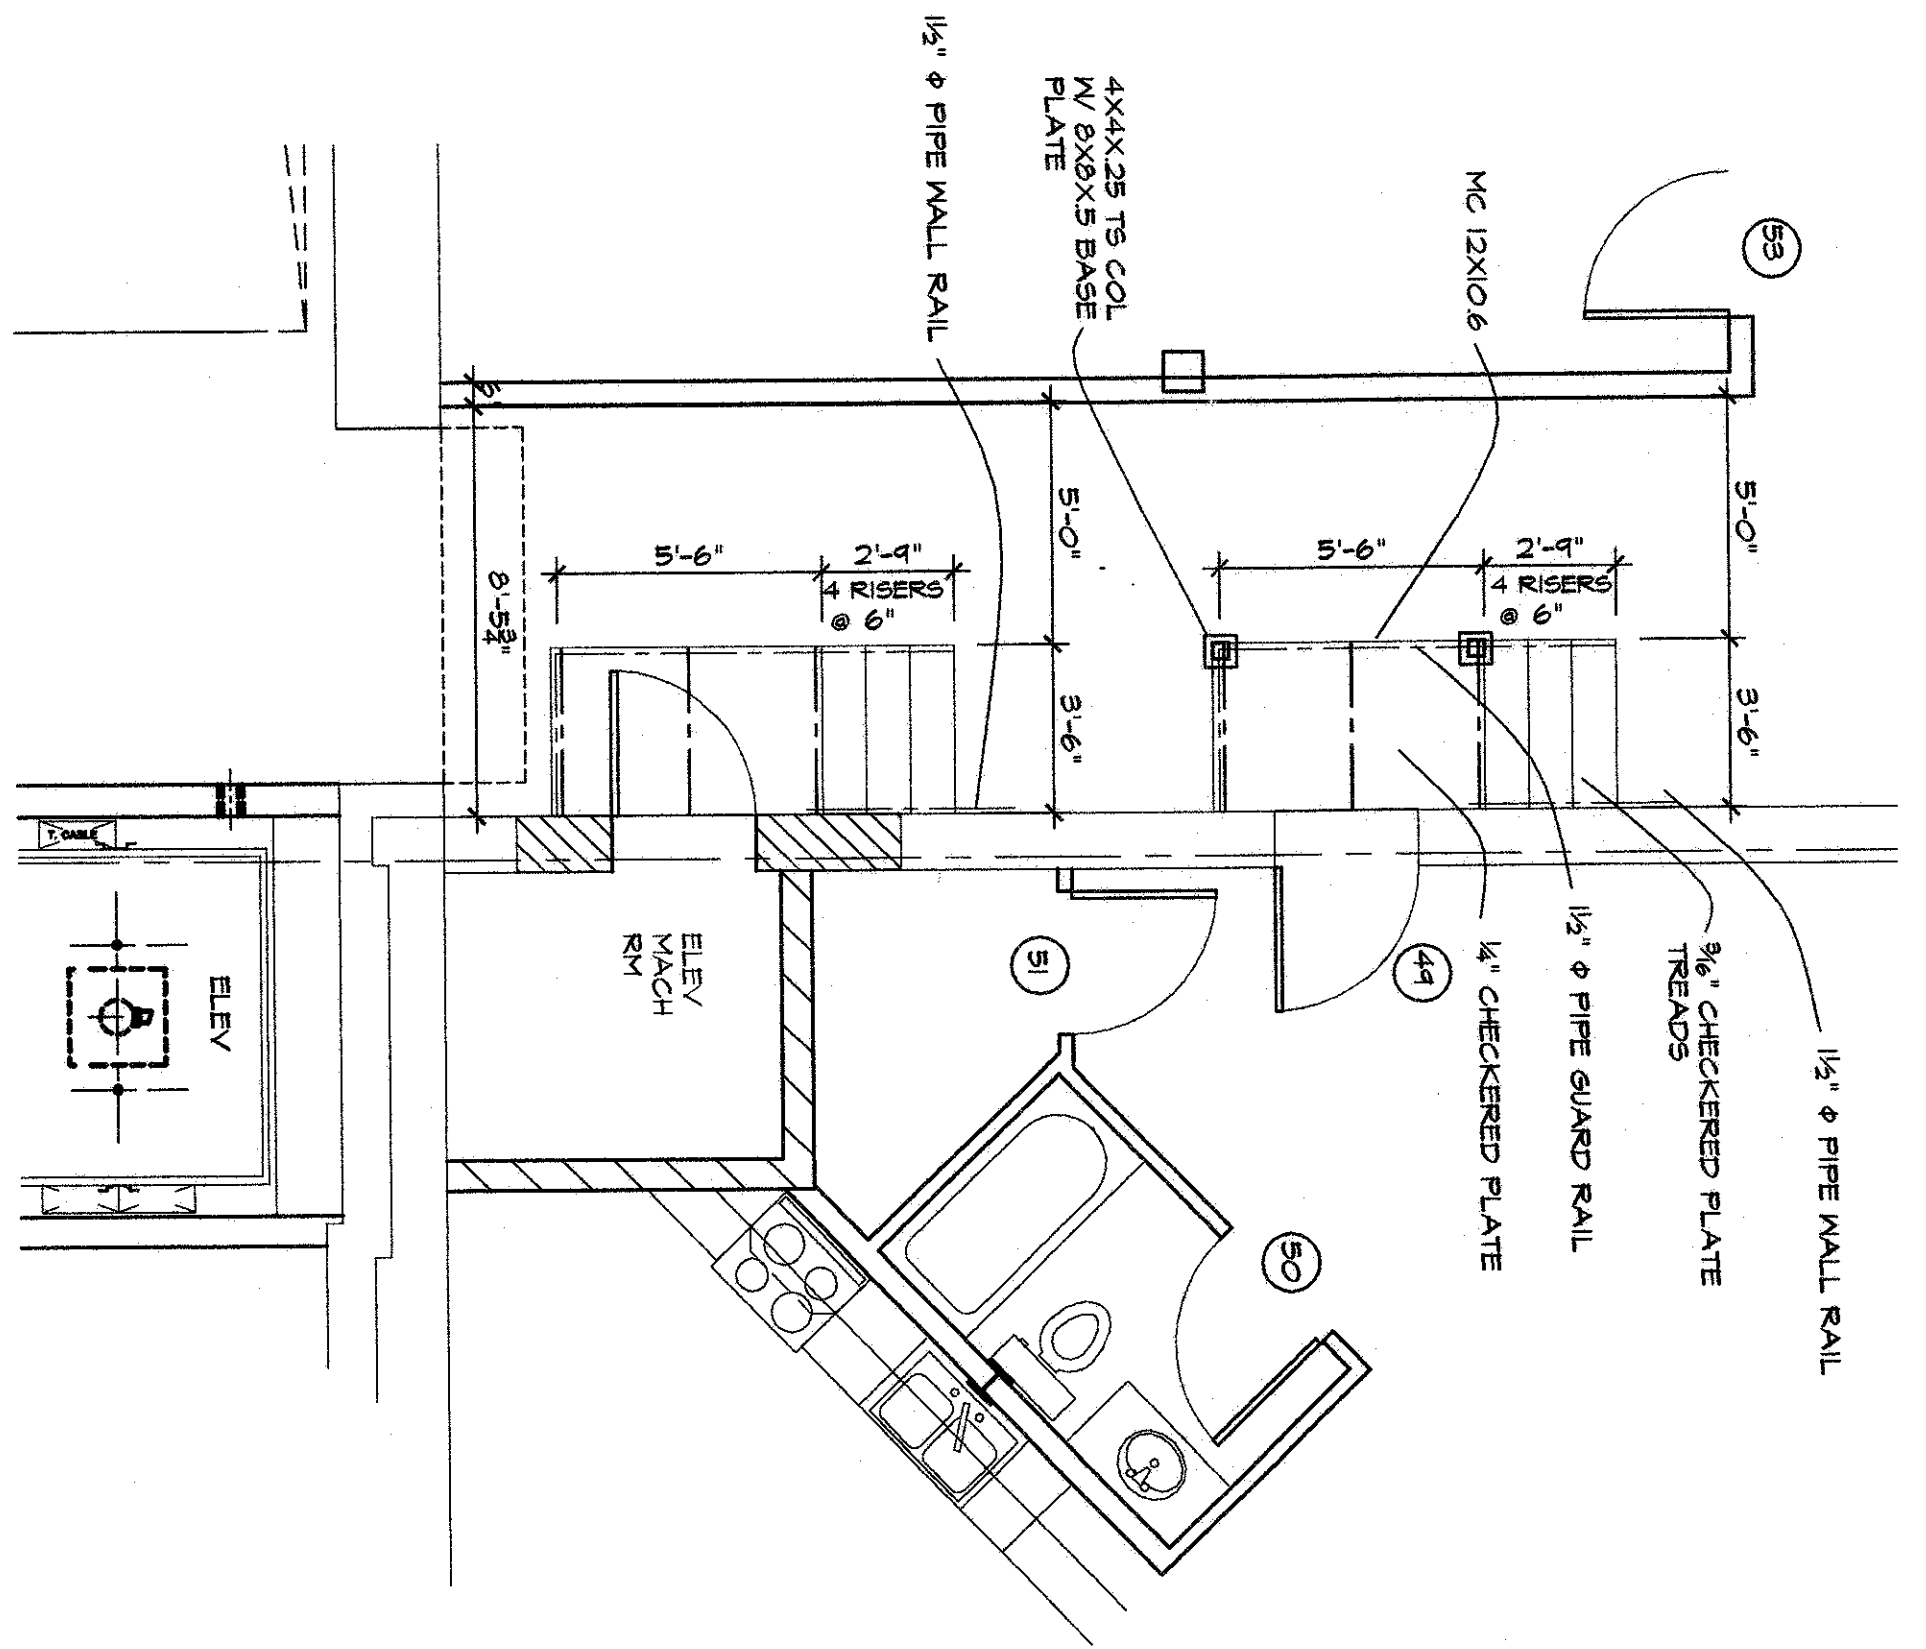

ENLARGED PLAN
SCALE: 1/4" = 1'-0"

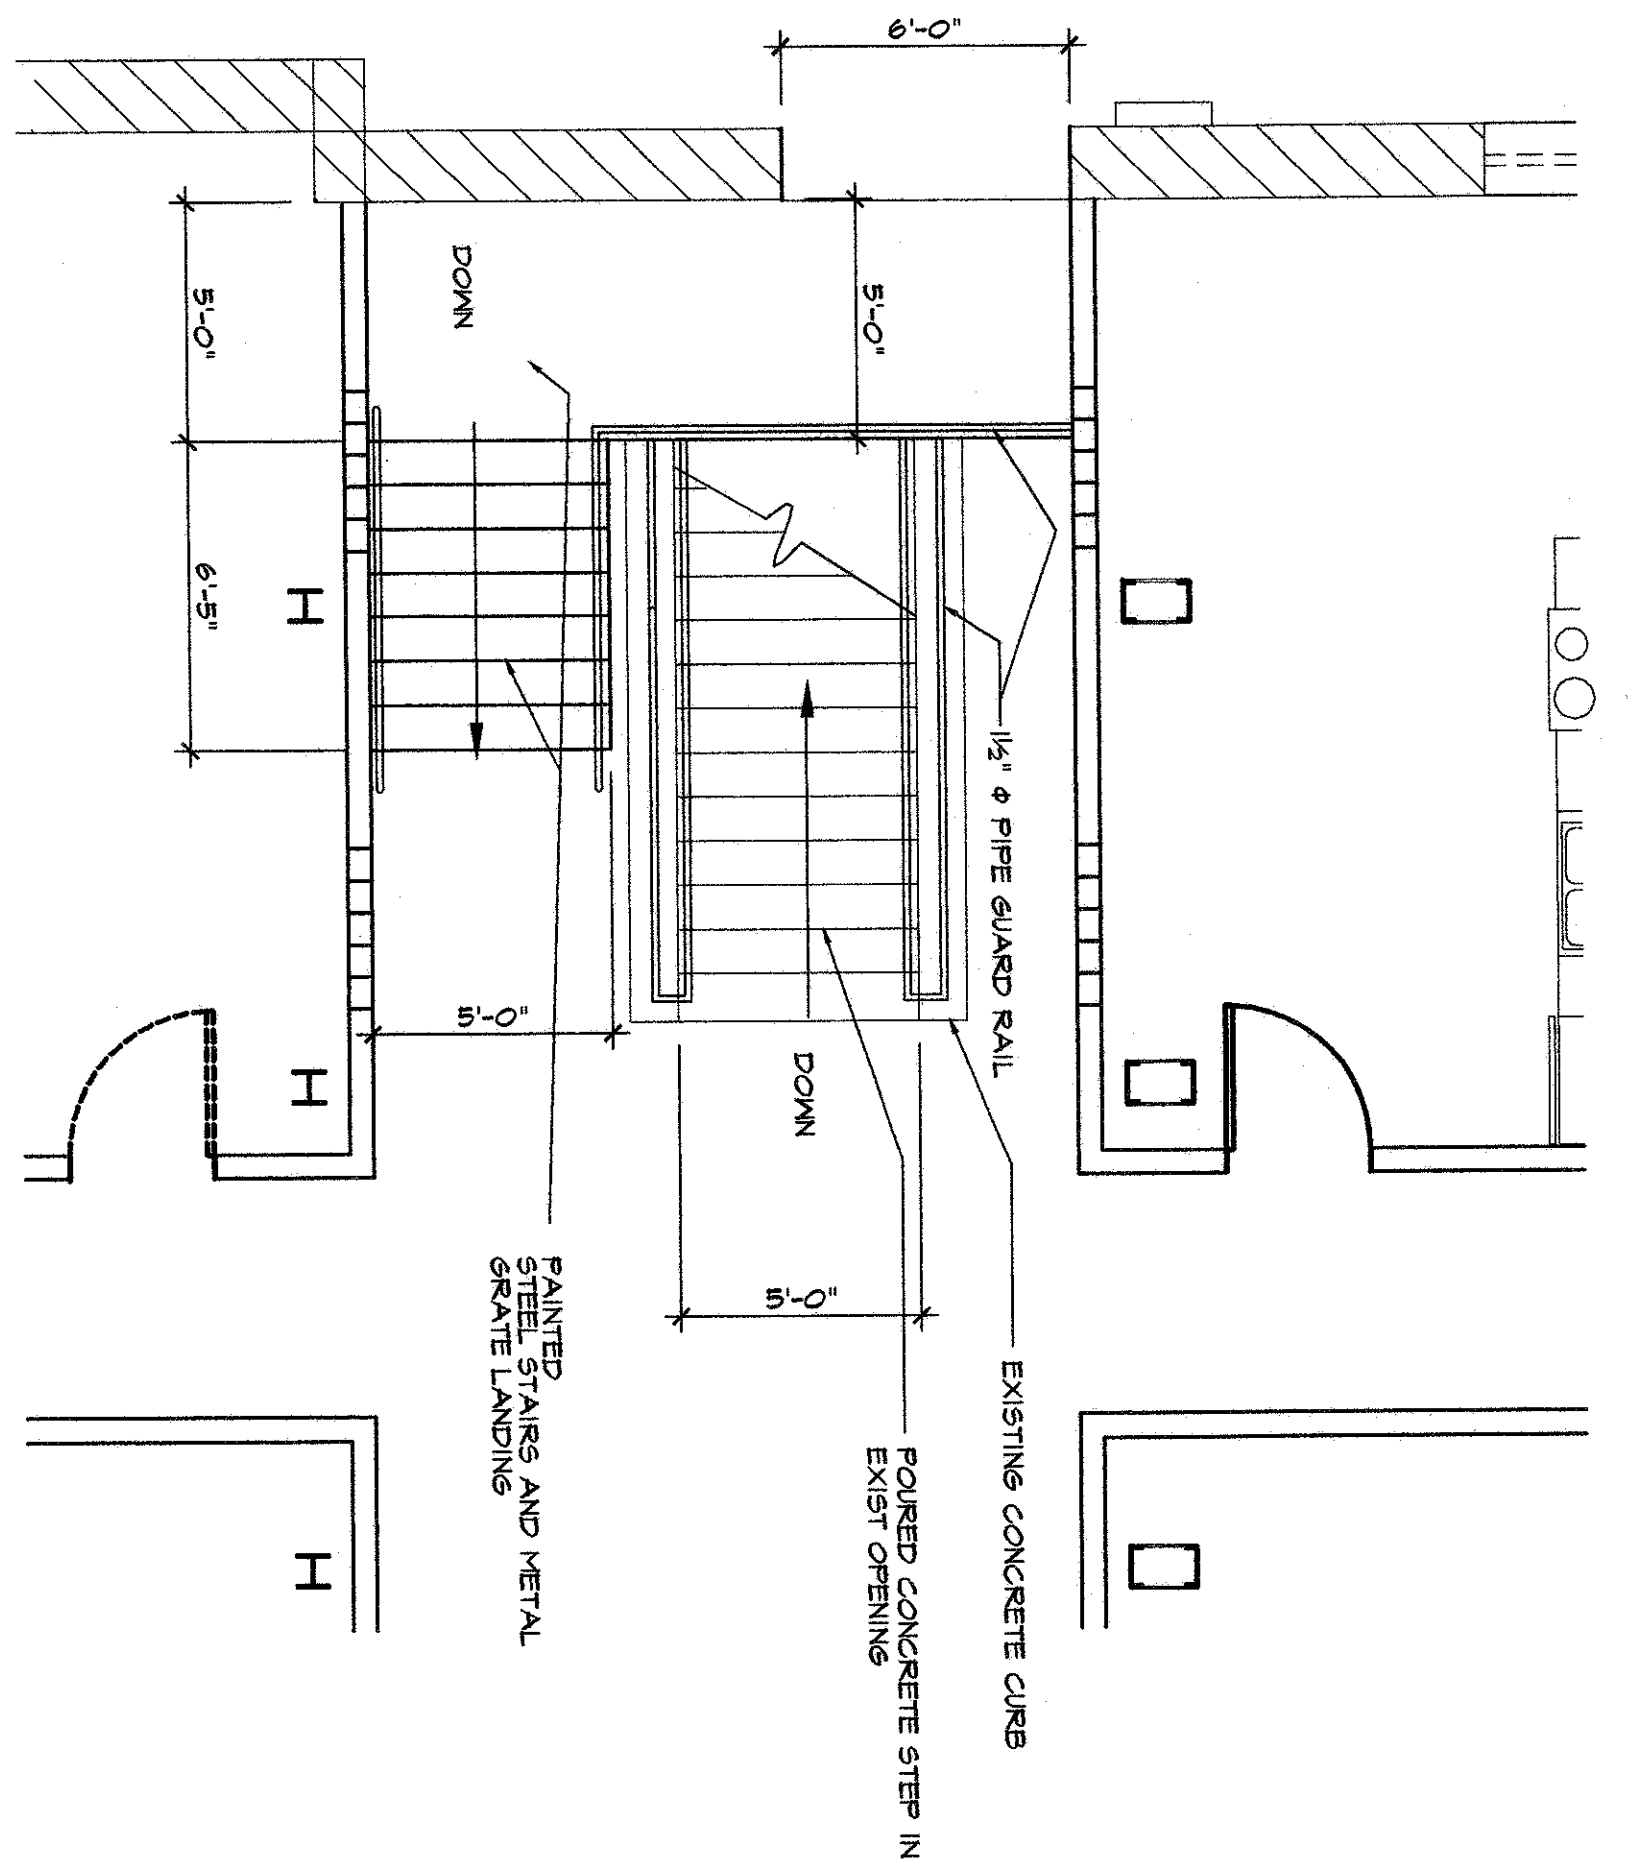

ENLARGED PLAN
SCALE: 1/4" = 1'-0"

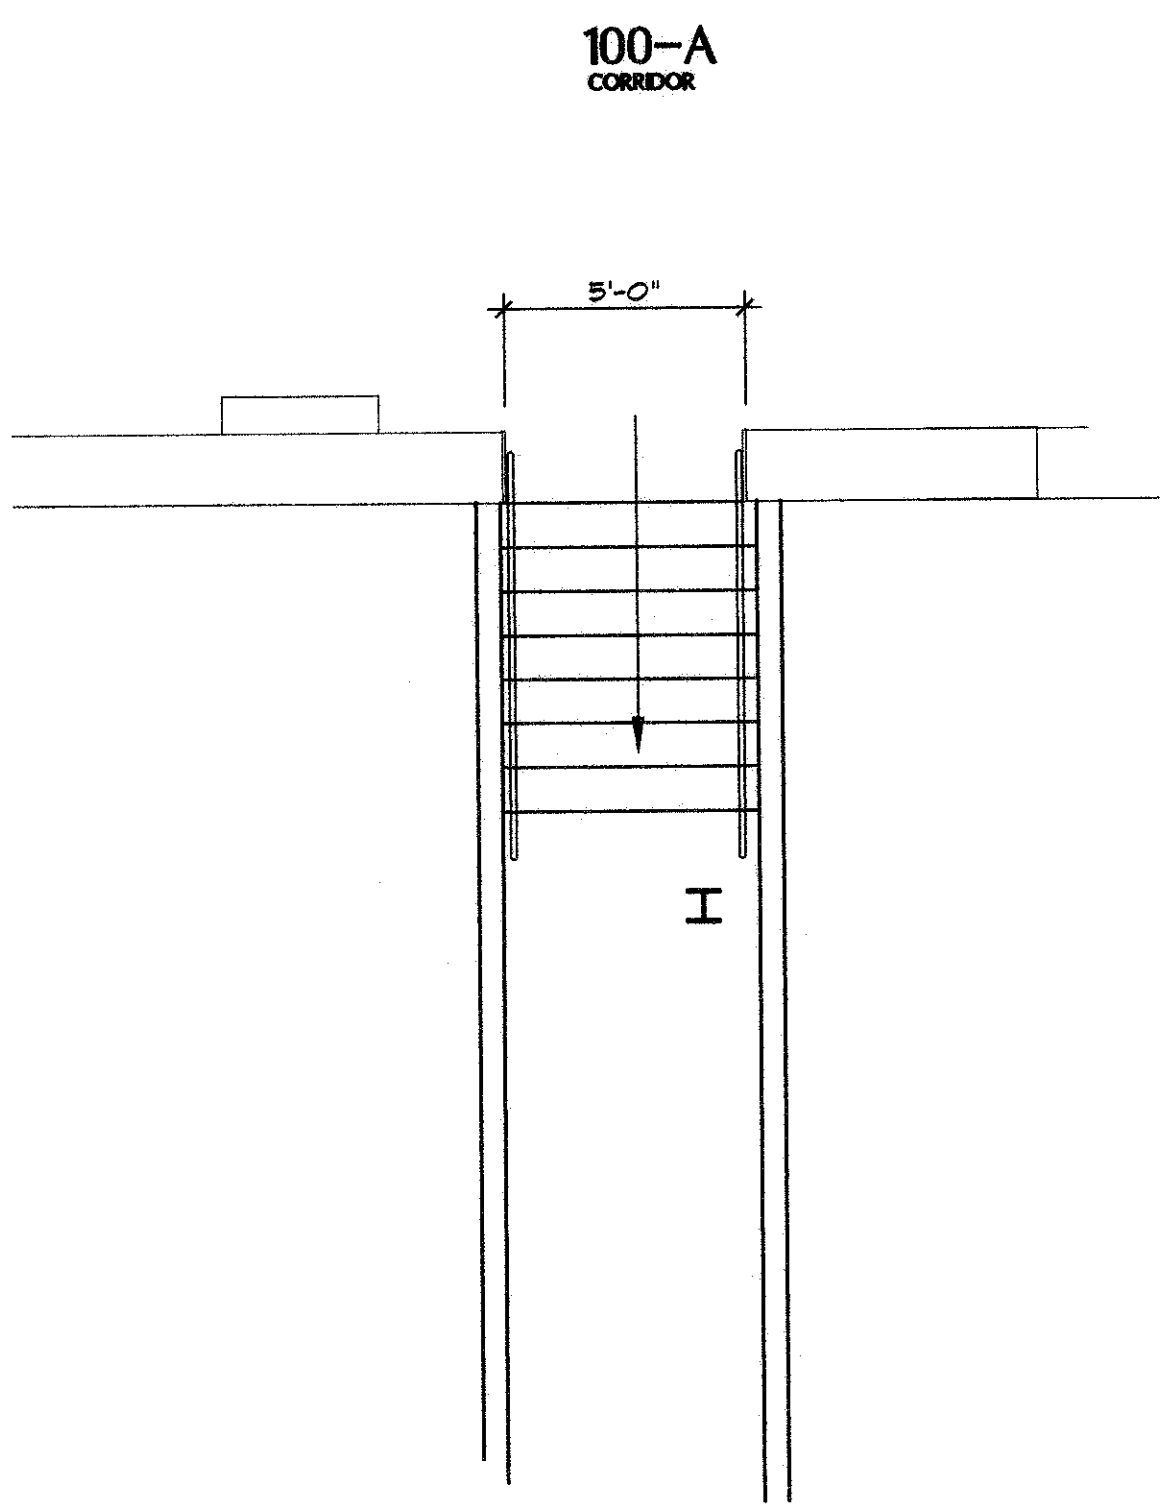

ENLARGED PLAN
SCALE: 1/4" = 1'-0"

AS-BUILT DRAWING 8/25/04

SHEET NO.
A-16a

DATE: 12/5/03
DRAWN BY: MLK
REVISIONS: 8/25/04

PROJECT:
**UNIVERSITY LOFTS
BOLIVAR STREET
LEXINGTON, KENTUCKY**

DRAWING:
ENLARGED STAIR PLANS

The McGoodwin Company
Commercial Real Estate
859-254-9934
201 PRICE ROAD LEXINGTON, KENTUCKY

MICHAEL L. KNOLL
ARCHITECT

346 South Main Street
Versailles, Kentucky 40383

Phone: 859-878-1900
Mobile: 859-621-5220
Email: mikescool-spaces.com

