


BUILDING SECTION  
SCALE 1/4" = 1'-0"

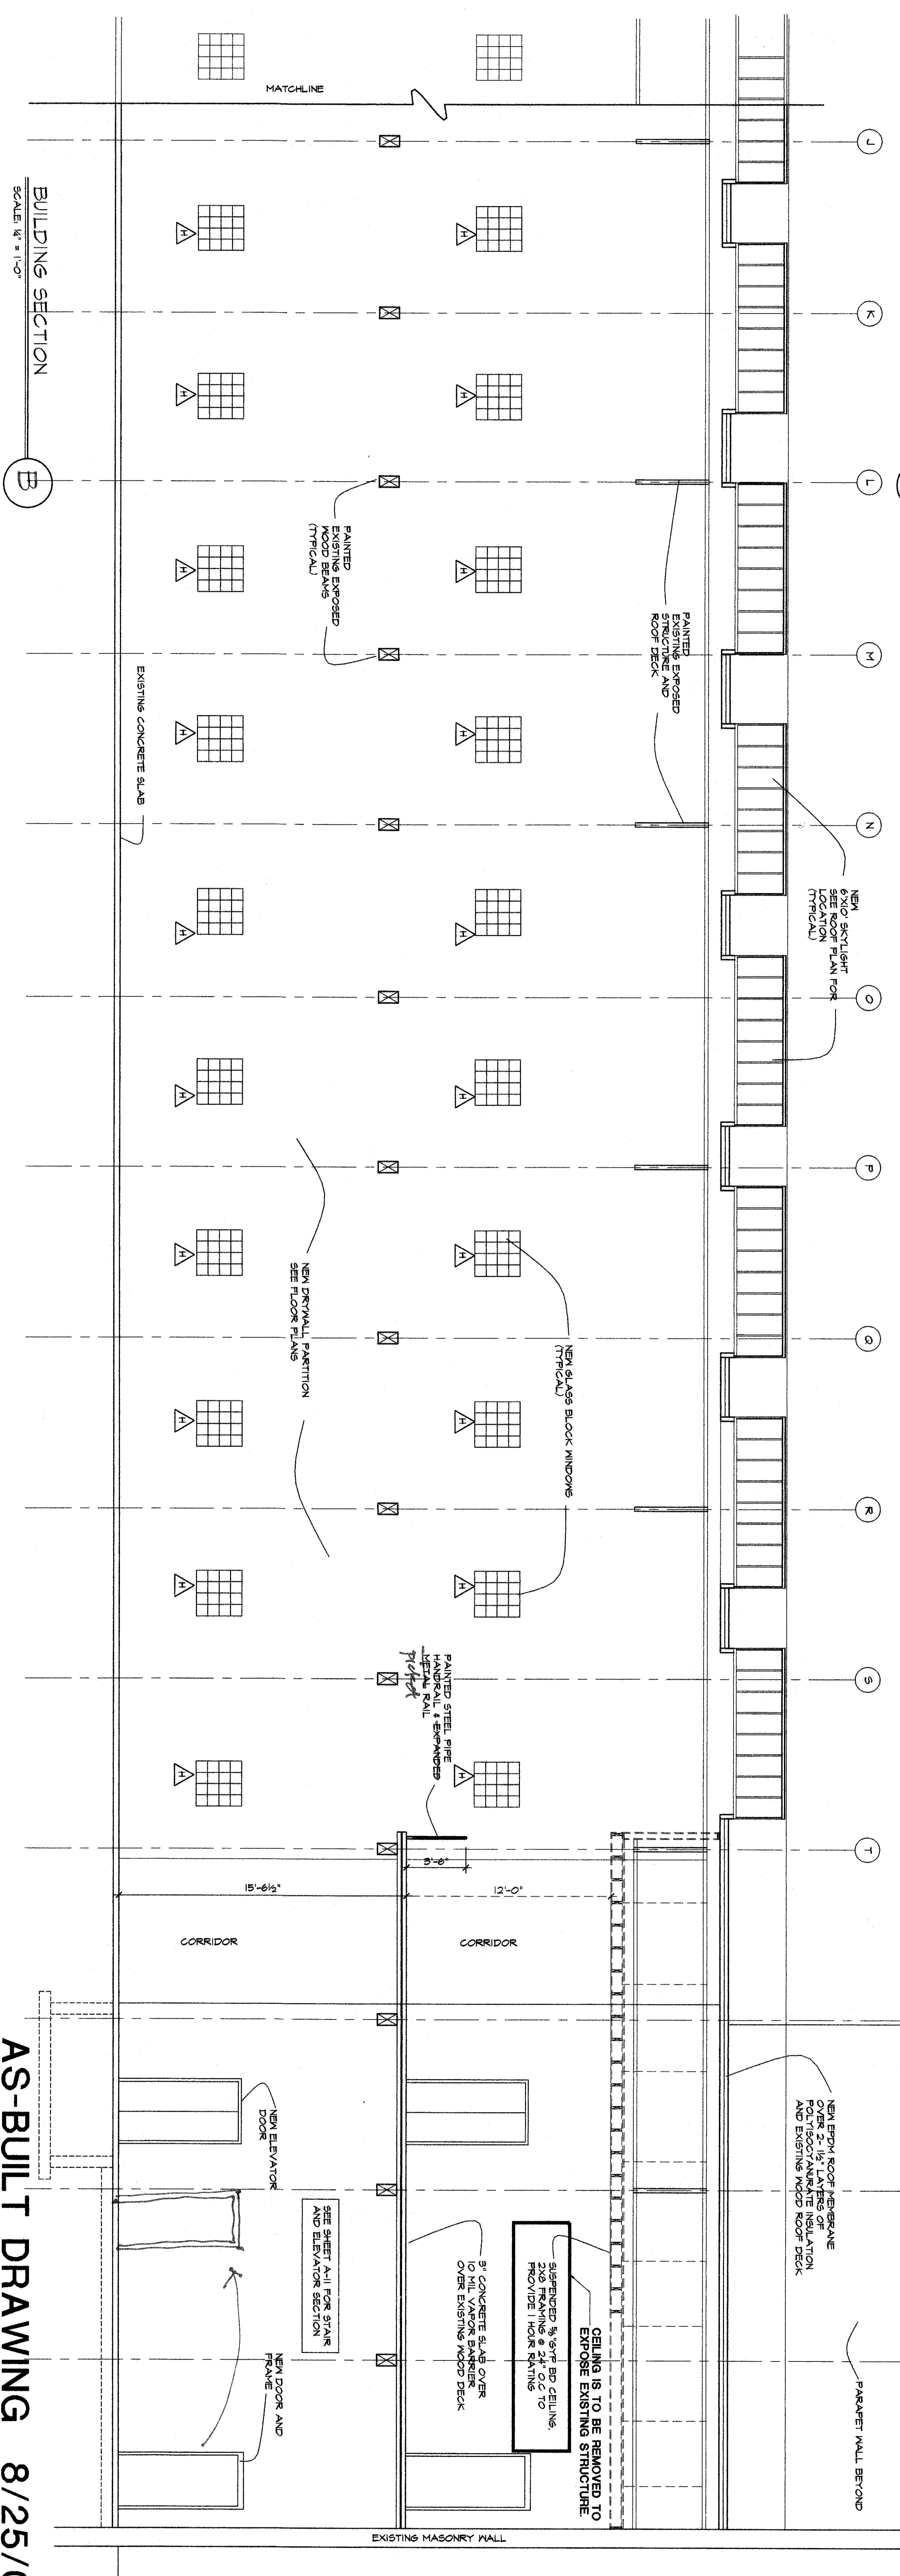

BUILDING SECTION  
SCALE 1/4" = 1'-0"

AS-BUILT DRAWING 8/25/04

SHEET NO. A-17

DATE: 1/10/03  
DRAWING: 8/10/04  
DRAWN BY: MLK  
8/25/04

PROJECT:  
**LEXINGTON LOFTS**  
200 BOLIVAR STREET  
LEXINGTON, KENTUCKY

DRAWING:  
**BUILDING SECTION**

**The McGowin Company**  
Commercial Real Estate

**HERRICK & ASSOCIATES**  
Consulting Engineers  
859 271 0483 LEXINGTON KY

DESIGN-ENGINEERING  
501 BROOKFARM COURT  
LEXINGTON, KY 40517  
O. DAVID PRESTON, P.E.

**MICHAEL L. KNOLL**  
ARCHITECT

348 South Main Street  
Versailles, Kentucky 40383  
Phone: 859-673-1900  
Email: 3mknoll@legte.net

