
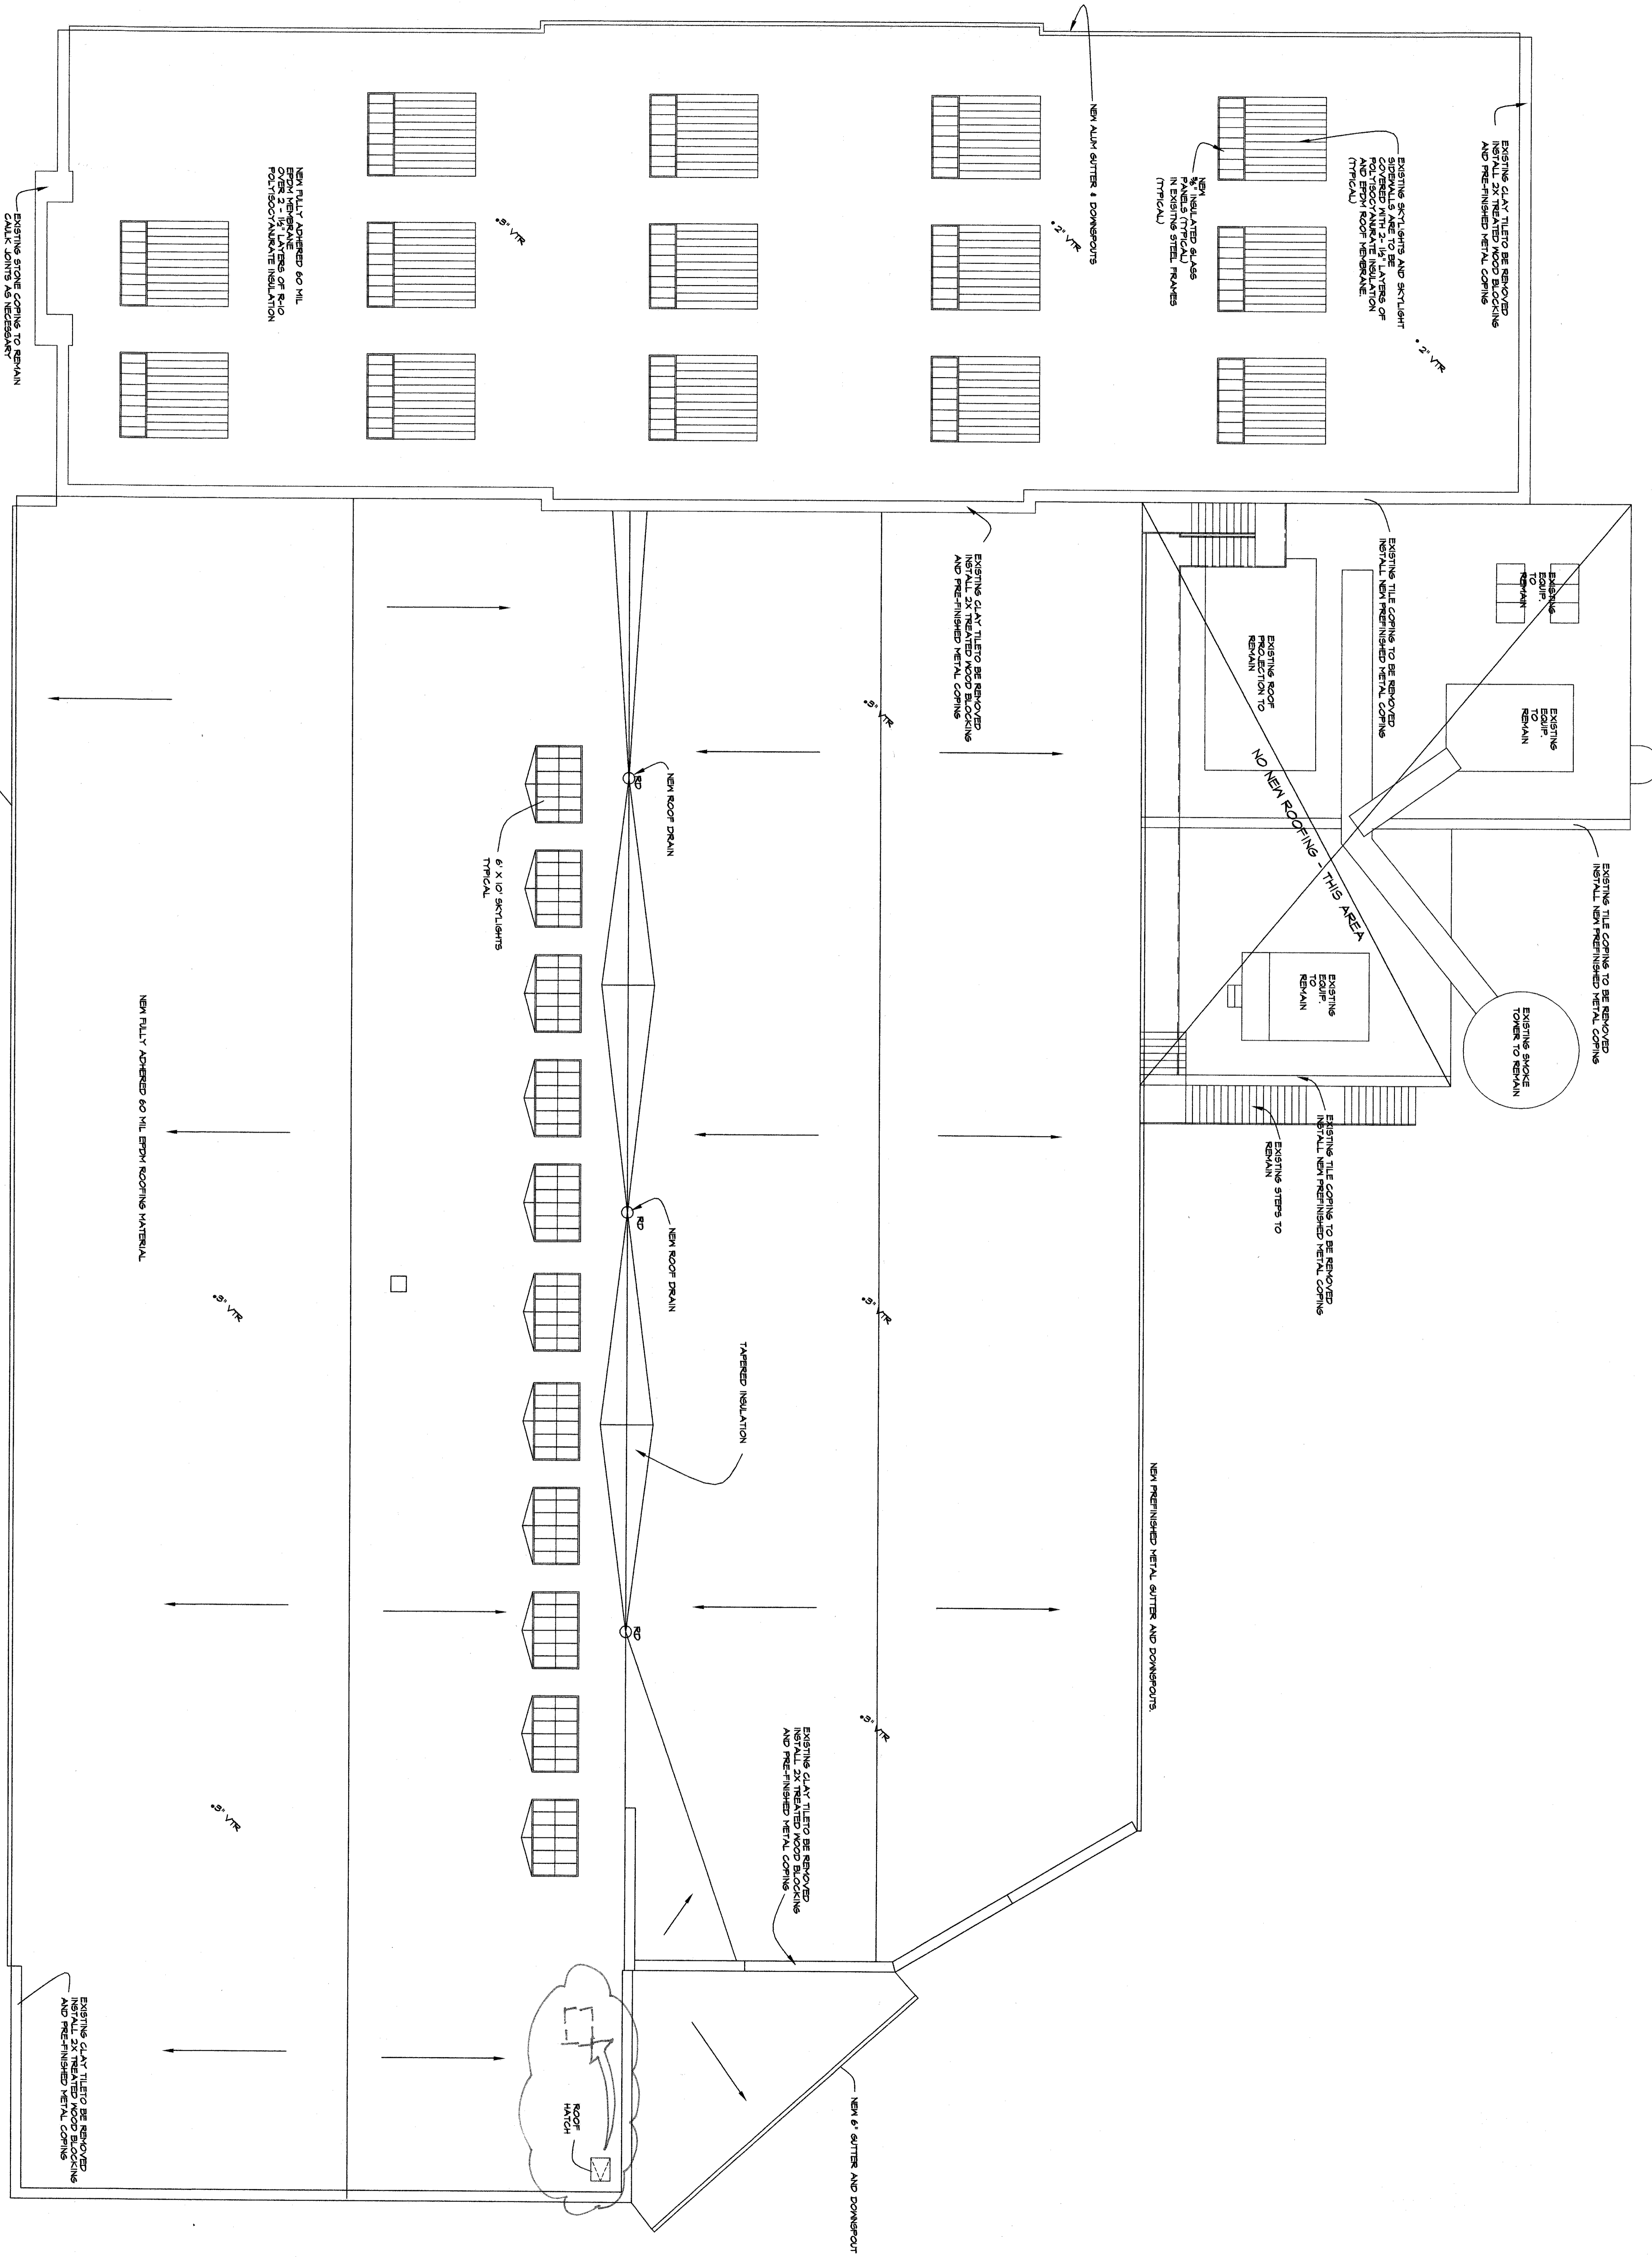


ROOF PLAN
SCALE 1/8" = 1'-0"

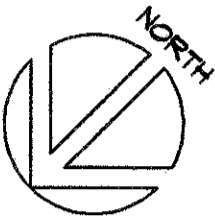

AS-BUILT DRAWING


NOTE:
SEE M-5 FOR MECHANICAL UNIT LOCATIONS


HUD Project No.


DATE: 9/05/02
DRAWN BY: MLK
REVISIONS:
10/1/02
1/0/03
6/25/04

PROJECT:
**LEXINGTON LOFTS
200 BOLIVAR STREET
LEXINGTON, KENTUCKY**
DRAWING:
ROOF PLAN


The McGowin Company
Commercial Real Estate

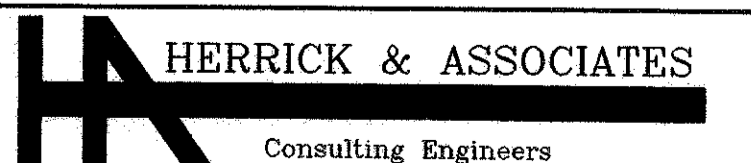
HERRICK & ASSOCIATES
Consulting Engineers
859 271 0483 LEXINGTON KY
DESIGN-ENGINEERING
501 BROOKFARM COURT
LEXINGTON, KY 40517
O. DAVID PRESTON, P.E.

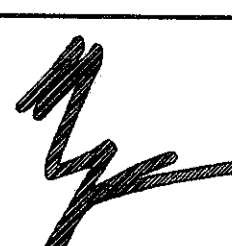
MICHAEL L. KNOLL
ARCHITECT
346 South Main Street
Versailles, Kentucky 40383
Phone: 859-878-1900
Email: 3mknoll@gte.net

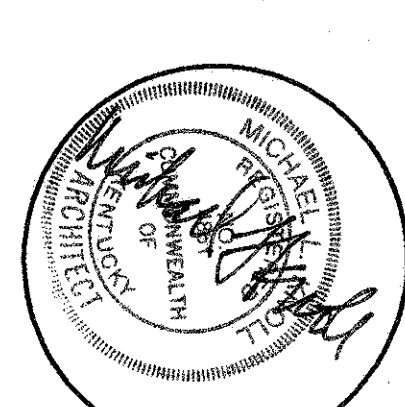

SHEET NO. **A-5**