


FRONT ELEVATION  
SCALE: 1/8" = 1'-0"

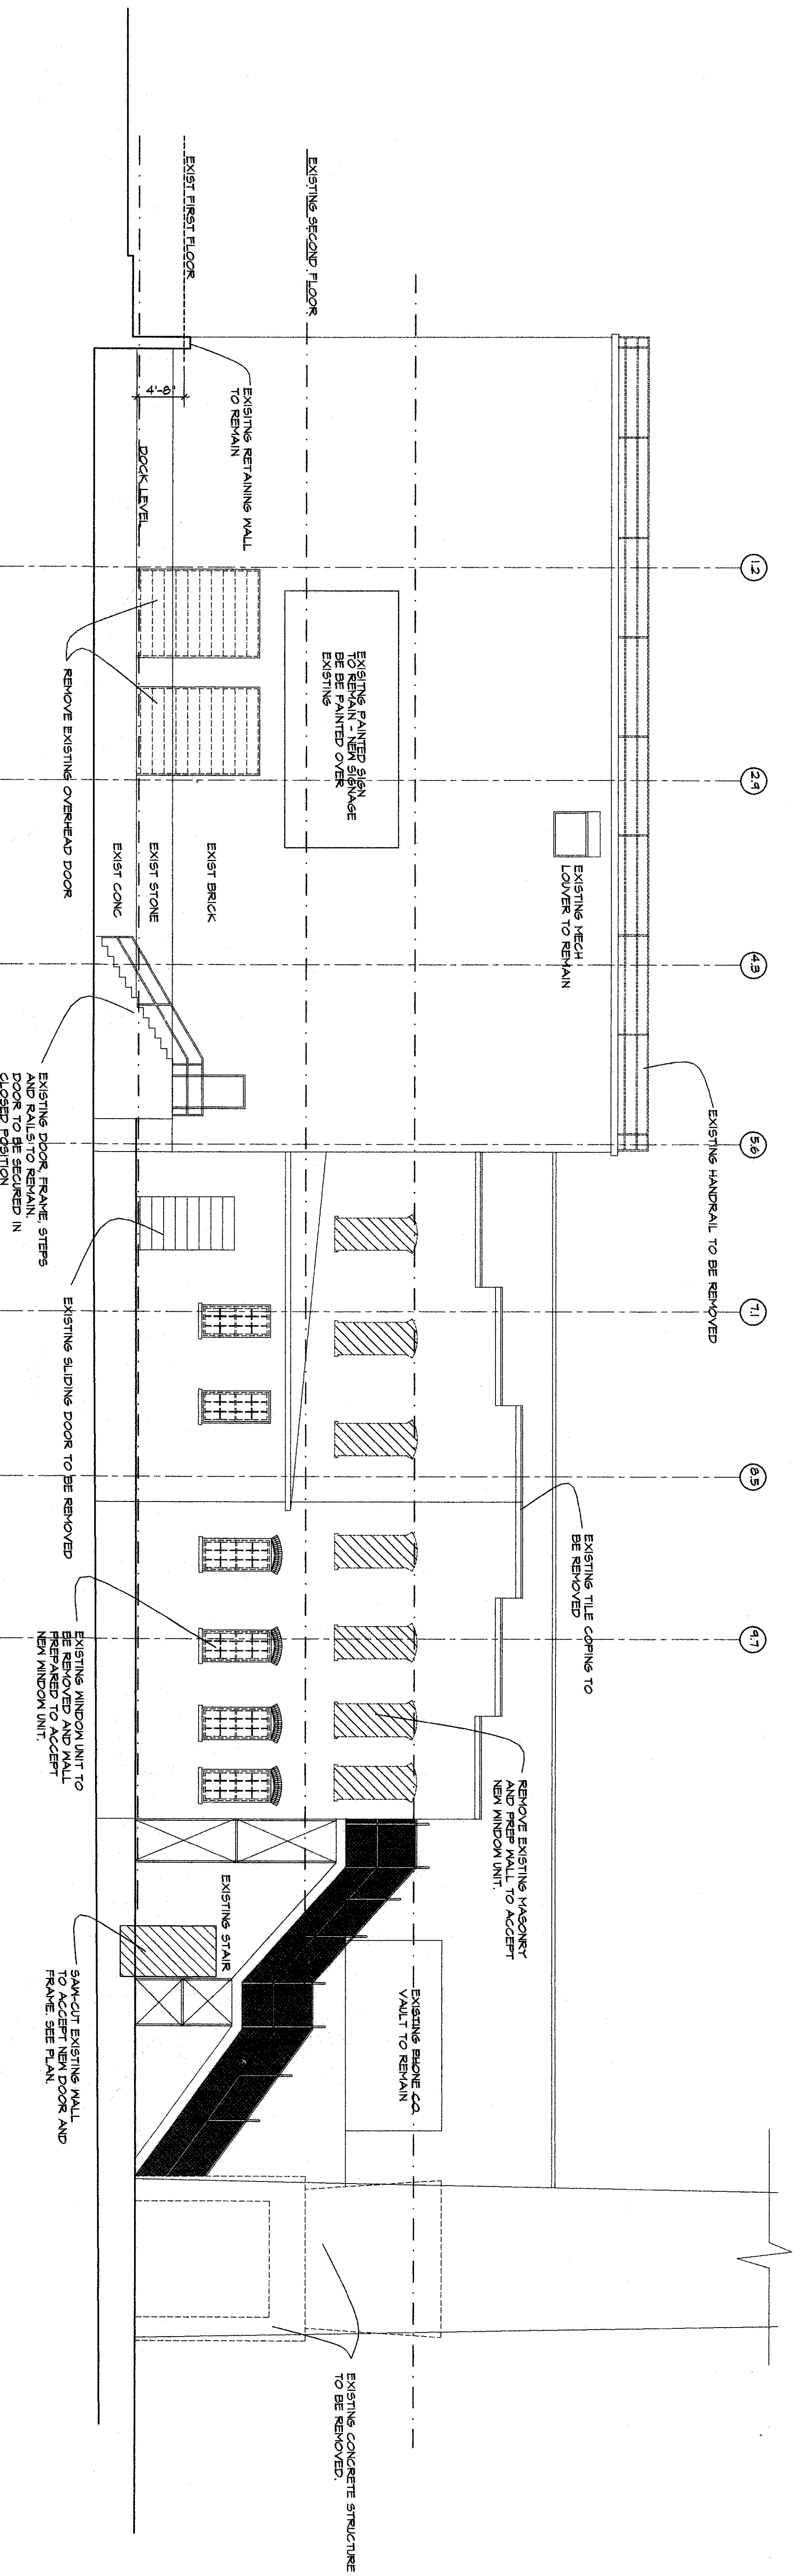

RIGHT SIDE ELEVATION  
SCALE: 1/8" = 1'-0"


AS-BUILT DRAWING 8/25/04

DATE	4/05/02
DRAWN BY	M.L.K.
REVISIONS	02/11/02
	11/01/03
	9/3/04
	8/25/04


PROJECT:  
**LEXINGTON LOFTS**  
200 BOLIVAR STREET  
LEXINGTON, KENTUCKY

DRAWING:  
**EXTERIOR ELEVATIONS**

  
**The McGoodwin Company**  
Commercial Real Estate

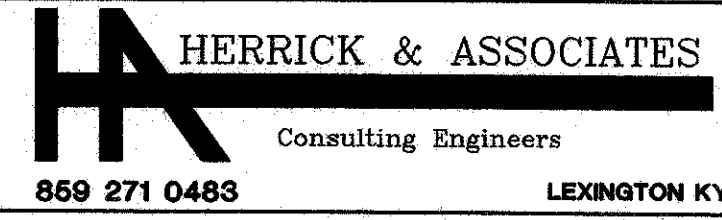  
**HERRICK & ASSOCIATES**  
Consulting Engineers  
859 271 0483 LEXINGTON KY

**DESIGN-ENGINEERING**  
LETT  
801 BROOKFARM COLLETT  
LEXINGTON, KY 40517  
O. DAVID PRESTON, P.E.

  
**MICHAEL L. KNOLL**  
ARCHITECT

348 South Main Street  
Versailles, Kentucky 40383

Phone: 859-673-1900  
Email: 3mcknoll@att.net



SHEET NO.  
**A-6**