


LEFT ELEVATION
SCALE: 1/4" = 1'-0"

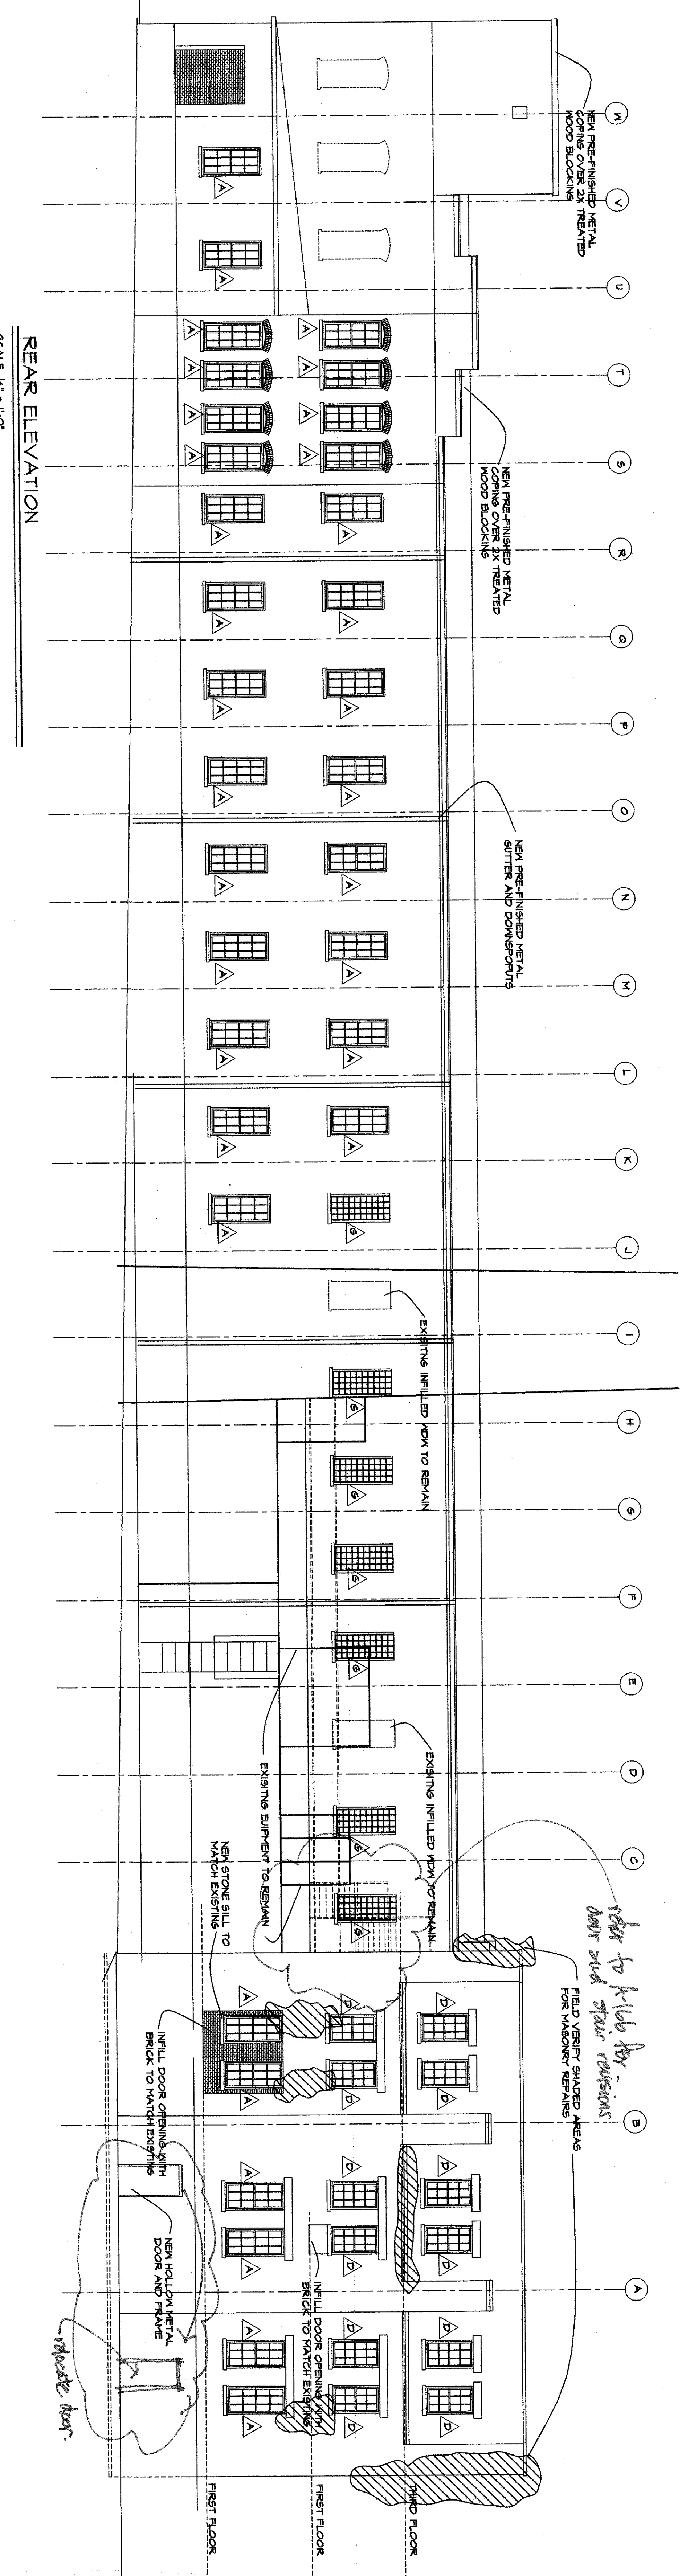


REAR ELEVATION
SCALE: 1/4" = 1'-0"


AS-BUILT DRAWING

HUD Project No.

DATE	9/03/02
DRAWN BY	VJK
REVISIONS	10/1/02 1/10/03 8/25/04
PROJECT	LEXINGTON LOFTS 200 BOLIVAR STREET LEXINGTON, KENTUCKY
DRAWING	EXTERIOR ELEVATIONS


The McGoodwin Company
 Commercial Real Estate


HERRICK & ASSOCIATES
 Consulting Engineers
 859 271 0483 LEXINGTON KY
 DESIGN-ENGINEERING
 501 BROOKFARM COURT
 LEXINGTON, KY 40517
 O. DAVID PRESTON, P.E.

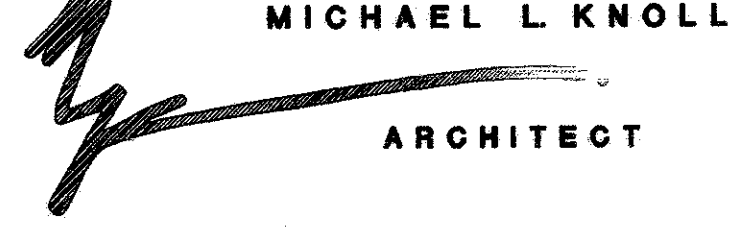
MICHAEL L. KNOLL
 ARCHITECT
 346 South Main Street
 Versailles, Kentucky 40383
 Phone: 859-873-1900
 Email: 3mcknoll@att.net

SHEET NO.
A-9

