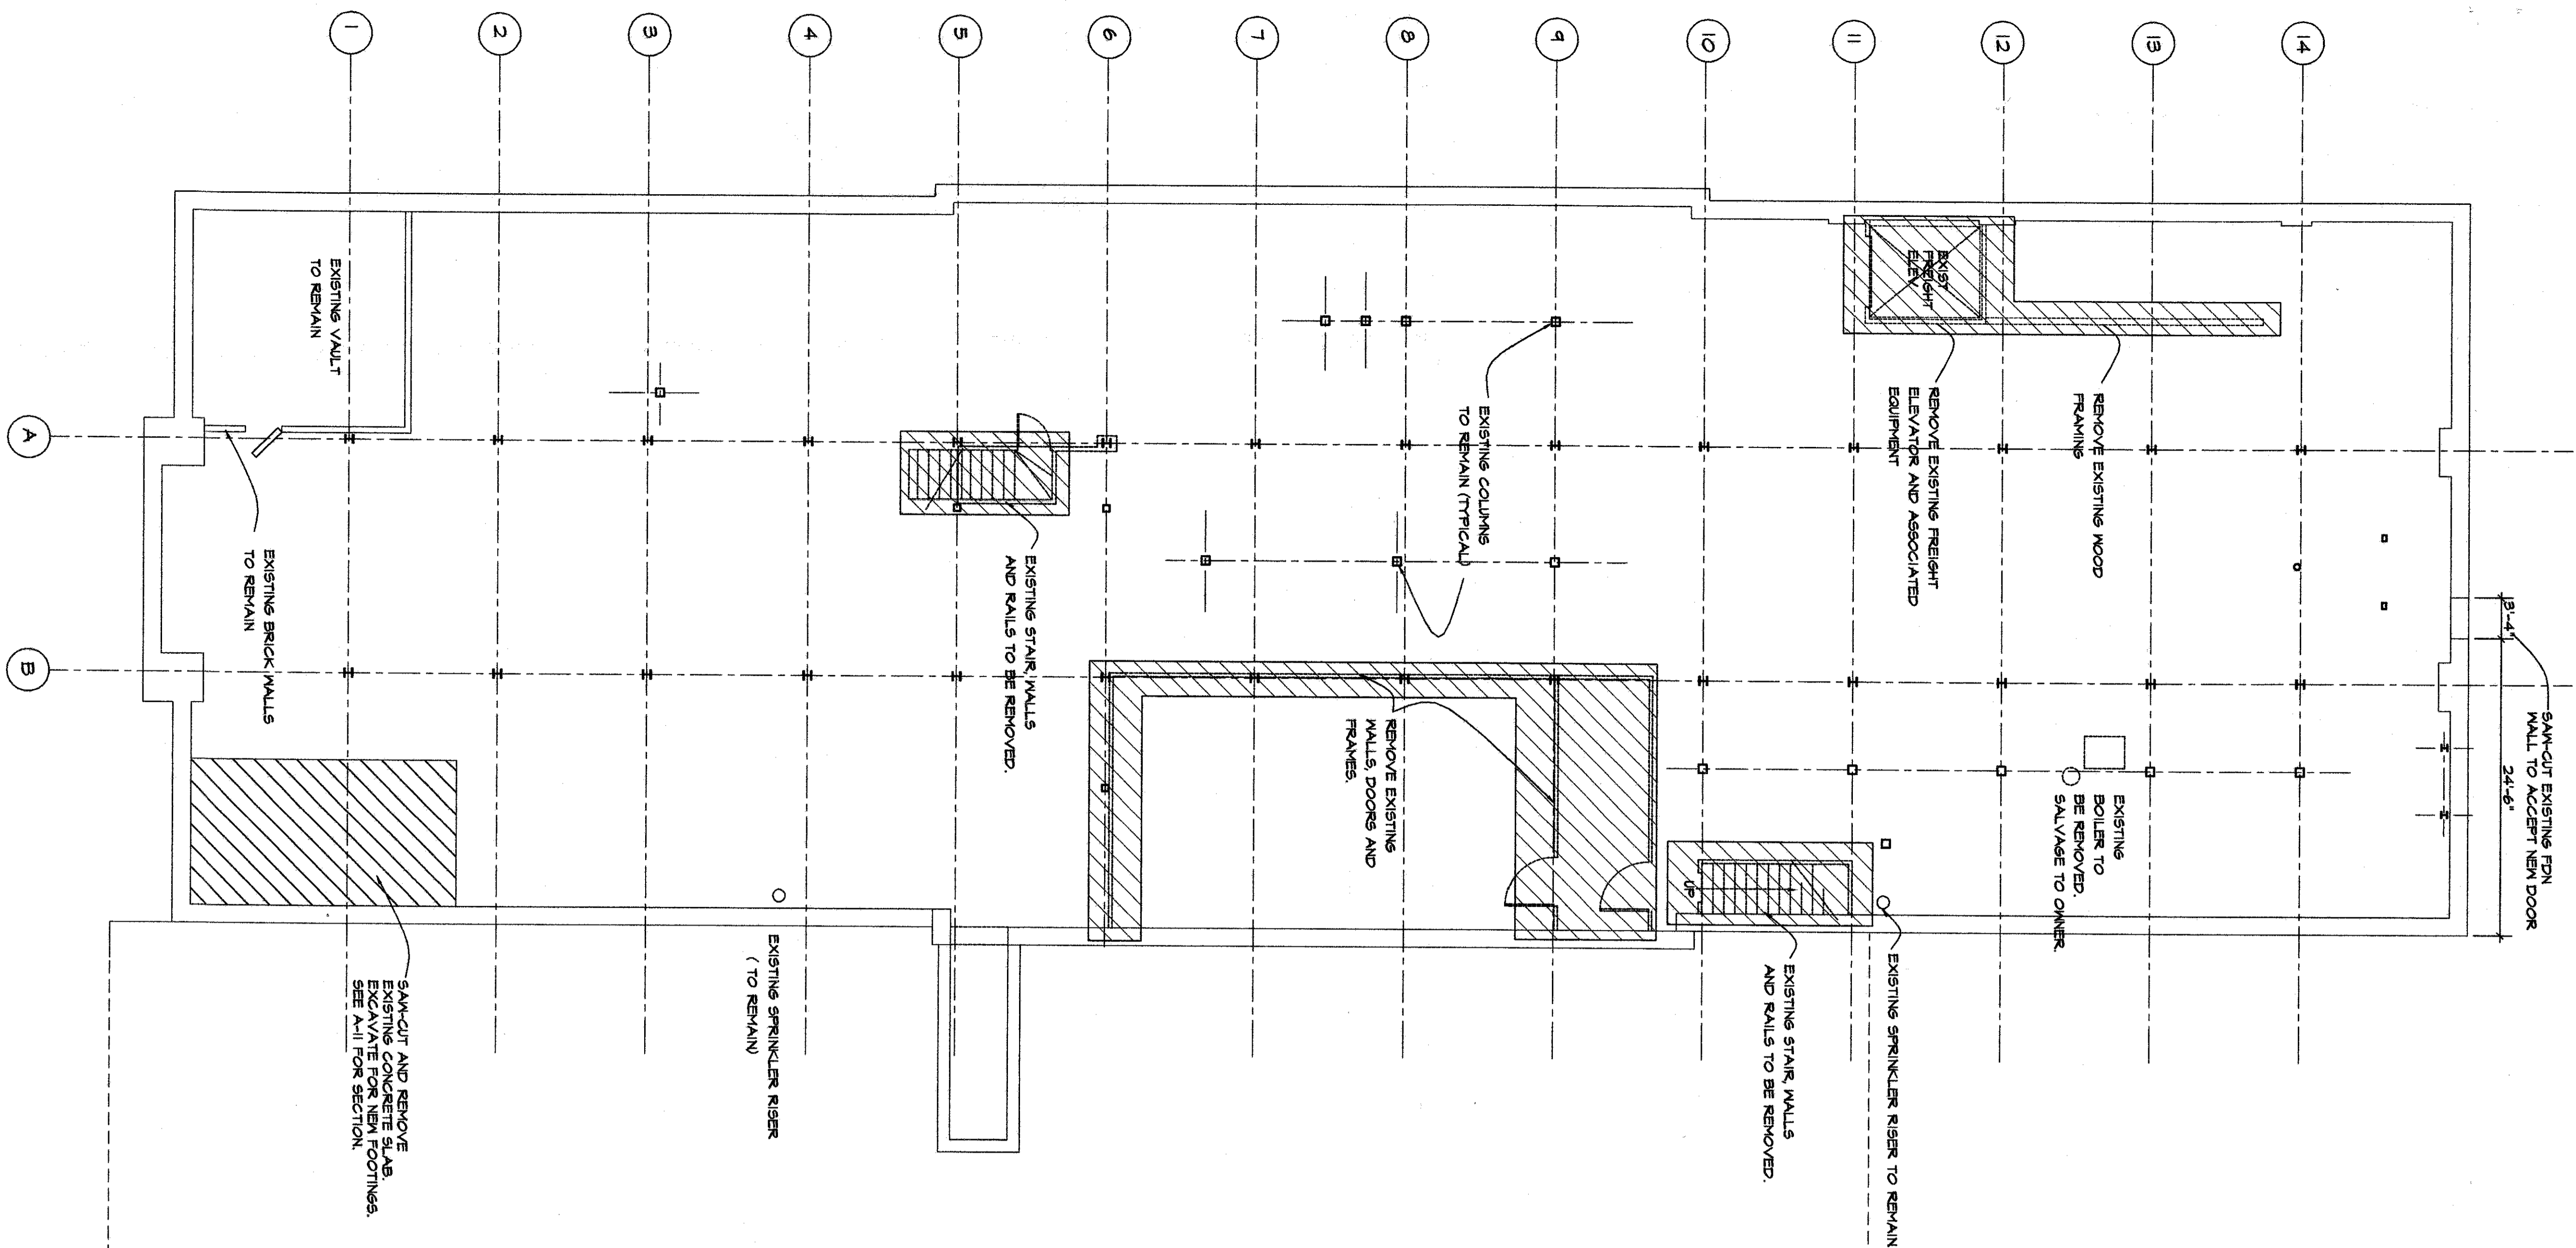


DEMOLITION NOTES

- ALL ABANDONED UTILITIES, PIPES, CONDUITS, FIXTURES, ARE TO BE REMOVED. ALL PIPE HANGERS, SUPPORTS AND FASTENERS ARE TO BE REMOVED. ALL DEMOLISHED MATERIALS ARE TO BE REMOVED FROM THE SITE IN A LAWFUL MANNER. MECHANICAL AND ELECTRICAL CONTRACTORS ARE RESPONSIBLE FOR THEIR RESPECTIVE TRADES DEMOLITION.
- ALL EXISTING COLUMNS ARE TO REMAIN UNLESS NOTED OTHERWISE.
- EXISTING INFILLED WINDOWS IN THIS AREA TO REMAIN.



BASEMENT DEMOLITION PLAN

SCALE: 1/8" = 1'-0"



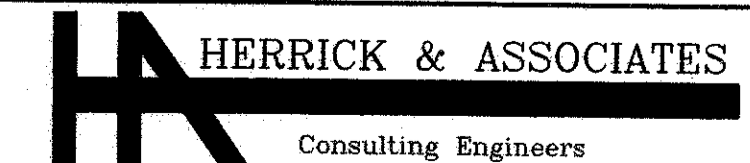
AS-BUILT DRAWING

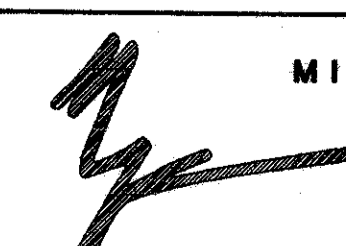
HUD Project No.

DATE	9/5/02
DRAWN BY	MJK
REVISIONS	10/1/02
	8/25/04

PROJECT:	LEXINGTON LOFTS 200 BOLIVAR STREET LEXINGTON, KENTUCKY
DRAWING:	BASEMENT DEMOLITION PLAN


The McGoodwin Company
 Commercial Real Estate


HERRICK & ASSOCIATES
 Consulting Engineers
 855 271 0483 LEXINGTON KY
 DESIGN-ENGINEERING
 501 BROOKFARM COURT
 LEXINGTON, KY 40517
 O. DAVID PRESTON, P.E.


MICHAEL L. KNOLL
 ARCHITECT
 346 South Main Street
 Versailles, Kentucky 40383
 Phone: 856-873-1900
 Email: 3mcknoll@qtz.net

D-1

SHEET NO.

