



- General Notes**
1. Wiring in public spaces to be in EMT unless otherwise noted
 2. Type LF-A lights to be chain hung below duct and feeder conduits; drop SD cable to light from jbox above
 3. In general, conduit serving corridor lighting and receptacles is to be run in corridor space (not through apartments). Branch circuit wiring is #12 unless otherwise noted
 4. Provide pull boxes as required on all panel feeder conduits
 5. Provide fire stopping at all floor penetrations
 6. Observe ADA restrictions in handicap apts. and Public areas
 7. Coordinate installation of TV wiring with Insight cable Co. (Ralph McDonie)

- Notes E2**
1. Verify location of tamper and flow switches with sprinkler contractor; provide conduit and wire to control panel
 2. System smoke detector
 3. Fire alarm manual pull station
 4. Fire alarm control panel with auto-dialer
 5. Single station smoke detector - typical in sleeping area of all loft units. Connect to arclinf fault breaker in apt. panel
 6. Exhaust fan
 7. Elevator equipment room
 8. 3 #6, gnd, 1-1/4" c
 9. IMC on building
 10. Route circuit through photocell controlled relay
 11. Relays for control of LF type G; use one for emergency circuit and the second for normal power circuit
 12. Photo cell control for relay(s) (notes 11,16)
 13. Exposed EMT - typical on old interior surfaces
 14. Type NMB cable - typical in new walls
 15. Drop exposed to device
 16. relay for control of LF type G
 17. Photo cell control for relay
 18. Loop 3-1/2' conduit between primary compartments
 19. 2 #8, #8 gnd, 3/4" c
 20. 6K water heater, 208v 1 ph
 21. #1 AWG conductor in 1-1/4" PVC-40 from telephone board to service ground
 22. Pad mounted transformer by KU; provide pad, ground rod and other accessories as required by KU. Provide spare 3-1/2" c
 23. 3-1/2" PVC-40 conduit buried 42'; provide rigid steel, long radius ell at each end; turn conduit up at riser pole. Verify all requirements with KU. Provide spare 3-1/2" c to pole
 24. KU primary service riser pole
 25. 4" PVC-40 telephone conduit; bury 36'; provide riser on pole
 26. Rise 48" on wall and LB through to Maintenance room. Provide 48"x72"x 3/4" plywood backboard
 27. 2" PVC-40 TV cable conduit; bury 30' min.; provide riser on pole; contractor to coordinate installation of apartment wiring for TV reception with Insight cable Co. (Ralph Mc Donie)
 28. Emergency generator; mount on concrete pad
 29. Underground secondary service to 'House' service equipment (MDP)
 30. Underground secondary service from transformers to MDBA and MDBB
 31. To breaker in apt panel
 32. 20 amp receptacle for washer
 33. 30 amp, 240/120 v, 3w plus ground receptacle for dryer
 34. Up to LF-F
 35. Distribution panel to be flush mounted and have hinged door
 36. To fire alarm control panel
 37. Transfer switch
 38. 3 #8, gnd, 3/4" c - typical for 4 dryers
 39. 40 amp, 240/120 receptacle; verify type with dryer installer - typical for 4

- Notes E4**
1. Verify location of tamper and flow switches with sprinkler contractor; provide conduit and wire to control panel
 2. Down to LF-H at 2nd level exit door
 3. Down to LF-A at second level
 4. 7'6" above stair tread
 5. Down to LF-F
 6. 100/3p NEMA 3R safety switch - disconnect for RTU heater (20 kw)
 7. 1/4 hp exhaust fan on roof
 8. 30/3p NEMA 3R safety switch - disconnect for RTU heat pump
 9. 3 #4, gnd, 1-1/4" c
 10. Roof top heat pump with strip heaters
 11. Weather proof GFI receptacle mounted on RTU housing
 12. 3#8, gnd, 1" c
 13. 3 #3, gnd, 1-1/4" c
 14. 3 # 6, gnd, 1-1/4" c
 15. 100/3p NEMA 3R safety switch - disconnect for RTU heater (24 kw)
 16. To fire alarm control panel

- Notes E3**
1. Verify location of tamper and flow switches with sprinkler contractor; provide conduit and wire to control panel
 2. Single station smoke detector - typical in sleeping area of all loft units. Connect to arcing fault breaker
 3. Smoke detector at top of shaft
 4. Heat detector at top of shaft
 5. Smoke detector in Lobby
 6. Interconnect fire alarm devices to provide necessary outputs to elevator controller for controlled descent destination and trip shunt trip breaker in control room (first level)
 7. LF J on top of exposed wood beams; provide 1" spacer off beam
 8. Mount LF H at 7'6" above walk level
 9. Mount LF H at 7'6" above landing
 10. Drop to LF H on catwalk
 11. 20/1p receptacle for washer
 12. 30/2p receptacle for dryer
 13. To 20/1p breaker in apt. panel
 14. To 30/2p breaker in apartment panel
 15. Down to elevator control panel and fire alarm panel
 16. Down to fire alarm panel
 17. Note deleted
 18. Down to fire alarm panel
 19. Photocell
 20. Up to LF-H at 3rd level exit door
 21. 1/4 hp exhaust fan on roof
 22. 100/3p NEMA 3R Safety switch - disconnect for heat circuit (20 kw)
 23. 30/3p NEMA 3R Safety switch - disconnect for heat pump
 24. Note deleted
 25. Note deleted
 26. Note deleted
 27. Note deleted
 28. LF-H lights are controlled by PE cell
 29. Note deleted
 30. Roof top AC unit
 31. 3 #6, #8 gnd, 1-1/4" c
 32. Motorized louver in atrium space
 33. Note deleted
 34. Weather proof GFI receptacle mounted on RTU housing
 35. Note deleted
 36. Up to LFA on 3rd level
 37. Tamper switch on sprinkler line to elevator shaft
 38. Down to LF-F

PLAN
SCALE: 1/8"=1'0"

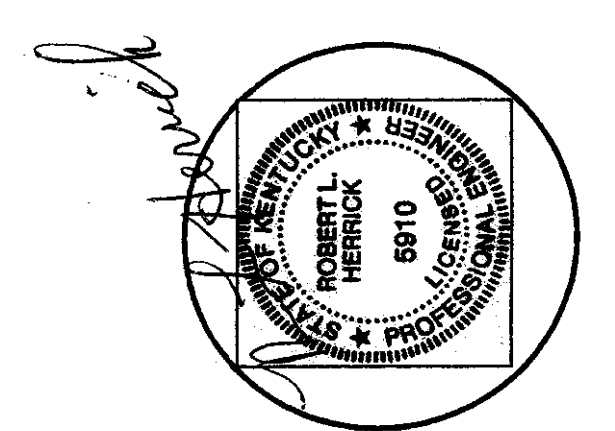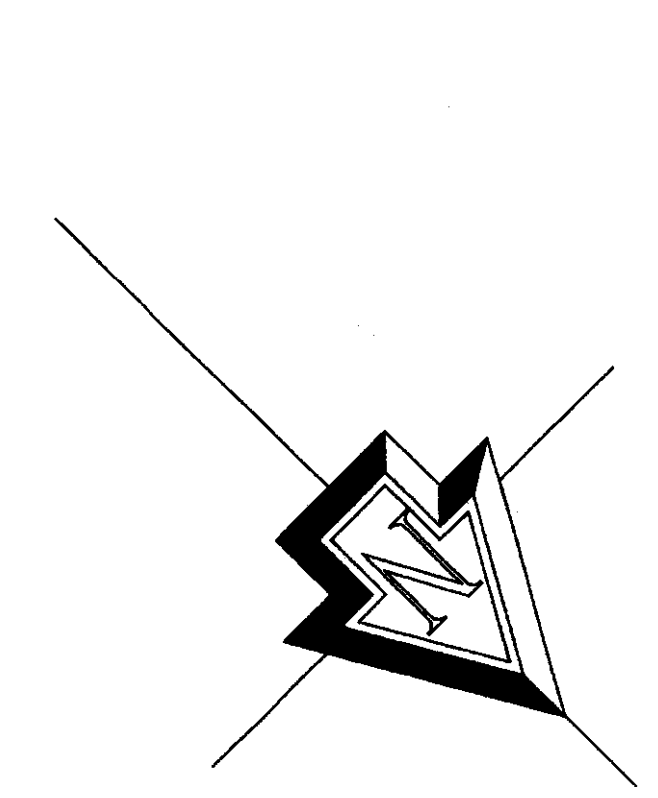

MICHAEL L. KNOLL
ARCHITECT
346 South Main Street
Versailles, Kentucky 40389
Phone 502-672-1000
Fax 502-672-1000

HERRICK & ASSOCIATES
Consulting Engineers
LEXINGTON, KY
859 271-1483

The McGowin Company
Commercial Real Estate

PROJECT: LEXINGTON LOFTS
200 BOLIVAR STREET
LEXINGTON, KENTUCKY
DRAWING: THIRD FLOOR ELECTRICAL PLAN

DATE	1/10/03
DRAWN BY	LF
REVISIONS	

SHEET NO.
E-4