



많	19	17	15	ដ	11	9	7	5	ယ	_	circuit			
			20/1	20/1	20/1	20/1	720/1	5 20/1	3 20/1	20/1	함			
space	space	space	spare	spare	recep in maintenance	spare	spore	Maintenance on lights	Coridor lits 1st fl south	Coridor lits 1st fl south	load served			
											surface mount	100 AMLD	208/120 3ph, 4w	PANELBOARD
Space	Space	space	space	spare	N-S corridor recep	recep in maintenance rm	Elevator rm.	Elevator rm.	North carridor recep	N-S running corr, receptackers	load served	lkaic		HPA
				PBS.	20/1	28/1	20/1	<u>1</u>	20/1	1 ASS	콥		 	
ಜ	23	8	16	14	ಸ	5	6 00	6	4	ro	circuit			

	100		3								***		***		3			
 ည	27	25	සු	ಣ	19	17	15	13		9		5		_	circuit			
							20/1	7.03	***	40/2	***	5 40/2	※ ※※	40/2	trip			
space	spoce .	space	space	space	Sp0.ce	space	washer	washer	***	water heater	***	commercial dryer	米米米	commercial dryer	load served			
 n. (n. 21)															flush mount	225 AMLII	208/120 3ph, 4w	PANEL BUARD (
space	space	space	space	space	space	space	washer	washer	***	water heater	***	commercial dryer	**	commercial dryer	load served	10 Kalc		HB)
							282	20/1	**	40/2	業業業	40/2	業業業	40/2	trip			
జ	28	26	24	23	ස	188		14		10	***	6	***	N	circult			

±	39	37	ည	జ	31	29	27	<u>D</u>	జ్ఞ	21	- 19	17	15	ಏ	Ħ	9	7	S	ω	<u>.</u>	rcult			
***	39 ***	37 100/3	35 ***	33 ***	31 80/3	29 ***	27 ***	25 175/3	23 ***	***	50/3	**	***	200/3	***	9 ***	7 200/3	5 ***	3 ***	100/3	참			
		Rtu-3 heater			RTU-1 heater	***	***	Elevator 25 hp	瀬米米	***	RTUS	***	米米米	Panel HPD	***	***	Panel HP3	₩ ₩ ₩	***	Panel HPA	load served			
																					surface mount	UL listed/labeled as service equipment	1000/3p main breaker	coorier ohit au
			***	***	RTU-2 heater	***	***	200/3p space only	***	****	RIUE	***	***	RTUI	***	****	Panel E	***	****	Panel HPW	load served	equipment	25 kaic	
									***	***	40/3	**	***	40/3	***	***	40/2	***	米米	250/3	trip			
42	46	38 88	೫	34	R3	జ	28	25	24	ಜ	20	18	16	14	ស	10	8	6	4	ro.	circuit			
				— -					- -							,								


_			**		**	Γ		Γ	Г	Γ			Ι		<u>Q</u>	,			I	1	=	9	7	5	ယ	jundo .	uit				
ည္ရ		CH CH	采	많	**	17	15	ಟ	=	و	7	ហ	ω		circuit							282	20/1	5 20/1	3 20/1	20/1	trip				
	***	25 40/2	***	40/ 2	***	40/2		7,082	20/1	20/1	20/1	5 20/1	3 20/1	20/1	핳						space	spare	1st	ist	lites	base	load	4			_
CDUCO	**	water heater	* *	connercial dryer	***	commercial dryer	spare	receptacle	spare	spare	spare	spare	lights in basement	lights in basement	load served						'n	rố	1st fl corridor	ist fi corridor	lites in maint	basement lights	load served				
				er		er.							nent	nent													surfa		60/2p	240/1	FANEL
																	400 AMLO	208/120 3ph, 4w	PANELBOARD								surface mount		60/2p main breaker	240/120 1 ph	PANELIBUARU
																		1			spare	1st fl c	1st fl corridor	2nd fil corridor	2nd fi c	type H	load served		10kaic		Fr
g Juus	space	***	water heater	***	connercial dryer	***	commercial dryer	spare	spare	spare	washer	washer	Washer	washer	load served		10kaic		HPW			corridor	orridor		d t	type H on catwalk	ved.				
																					1/02	28	282	20/1	Cor Back	20/1	trip				
		***	40/2	***	40/2	***	40/2	20/1	20/1	20/1	20/1	1705	20/1	20/1	쿻						-	-		_			circuit				
<u>ء</u>	ಜ		24	**	20	***	16	14	ಸ	5	8	6	4	2	chcult						ਲ	5	<u>@</u>	6	4-	ro	u#				

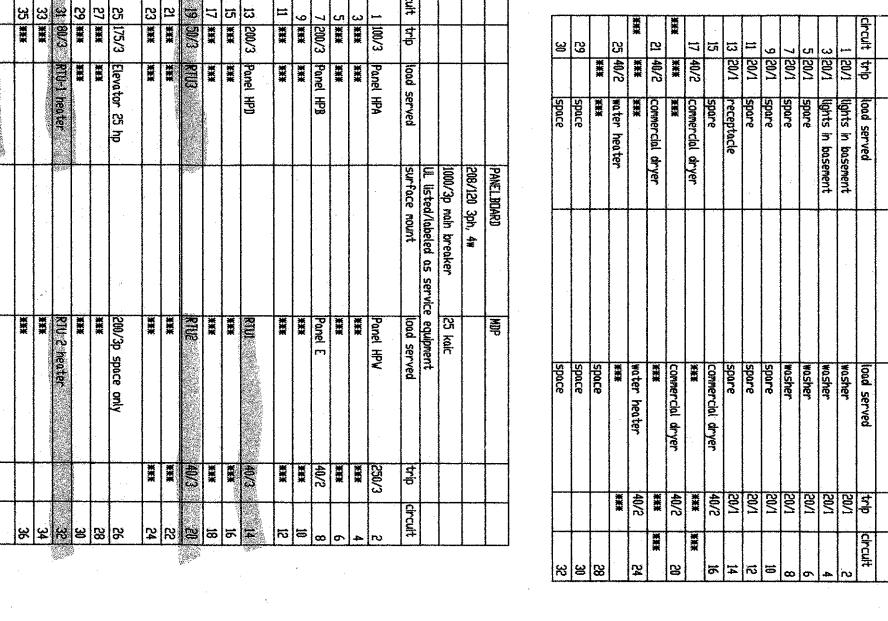

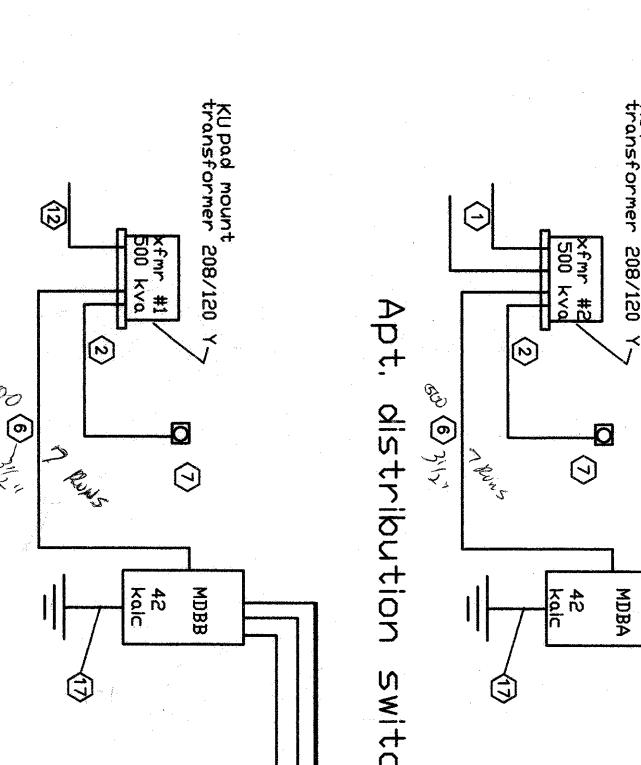

MDBA

DP6

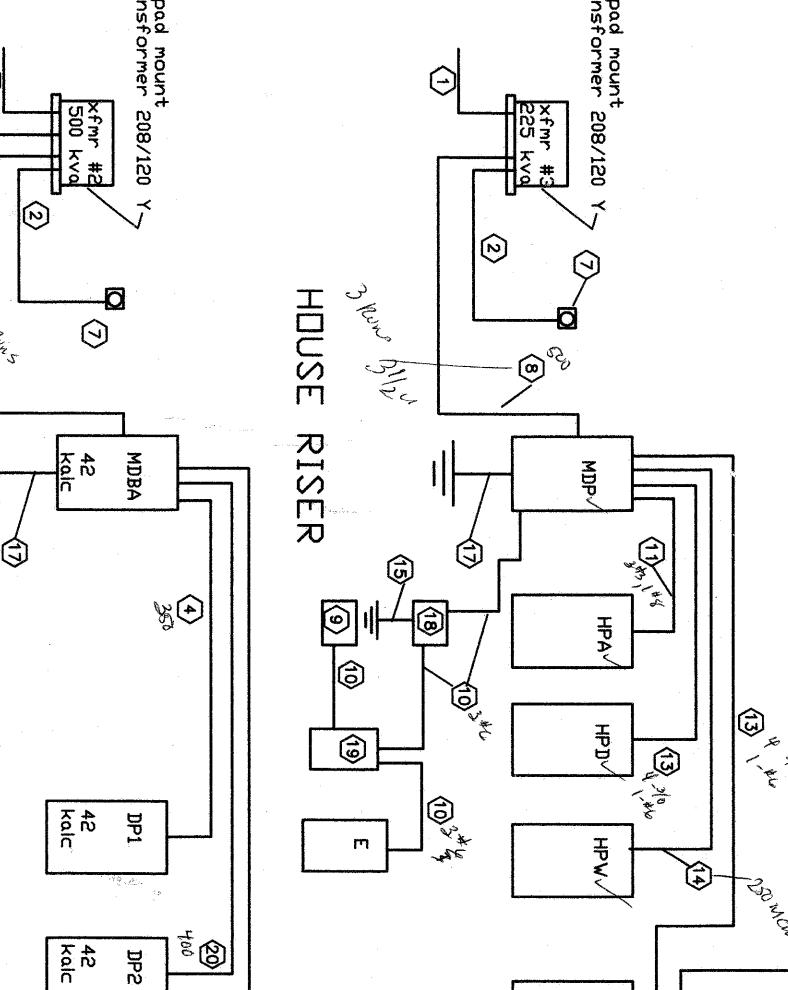

distribution hboard

MDBB

, 240/120 v 1 roof housing

AS-BUILT DRAWING

