
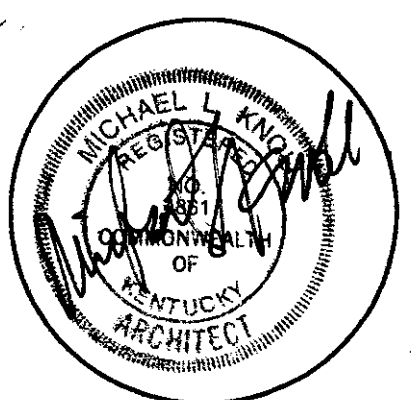


AS-BUILT DRAWING

PHOTO KEY PLAN  
NTS

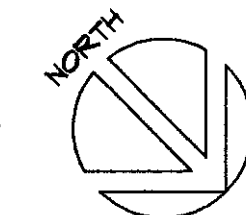

**MICHAEL L. KNOLL**  
ARCHITECT  
348 South Main Street  
Versailles, Kentucky 40383  
Phone: 859-273-1800  
Email: Smlknoll@legnet.net

**HERRICK & ASSOCIATES**  
Consulting Engineers  
LEXINGTON KY  
859 271 0483  
DESIGN-ENGINEERING  
501 BROOKFARM COURT  
LEXINGTON, KY 40517  
O. DAVID PRESTON, P.E.

**The McGoodwin Company**  
Commercial Real Estate

PROJECT:  
**LEXINGTON LOFTS  
200 BOLIVAR STREET  
LEXINGTON, KENTUCKY**  
DRAWING:  
**PHOTO KEY PLAN**

DATE: 9/31/09  
DRAWN BY: MLK  
REVISIONS:  
8-25-04

SHEET NO.  
**K-1**

Cal # S10t  
234 A-1  
34183