


RECEIVED  
JUN 09 2003

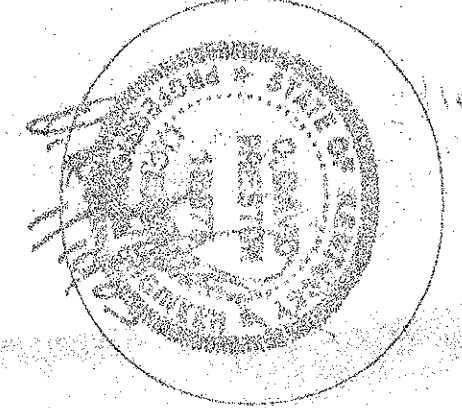

MICHAEL L. KNOLL  
ARCHITECT  
346 South Main Street  
Versailles, Kentucky 40383  
Phone: 659-673-1000  
Email: Mknoll@tgs.net

HERRICK & ASSOCIATES  
Lexington, KY  
859 271 0483  
DESIGN-ENGINEERING  
501 BROOKFARM COURT  
LEXINGTON, KY 40517  
D. DAVID PRESTON, P.E.

The McGoodwin Company  
Commercial Real Estate

PROJECT:  
McGOODWIN DEVELOPMENT  
LEXINGTON LOFTS  
200 BOLIVAR STREET  
LEXINGTON, KENTUCKY  
DRAWING:  
BASEMENT VENTILATION PLAN

DATE: 1/7/03  
DESIGNED BY: MILK  
CHECKED BY: MILK  
SHEET NO. 1  
HVAC NOT REVISIONS

Lexington Loft Apartments  
HVAC Equipment - Unit Counts

Table with columns: Room Number, Air Handler Number, Air Handler Model Number, Heater, Min. Circuit Amps, Max. Breaker, Heat (KW), Heat Pump Number, Heat Pump Model Number, Min. Circuit Amps, Max. Breaker. Rows 101-307.

Table with columns: Unit, Tonnage, Equipment Schedule. Rows 15.1, 26.3, 38.4 TON IN ONLY.

1. Return & Supply Registers (Verify color with Architect)

Mfg	Model	Size	Usage	Comments
Camco	RS128	17x28"	Return	Horizontal Return Grill, Verify color with Architect.
Camco	RS128	12x10"	Supply	Horizontal Return Supply Grill, Verify color with Architect.
Camco	RS128	12x8"	Supply	Horizontal Return Supply Grill, Verify color with Architect.
Camco	RS128	24x8"	Supply	Common Area Supply Grill, Verify color with Architect.

GRILL SCHEDULE  
1.154...  
2. This...  
3. Coordinate...  
4. Drawings...  
5. UNO...  
6. UNO...  
7. Coordinate...  
8. Coordinate...  
9. Provide...  
10. UNO...  
11. Provide...  
12. Coordinate...  
13. Mount...  
14. Draw...  
15. ADA...

2. Programmable Thermostat  
YORK HVAC ROOF TOP UNITS

Mark	Size	Model	BTUH	SEER	Watt/HP	Phase	Notes					
RTU1	4 Ton	A04	48	150	12.1	208	28	1	40	3	585	182
RTU2	4 Ton	A04	48	150	12.1	208	28	1	40	3	585	182
RTU3	5 Ton	A090	60	200	12.1	208	32	1	50	3	585	182

MECHANICAL EQUIPMENT  
Roof Top Heating & Cooling Equipment Schedule

Mark	Mfg	Model	CFM	S.P.	Volts	Ph	Notes	Service Area	
EH-1	Greenheck	BSC-100-4	840	0.125	120	1	1.6	Separate hood return, hood-start damper & hood screen	Ball Room Exhaust
EH-2	Greenheck	BSC-100-4	840	0.125	120	1	1.6	Separate hood return, hood-start damper & hood screen	Ball Room Exhaust
EH-3	Greenheck	BSC-100-4	840	0.125	120	1	1.6	Separate hood return, hood-start damper & hood screen	Ball Room Exhaust
EH-4	Greenheck	BSC-100-4	840	0.125	120	1	1.6	Separate hood return, hood-start damper & hood screen	Ball Room Exhaust
EH-5	Greenheck	BSC-100-4	840	0.125	120	1	1.6	Separate hood return, hood-start damper & hood screen	Ball Room Exhaust
EH-6	Greenheck	BSC-100-4	840	0.125	120	1	1.6	Separate hood return, hood-start damper & hood screen	Ball Room Exhaust

