

MICHAEL L. KNOLL
ARCHITECT
346 South Main Street
Versailles, Kentucky 40383
Phone: 859-673-1900
Email: mknoll@tgn.net

HERRICK & ASSOCIATES
LEXINGTON, KY
DESIGN-ENGINEERING
501 BRECKENRIDGE COURT
LEXINGTON, KY 40502
L. JACOB ERNSTON, P.E.


The McGoodwin Company
Commercial Real Estate

PROJECT: MCGOODWIN DEVELOPMENT
LEXINGTON LOFTS
200 BOLIVAR STREET
LEXINGTON, KENTUCKY
DRAWING: BASEMENT SANITARY SEWER PLAN

DATE: 1/10/03
DRAWN BY: MLK
REVISIONS:

SHEET NO.
P-1

Doc # 34229
C-1

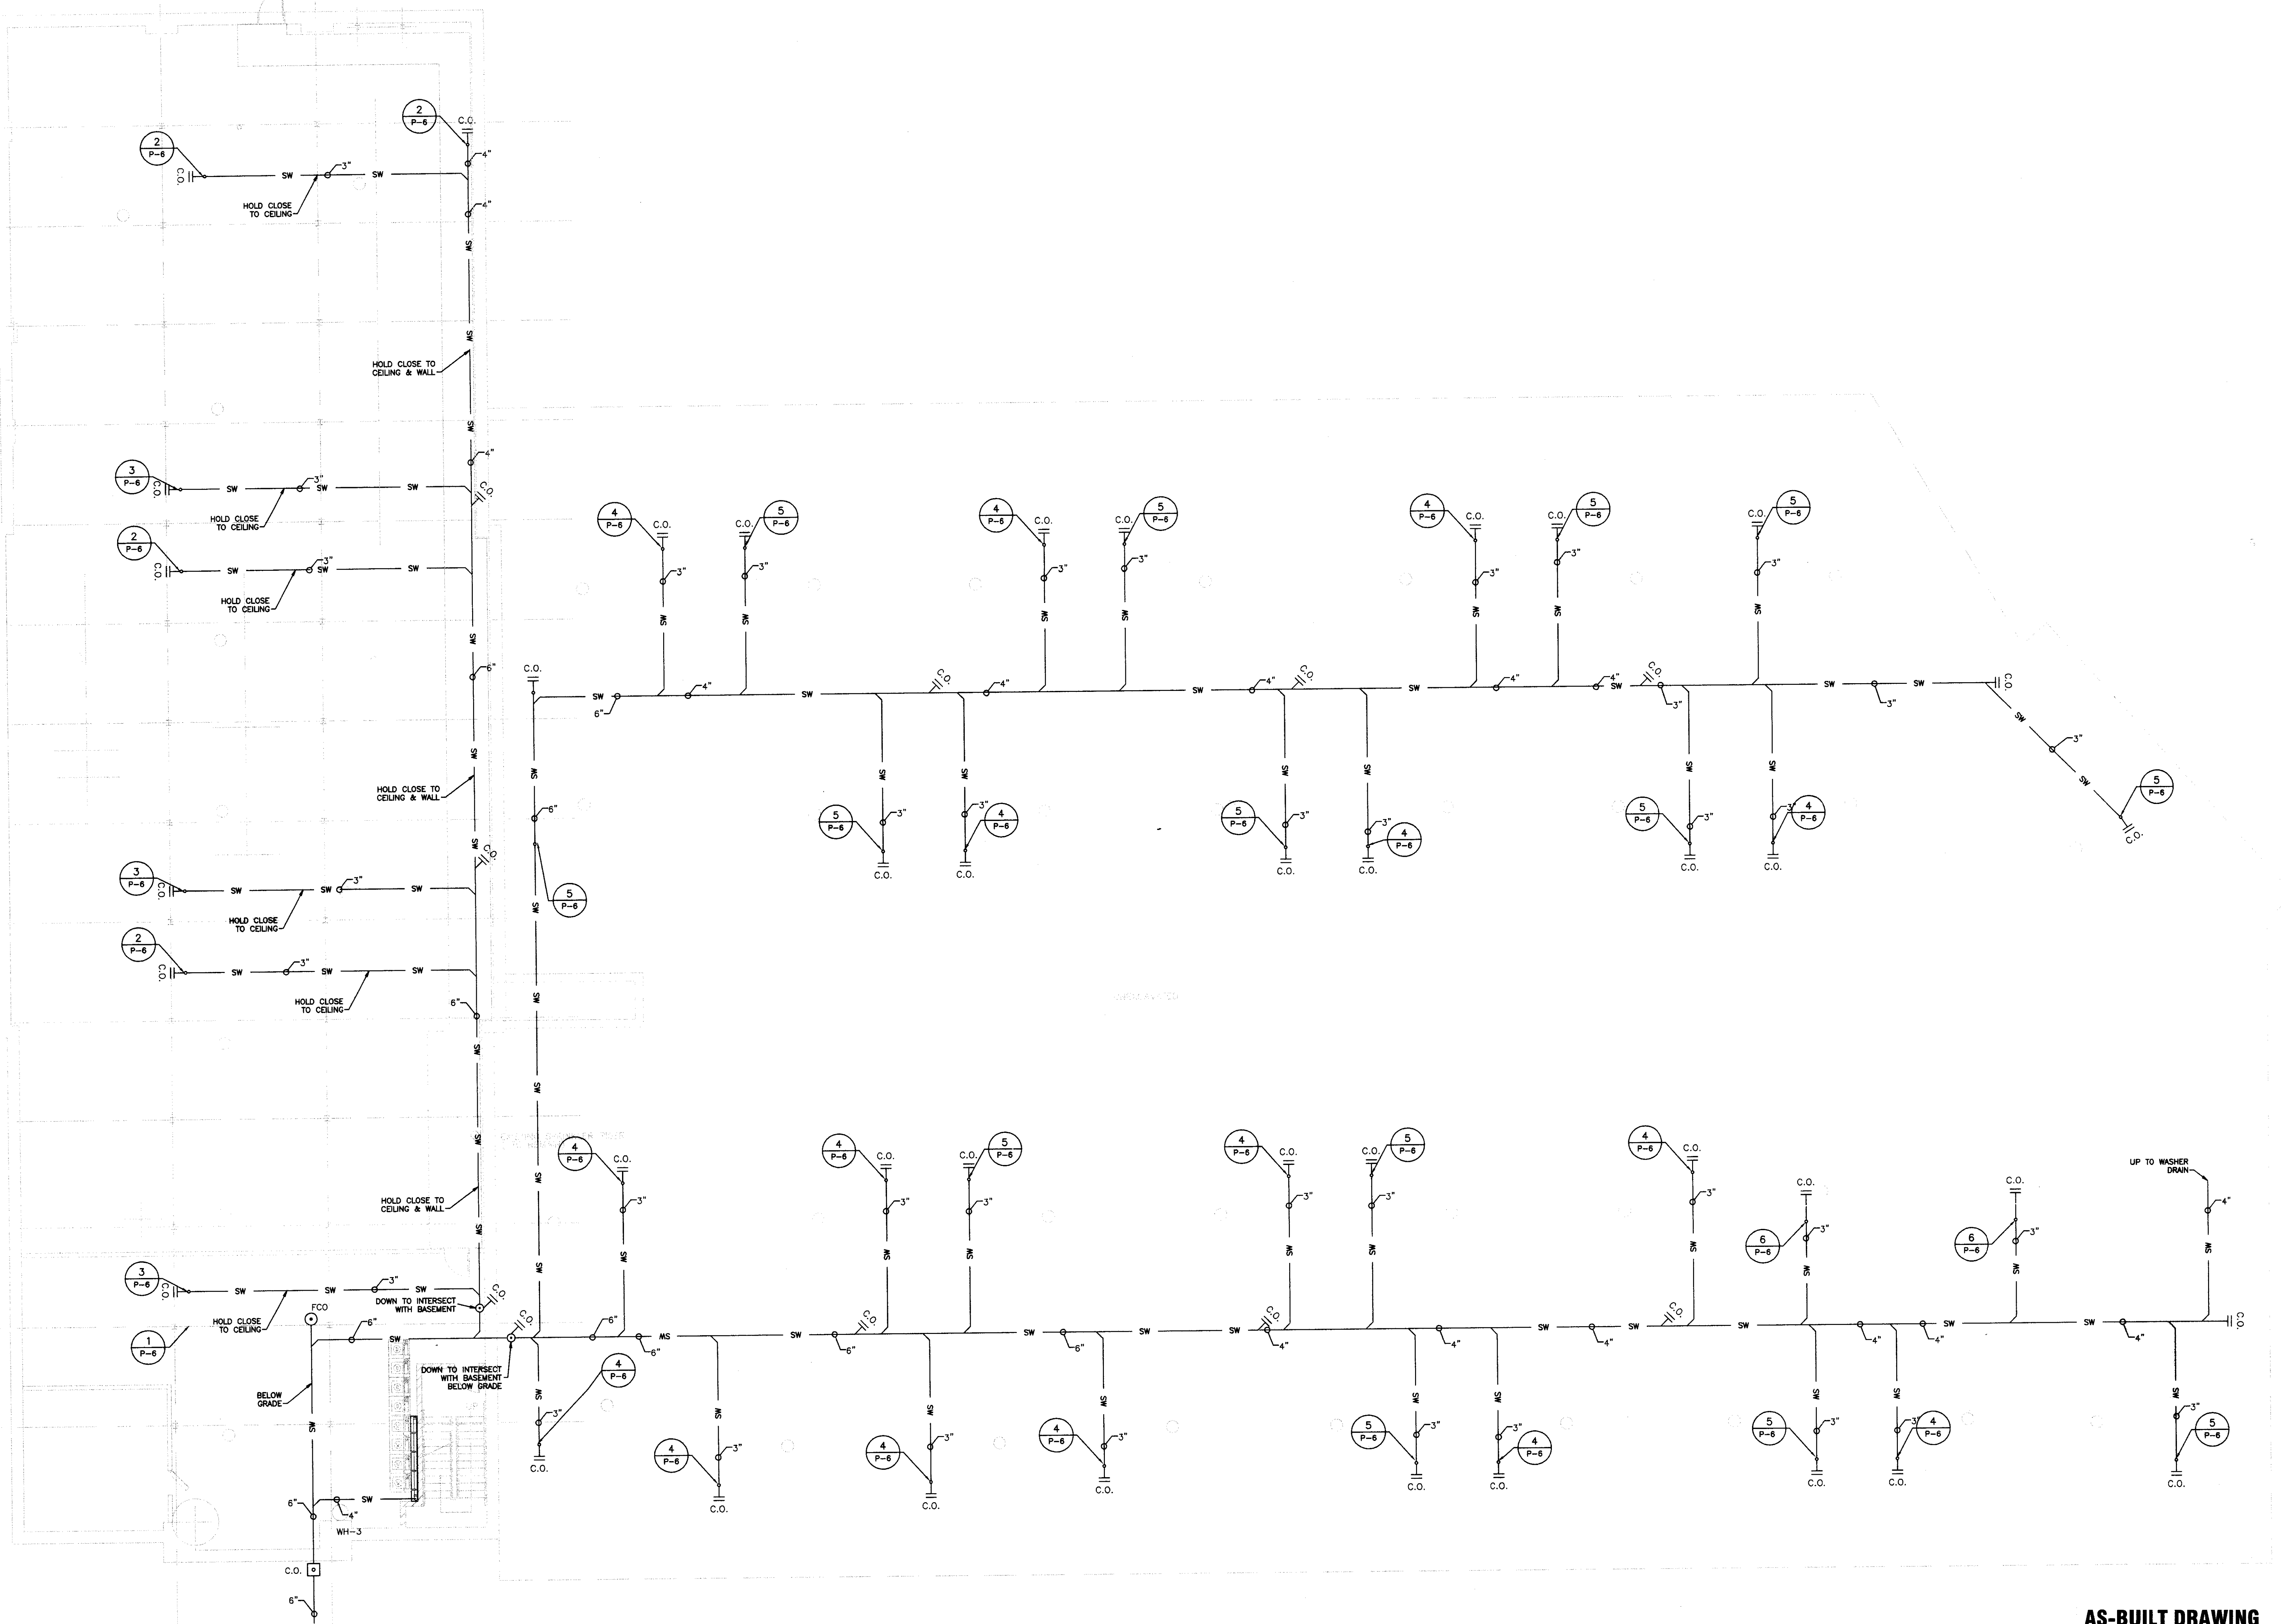

AS-BUILT DRAWING

1/8" = 1' S