

MICHAEL L. KNOLL
ARCHITECT
346 South Main Street
Versailles, Kentucky 40383
Phone: 606-673-9966
Email: mknoll@mlk.com


HERRICK & ASSOCIATES
Consulting Engineers
LEWINGTON, KY
DESIGN-ENGINEERING
501 BROOKLYN COURT, SUITE 101
LEWINGTON, KY 40341

The McGoodwin Company
Commercial Real Estate

PROJECT:
MCGOODWIN DEVELOPMENT
LEXINGTON LOFTS
200 BOLLIVAR STREET
LEXINGTON, KENTUCKY
DRAWING:
ATTIC SANITARY SEWER VENT PLAN

DATE: 1/10/03
DRAWN BY: MLK
REVISIONS:

SHEET NO.
P-5

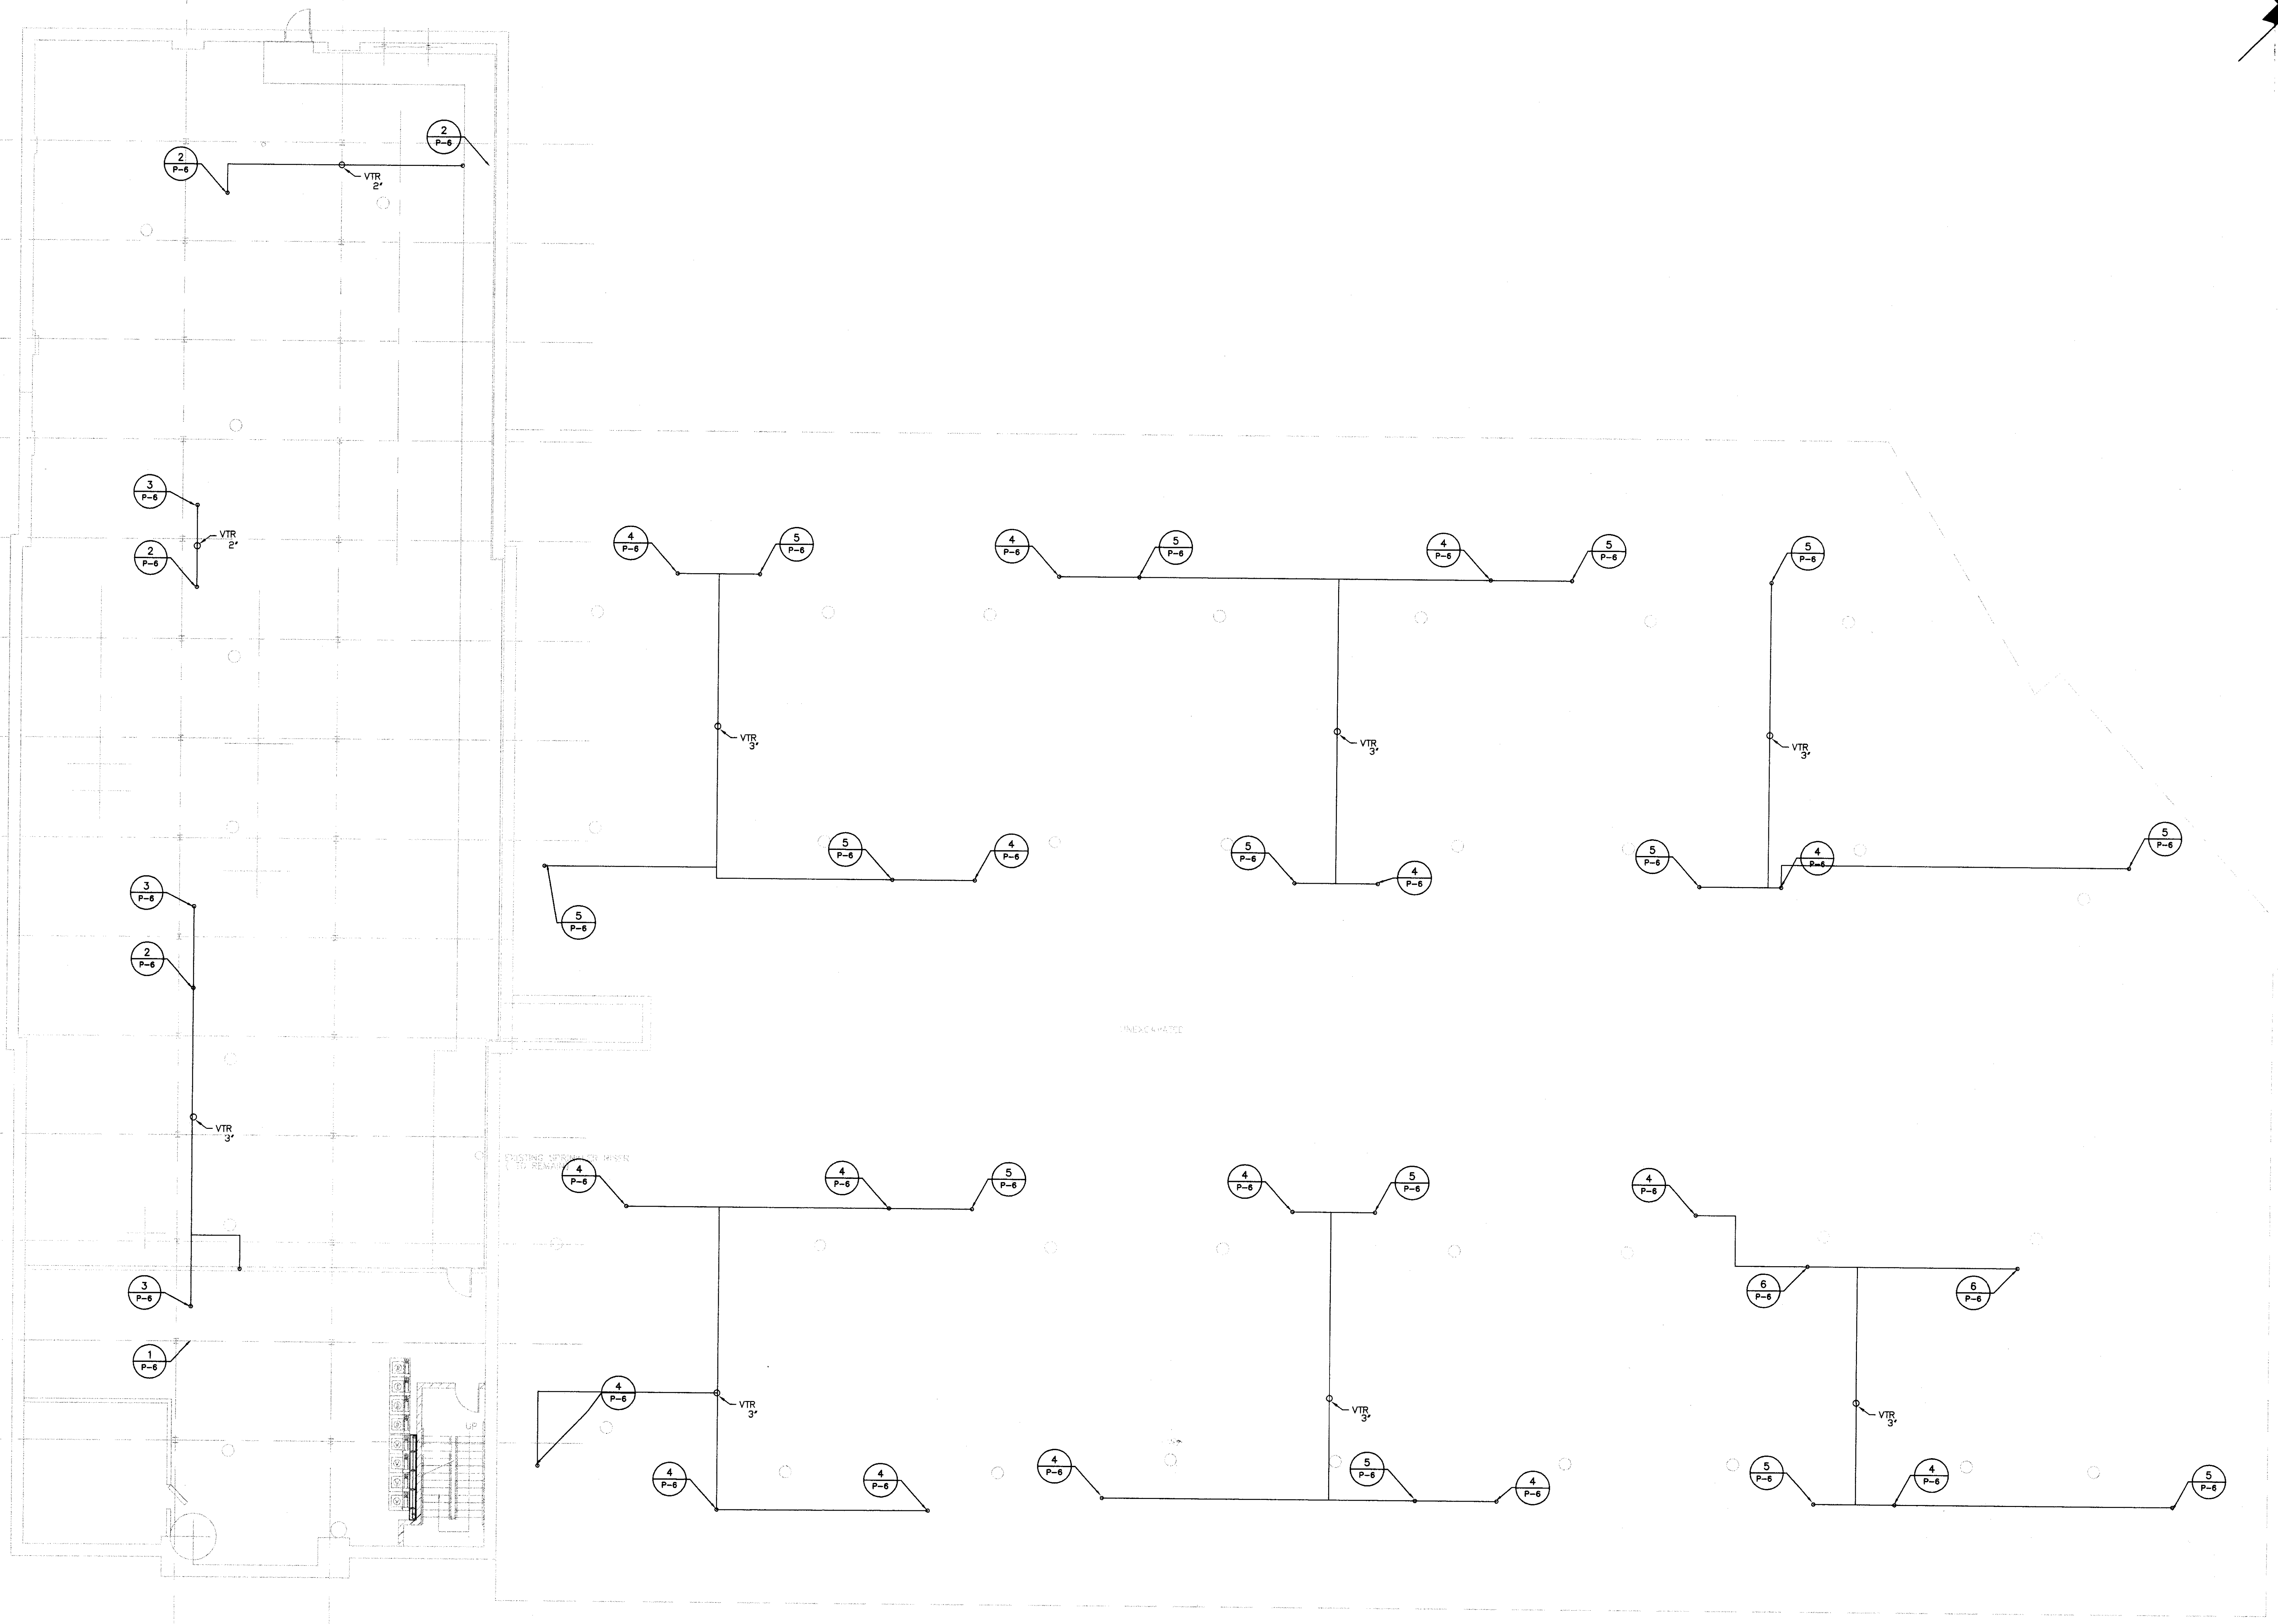

SANITARY SEWER ATTIC VENT PLAN

AS-BUILT DRAWING

1/8" = 1' S

Doc # 34233
C-1