

MICHAEL L. KNOLL  
ARCHITECT  
346 South Main Street  
Versailles, Kentucky 40383  
Phone: 859-873-1980  
Email: mknoll@earthlink.net

HERRICK & ASSOCIATES  
CONSULTING ENGINEERS  
DESIGN-ENGINEERING  
LEXINGTON, KY 40517  
D. DAVID PRESTON, P.E.


The McGowan Company  
Commercial Real Estate

PROJECT: MCGOWAN DEVELOPMENT  
LEXINGTON LOFTS  
200 BOLLIVAR STREET  
LEXINGTON, KENTUCKY  
DRAWING: POTABLE WATER DISTRIBUTION PLAN

DATE: 1/10/08  
DRAWN BY: MLK  
REVISIONS:

SHEET NO.  
P-7

Job # 8106 Document # 34225  
234 C-1

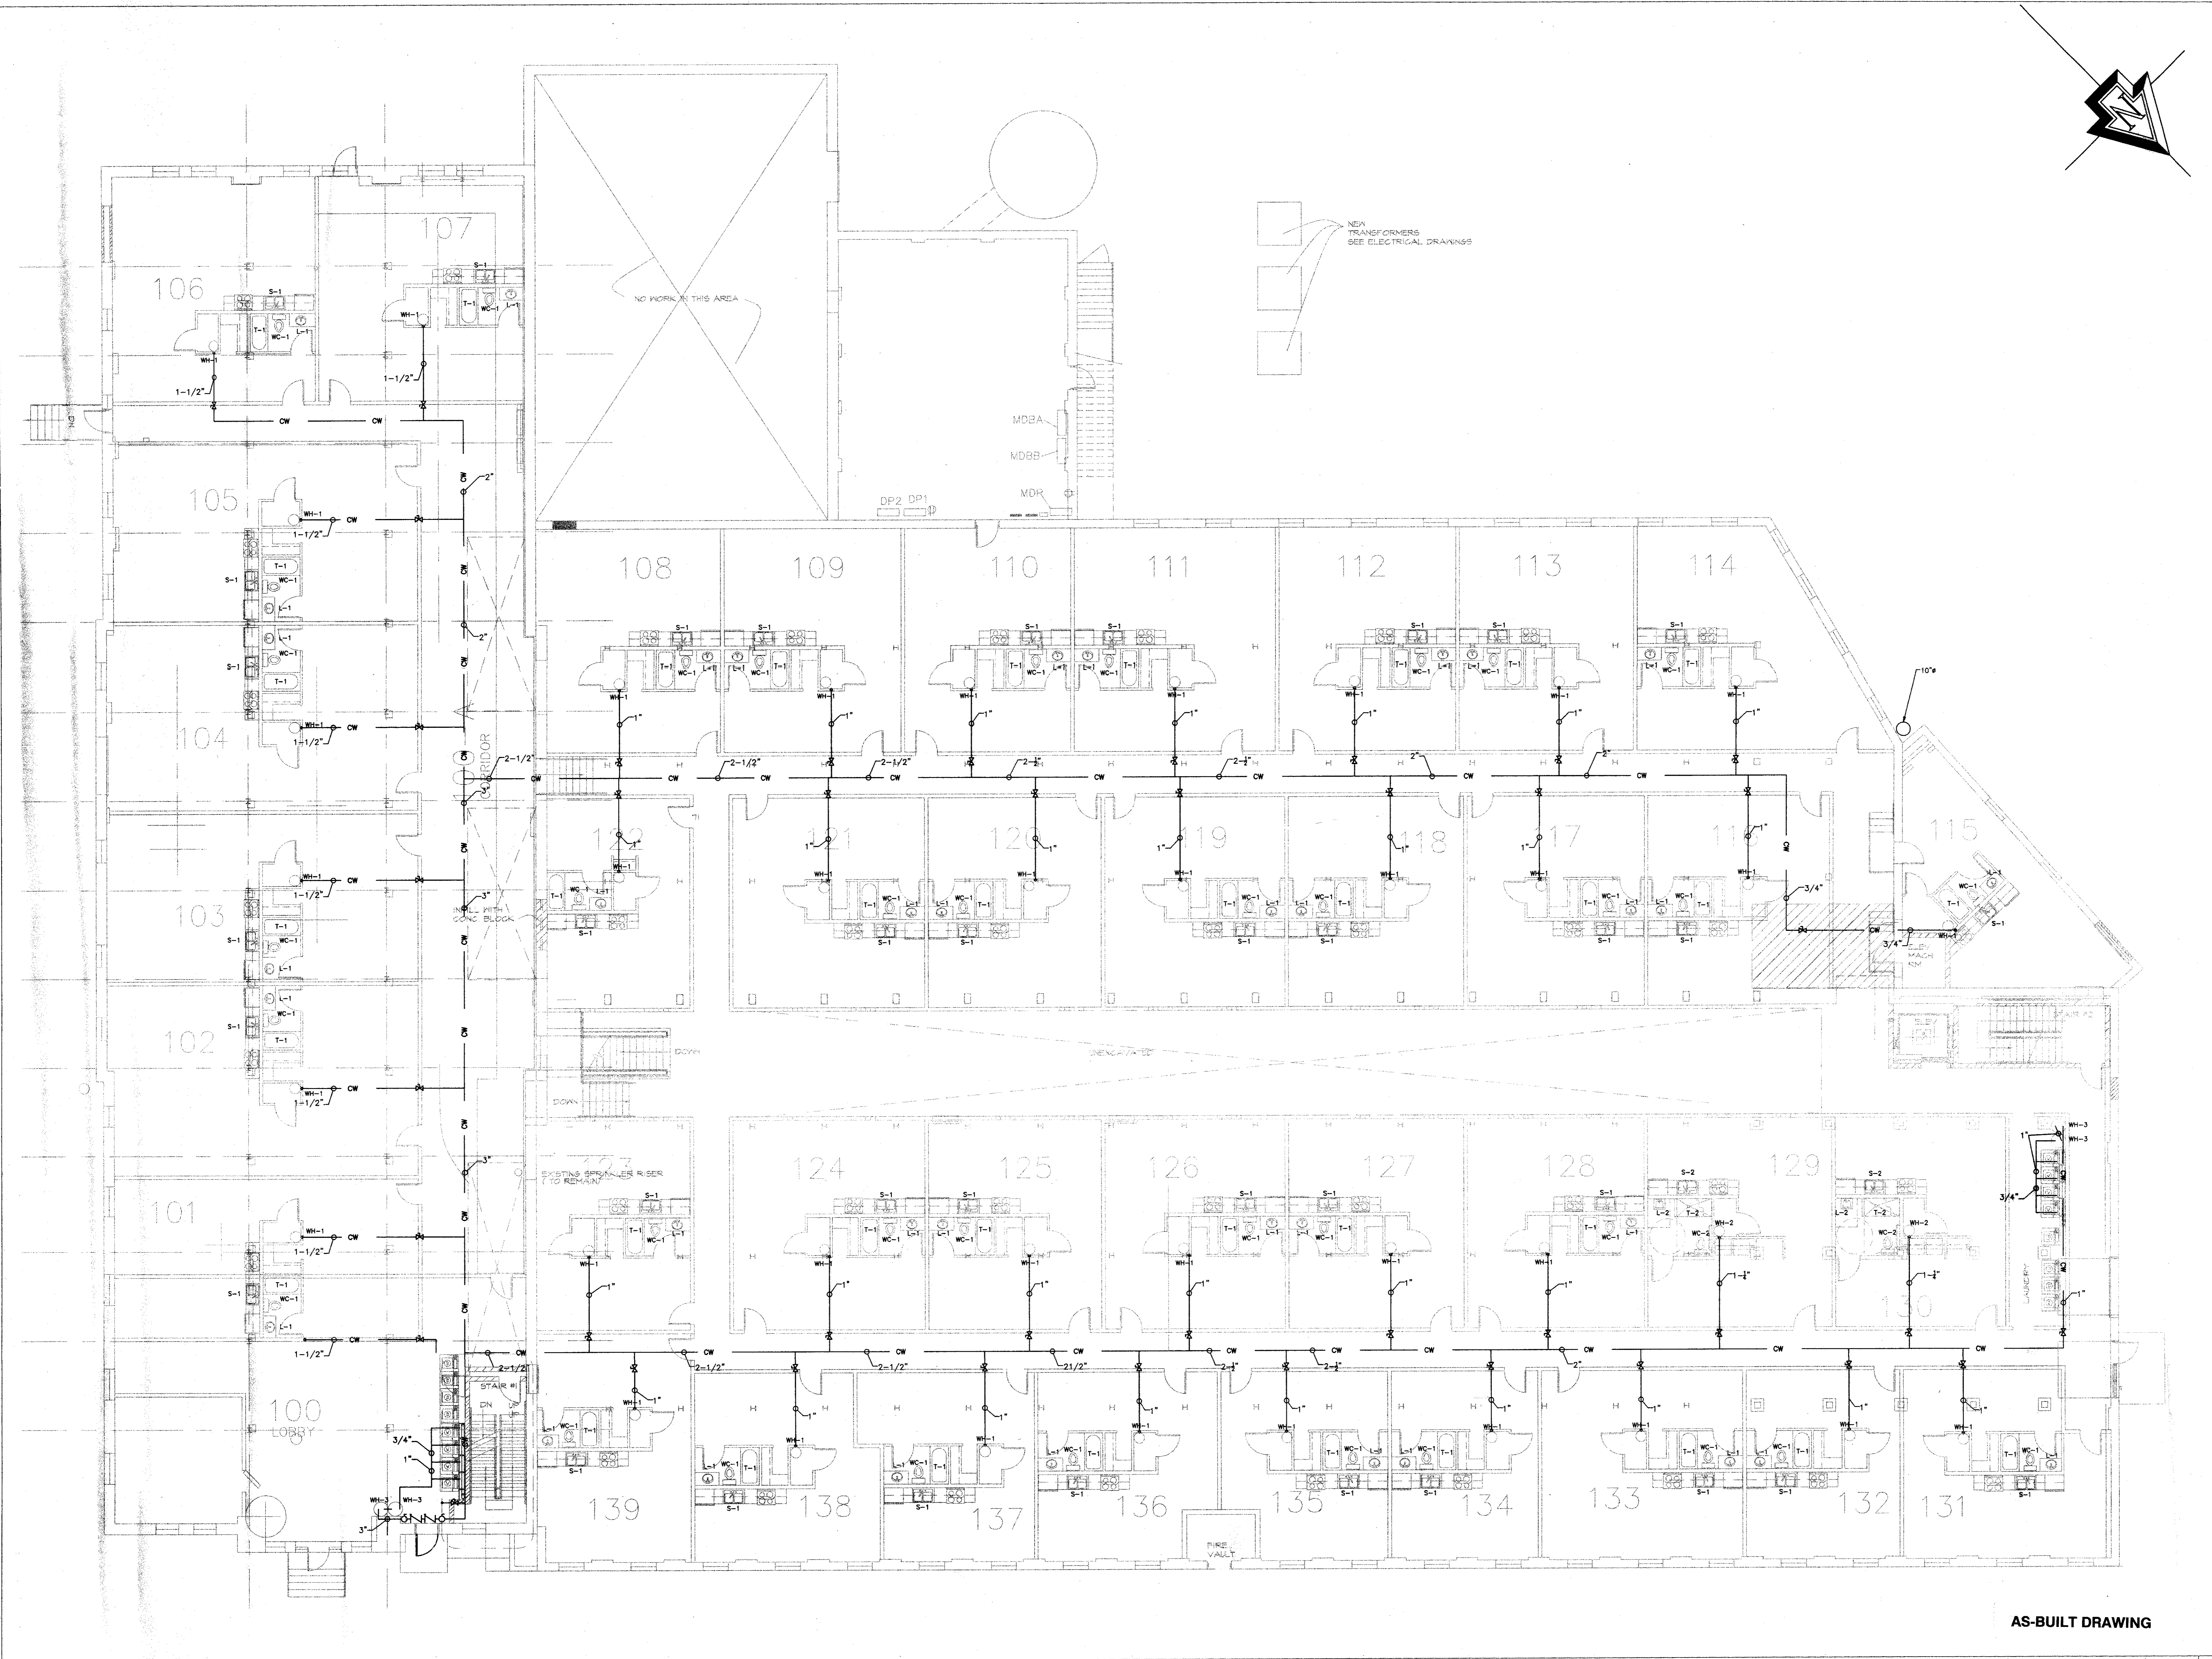

BASEMENT POTABLE WATER PLAN

AS-BUILT DRAWING

1/8" = 1' S