


20.


23.




24.

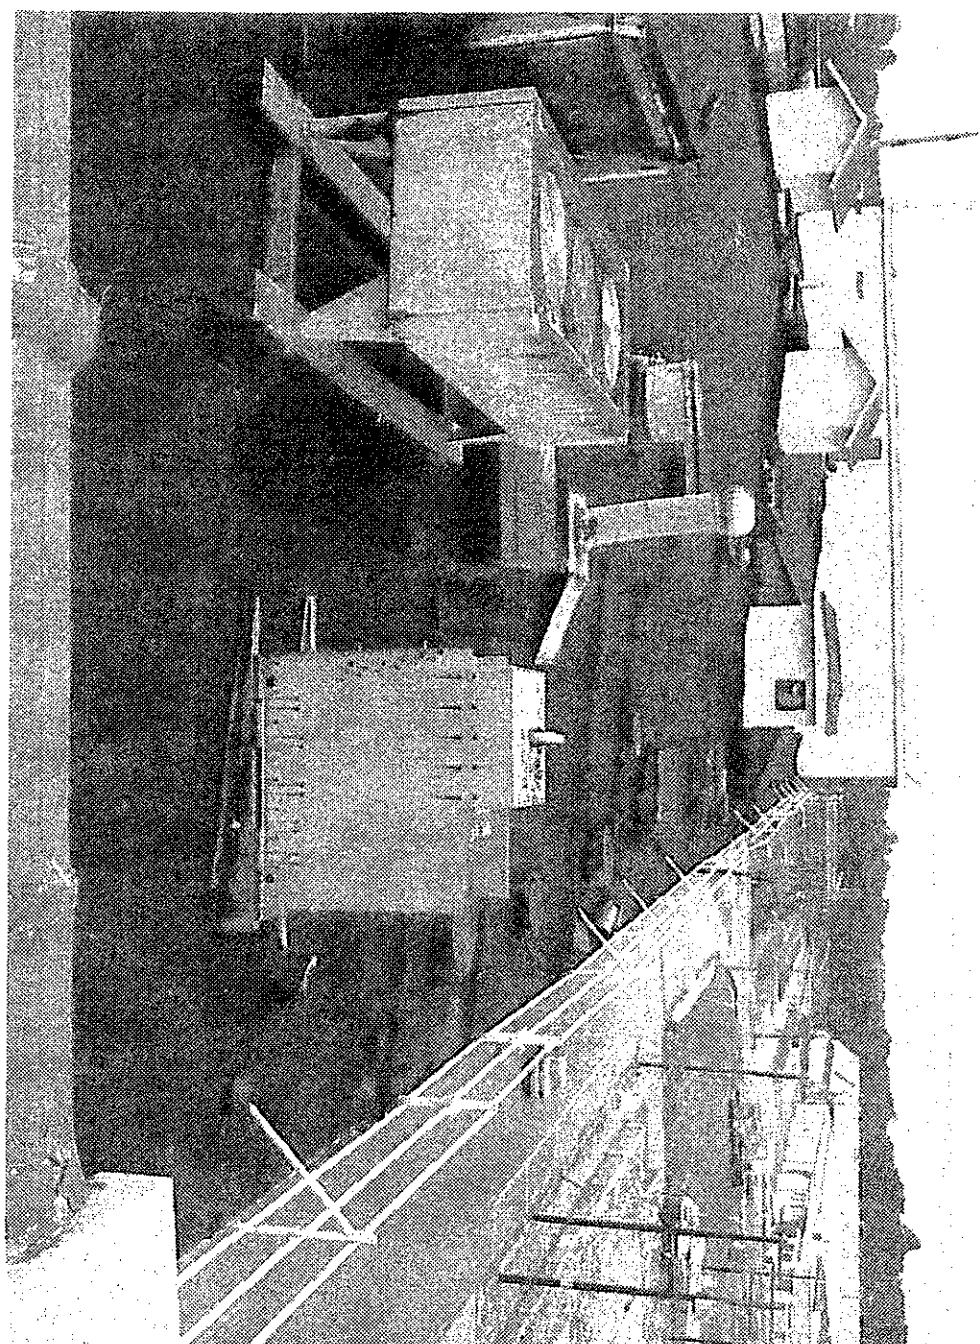


21.

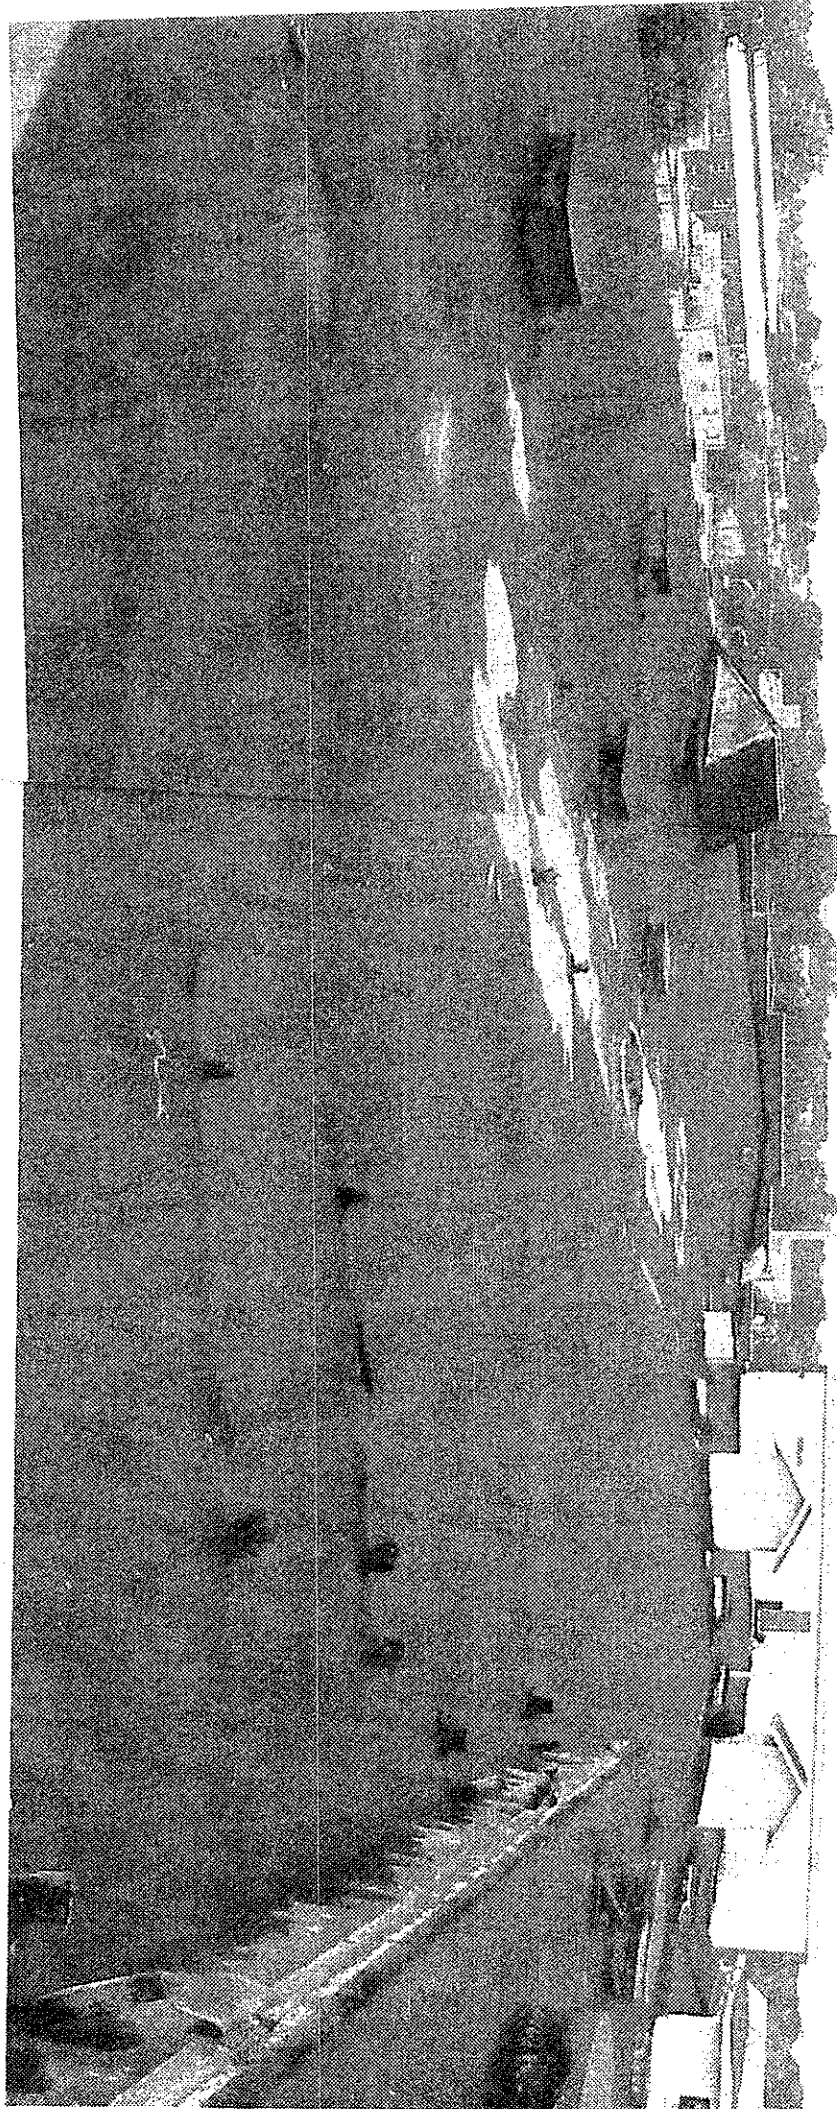


26.

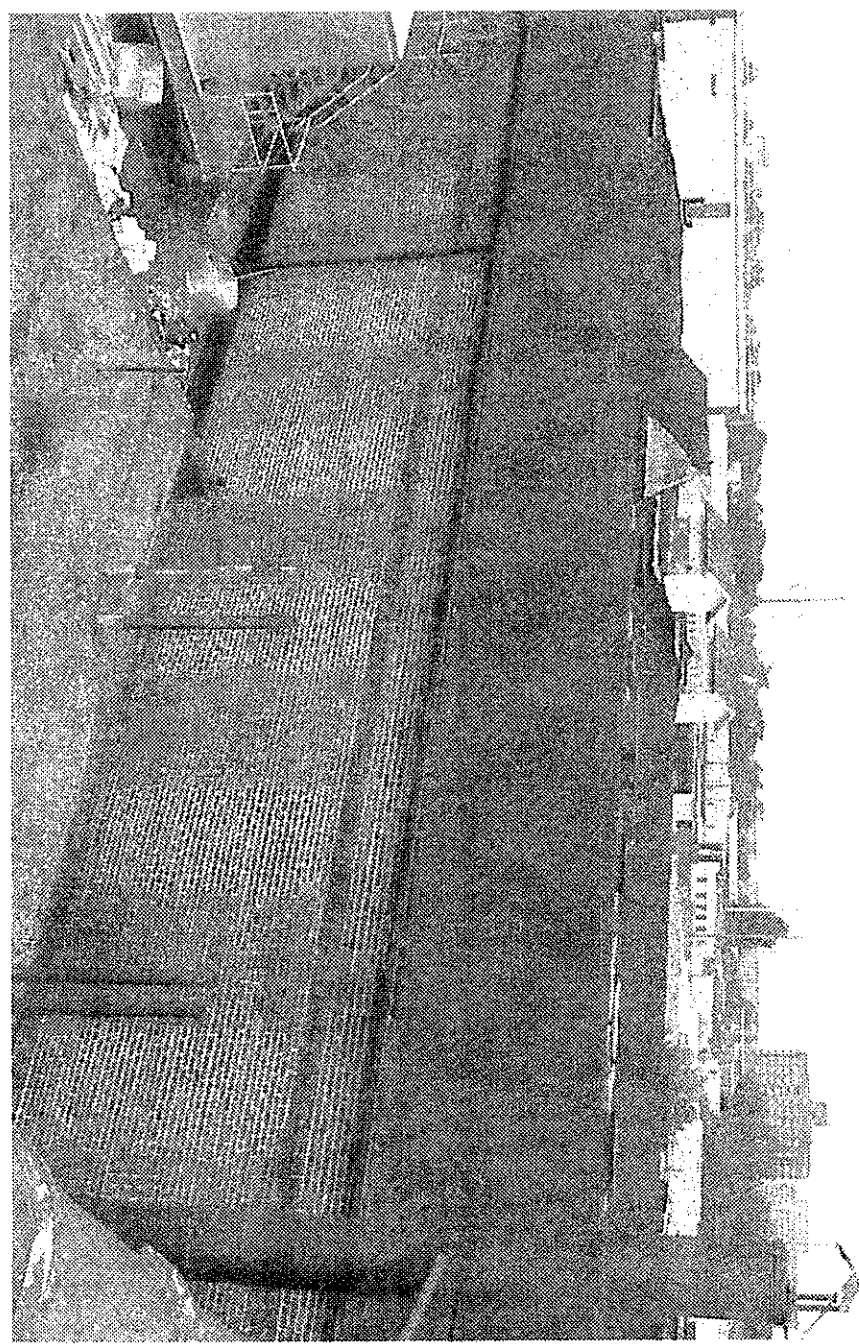


28.

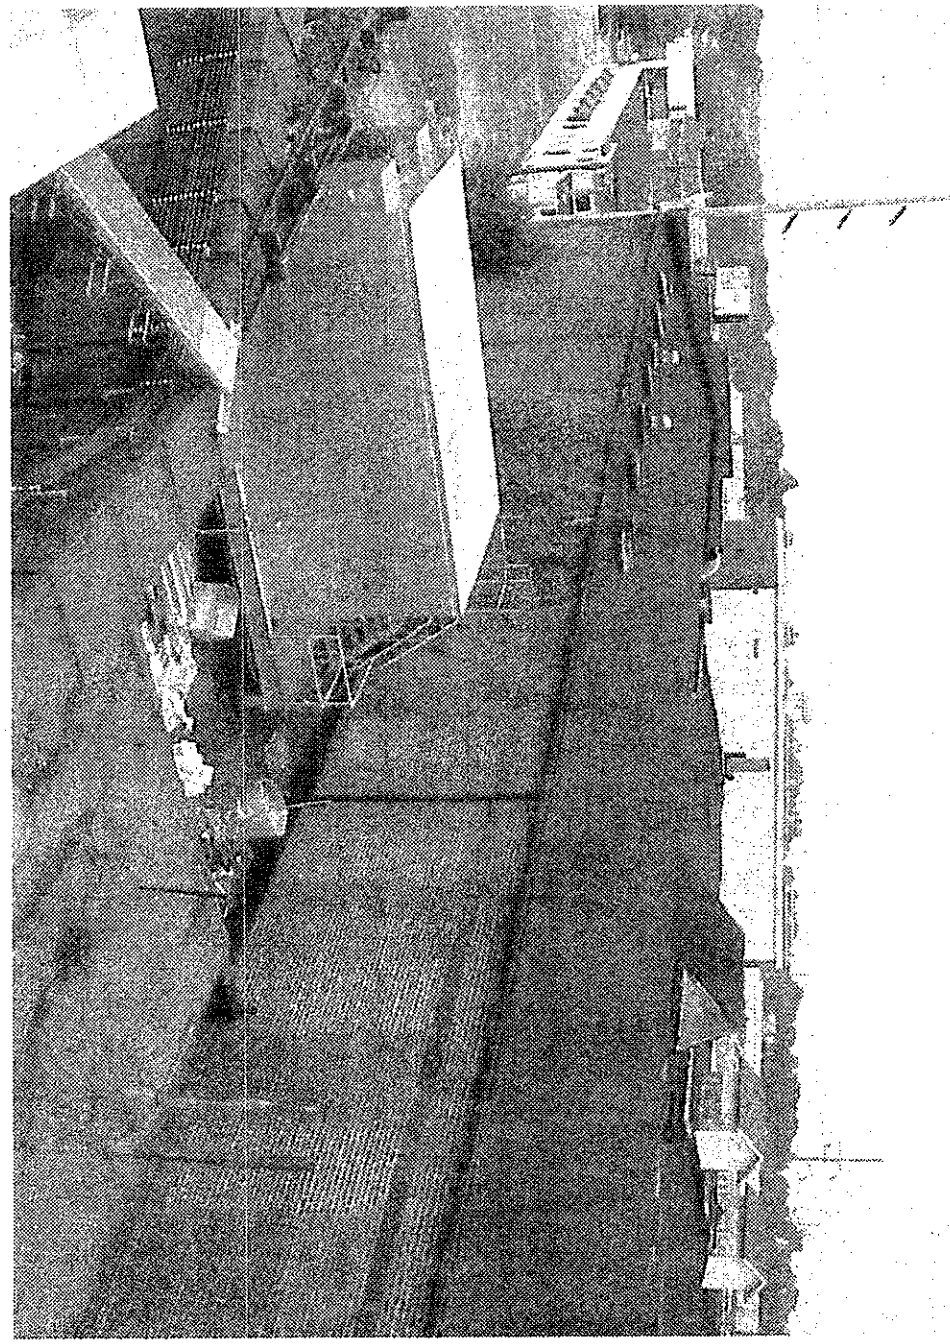

27.

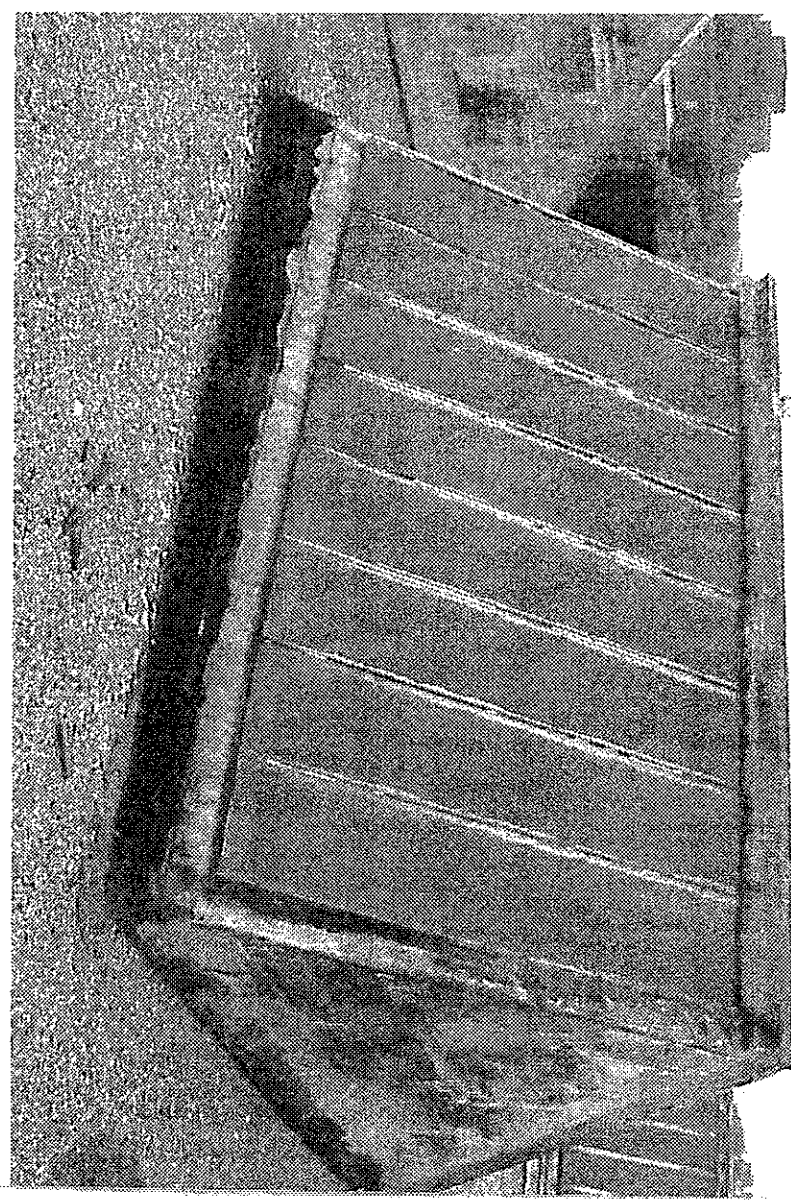

25.

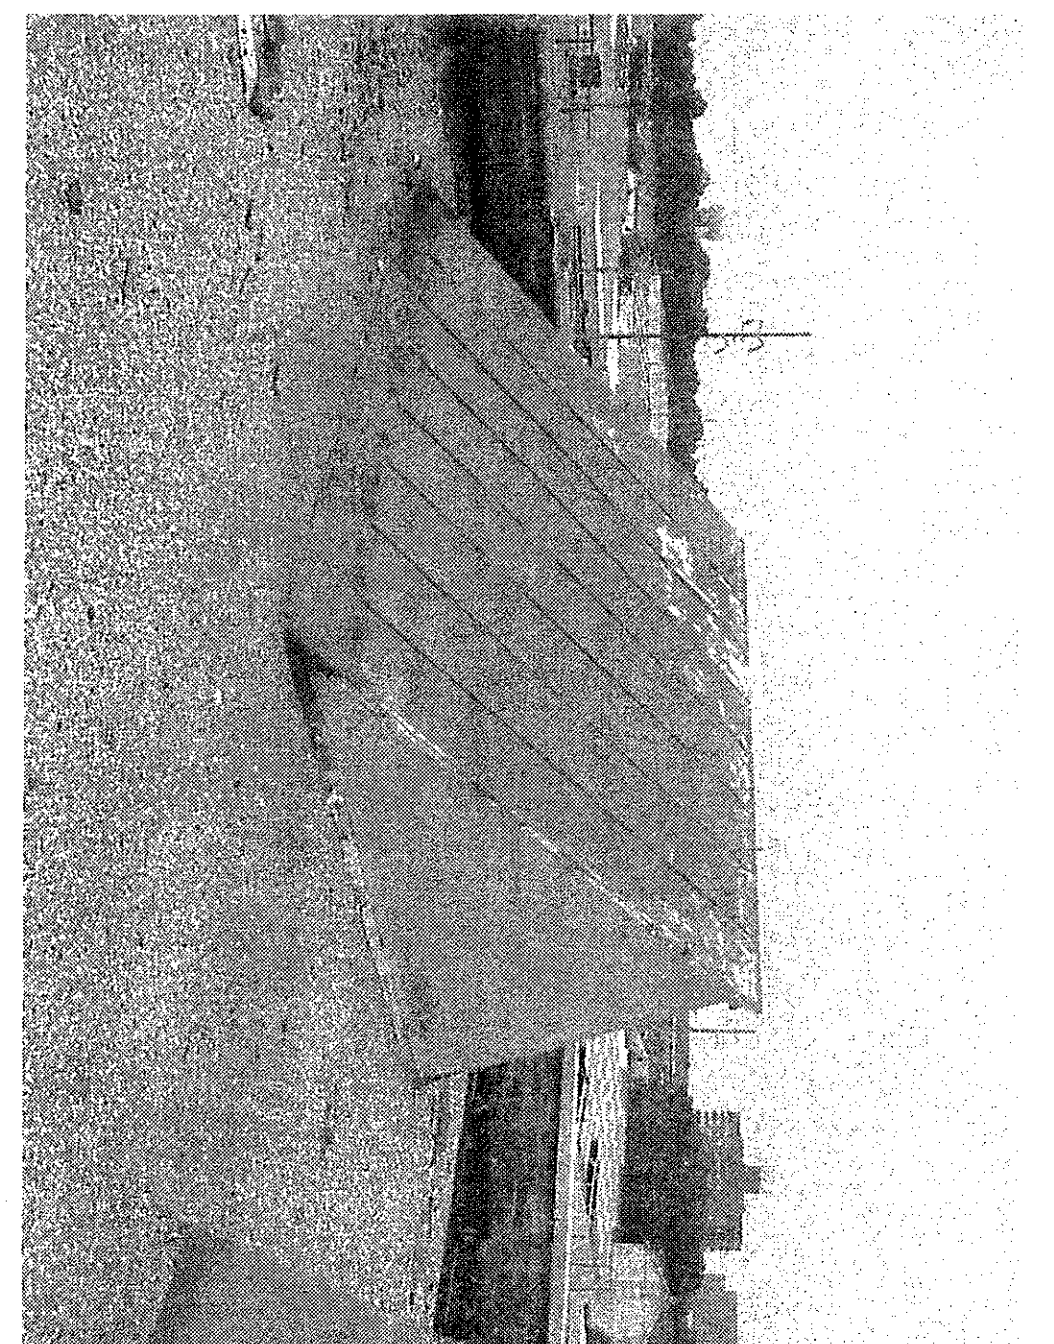

22.

AS-BUILT DRAWING


HUD Project No.

SHEET NO. PH-2

DATE: 5/5/02
DRAWN BY: MLK
CHECKED BY: [Signature]
DATE: 5/10/02

PROJECT:
LEXINGTON LOFTS
200 BOLIVAR STREET
LEXINGTON, KENTUCKY
DRAWING:
BUILDING PHOTOS


The McGoodwin Company
Commercial Real Estate

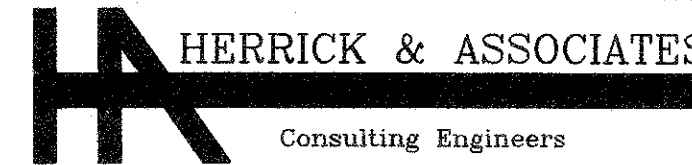
HERRICK & ASSOCIATES
Consulting Engineers
859 271 0483 LEXINGTON KY
DESIGN-ENGINEERING
601 BROOKFARM COURT
LEXINGTON, KY 40517
O. DAVID PRESTON, P.E.


MICHAEL L. KNOLL
ARCHITECT
346 South Main Street
Versailles, Kentucky 40383
Phone: 859-873-1900
Email: 3mcknoll@gte.net

