
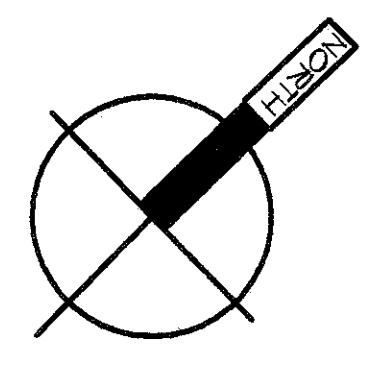


- DEMOLITION CODED NOTES:
1. REMOVE EXISTING PAVEMENT OR GRAVEL SURFACE TO MIN. DEPTH OF 4" AND REGRADE.
 2. REMOVE WALL AND FOUNDATION.
 3. SAWCUT AND REMOVE CONCRETE.
 4. REMOVE CONCRETE SIDEWALK AND ASSOCIATED CURB.
 5. REMOVE CONCRETE SIDEWALK AND EXISTING STREET SIGNS, PARKING METERS AND UTILITY APPURTENANCES AS NECESSARY.
 6. REMOVE BUILDING STRUCTURES, SIDEWALKS, CURBS, AND UTILITY APPURTENANCES AS NECESSARY.
 7. SAWCUT AND REMOVE CONCRETE PAVEMENT AND BASE TO DEPTH OF 2" ALL CONCRETE OR BRICK SIDEWALK AND ASSOCIATED CURB. SALVAGE AND REINSTALL ALL EXISTING STREET SIGNS, PARKING METERS AND UTILITY APPURTENANCES AS NECESSARY FOR NEW CONCRETE SIDEWALKS.
 8. REMOVE EXCESS SOIL/DEBRIS DOWN TO LEVEL OF REMAINDER OF LOT FOR EXPANSION OF PARKING AREA.
 9. REMOVE EXCESS SOIL/DEBRIS AS NECESSARY TO PERMIT NEW PARKING LOT ENTRANCE AS NECESSARY TO PERMIT NEW UTILITY APPURTENANCES.
 10. APPROPRIATE UTILITY COMPANY TO REMOVE ALL AND CONCRETE LANDING, SAWCUT EDGE OF PAVEMENTS TO REMAIN.

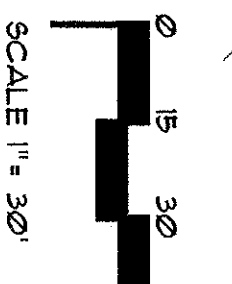

AS-BUILT DRAWING

FOR LOCATION OF UNDERGROUND UTILITIES, CALL OR BUILD 1-800-752-6001 2 WORKING DAYS IN ADVANCE OF DIGGING

SD-0

DRAWN: SGT
 DATE: 12/13/02
 CHECKED: SKL
 REVISION: 11/2/03
 LC # 21-144

JOHN L. CARMAN & ASSOCIATES, INC.
 310 Old East Vine Street
 Lexington, Kentucky 40507 859/264-8803
 Landscape Architecture • Planning • Site Engineering

DEMOLITION PLAN
BOLIVAR DEVELOPMENT
 200-224 & 225 Bolivar Street
 Lexington, Kentucky

Professional Engineer Seal for Kevin L. Warner, State of Kentucky, License No. 533, Expired 11/19/03.