


SD-3

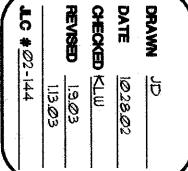

JOHN L CARMAN & ASSOCIATES, INC.
310 Old East Vine Street
Lexington, Kentucky 40507 859/254-9803
Landscape Architecture • Planning • Site Engineering

## LANDSCAPE PLAN

BOLIVAR DEVELOPMENT 200-224 & 245 Bolivar Street Lexington, Kentucky

