


NOTES:
 • CENTRALIZED PRINTING FACILITIES
 • IN ALL OFFERINGS
 • DO WE NEED ALL OF THESE TOILETS?
 • RECTANGULAR DIRECT FIXTURES?

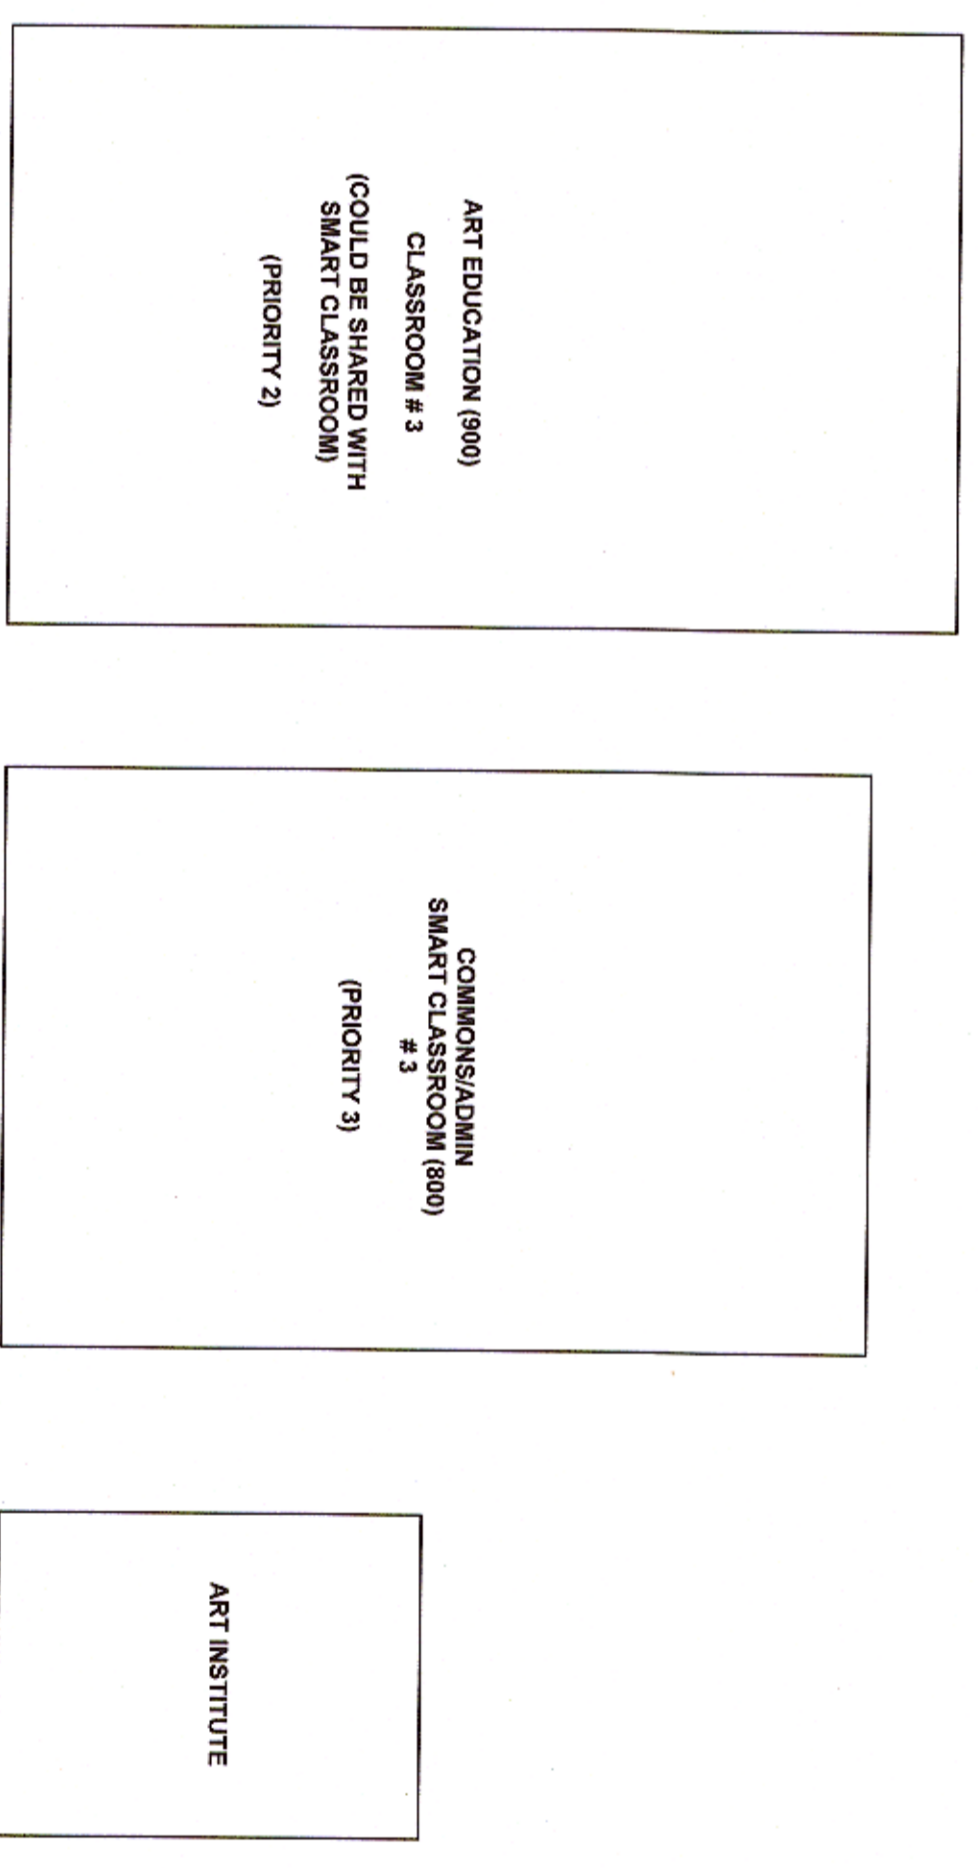

TARGET PROGRAM	STUDIOS	FACULTY OFFICE
(450 SFT)	(80 SFT)	
ART EDUCATION	2	2
ADVANCED DRAWING	1	4
FOUNDATIONS	2	4
PHOTOGRAPHY	1	4
PRINT MAKING	1	4
INTERMEDIA	2	4
FIBER	1	4
PAINTING/DRAWING	1	6
PART-TIME INSTRUCTORS	1	6
VISITING ARTIST*		

Number	Name	Level	Department	Area	Program Area
0307	ELEC	3RD LEVEL		83 SF	
0309	PART - TIME INSTRUCTOR	3RD LEVEL		156 SF	
0315	FACULTY WORKROOM	3RD LEVEL		156 SF	
0311	MESH	3RD LEVEL		43 SF	
0318A	MECH ROOM	3RD LEVEL		18 SF	
0318B	MECH ROOM	3RD LEVEL		18 SF	
0318C	MECH ROOM	3RD LEVEL		45 SF	
0314A	Room	3RD LEVEL		18 SF	
0314B	Room	3RD LEVEL		44 SF	
0312A	Room	3RD LEVEL		18 SF	
0312B	Room	3RD LEVEL		18 SF	
0310A	Room	3RD LEVEL		18 SF	
0309C	Room	3RD LEVEL		44 SF	
0309B	Room	3RD LEVEL		44 SF	
0309A	Room	3RD LEVEL		44 SF	
0304A	TOILET	3RD LEVEL		18 SF	
0304B	Room	3RD LEVEL		18 SF	
0303	Room	3RD LEVEL		18 SF	
0302	L.T. CLOSET	3RD LEVEL		25 SF	
0301	HAAC	3RD LEVEL		25 SF	
0305	FACULTY OFFICE 4	3RD LEVEL	ART EDUCATION	113 SF	80
0306	FACULTY OFFICE 3	3RD LEVEL	ART EDUCATION	75 SF	265
0308	STUDIO/OFFICE 2	3RD LEVEL	ART EDUCATION	138 SF	265
0308	STUDIO/OFFICE 1	3RD LEVEL	ART EDUCATION	133 SF	67
0304	PART - TIME INSTRUCTOR 6	3RD LEVEL	COMMONS/ADMIN	201 SF	300
0304	FACULTY LOUNGE	3RD LEVEL	COMMONS/ADMIN	255 SF	288
0316	FACULTY STUDIO	3RD LEVEL	COMMONS/ADMIN	72 SF	288
0317	DRAWING LECTURE	3RD LEVEL	FOUNDATIONS	94 SF	140
0310	DRAWING LECTURE	3RD LEVEL	FOUNDATIONS	521 SF	140
0312	OFFICE FOR FACULTY	3RD LEVEL	FOUNDATIONS	868 SF	480
0312	OFFICE FOR FACULTY	3RD LEVEL	FOUNDATIONS	868 SF	480
0300	FACULTY STUDIO OFFICE 1	3RD LEVEL	INTERMEDIA	443 SF	480
0300	FACULTY STUDIO OFFICE 2	3RD LEVEL	INTERMEDIA	443 SF	480
0300	FACULTY STUDIO OFFICE 3	3RD LEVEL	INTERMEDIA	443 SF	480
0310	OFFICE FOR FACULTY	3RD LEVEL	PHOTOGRAPHY	565 SF	480
0310	OFFICE FOR FACULTY	3RD LEVEL	PHOTOGRAPHY	481 SF	480
0310	OFFICE FOR FACULTY	3RD LEVEL	PHOTOGRAPHY	422 SF	480
0310	OFFICE FOR FACULTY	3RD LEVEL	PHOTOGRAPHY	470 SF	480
0310	FACULTY STUDIO	3RD LEVEL	PRINT MAKING	480 SF	480

UNIVERSITY LOFTS - Renovate Academic Facility UK School of Art & Visual Studies

Third Floor Plan

NOT FOR CONSTRUCTION Job Number: 1205 Date: 02/13/2013 Drawn By: MJ Checked By: EZ Revision: 1

A-1.3



212 North Upper Street
 Lexington, Kentucky 40507-1001
 p 859.252.6664 f 859.253.2368
 www.omniarchitects.com

This Drawing and the Design shown thereon are the property of Omni Architects. The reproduction, copying or other use of this Drawing or Design without the written consent of Omni Architects is prohibited.

