

# UNIVERSITY OF LOUISVILLE

## STUDENT RECREATION CENTER

2030 SOUTH 4th STREET  
LOUISVILLE, KENTUCKY 40208



### BID PACKAGE, PHASE #3

### JANUARY, 2012

### DRAWING INCLUDE ALL BP #4 ADDENDUM ITEMS JULY 27, 2012

The Contractor is reminded that the inclusion of the addendum items in the drawings is for convenience purposes and the Contractor will still be responsible for all addendum items even if they were not included in the revised drawings.

THE SCOPE OF BID PACKAGES, PHASES 1, 2, AND 3 (INCLUDING ADDENDA) ARE RELATED TO AND INCLUDE ASSIGNED SCOPE OF WORK THAT IS A COMPONENT OF BID PACKAGE #4. THESE DOCUMENTS HAVE BEEN ISSUED IN ADVANCE OF BID PACKAGE #4.

BID PACKAGE, PHASE (1) SITE PREPERATION (FLYNN BROS.)  
BID PACKAGE, PHASE (2) SPECIAL INSTRUCTIONS (TBA)  
BID PACKAGE, PHASE (3) STEEL FABRICATION AND ERECTION (TBA)  
BID PACKAGE, PHASE (4) GENERAL CONTRACTOR BEST VALUE



212 North Upper Street  
Lexington, Kentucky 40507-1001  
p 859.252.6664 f 859.253.2358  
www.omniarchitects.com



#### CANNON DESIGN

1100 Clark Avenue, St. Louis, MO 63102 p314.241.6250

LEAD DESIGNERS

#### Rangaswamy & Associates, Inc.

304 W Liberty St, #420, Louisville, KY 40202 p502.589.2212

STRUCTURAL ENGINEERS

#### Carman

639 East Jefferson Street, Louisville, KY 40202 p502.742.6581

LANDSCAPE ARCHITECTS/ CIVIL ENGINEERS

#### Swope Design Group

2297 Lexington Road, Louisville, KY 40206 p502.583.933

WAYFINDING DESIGNER

#### CMTA Consulting Engineers

10411 Meeting Street, Prospect, KY 40059 p502.326.3085

MEP ENGINEERS

#### Paladin, Inc.

143 Walton Avenue, Lexington, KY 40508 p 859.252.3047

COMMISSIONING AGENT

#### DBA Accoustics, Inc.

3044 Bardstown Rd., Louisville, KY 40205 p502.212.9184

ACCOUSTICAL CONSULTANTS

#### Robert Pass + Associates

309 East Market Street, Suite 302, Louisville, KY 40202 p502.589.7632

COST CONSULTANTS

#### Schedule of Drawings

##### STRUCTURAL

S0000 - GENERAL PROVISIONS  
S0001 - GENERAL PROVISIONS CONT'D  
S0002 - ERECTION SEQUENCE  
S0003 - ERECTION SEQUENCE  
S0004 - ERECTION SEQUENCE  
S0005 - 3D - VIEW  
S0120 - OVERALL MEZZANINE FLOOR FRAMING PLAN  
S0121 - MEZZANINE FLOOR FRAMING PLAN - AREA A  
S0122 - MEZZANINE FLOOR FRAMING PLAN - AREA B  
S0123 - MEZZANINE FLOOR FRAMING PLAN - AREA C  
S0124 - MEZZANINE FLOOR FRAMING PLAN - AREA D  
S0130 - OVERALL LEVEL 02 FLOOR FRAMING PLAN  
S0131 - LEVEL 02 FLOOR FRAMING PLAN- AREA A  
S0132 - LEVEL 02 FLOOR FRAMING PLAN- AREA B  
S0133 - LEVEL 02 FLOOR FRAMING PLAN- AREA C  
S0134 - LEVEL 02 FLOOR FRAMING PLAN- AREA D  
S0140 - OVERALL ROOF FRAMING PLAN  
S0141 - HIGH ROOF FRAMING PLAN  
S0142 - LOW ROOF FRAMING PLAN - AREA B  
S0143 - LOW ROOF FRAMING PLAN - AREA C  
S0144 - LOW ROOF FRAMING PLAN - AREA D  
S0145 - RACQUETBALL COURT ROOF FRAMING PLAN  
S0150 - STRUCTURAL EXTERIOR LINTEL ELEVATIONS  
S0151 - STRUCTURAL EXTERIOR LINTEL ELEVATIONS  
S0152 - STRUCTURAL EXTERIOR LINTEL ELEVATIONS  
S0153 - STRUCTURAL EXTERIOR LINTEL ELEVATIONS  
S0154 - HSS SPACER TUBE ELEVATIONS  
S0155 - HSS SPACER TUBE ELEVATIONS  
S0160 - SECTIONS AND DETAILS  
S0161 - SECTIONS AND DETAILS  
S0162 - SECTIONS AND DETAILS  
S0164 - SECTIONS AND DETAILS  
S0165 - SECTIONS AND DETAILS  
S0166 - SECTIONS AND DETAILS  
S0167 - SECTIONS AND DETAILS  
S0168 - SECTIONS AND DETAILS  
S0169 - SECTIONS AND DETAILS  
S0170 - SECTIONS AND DETAILS  
S0171 - COLUMN SCHEDULE  
S0172 - SECTIONS AND DETAILS  
S0173 - SECTIONS AND DETAILS  
S0174 - SECTIONS AND DETAILS  
S0175 - SECTIONS AND DETAILS  
S0176 - SECTIONS AND DETAILS  
S0177 - SECTIONS AND DETAILS  
S0178 - SECTIONS AND DETAILS  
S0179 - SECTIONS AND DETAILS  
S0200 - TYPICAL DETAILS  
S0201 - TYPICAL DETAILS  
S0202 - TYPICAL DETAILS  
S0203 - TYPICAL DETAILS  
S0209 - TYPICAL DETAILS

Louisville, Ky

University of Louisville - Student Recreation Center (Bid Package, Phase #3)

212 North Upper Street  
Lexington, Kentucky 40507-  
1001  
p 859.252.6664 f 859.253.2358  
www.omniarchitects.com



CANNONDESIGN



Drawing Name:	SITE/ STRUCTURAL COVER SHEET	#	Revision Date
		AUD. 2	March 2, 2012
U of L Project Number:			
Project Number:	Omni - 1105.00 Cannon - 03667.00		
Date:	JANUARY 2012		
Drawn By:	KTV	Checked By:	DLA

ADD. BP #4  
STRUCTURAL



1.1 GENERAL

A. DESIGN DOCUMENT HIERARCHY:

1. THE GENERAL PROVISIONS OUTLINED HEREIN SHALL BE TREATED AS PART OF THE PROJECT SPECIFICATIONS & TAKE PRECEDENCE OVER OTHER DOCUMENTS RELATED TO THIS PROJECT, UNLESS SPECIFICALLY NOTED ELSEWHERE, AND SHALL BE STRICTLY OBSERVED DURING CONSTRUCTION AS WELL AS SHOP DRAWING PREPARATIONS.
2. CONTRACT DOCUMENTS TAKE PRECEDENCE OVER THE SHOP DRAWINGS UNDER ANY OF THE FOLLOWING CONDITIONS:
- a.) THE SHOP DRAWINGS ARE SUBMITTED IN "PIECE MEAL" BASIS, IN SEVERAL INSTALLMENTS, TO EXPEDITE CONSTRUCTION ON A "FAST TRACK" DELIVERY METHOD.
- b.) IF SHOP DRAWINGS ARE RELEASED WITH "NO EXCEPTIONS TAKEN" NOT CHECKED.
- c.) WHEN SHOP DRAWINGS HAVE MARKINGS AND DIRECTIONS TO COMPLY WITH CONTRACT DOCUMENTS.

B. CONSTRUCTION DEFICIENCIES:

1. REMEDIAL DESIGNS WILL BE NECESSARY TO CORRECT ANY DEVIATIONS FROM THE CONTRACT DOCUMENTS DUE TO FIELD, FABRICATION AND/OR SUPPLY ERRORS, ALTERNATE DESIGNS, OR FIELD PROBLEMS AND SHALL BE PERFORMED BY A STRUCTURAL ENGINEER LICENSED IN KENTUCKY AND HAVING HIS/HER PRACTICE LOCATED IN KENTUCKY. THE STRUCTURAL ENGINEER SHALL HAVE PROFESSIONAL LIABILITY INSURANCE COVERAGE FOR ERRORS AND OMISSIONS TO A LIMIT OF \$1,000,000.00. SUBMIT CERTIFICATE OF INSURANCE WITH ARCHITECT AS CERTIFICATE HOLDER ALONG WITH THE CALCULATIONS AND DETAILS FOR ARCHITECT'S RECORD. THE REQUIREMENTS OF GENERAL PROVISION SECTION 1.4, SUBMITTALS, APPLY AND THE SUBMITTAL SHALL INCLUDE SKETCHES THAT ILLUSTRATE THE LOCATIONS, EXTENTS AND DETAILS OF THE DEFICIENCY. RAI IS NOT REQUIRED TO ORDER REMEDIES BUT RESERVES THE RIGHT TO INVOICE, ACCEPT AND/OR REJECT THE PROPOSALS BEFORE THE WORK IS PUT IN HAND.

C. FIELD DIRECTIVES & RESPONSES TO "REQUESTS FOR INFORMATION":

1. THE STRUCTURAL ENGINEER RESERVES THE RIGHT TO ISSUE, AT VARIOUS STAGES OF CONSTRUCTION, DIRECTIVES AND SKETCHES TO FURTHER CLARIFY THE INTENT OF THE CONTRACT DOCUMENTS. IN ADDITION, THE STRUCTURAL ENGINEER MAY PROVIDE RESPONSES TO "REQUESTS FOR INFORMATION" INITIATED BY THE CONTRACTOR. IF THE CONTRACTOR FINDS THAT SUCH DIRECTIVES AND RESPONSES ARE CARDINAL CHANGES TO THE CONTRACT DOCUMENTS, HE/SHE MUST OBTAIN A CHANGE ORDER FROM THE ARCHITECT/ENGINEER, WITHIN FIFTEEN DAYS OF THE RECEIPT OF THE DIRECTIVE OR RESPONSE AND BEFORE PROCEEDING WITH THE WORK. CONTRACTOR SHALL NOT PROCEED WITH ANY PORTION OF THE CONSTRUCTION AFFECTED BY THE DIRECTIVE OR RESPONSE WITHOUT A CHANGE ORDER AND SUCH ACT SHALL BE DEEMED TO BE WITHIN THE SCOPE OF THE CONTRACT DOCUMENTS. NO CHANGE IN THE CONTRACT SUM WILL BE MADE WITHOUT AN APPROVED CHANGE ORDER AND NO CHANGE ORDER WILL BE ISSUED AFTER THE WORK IS IN PLACE.

- D. APPLICABILITY:
- THE GENERAL PROVISIONS CONTAINS HEREIN ARE APPLICABLE TO ALL DRAWINGS STARTING WITH SHEETS "XXXXX TO YYYY".

1.2 ADMINISTRATIVE

1. THE STRUCTURAL ENGINEER NEITHER SUPERVISES NOR CONTROLS THE CONSTRUCTION AND HAS NOT RETAINED THE RIGHTS TO SUPERVISE OR CONTROL THE WORK DESCRIBED IN THESE DOCUMENTS.
2. THE STRUCTURAL ENGINEER HAS NOT BEEN RETAINED TO & WILL NOT PARTICIPATE IN THE ON-GOING DAY TO DAY ACTIVITIES AT THE CONSTRUCTION SITE.
3. THE STRUCTURAL ENGINEER IS NOT RESPONSIBLE FOR ON-SITE SAFETY AND WILL NOT BE RESPONSIBLE FOR SUPERVISING GENERAL OR SUB-CONTRACTORS.
4. THE STRUCTURAL ENGINEER HAS ANY OTHER AUTHORITY TO ISSUE ORDERS NOR THE RIGHT TO STOP WORK AT ANY TIME.
5. THE SPECIAL INSPECTION REQUIREMENTS, AND THE EXECUTION OF THE REQUIREMENTS BY THE SPECIAL INSPECTION TEAM, DOES NOT IN ANY WAY, OR AT ANY TIME, RELIEVE THE GENERAL OR PRIME CONTRACTOR OF THE ULTIMATE RESPONSIBILITY FOR COMPLETION OF ALL STRUCTURAL WORKS OF WORK TO THE SATISFACTION OF THE SPECIAL-INSPECTOR-OF-RECORD.

1.3 DESIGN NOTES

1. CONCRETE: MINIMUM COMPRESSIVE STRENGTH AT 28 DAYS ( $f'_c$ ) = CAST IN PLACE CONCRETE (C.I.P.) = 4000 PSI (U.N.O.) SLAB ON GRADE CONCRETE (S.O.G.): SEE NOTES 3.2.1 & 3.2.2 ACI 302 CLASSES 1 AND 2 = 3500 PSI ACI 302 CLASSES 4 AND 5 = 4000 PSI PRECAST CONCRETE = 5000 PSI CONCRETE TO RECEIVE BUSH-HAMMERED FINISH = 5000 PSI LEAN CONCRETE FILL = 3000 PSI ALL ELEVATED FLOOR CONCRETE PLACED OVER METAL DECK SHALL BE LIGHT WEIGHT WEIGHING NO MORE THAN 110 PCF AT EQUILIBRIUM.
2. MASONRY NET AREA COMPRESSIVE STRENGTH OF UNREINFORCED MASONRY,  $F_m$  = 1500 PSI-SEE SECTION 4.1: FOR GRADE AND MORTAR REQUIREMENTS.
3. CONCRETE REINFORCING STEEL: ASTM A615, GRADE 60.
4. STRUCTURAL STEEL: ROLLED SHAPES AND PLATES: W - SHAPES: ASTM A-992 ALL OTHER SHAPES: ASTM A-36 ROLLED PIPES - ASTM-A500, GRADE B RECTANGULAR AND SQUARE TUBING - ASTM A-500, GRADE B
5. BOLTS: 3/4" INCH DIAMETER ASTM F1582 (A325UT), TYPE 1, TENSION CONTROL BOLTING SYSTEM, TWIST-OFF SPLINE TYPE, UNLESS NOTED OTHERWISE.
6. ANCHOR BOLTS: ASTM A307 OR ASTM A36, MINIMUM, SIZE AND LOCATION PER THE VENDOR'S CERTIFIED DRAWINGS. ADHESIVE SET ANCHOR BOLTS, WHEN DEEMED ACCEPTABLE BY THE ENGINEER, SHALL BE THE HILTI "HIT" SYSTEM USING THE RE 500 SD CARTRIDGE IN CONJUNCTION WITH THE HILTI "HIT-100" ANCHOR BOLTS OF THE SPECIFIED DIAMETER. LENGTH AND INSTALLATION SHALL BE IN ACCORDANCE WITH THE VENDOR'S INSTRUCTIONS AND RECOMMENDATIONS SHALL BE STRICTLY ADHERED TO.
7. CLOSED CELL NEOPRENE PADS: ASTM D1056 (S.A.E. SPEC. SIZE-42), DIAPHRAGM OF THE TENSILE STRENGTH 100 PSI, ELONGATION 150% MINIMUM, AS DISTRIBUTED BY LAMATEK, INC. OR APPROVED EQUIVALENT.
8. DESIGN LOADS (PSF):

	DEAD	SUPER-IMPOSED	LIVE
ROOFS (U.N.O.):	26.0	60.0	20.0
GYMNASIUM/ACC. GYM/ FITNESS ROOF AREAS	46.0	-	20.0
ALL OTHER ROOF AREAS	29.0	-	20.0
GYMNASIUM FLOORS	74.0	18.0	100.0
AEROBICS FLOORS	56.0	86.0	100.0
JOGGING TRACK FLOORS	56.0	20.0	100.0
MECHANICAL/STORAGE FLOORS	56.0	40.0	125.0
STORAGE DEPRESSION FLOORS	56.0	88.0	125.0
CORRIDOR FLOORS	56.0	40.0	100.0
RACQUETBALL COURT FLOORS	56.0	42.0	100.0

NOTE: THE ABOVE TABULATED LOADS ARE THE BASIS FOR DESIGN AND INCLUDE ALL LOADS EXCEPT WIND, SEISMIC, AND VAPOR. SPECIFICALLY NOTED, THE MAGNITUDE, LOCATION AND DESIGN REQUIREMENTS FOR SPECIFIC CONCENTRATED AND LOCALIZED SUPERIMPOSED LOADS, IN ADDITION TO THE BASIC ALLOWANCES, ARE REFERENCED IN THE PLANS.

SPECIAL DESIGN LOADS (PSF): (LOAD CONDITIONS TO BE INCLUDED IN COMPONENT DESIGNS BY SPECIALTY ENGINEERS):

WIND PRESSURE	30
NET UPLIFT:	
ON ALL ROOF JOISTS AND ROOF TRUSSES	25
ON METAL DECK IN THE FIELD AREA	30
ON METAL DECK AT WALLS & CORNERS	INCREASE FIELD REQUIREMENT IN PROPORTION TO KBC PRESCRIBED INCREASES.

SNOW (NON-SIMULTANEOUS $s_w/L$ )	15
SOL BEARING PRESSURES (PSF):	
SPREAD FOOTINGS	2500
CONTINUOUS STRIP FOOTINGS	1500

PILE NOTES:

PILE TYPE = 16" X 48" CAST PILE

ALLOWABLE LOAD CAPACITY = 110 TONS

LENGTH OF PILES = 45'-0" (MIN.)

"SPECIFICATIONS AND COMMENTARIES FOR STEEL ROOF DECK", STEEL DECK INSTITUTE, PUBLICATION NO. 31.

"DIAPHRAGM DESIGN MANUAL", STEEL DECK INSTITUTE (DOW03).

PARAMETERS USED IN THE DESIGN OF THE PRINCIPAL FORCE-RESISTING STRUCTURAL SYSTEM

SNOW:	GROUND SNOW LOAD ( $P_g$ ) = 15 PSF FLAT ROOF SNOW LOAD ( $P_f$ ) = 0.9 PSF SNOW EXPOSURE FACTOR ( $C_e$ ) = 1.1 THERMAL FACTOR ( $C_t$ ) = 1.0	15 PSF 16.9 PSF 0.9 1.1
WIND:	BASIC WIND SPEED = 90 MPH WIND IMPORTANCE FACTOR ( $I_w$ ) = 1.15 WIND EXPOSURE = B INTERNAL PRESSURE COEFFICIENT = 0.18 DESIGN WIND PRESSURE FOR COMPONENTS AND CLADDING = 25.0 PSF	90 MPH 1.15 B 0.18 25.0 PSF
SEISMIC:	SEISMIC IMPORTANCE FACTOR ( $I_e$ ) = 1.25 OCCUPANCY CATEGORY = III MAPPED SPECTRAL RESPONSE ACCELERATION AT SHORT PERIODS ( $S_S$ ) = 0.248 (G) SITE CLASSIFICATION BASED ON GEO-TECH REPORT = D DESIGN SPECTRAL RESPONSE ACCELERATION AT ONE SEC PERIOD ( $S_1$ ) = 0.103 (G) DESIGN SPECTRAL RESPONSE ACCELERATION AT ONE SEC PERIOD ( $S_D1$ ) = 0.265 (G) SEISMIC DESIGN CATEGORY = 4 BASIC SEISMIC FORCE RESISTING SYSTEM = MOMENT RESISTING FRAME SYSTEMS AND ORDINARY STEEL MOMENT FRAMES	1.25 III 0.248 (G) D 0.103 (G) 0.265 (G) 4 MOMENT RESISTING FRAME SYSTEMS AND ORDINARY STEEL MOMENT FRAMES
	DESIGN BASE SHEAR = 414.43 KIPS SEISMIC RESPONSE COEFF. ( $C_s$ ) = 0.0429 RESPONSE MODIFICATION FACTOR ( $R$ ) = 3.5 ANALYSIS PROCEDURE = U.P.P. ZIP CODE = 40208 LATITUDE = 38.219 N LONGITUDE = -85.761 W	414.43 KIPS 0.0429 3.5 U.P.P. 40208 38.219 N -85.761 W

SPECIAL INSPECTIONS ARE REQUIRED AS FOLLOWS (PER KBC):

KBC SECTION	REQUIRED	DESCRIPTION OF INSPECTION OR TEST TO BE PERFORMED	COMPLY WITH REQUIREMENTS OF
1704.2	X	INSPECTION OF FABRICATORS:	ART. 1704.2.1
1704.2	X	A. STRUCTURAL STEEL	ART. 1704.2.1
1704.2	X	B. STEEL JOIST FABRICATION SHOP	ART. 1704.2.1
1704.2	X	C. METAL DECK ROLLING MILL	ART. 1704.2.1
1704.2	X	D. LIGHT GAGE STEEL TRUSS FABRICATION SHOP	ART. 1704.2.1
1704.2	X	E. LIGHT GAGE STEEL FRAMING FABRICATION SHOP	ART. 1704.2.1
1704.3	X	STEEL CONSTRUCTION	TABLE 1704.3
1704.4	X	CONCRETE CONSTRUCTION	TABLE 1704.4
1704.5	X	MASONRY CONSTRUCTION (NON-ESSENTIAL FACILITIES)	TABLE 1704.5.2 (LEVEL 1)
1704.5	X	MASONRY CONSTRUCTION (ESSENTIAL FACILITIES)	TABLE 1704.5.2 (LEVEL 2)
1704.6	X	HIGH-LOAD DIAPHRAGMS AND SHEAR WALLS	ART. 1704.6.1
1704.7	X	SOILS/SLICE PREPARATION	ART. 1704.7
1704.8	X	PILE FOUNDATIONS	ART. 1704.8
1704.9	X	PIER FOUNDATIONS	ART. 1704.9
1704.10	X	SPRAYED FIRE-RESISTANT MATERIALS	ART. 1704.10
1704.11	X	MASTIC AND INTUMESCENT FIRE-RESISTANT COATINGS	ART. 1704.11
1705	X	SEISMIC RESISTANCE	ART. 1705.3
1705	X	WIND RESISTANCE	ART. 1705.4
1707	X	SPECIAL INSPECTIONS FOR SEISMIC RESISTANCE	ART. 1707
1707	X	A. SPECIAL INSPECTION FOR SEISMIC RESISTANCE	ART. 1707.1
1707	X	B. STRUCTURAL STEEL	ART. 1707.2
1707	X	C. DOLD-FORMED STEEL FRAMING	ART. 1707.4
1707	X	E. PIER FOUNDATIONS	ART. 1707.5
1707	X	F. STORAGE RACKS & ACCESS FLOORS	ART. 1707.6
1707	X	G. ARCHITECTURAL COMPONENTS H, MECHANICAL & ELECTRICAL COMPONENTS	ART. 1707.7
1707	X	I. DESIGNATED SEISMIC SYSTEM VERIFICATIONS	ART. 1707.10
1707	X	J. SEISMIC ISOLATION SYSTEM	ART. 1707.10
1708	X	STRUCTURAL TESTING FOR SEISMIC RESISTANCE	ART. 1708
1708	X	A. MASONRY CONSTRUCTION	ART. 1708.1
1708	X	A.1 EMPIRICALLY DESIGNED NON-ESSENTIAL FACILITY	ART. 1708.1.2
1708	X	A.2 EMPIRICALLY DESIGNED ESSENTIAL FACILITY	ART. 1708.1.2
1708	X	A.3 ENGINEERED MASONRY IN NON-ESSENTIAL FACILITY	ART. 1708.1.4
1708	X	A.4 ENGINEERED MASONRY IN ESSENTIAL FACILITY	ART. 1708.1.4
1708	X	B. TESTING FOR SEISMIC RESISTANCE	ART. 1708.2
1708	X	C. REINFORCING & PRESTRESSING STEEL	ART. 1708.3
1708	X	D. STRUCTURAL STEEL	ART. 1708.4
1708	X	E. MECHANICAL & ELECTRICAL EQUIPMENT	ART. 1708.5
1708	X	F. SEISMICALLY ISOLATED STRUCTURES	ART. 1708.6
1709	X	STRUCTURAL OBSERVATIONS	ART. 1709

NOTE: INSPECTION OF FABRICATION SHOPS SHALL BE WAIVED BASED UPON THE FOLLOWING AFFILIATIONS:

STRUCTURAL STEEL - ACTIVE CERTIFICATION WITH THE AMERICAN INSTITUTE OF STEEL CONSTRUCTION (A.I.S.C.)

STEEL JOIST - ACTIVE MEMBER COMPANY WITH THE STEEL JOIST INSTITUTE (S.J.I.)

METAL DECK - ACTIVE MEMBER COMPANY WITH THE STEEL DECK INSTITUTE (S.D.I.)

LIGHT GAGE STEEL FRAMING - FULL VOTING MEMBER WITH THE STEEL STUD MANUFACTURER'S ASSOCIATION (S.S.M.A.)

ALL COSTS ASSOCIATED WITH ANY NECESSARY FAB SHOP INSPECTIONS SHALL BE THE RESPONSIBILITY OF THE FABRICATION SHOP AND PAID DIRECTLY TO THE PROJECT'S SPECIAL INSPECTION FIRM.

10. PROVISION FOR FUTURE EXPANSION: NONE

11. THIS BUILDING WAS DESIGNED IN ACCORDANCE WITH:

"BUILDING CODE REQUIREMENTS FOR STRUCTURAL CONCRETE AND COMMENTARY", ACI 318-08, ALTERNATE DESIGN METHOD.

"BUILDING CODE REQUIREMENTS AND SPECIFICATION FOR MASONRY STRUCTURES", ACI 530-08/ASCE 5-08/MSJC 402-08.

"SPECIFICATION FOR STRUCTURAL STEEL BUILDINGS", AISC, 2005, ALLOWABLE STRESS DESIGN.

"SPECIFICATIONS FOR STRUCTURAL JOINTS USING ASTM A325 OR A490 BOLTS", AISC, 2004.

"STANDARD SPECIFICATIONS FOR OPEN WEB STEEL JOISTS, K-SERIES", SJI, 2005.

"STANDARD SPECIFICATIONS FOR LONG-SPAN STEEL JOISTS, LH-SERIES AND DEEP LONG-SPAN STEEL JOISTS, DLH-SERIES", SJI, 2005.

"SPECIFICATIONS AND COMMENTARY FOR STEEL ROOF DECK", STEEL DECK INSTITUTE, PUBLICATION NO. 31.

"SPECIFICATIONS AND COMMENTARIES FOR NON-COMPOSITE STEEL FORM DECK", STEEL DECK INSTITUTE, PUBLICATION NO. 31.

"DIAPHRAGM DESIGN MANUAL", STEEL DECK INSTITUTE (DOW03).

1.4 SUBMITTALS

1. ANY REFERENCE TO SHOP DRAWINGS IN THE CONTRACT DOCUMENTS MEANS SHOP, ERECTION DRAWINGS, & ERECTION DRAWINGS. SHOP DRAWINGS ARE TO BE SUBMITTED BY THE CONTRACTOR, FOR THE SHOP PURPOSE OF DEMONSTRATING HIS/HER DEPTH OF UNDERSTANDING OF THE PROJECT REQUIREMENTS, RESOLVING THE COMPLEXITIES TO BE ANTICIPATED DURING THE CONSTRUCTION, PLANNING THE EXECUTION AND WORKING OUT THOSE SPECIFIC AND FINITE DETAILS REQUIRED TO CARRY OUT CONSTRUCTION. HENCE, BOTH SHOP AS WELL AS ERECTION DRAWINGS SHALL BE PREPARED BY THE MATERIAL SUPPLIER IN DETAIL. NEITHER DESIGN OR ERECTION DRAWINGS NOR PARTS THEREOF SHALL BE USED AS SHOP DRAWINGS. SUBSTITUTION OF DESIGN DRAWINGS FOR SHOP & ERECTION DRAWINGS IS IN VIOLATION OF ONE OR MORE OF THE STATUTES AND IS FORBIDDEN HEREIN AND THE SUBMITTAL WILL BE REJECTED.
2. SHOP DRAWINGS SHALL BE EXPLICIT, SUFFICIENT INFORMATION AND DETAILS SHALL BE SHOWN TO ENSURE THAT FABRICATORS, INSTALLERS AND ERECTORS ARE NOT REQUIRED TO INTERPRET REQUIREMENTS. THE SHOP DRAWINGS SHALL FULLY REPRESENT WHAT IS TO BE INSTALLED IN THE PROJECT. LABOR SAVING WORDS SUCH AS "TYP.", "VERIFY IN FIELD", "N-PLACES" SHOULD BE AVOIDED AND SUBMITTALS MAY BE RETURNED FOR EXPLICIT REPRESENTATIONS.

3. WHERE THE CONTRACTOR IS REQUIRED TO PROVIDE ENGINEERING DESIGN, THE SHOP DRAWINGS AND CALCULATIONS SUBMITTED ARE TO BE IN ACCORDANCE WITH THE FOLLOWING STAMPING AND SIGNING PROVISIONS. THE ITEMS SUBMITTED SHALL BE DESIGNED BY A STRUCTURAL ENGINEER REGISTERED IN THE STATE IN WHICH THE PROJECT IS LOCATED AND THE SHOP DRAWINGS SHALL BE STAMPED BY THE ENGINEER IN CHARGE OF DESIGN, THE STAMPING AND SIGNING SHALL CONFORM TO THE FOLLOWING:

- DRAWINGS:
- A. EACH SHEET OF A SET SHALL BEAR THE STAMP, SIGNATURE AND THE DATE SIGNED. THE SIGNATURE SHALL BE ACROSS THE STAMP.
- B. THE SHEET 1 OR TITLE PAGE SHALL BE WET SIGNED IN A DIFFERENT COLORED INK THAN THE MEDIA AND CONTAIN THE DATES OF SIGNATURE AND EXPIRATION DATE OF REGISTRATION IN ADDITION TO THE REQUIREMENTS STATED IN ITEM A.

CALCULATIONS:

- A. EACH SHEET OF A SET SHALL BEAR THE STAMP, SIGNATURE AND THE DATE SIGNED. THE SIGNATURE SHALL BE ACROSS THE STAMP.
- B. THE SHEET 1 OR TITLE PAGE SHALL BE WET SIGNED IN A DIFFERENT COLORED INK THAN THE MEDIA AND CONTAIN THE DATES OF SIGNATURE AND EXPIRATION DATE OF REGISTRATION IN ADDITION TO THE REQUIREMENTS STATED IN ITEM A.

STAMPING WHOLE OR PORTIONS OF DESIGN DRAWINGS, & THEIR USE AS SHOP DRAWINGS, IS IN VIOLATION OF CODE OF PROFESSIONAL PRACTICE AND CONDUCT ADOPTED BY THE AMERICAN SOCIETY OF PROFESSIONAL ENGINEERS & LAND SURVEYORS & AS PER KRS 322.180(4), THE REGISTRATION OF THE REGISTRANT MAY BE REVOKED OR SUSPENDED.

4. SUBMITTALS SHALL BE COMBINED TO INCLUDE ALL MATERIALS OR COMPONENTS NECESSARY TO COORDINATE & CONSTRUCT PARTICULAR ELEMENTS OF THE WORK. LARGE PROJECTS, HOWEVER, MAY BE SUBMITTED IN BUILDING AREA PHASES.

5. SHOP DRAWINGS FOR FABRICATION, BENDING & PLACEMENT OF CONCRETE OR MASONRY REINFORCEMENT SHALL COMPLY WITH LATEST EDITION OF ACI-315 "MANUAL OF STANDARD PRACTICE FOR DETAILING REINFORCED CONCRETE STRUCTURES", "SHOW BAR SCHEDULES, STIRRUP AND BAR SPACING, BAR LOCATION, INCLUDING ALL CMU DOWELS ON A PLAN VIEW, DETAIL OF BENT BARS, ARRANGEMENT OF BARS, CLEARANCES, BOLSTERS & OTHER ACCESSORIES, CONCRETE COVER AND CONTROL AND CONSTRUCTION JOINTS.

6. IF CUT SHEETS OR CATALOGUES ARE SUBMITTED FOR REVIEW, THE SPECIFIC PRODUCT DETAILS THAT WILL BE USED IN THIS PROJECT SHALL BE MARKED.

7. ALL SUBMITTALS SHALL HAVE BEEN FULLY REVIEWED & COORDINATED BY THE GENERAL CONTRACTOR BEFORE SUBMISSION TO THE STRUCTURAL ENGINEER FOR COMPLETE COMPLIANCE WITH THE REQUIREMENTS OF THE DESIGN DRAWINGS, GENERAL PROVISIONS & SPECIFICATIONS. FAILURE OF THE GENERAL CONTRACTOR TO COMPLY SHALL BE REASON FOR REJECTION OF THE SUBMITTAL. THE CONTRACTOR'S REVIEW SHALL ALSO DETERMINE THAT THE SUBMITTALS ARE ACCEPTABLE IN TERMS OF THE MEANS, METHODS, TECHNIQUES, SEQUENCES AND OPERATIONS OF CONSTRUCTION, SAFETY PRECAUTIONS AND PROGRAMS OF PROGRESS INDICATOR. THE REVIEW OF THE CONTRACTOR'S RESPONSIBILITIES. LABEL ALL SUBMITTALS WITH THE SPECIFICATION REFERENCE NUMBER UNDER WHICH THEY ARE TO BE REVIEWED AND PROVIDE SPACE FOR REVIEW COMMENTS.

8. THE CONTRACTOR SHALL CALL ATTENTION TO ANY SHOP DRAWING SUBMITTAL, AND ANY SPECIFIC PART THEREOF, THAT VARIES FROM WHAT THE PROJECT DOCUMENTS CALL FOR. THE JUSTIFICATION FOR SUCH VARIANCES SHALL BE CLEARLY STATED, AS SHALL ANY RESULTING COST SAVINGS TO BE PASSED ON TO THE OWNER. THE ENGINEER'S REVIEW OF THE ITEMS AT VARIANCE IN ANY SUCH SUBMITTAL WILL BE BILLED TO THE CONTRACTOR, AT THE ENGINEER'S DISCRETION.

9. RESUBMITTALS SHALL CLEARLY INDICATE THOSE SPECIFIC ITEMS THAT HAVE BEEN REVISED OR ADDED SINCE THE INITIAL REVIEW BY THE ENGINEER. FAILURE TO DO SO WILL BE REASON FOR REJECTION. THE ENGINEER'S COSTS IN REVIEWING SUBMITTALS OTHER THAN THE INITIAL SUBMITTAL, AND THE FIRST SUBSEQUENT RESUBMITTAL, WHEN CALLED FOR, WILL BE BILLED TO THE CONTRACTOR. THE GENERAL CONTRACTOR SHALL CLEARLY STATE THAT RESUBMITTALS COMPLY WITH THE DESIGN TEAM'S REVIEW COMMENTS.

10. ONE PAPER SEPA AND TWO BLUE LINE COPIES OF EACH SHOP DRAWING SHALL BE SUBMITTED, UNLESS NOTED OTHERWISE IN THE SPECIFICATIONS.

11. SUBMITTALS FOR CONCRETE & GROUT MIX DESIGNS SHALL INCLUDE REQUEST FOR, AND COMPLETION OF, SUBMITTAL FORM PRESCRIBED BY THE ENGINEER.

12. NON-COMPLIANCE WITH SUBMITTAL REQUIREMENTS WILL RESULT IN A DELAY IN THE RELEASE OF REVIEWED DOCUMENTS, FOR WHICH THE ENGINEER WILL NOT BE RESPONSIBLE.

13. SUBMITTAL PROCEDURES:

- A. GENERAL SUBMITTAL DATA IN ELECTRONIC FORMAT IS TO BE UTILIZED IN PLACE OF PAPER COPIES, WHEREVER POSSIBLE.
- B. ELECTRONIC SUBMITTALS

1. SUBMIT DATA IN A DIGITAL FORMAT, EITHER AS E-MAIL ATTACHMENT OR PHYSICALLY DRAWING ON FLOPPY OR CD RECORDING MEDIA, WHEREVER POSSIBLE. DRAWING FILES ARE TO BE IN A FORMAT THAT CAN BE OPENED BY AUTOCAD 2004, & TEXT FILES IN A FORMAT THAT CAN BE OPENED BY MICROSOFT EXCEL OR WORD. FILES THAT CAN ONLY BE OPENED BY AUTOCAD 5.0 OR IMAGE VIEWERS ARE ACCEPTABLE BUT ARE NOT PREFERRED. RAI'S REVIEW COMMENTS & STAMP WILL BE ADDED TO DWG FILES, IN THEIR OWN LAYER AND IN A CLEARLY IDENTIFIABLE FONT SIZE AND COLOR. RAI'S REVIEW COMMENTS & STAMP WILL BE ADDED IN A CLEARLY IDENTIFIABLE FONT STYLE & COLOR TO THE FILES. IF THE REVIEW COMMENTS ARE CREATED IN A SEPARATE MICROSOFT EXCEL OR WORD FILE, ALL REVIEWED SUBMITTALS WILL BE ELECTRONICALLY FORWARDED TO THE ARCHITECT FOR HIS/HER REVIEW AND SUBSEQUENT DISTRIBUTION. THE FORWARDED FILES WILL BE IN .PDF FORMAT AND ADDITIONALLY IN .DWG FORMAT, WHERE APPLICABLE.

- C. PAPER SUBMITTALS
1. SUBMIT DATA IN DUPLICATE. ONE COPY WILL BE USED FOR RAI'S REVIEW PROCESS & PROJECT RECORDS. REVIEW COMMENTS WILL BE TRANSCRIBED, OR ATTACHED, TO THE REMAINING COPY BEFORE FORWARDING TO THE ARCHITECT FOR HIS/HER REVIEW AND SUBSEQUENT DISTRIBUTION, AND ONE COURTESY COPIES OF XEROX PROCESS BLACK-LINE COPY OF THE FORWARDED DOCUMENTS WILL ALSO BE INCLUDED. RANGASWAMY & ASSOCIATES' COMMENTS WILL BE IDENTIFIED.

14. RANGASWAMY AND ASSOCIATES, INC. HAS PREPARED A "SUBMITTAL STANDARDS" GUIDE WHICH CAN BE VIEWED, PRINTED AND/OR DOWNLOADED FROM THE FOLLOWING WEB PAGE: <http://www.rangaswamy.com/submittalstandards.htm>. THE "SUBMITTAL STANDARDS" GUIDE IS NOT INTENDED TO BE EXHAUSTIVE FOR ALL SUBMITTALS AND ALL MATERIALS. THE "SUBMITTAL STANDARDS" GUIDE SHALL BE FOLLOWED FOR ALL APPLICABLE SHOP DRAWINGS AND SUBMITTALS.

1.5 TYPICAL DETAILS

1. TYPICAL DETAILS SHOWN IN THESE PLANS ARE PROVIDED TO ILLUSTRATE DESIGN PHILOSOPHIES AND MINIMUM REQUIREMENTS.

2. THE CONTRACTOR SHALL BE RESPONSIBLE FOR ACCOMMODATING SPECIFIC FIELD CONDITIONS WHILE PROVIDING FOR THE INTENT OF THE TYPICAL DETAILS.

3. COORDINATION OF THE EXACT LOCATIONS, AND QUANTITIES, OF THE TYPICAL DETAIL CONDITIONS IN COMPARISON TO THE ACTUAL PROJECT CONDITIONS SHALL BE THE RESPONSIBILITY OF THE GENERAL CONTRACTOR, AND PERFORMED AT NO ADDITIONAL COSTS TO THE OWNER OR THE OWNER'S AGENTS.

1.6 MISCELLANEOUS NOTES

1. LAYOUT DIMENSIONS SHOWN ON THE STRUCTURAL PLANS HAVE BEEN DERIVED FROM THE ARCHITECT'S PLANS AND INCLUDED FOR THE CONTRACTOR'S CONVENIENCE. THE CONTRACTOR IS RESPONSIBLE FOR CORRELATING AND VERIFYING THE LAYOUT DIMENSIONS ON THE STRUCTURAL PLANS WITH THE DIMENSIONS AND DIMENSIONS SHOWN ON THE ARCHITECTURAL PLANS, IF ARCHITECTURAL DETAILS, FEATURES OR ROOM LAYOUTS ARE SHOWN IN THE STRUCTURAL PLANS. THEY ARE TO BE USED AS A GUIDE ONLY. THE CONTRACTOR'S PURPOSES ONLY. DOCUMENT DISCREPANCIES, BETWEEN VARIOUS TRADES, SHALL BE BROUGHT TO THE ARCHITECT'S IMMEDIATE ATTENTION FOR FINAL RESOLUTION.

2. EACH CONTRACTOR SHALL VERIFY THE SIZE & LOCATION OF DUCT OPENINGS, DOWELS, LOUVERS, ETC. WITH THE MECHANICAL TRADES BEFORE PROCEEDING WITH THE WORK.

3. IF DIMENSIONS AND DETAILS ARE NOTED WITH AN ASTERISK (\*) THEY ARE TO BE DETERMINED BY THE CONTRACTOR FROM THE EQUIPMENT MANUFACTURERS' CERTIFIED DRAWINGS, AND INSTALLATIONS SHALL BE BASED ON SUCH INFORMATION.
4. SEE THE SPECIFICATIONS FOR SHORING AND BRACING REQUIREMENTS, STABILITY OF EXISTING STRUCTURES DURING CONSTRUCTION IS THE CONTRACTOR'S RESPONSIBILITY. ENGAGE THE SERVICES OF A STRUCTURAL ENGINEER REGISTERED IN THE STATE OF KENTUCKY TO SUPERVISE THE ERECTION OF TEMPORARY SUPPORTS AND PROCEDURES. SUCH ENGINEER SHALL CARRY PROFESSIONAL LIABILITY INSURANCE FOR \$1,000,000.00 MIN. AND SUBMIT CERTIFICATE OF INSURANCE FOR REVIEW BY THE ARCHITECT. ENGINEER'S SUBMITTALS, NOT ACCOMPANIED WITH CERTIFICATE OF PROFESSIONAL LIABILITY INSURANCE, WILL BE RETURNED WITHOUT FURTHER REVIEW.

1.7 CABINET DESIGN AND ANCHORING

1. CABINET AND CASEWORK DESIGN AND ITS ANCHORING TO STRUCTURAL ELEMENTS SUCH AS WALLS, BEAMS, JOISTS, COLUMNS, ETC. SHALL BE IN ACCORDANCE WITH SECTION 1613, "EARTHQUAKE LOADS" OF THE INTERNATIONAL BUILDING CODE, CURRENT EDITION. SEISMIC DESIGN PARAMETERS ARE FURNISHED UNDER GENERAL PROVISION NOTES SECTION 1.3 "DESIGN NOTES" SHOWN ON THE STRUCTURAL DRAWINGS.

2. THE STORAGE VERTICAL LIVE LOADS TO BE APPLIED TO THE HORIZONTAL FLAT SURFACES OF THE CABINETS OR CASEWORK SHALL BE 20 PSF IN ADDITION TO THE VERTICAL DEAD LOADS OF THE CABINETS FOR SIMPLY, ALL VERTICAL LOADS CAN BE ASSUMED TO BE APPLIED AT ONE HALF THE HORIZONTAL DEPTH OF THE CABINET.

3. THE HORIZONTAL EARTHQUAKE LOADS SHALL BE OBTAINED BY MULTIPLYING THE TOTAL VERTICAL LOAD (DEAD + LIVE) BY THE SEISMIC RESPONSE COEFFICIENT (C<sub>s</sub>) FURNISHED UNDER GENERAL PROVISION NOTES SECTION 1.3 "DESIGN NOTES" SHOWN ON THE STRUCTURAL DRAWINGS. FOR SIMPLICITY, THE HORIZONTAL EARTHQUAKE LOAD MAY BE APPLIED AT ONE HALF THE VERTICAL HEIGHT OF THE CABINET.

4. ANCHORS SHALL BE DESIGNED TO WITHSTAND THE RESOLVED COMPONENTS OF THE VERTICAL DEAD AND LIVE LOADS AS WELL AS HORIZONTAL SEISMIC LOADS ACTING SIMULTANEOUSLY ON THE ANCHOR.

5. ANCHOR DESIGN CALCULATIONS AND DETAILS SHALL BEAR THE SEAL AND SIGNATURE OF A STRUCTURAL ENGINEER LICENSED AND PRACTICING IN THE STATE OF KENTUCKY. THE STRUCTURAL ENGINEER SHALL HAVE PROFESSIONAL LIABILITY INSURANCE TO A LIMIT OF \$1,000,000.00 AND SUBMIT CERTIFICATE OF INSURANCE FOR ARCHITECT'S REVIEW AND FILE.

6. THE SHEET 1 OR TITLE PAGE SHALL BE WET SIGNED IN A DIFFERENT COLORED INK THAN THE MEDIA AND CONTAIN THE DATES OF SIGNATURE AND EXPIRATION DATE OF REGISTRATION IN ADDITION TO THE REQUIREMENTS STATED IN ITEM A.

7. REINFORCING STEEL PLACING DRAWINGS AND BAR LISTS SHALL CONFORM TO THE CURRENT EDITIONS OF THE AMERICAN SOCIETY OF INSTITUTES' AND DETAILING OF CONCRETE REINFORCEMENT (ACI 315) AND "MANUAL OF ENGINEERING AND PLACING DRAWINGS FOR REINFORCED CONCRETE STRUCTURES" (ACI 315R), AND THESE PUBLICATIONS SHALL BE INCLUDED IN THE PROJECT DOCUMENTS. ALL BAR AND MESH SUPPORTS MUST BE CLEARLY DETAIL.

8. ALL REINFORCING STEEL DETAILS SHALL BE IN ACCORDANCE WITH THE ACI "BUILDING CODE REQUIREMENTS FOR STRUCTURAL CONCRETE AND COMMENTARY" (ACI 318, CURRENT EDITION).

9. CONCRETE COVER SHALL BE PROVIDED FOR REINFORCING STEEL AS OUTLINED HEREIN AND SHALL BE INDICATED ON THE APPLICABLE REINFORCING STEEL SHOP DRAWINGS.

10. UNLESS NOTED OTHERWISE: MINIMUM COMPRESSIVE STRENGTH OF CONCRETE SHALL BE AS NOTED IN THE DESIGN NOTES. UNLESS NOTED OTHERWISE, MINIMUM CEMENT PER CUBIC YARD OF CONCRETE SHALL BE 540 POUNDS FOR SLABS, 560 POUNDS FOR ALL OTHER C.I.P. CONCRETE. MAXIMUM SLUMP, AT POINT OF PLACEMENT, SHALL BE 5" (+1") FOR SLABS AND 4" (+1") FOR ALL OTHER C.I.P. CONCRETE - UNLESS NOTED OTHERWISE, BEFORE THE ADDITION OF WATER REDUCING ADMIXTURES. FLASHY MIX SHALL NOT EXCEED MORE THAN 20% OF THE TOTAL CEMENTITIOUS MATERIAL. ALL SELECTED ADMIXTURES MUST BE COMPATIBLE WITH EACH OTHER, AND MAY NOT CONTAIN ANY CHLORIDE BASED COMPONENTS. MAXIMUM SLUMP OF CONCRETE TO RECEIVE A BUSH-HAMMERED FINISH SHALL BE 1 1/2" PRIOR TO THE ADDITION OF ADMIXTURES AND FLUIDIFIERS.

11. ALL MATERIALS USED IN THE CONCRETE CONSTRUCTION SHALL BE NEW. REINFORCING STEELS SHALL BE CONTINUOUS BETWEEN SPLICES. LOCATION OF ALL SPLICES SHALL BE PER PLANS OR AS APPROVED BY THE ARCHITECT. REINFORCING STEEL AND RECYCLED MATERIALS (EXCEPT CONCRETE FORMS AS ALLOWED IN THE SPECIFICATIONS) SHALL NOT BE USED IN THE CONSTRUCTION. ALL REJECTED MATERIALS SHALL BE REPLACED AT NO ADDITIONAL COST TO THE OWNER OR HIS AGENTS.

12. REINFORCING STEEL PLACING DRAWINGS AND BAR LISTS SHALL CONFORM TO THE CURRENT EDITIONS OF THE AMERICAN SOCIETY OF INSTITUTES' AND DETAILING OF CONCRETE REINFORCEMENT (ACI 315) AND "MANUAL OF ENGINEERING AND PLACING DRAWINGS FOR REINFORCED CONCRETE STRUCTURES" (ACI 315R), AND THESE PUBLICATIONS SHALL BE INCLUDED IN THE PROJECT DOCUMENTS. ALL BAR AND MESH SUPPORTS MUST BE CLEARLY DETAIL.

13. ALL REINFORCING STEEL DETAILS SHALL BE IN ACCORDANCE WITH THE ACI "BUILDING CODE REQUIREMENTS FOR STRUCTURAL CONCRETE AND COMMENTARY" (ACI 318, CURRENT EDITION).



- [illegible]

7. PROVIDE STRUCTURAL STEEL TUBE REINFORCEMENTS AT OPENINGS IF LIGHT GAGE FRAMING IS NOT FEASIBLE.
8. STRUCTURAL LIGHT GAGE STEEL FRAMING SHOWN IN THESE PLANS IS BASED ON THE PRODUCTS OF A PARTICULAR MANUFACTURER AND IS SHOWN TO ILLUSTRATE THE CONCEPT AND METHODS BEHIND THE SYSTEM. THE DESIGNERS ARE BY NO MEANS GUARANTEEING THE QUALITY OF THE MANUFACTURING PROCESS OR THE CAPABILITY OF A SYSTEM WHICH IS CAPABLE OF CARRYING THE LOADS PRESCRIBED BY THE LOCAL BUILDING CODES IS NOT SHOWN. THE FRAMING CONTRACTOR IS RESPONSIBLE FOR DESIGNING AND DETAILING ALL CONNECTIONS AND PANELS REQUIRED TO COMPLETE THE EXTERIOR WALL FRAMING PER PLAN AND PANEL CODE REQUIREMENTS.
9. ALL DESIGN SHALL BE PERFORMED BY A REGISTERED ENGINEER LICENSED TO PRACTICE IN THE STATE OF KENTUCKY. STRUCTURAL ENGINEER SHALL CARRY THE PROFESSIONAL LIABILITY INSURANCE. THE ENGINEER SHALL PROVIDE A PROFESSIONAL CERTIFICATE, DESIGN CALCULATIONS AND SHOP DRAWINGS EMPLOYED BY THE ENGINEER FOR REVIEW BY THE ARCHITECT. SUBMITTALS, NOT ACCOMPANIED WITH CERTIFICATE OF PROFESSIONAL LIABILITY INSURANCE, WILL BE RETURNED WITHOUT FURTHER REVIEW.

BRU
B.S.
BRG

- | STEEL LINTELS SCHEDULE:<br>8" MIN. BEARING EACH END.<br>L.L.V. = LONG LEG VERTICAL. |  |   |
|---|--|---|
| OPENING<br>WIDTH  | NUMBERS OF MEMBERS<br>PER THICKNESS OF MSRY. | MIN. MEMBER SZ.   |
| LESS THAN 3'-4"   | 1 PER 4" THICK                               | L3-1/2 x 3-1/2 x 3/8  |
| 3'-4" BUT LESS THAN 5'-6"   | 1 PER 4" THICK                               | L5 x 3-1/2 x 3/8 (L.L.V.)   |
| 5'-6" BUT LESS THAN 8'-6"   | 1 PER 4" THICK                               | L6 x 3-1/2 x 3/8 (L.L.V.)   |
| 8'-6" BUT LESS THAN 10'-6"  | 1 PER OPENING                                | W8 x 21 L 3/8" PLATE<br>@ BOT. FLD. FOR 6" CMU<br>W8 x 28 L 3/8" PLATE<br>@ BOT. FLD. FOR 8" CMU<br>W8 x 35 L 3/8" PLATE<br>@ BOT. FLD. FOR 12" CMU |
- SEE THE TYPICAL DETAILS FOR STEEL LINTEL VARIATIONS, OPTIONS, BEARINGS, ETC.

	B/W
--	-----

1. 1700X ELECTRODES SHALL BE USED FOR ALL WELDS.
2. FIELD WELDING OF STRUCTURAL STEEL JOISTS AND DECKING SHALL ONLY BE UNDERTAKEN IF APPROVED CERTIFIED WELDERS, SUBMIT WELDING CERTIFICATES TO THE ARCHITECT FOR REVIEW.
- WELDING OF WET CONTACT SURFACES IS NOT PERMITTED, STEPS SHALL BE TAKEN TO PRE-DRY THE CONTACT SURFACES UNDER SUCH CONDITIONS, WELDING OF SURFACES EXPOSED TO PRECIPITATION IS ALSO NOT PERMITTED UNLESS TEMPORARY PROTECTIVE COVERINGS ARE PROVIDED TO PREVENT FURTHER PRECIPITATION. AT THE CONTRACTOR'S OPTION, SHALL BE ALLOWED TO BLOCK OFF ANY ADDITIONAL COSTS TO THE OWNER OR THE OWNER'S AGENTS.
3. STEEL CONTACT SURFACES MUST BE A MINIMUM OF 40 DEGREES FAHRENHEIT FOR WELDING OPERATIONS TO TAKE PLACE. PRE-HEATING OF CONTACT SURFACES MAY BE UNDERTAKEN, AT THE CONTRACTOR'S OPTION, THE CONTRACTOR IS REQUIRED TO PROVIDE PROTECTIVE COVERINGS TO PREVENT FURTHER PRECIPITATION. A THERMOCOUPLED DESIGNED FOR MEASURING THE STEEL TEMPERATURE WITH NO INFLUENCES FROM THE SURROUNDING AIR TEMPERATURES. TEMPERATURE MEASUREMENTS SHALL BE TAKEN AT 10 AND NO LESS THAN 25% OF THE WELDED CONNECTIONS WHEN THE AIR TEMPERATURE HAS FALLEN BELOW 40 DEGREES FAHRENHEIT WITHIN THE LAST 24 HOURS. TEMPERATURE MEASUREMENTS SHALL BE TAKEN WITHIN SIX INCHES OF THE WELDED JOINTS, AND AT 100% OF THE WELDED CONNECTIONS WHEN THE AIR TEMPERATURE HAS FALLEN BELOW 40 DEGREES FAHRENHEIT WITHIN THE LAST 24 HOURS. TEMPERATURE MEASUREMENTS SHALL BE TAKEN WITHIN SIX INCHES OF THE PROPOSED WELDED CONNECTIONS.

5. PRE-HEATING OF STEEL THAT HAS FALLEN UNDER 40 DEGREES FAHRENHEIT SHALL COMPLY WITH THE RECOMMENDATIONS OF THE A.I.S.C. AND THE A.W.S. THE CONTRACTOR IS REQUIRED TO MONITOR THE TEMPERATURE OF EACH PRE-HEATED AREA USING EITHER STEEL TEMPERATURE MEASURING DEVICES THAT ARE DESIGNED FOR SUCH READINGS; OR BY THE USE OF A TEMPISTICK CRAYON DESIGNED TO MELT AT THE TEMPERATURE OF AT LEAST 100 DEGREES FAHRENHEIT. ABSOLUTELY NO PRE-HEATING OR WELDING OF STEEL SHALL TAKE PLACE WHEN THE SURROUNDING AIR TEMPERATURE HAS FALLEN BELOW ZERO DEGREES FAHRENHEIT WITHIN THE PAST 24 HOURS.

1. THE STEEL STEEL ROOF DECK SHALL BE TYPE F36, 1/4" DEEP, 22 GAUGE GALVANIZED DECK (15F36-22) AS MANUFACTURED BY WHEELING OR APPROVED EQUIVALENT PROVIDE 1 1/2" DEEP, 22 GAUGE GALVANIZED ACOUSTICAL DECK (NON-CELLULAR) AS MANUFACTURED BY WHEELING OR APPROVED EQUIVALENT OVER AREAS AS INDICATED BY THE ARCHITECT. COORDINATE ALL THESE SUCH AREAS WITH THE ARCHITECT. SEE SPECIFICATIONS FOR REQUIRED FIRE RATING CERTIFICATION.
  2. STEEL FLOOR DECK SHALL BE TENSILFORM TYPE 17, 20 GAGE, 3" NOMINAL DEPTH, GALVANIZED AS MANUFACTURED BY WHEELING OR APPROVED EQUIVALENT. DECKING SUPPLIER SHALL PROVIDE ALL CONCRETE STOPS, FLASHINGS, JOINTS, AND JOINT FINISHES, SHEET MATERIAL, AROUND COLUMNS, ETC. SO AS TO CONSTITUTE A COMPLETE SYSTEM.
  3. STEEL DECK CONSTRUCTION SHALL CONFORM TO THE STEEL DECK INSTITUTE'S DESIGN MANUAL FOR CONCRETE DECKS, FORM DECKS AND ROOF DECKS PUBLICATION NO. 31, CURRENT EDITION.
  4. ALL DECKS SHALL BE THREE OR MORE SPANS CONTINUOUS WHERE POSSIBLE.
  5. SEE THE SPECIFICATIONS AND TYPICAL DETAILS FOR MINIMUM REQUIREMENTS FOR FASTENING THE DECK TO ITS SUPPORTS.
  6. ALL OPENINGS THROUGH FLOOR OR ROOF DECKS SHALL NOT SHOWN ON THE STRUCTURAL PLANS SHALL BE FRAMED FOUR TIMES WITH ANGLE FRAMING SUPPORTED BY THE JOIST, UNLESS NOTED OTHERWISE. OPENINGS 4 FEET WIDE OR LESS PERPENDICULAR TO THE SPAN OF THE DECK SHALL BE FRAMED WITH MEMBERS PERPENDICULAR TO THE SPAN OF THE DECK SHALL BE FRAMED WITH MEMBERS DESIGNED TO CARRY THE SPECIFIED DESIGN LIVE AND DEAD LOADS. OPENINGS THROUGH FLOOR OR ROOF DECKS THAT ARE MORE THAN 4 FEET OR LESS THAN 2 SQUARE INCHES OR LESS, ARE NOT REQUIRED TO BE FRAMED AS NOTED ABOVE.
  7. UNLESS NOTED OTHERWISE, PROVIDE 1/3 x 3 x 1/4 AT UNSUPPORTED DECK BOUNDARIES PARALLEL TO DECK SPAN, AND AT EDGES OF DECKS THAT ARE CUT DIAGONALLY, SKEWED WALLS AND ALONG BOTH SIDES OF ALL ROOF RIPS AND VALLEYS, ETC.
  8. THE STEEL DECK SYSTEM IS DESIGNED AS A WIND FORCE RESISTING DIAPHRAGM. REFER TO GENERAL PROVISION SECTION 5.7 FOR FURTHER REQUIREMENTS.
  9. ALL METAL DECKS SHALL BE COMPOSITE DECK WHICH CONFORM TO THE CONDITIONS SHOWN IN THE DRAWINGS.
  10. ASSUME A SUITABLE CONSTRUCTION LIVE LOAD WHICH WILL CONSIDER THE PARTICULAR METHOD OF CONCRETE PLACEMENT. THE ASSUMED CONSTRUCTION LIVE LOAD SHALL NOT BE LESS THAN 20 PSF. THE CONCRETE CONTRACTOR SHALL NOT EXCEED THE CONSTRUCTION LIVE LOADS ASSUMED IN DESIGN WITHOUT TAKING PROPER SAFETY PRECAUTIONS, SUCH AS SHORING.
  11. SHEAR-STUDS SHALL BE WELDED THROUGH THE METAL DECK BY PREPARED METHODS.
  12. THE NON-CELLULAR METAL DECK SHALL HAVE WIDE RIBS SUITABLE FOR SHEAR-STUD PLACEMENT. THE CONFIGURATION OF THE METAL DECK SHALL BE SUCH AS TO DEVELOP THE MAXIMUM SHEAR CAPACITY FOR THE PARTICULAR WEIGHTS OF THE DECK, AS SPECIFIED IN THE AISC SPECIFICATION, LATEST EDITION.
  13. ALL DECK DESIGN IS TO BE ON A NON-SHORED BASIS UNLESS REQUIRED FOR THE DEAR LOAD CONSTRUCTION LOAD. THE METAL DECK CONTRACTOR SHALL SPECIFY WHERE SHORING IS NECESSARY IN HIS BID.
  14. PROVIDE STRAP ANCHORS, IF REQUIRED, FOR CONTROL OF CANTILEVER DEFLECTION AT EDGE OF FLOOR SLAB.
- ## 5.4 STRUCTURAL COLD-FORMED, LIGHT GAGE STEEL FRAMING
1. DESIGN, FABRICATION AND USE:
    - a. COLD-FORMED STEEL FABRICATED BY AMERICAN RIB AND STEEL INSTITUTE

## 5.7 ROOF DIAPHRAGM

- THE ROOF DECK IN THIS BUILDING IS DESIGNED AS A STRUCTURAL DIAPHRAGM TO RESIST THE HORIZONTAL SHEAR FROM WIND AND SEISMIC LOADS TO THE SHEAR WALLS.
- THE ROOF DECK SHALL BE MADE CONTINUOUS AT ALL RIDGES, HIPS AND VALLEYS USING A 16 G. (0.0589") THICK MINIMUM BENT PLATE AND SCREWING OR WELDING THE PLATE TO THE DECK. THE MINIMUM BENT PLATE SHALL BE 1/4" HILT OR VALLEY. LEGS OF BENT PLATE SHALL BE 6" MINIMUM AND AS NECESSARY TO FACILITATE PROPER LAP BETWEEN THE LEG AND METAL DECK, WELDING OR SCREW (FASTENINGS) SHALL MEET THE MINIMUM FASTENER SPECIFICATIONS SPECIFIED HEREIN UNLESS MORE STRINGENT REQUIREMENTS ARE SPECIFIED ELSEWHERE.
- THE MINIMUM ALLOWABLE SHEAR CAPACITY OF THE DIAPHRAGM AND CONNECTION THEREAT SHALL BE 2.75 AND THAT FOR MECHANICALLY FASTENED SHALL BE 2.3. ULTIMATE SHEAR CAPACITY OF THE DIAPHRAGM SHALL BE THE ALLOWABLE SHEAR CAPACITY MULTIPLIED BY THE FACTOR OF SAFETY.
- FOR WELDED DIAPHRAGM, MINIMUM WELDING REQUIREMENT IS AS FOLLOWS: THE SUPPORT FASTENERS SHALL BE 3/4" RIDDLE WELD SPACED AT 6" ON CENTERS AND 1/4" RIDDLE WELD SPACED AT 6" ON CENTERS AND THE SIDE LAP FASTENERS SHALL BE 1/4" RIDDLE WELD SPACED AT 6" ON CENTERS AND 1/4" ARC WELD SPACED AT 12" MAXIMUM ON CENTERS OR MINIMUM FIVE WELDS BETWEEN THE SUPPORTS, WHICHEVER IS MORE STRINGENT.
- FOR MECHANICALLY FASTENED DIAPHRAGM, MINIMUM FASTENING REQUIREMENT IS AS FOLLOWS: THE SUPPORT FASTENERS SHALL BE HILT EPW 3/8" X HSN SERIES FASTENERS SPACED AT 6" ON CENTERS AND THE SIDE LAP FASTENERS SHALL BE HILT EPW 3/8" X HSN SERIES FASTENERS SPACED AT 6" ON CENTERS AND THE SIDE LAP FASTENERS SHALL BE HILT EPW 3/8" X HSN SERIES FASTENERS BETWEEN THE SUPPORTS, WHICHEVER IS MORE STRINGENT. FOR ATTACHMENT TO STRUCTURAL STEEL SECTIONS USE HILT EPW2 FASTENERS.
- THE DECK SHEAR SHALL BE TRANSFERRED TO THE SHEAR WALLS THROUGH CORRELATOR PLATES OF 14 GAGE (0.0747") INSTALLED BETWEEN THE TRUSSES/JOIS AND FASTENED TO THE ROOF DECK AS PER THE MINIMUM FASTENING SPECIFIED HEREIN. THE CORRELATOR PLATES SHALL BE THE SPECIFIED ANGLE AND LENGTH OF THE WALL USING 1/8" FILLET WELD X 2" LONG SPACED AT 12" ALTERNATE. THIS CONDITION IS TYPICAL OVER THE ENTIRE LENGTH OF THE OUTER BOUNDARY OF THE INTERIOR WALLS. THE CORRELATOR PLATES SHALL BE WELDED TO THE WALLS PARALLEL TO THE INTERIOR SHEAR WALLS AND CONNECTED TO THE SHEAR WALLS ALONG THE LENGTH OF THE THRU, BENT PLATES ARE NOT NECESSARY OVER THESE INTERIOR WALLS.
- ROOF DECKING CONTRACTOR IS RESPONSIBLE FOR FURNISHING THE NECESSARY BENT PLATES AT ALL PLANE BREAKS. 14 GAGE BENT CORRELATOR PLATES, SUPPORT EDGE CORRELATOR PLATES AND CORRELATOR PLATES SHALL BE INSTALLED TO INSTALL A COMPLETE DIAPHRAGM SYSTEM AS DESCRIBED HEREIN.
- THE DIAPHRAGM CONTRACTOR SHALL HAVE MINIMUM FIVE YEARS EXPERIENCE IN INSTALLING STEEL DECK DIAPHRAGMS SIMILAR TO THOSE SHOWN IN THE PLANS. SUBMIT AT LEAST FIVE SIMILAR PROJECTS COMPLETED IN THE PAST FIVE YEARS WITH THE PROJECT ENGINEER, ARCHITECT, STRUCTURAL ENGINEER, INSURANCE BROKER WITH THEIR ADDRESSES AND TELEPHONE NUMBERS. SEISMIC DESIGN CATEGORY OF THE PROJECTS SUBMITTED SHALL BE "D" OR PER KUTNY BUILDING CODE, CURRENT EDITION.
- THE DIAPHRAGM DESIGN IS BASED ON FASTENERS FROM A SPECIFIC MANUFACTURER. THE DESIGN OF THE FASTENERS IS THE PROPERTY OF THAT MANUFACTURER AND MAY BE CONSIDERED PROVIDED THAT THE DESIGN IS CERTIFIED BY A PROFESSIONAL ENGINEER LOCATED AND LICENSED IN THE STATE OF KENTUCKY AND THE DIAPHRAGM DESIGN VALUES ARE JUSTIFIED BY ICBD EVALUATION REPORTS. STRUCTURAL ENGINEER SHALL OBTAIN PROFESSIONAL LIABILITY INSURANCE FOR \$1,000,000.00 MIN. SUBMIT INSURANCE CERTIFICATE, DESIGN CALCULATIONS AND SHOP DRAWINGS SUBMITTED BY THE ENGINEER FOR REVIEW BY THE ARCHITECT. THE ENGINEER SHALL ACCUMULATE AND MAINTAIN PROFESSIONAL LIABILITY INSURANCE, WILL BE RETURNED WITHOUT FURTHER REVIEW.


ABBREVIATIONS					
A.B.	=	ANCHOR BOLT	IN.	=	INCH/INCHES
ADD'L.	=	ADDITIONAL	INV.	=	INVERT
A.F.F.	=	ABOVE FINISHED FLOOR			
ALT.	=	ALTERNATE/ALTERNATIVE	JNT.	=	JOINT
ALUM.	=	ALUMINUM	J.S.T.	=	JOIST
APPROX.	=	APPROXIMATE	J.B.E.	=	JOIST BEARING ELEVATION
ARCH.	=	ARCHITECT/ARCHITECTURAL	L.L.V.	=	LONG LEG VERTICAL
Ø	=	AT	L.H.D.	=	LONG LEG HORIZONTAL
			L.S.H.	=	LONG SIDE HORIZONTAL
B./BOT./BOT.	=	BOTTOM	CONV.	=	CONVERSION
B.F.F.	=	BELOW FINISHED FLOOR	L.P.	=	LOW POINT
BLDG.	=	BUILDING	LYR.	=	LAYER/LAYERS
BM.	=	BEAM	MAX.	=	MAXIMUM
B.O.	=	BOTTOM OF	M.C.	=	MACHINE/MACHINERY
B.O.S.	=	BOTTOM OF STEEL	M.C.H.	=	MECHANICAL CONTRACTOR
BRCK.	=	BRICK	M.C.I.	=	MACHINE CONTROL JOINT
B.S.	=	BRICK SHELF	MCH.	=	MECHANICAL
BRG.	=	BREAST	MGH.	=	MANUFACTURER/MANUFACTURING
B/W	=	BETWEEN	MAT'L.	=	MATERIAL
C/C, c/c	=	CENTER TO CENTER (IN VARIOUS U.N.O.)	M.D.	=	MIDDLE / MID-POINT
CANT.	=	CANTILEVER	M.N.	=	MINOR
C.I.P.	=	CAST IN PLACE	MSRY.	=	MASONRY
C.J.	=	CONTROL JOINT	MTL.	=	METAL
CL.	=	CENTER LINE	NEC.	=	NECESSARY
CLR., CL	=	CLEAR	N.F.	=	NEAR FACE
CMU	=	CONCRETE MASONRY UNIT	N.T.S.	=	NOT TO SCALE
COL.	=	COLUMN	O.D.	=	OUTSIDE DIAMETER
CONC.	=	CONCRETE	O.F.	=	OUTSIDE FACE
CONSTR.	=	CONSTRUCTION	OPNG.	=	OPENING
CONN.	=	CONNECTION	OPP.	=	OPPOSITE
CONT.	=	CONTINUOUS	OR EQ.	=	OR EQUAL/EQUIVALENT (SEE NOTE BELOW)
CORP.	=	CORPORATION	O.C. OR O/C	=	ON CENTERS
CTR.	=	CENTER	PERIM.	=	PERIMETER
DET.	=	DETAIL	PL.	=	PLATE
DIA. OR Ø	=	DIAMETER	P.R.O.	=	PROPOSED
DM.	=	DIVISION	P.R.V.	=	PRESSURE RELIEF VALVE
DOWN.	=	DOWN	PT.	=	POINT
DO.	=	DITTO	R.C.	=	REINFORCED CONCRETE
DP.	=	DEEP	REIN.	=	REINFORCED / REINFORCEMENT
DWG.	=	DRAWING	REQ'D.	=	REQUIRED
DWL.	=	DOWEL	REQ'T.	=	REQUIREMENT
EA.	=	EACH	SIM.	=	SIMILAR
ELL. ELEV.	=	ELEVATION	SEC.	=	SECTION
E.F.	=	EACH FACE	S.C.J.	=	SAWN CONTROL JOINT
E.J.	=	EXPANSION JOINT	S.J.I.	=	STEEL JOIST INSTITUTE
ELEC.	=	ELECTRIC/ELECTRICAL	SP.	=	SPACE/SPACES
EMB./EMBED.	=	EMBEDMENT	SPEC.	=	SPECIFICATIONS
EQ.	=	EQUAL/EQUIVALENT	SQ. OR □	=	SQUARE
E.W.	=	EACH WAY	S.S.	=	STAINLESS STEEL
EXP.	=	EXPANSION	STAG.	=	STAGGER/STAGGERED
EXTG.	=	EXISTING	STF.	=	STIFFENER
F.D.	=	FLOOR DRAIN	STND.	=	STANDARD
F.F.	=	FAR FACE	STIRR.	=	STIRRUP
FIN.	=	FINISH/FINISHED	STL.	=	STEEL
FLG.	=	FLANGE	STR.	=	STRAIGHT
FLR.	=	FLOOR	T.	=	TOP
FND.	=	FOUNDATION	TH.	=	THICK
FT.	=	FOOT/FEET	THK.	=	THICK/THICKNESS
FTG.	=	FOOTING	THRU	=	THROUGH
F.F.E.	=	FINISHED FLOOR ELEVATION	T.O.	=	TOP OF
GA.	=	GAGE	T.O.S.	=	TOP OF STEEL
G.C.	=	GENERAL CONTRACTOR	TRANS.	=	TRANSVERSE
GR.	=	GRADE/GROUND	TYP.	=	TYPICAL/TYPICALLY
GRG.	=	GRATING	T.O.F. / T/F	=	TOP OF FOOTING
H.	=	HORIZONTAL REINFORCING	T/W	=	TOP OF WALL
HK.	=	HOOK	U.N.O.	=	UNLESS NOTED OTHERWISE
HORIZ.	=	HORIZONTAL	V. VERT.	=	VERTICAL
H.P.	=	HIGH POINT	V.I.F.	=	VERIFY IN FIELD
HR.	=	HANDRAIL	V.W.A.	=	VERIFY WITH ARCHITECT
HT.	=	HIGH/HEIGHT	W/	=	WITH
I.D.	=	INSIDE DIAMETER	WD.	=	WIDTH/WIDTH
I.F.	=	INSIDE FACE	W.P.	=	WORK POINT
			W.S.	=	WATERSTOP

NOTE: "OR EQUAL" MEANS EQUIVALENT IN THE OPINION OF THE ENGINEER.

"PROVIDE FOR" MEANS FURNISH AND INSTALL INCLUDING COORDINATION WITH MATERIAL AND EQUIPMENT SUPPLIERS' REQUIREMENTS.

The diagram illustrates five standard architectural symbols used in section drawings:


- BUILDING SECTIONS:** A circular symbol divided vertically. The left half is white and contains the number '1'. The right half is black and contains the text 'S0160'. An arrow points to the black half with the label 'SECTION NUMBER'. Another arrow points to the black half with the label 'DIRECTION IN VIEW'. A third arrow points to the black half with the label 'SHEET WHERE DRAWN'.
- MATCH LINE:** A horizontal line with a dashed center. Above the line is the text 'S0XXX' and below the line is the text 'S0XXX'. An arrow points to the right 'S0XXX' with the label 'DRAWING WHERE CONTINUATION IS FOUND'.
- ELEVATION DESIGNATION:** A circular symbol divided vertically. The left half is white and the right half is black. To the right of the circle is the text 'F.F.E. = XXX'-X"'. An arrow points to the black half with the label 'DIRECTION IN VIEW'.
- DETAIL REFERENCE:** A dashed rectangular box. To its right is a circular detail symbol. The detail symbol is divided vertically. The left half is white and contains the text 'X'. The right half is black and contains the text 'S0XXX'. An arrow points from the detail symbol to the dashed box with the label 'AREA OF ENLARGED VIEW'. Another arrow points to the black half of the detail symbol with the label 'DETAIL NUMBER'. A third arrow points to the black half of the detail symbol with the label 'SHEET WHERE DRAWN'.
- BUILDING ELEVATIONS:** A symbol consisting of a white square with a black triangle on top. An arrow points to the black triangle with the label 'DIRECTION IN VIEW'. Another arrow points to the white square with the label 'SHEET WHERE DRAWN'.

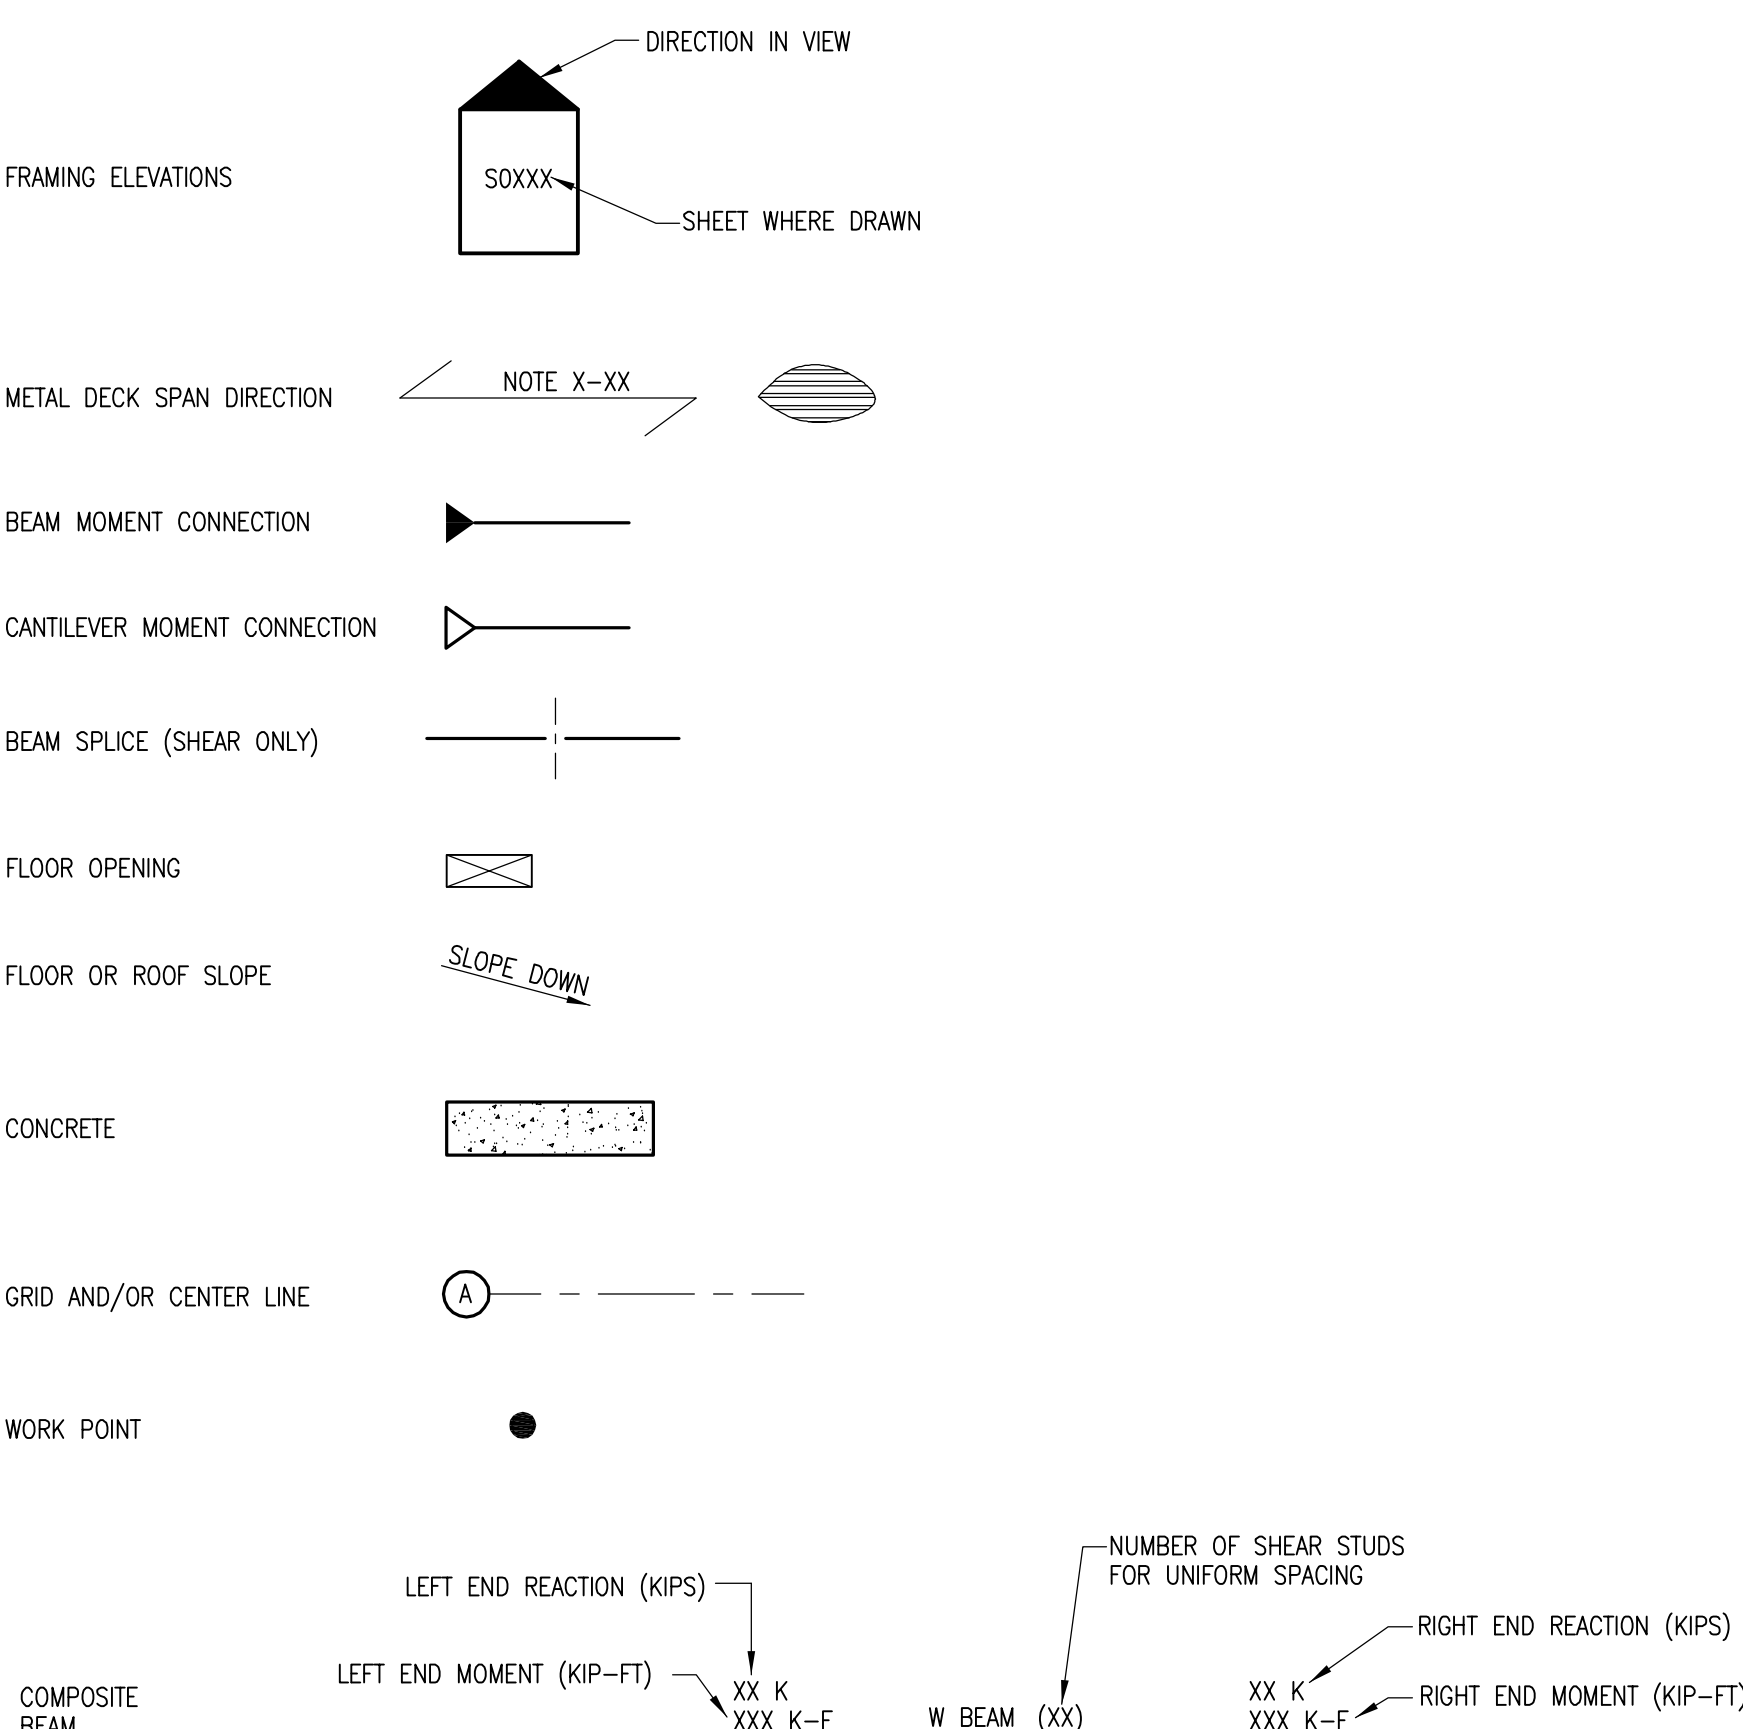


XX K ← RIGHT END REACTION (KIPS)  
XXX K-F ← RIGHT END MOMENT (KIP-FT)

<b>Drawing Name:</b> GENERAL PROVISIONS CONT'D	#	Revision Date	
<b>U of L Project Number:</b>			
<b>Project Number:</b> Omni — 03687.00			
<b>Date:</b> March 02, 2012			
<b>Drawn By:</b> PGK	<b>Checked By:</b> ANTHONY		

S0001



**Omni**  
ARCHITECTS



UNIVERSITY OF  
**LOUISVILLE**

212 North Upper Street  
Lexington, Kentucky 40507-1001

p 859.252.6664 f 859.253.2358


www.omniarchitects.com

**CANNONDESIGN**

**RANGASWAMY AND ASSOC., INC.**

Suite 420, The Landmark Building  
1000 Lexington Avenue  
Lexington, Kentucky 40502


phone: (502) 389-2412  
Fax: (502) 389-2240 • www.rangaswamy.com



**DISCLAIMER NOTE:**  
THIS SET OF CONSTRUCTION DRAWINGS HAS BEEN UPDATED TO INCLUDE ANY CHANGES ISSUED THROUGH ADDENDUM OR OTHER MEANS. EVERY EFFORT HAS BEEN TAKEN TO INCLUDE ALL CHANGES TO DATE. THE CONTRACTOR IS STILL RESPONSIBLE FOR PROVIDING ANY ITEMS THAT WERE SHOWN AS PART OF THE ORIGINAL BID SET THAT MAY HAVE BEEN OVERLOOKED AND NOT INCLUDED IN THIS SET.

**S0001**



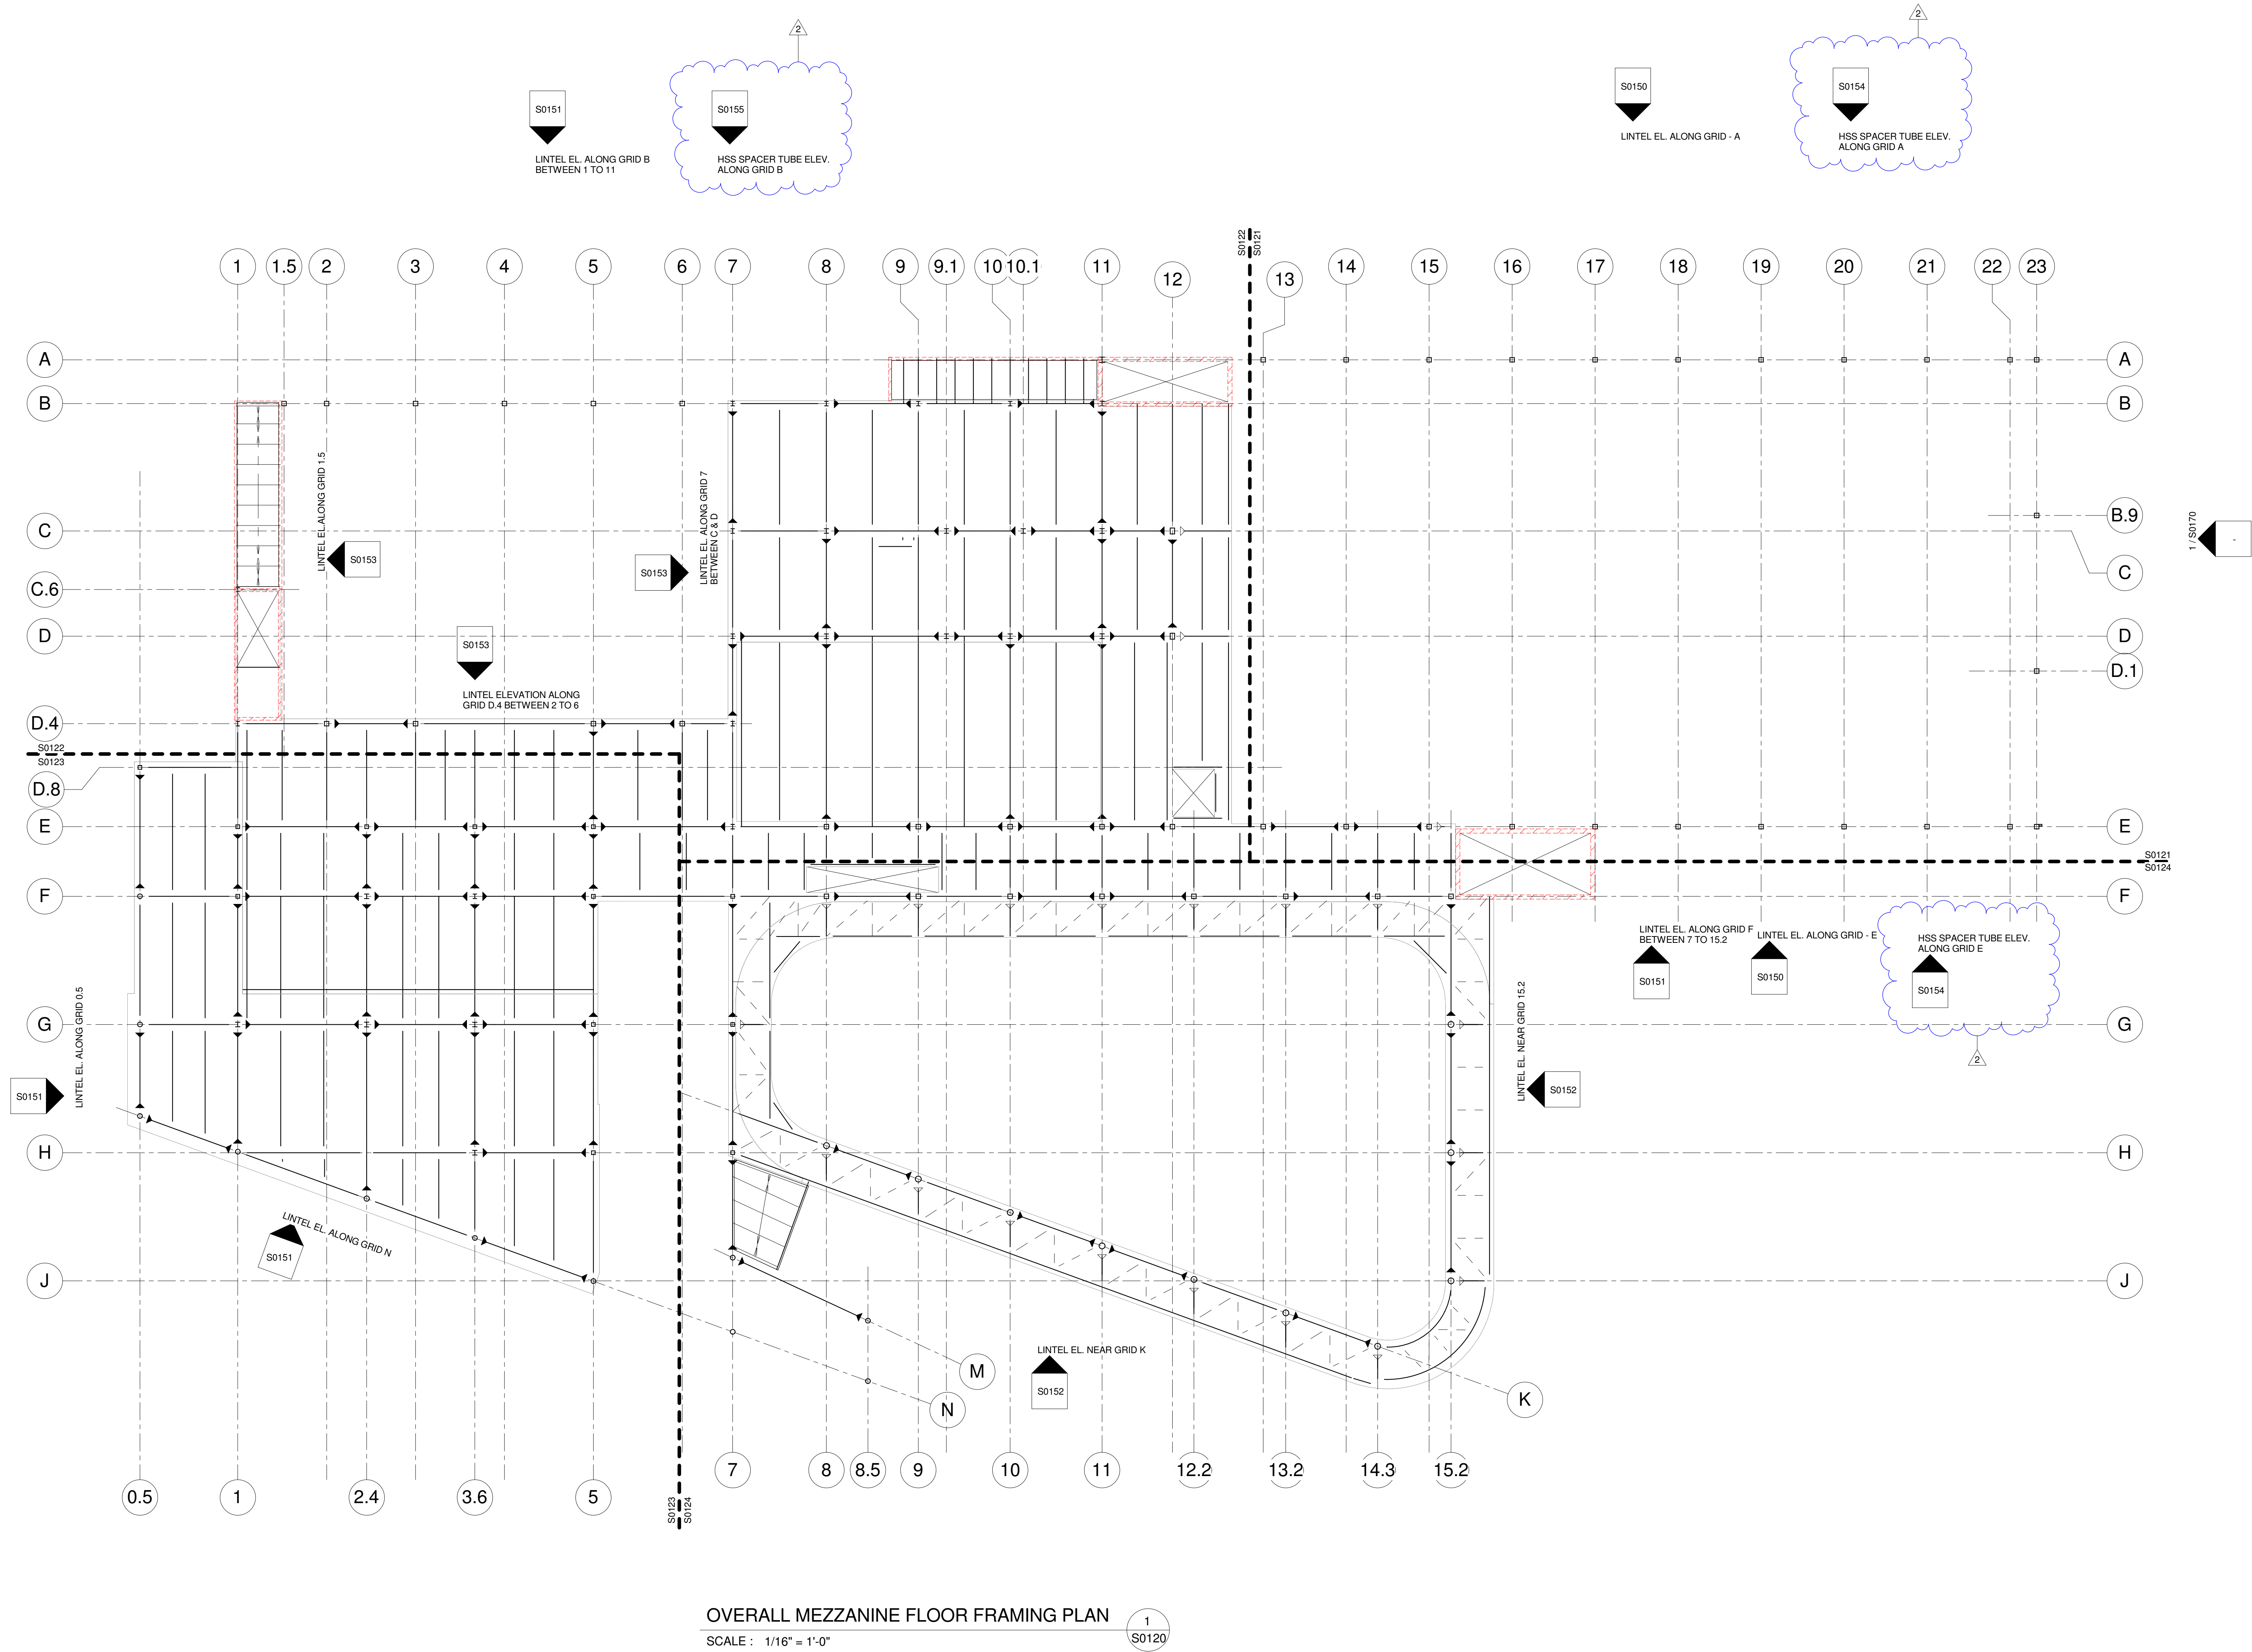


LEGEND:

☁ = CLOUDED ITEMS WHERE CHANGED PER ADDENDUM

➔ = ADDENDUM NUMBER

DISCLAIMER NOTE:

THIS SET OF CONSTRUCTION DRAWINGS HAS BEEN UPDATED TO INCLUDE ANY CHANGES ISSUED THROUGH ADDENDUM OR OTHER MEANS. EVERY EFFORT HAS BEEN TAKEN TO INCLUDE ALL CHANGES TO DATE. THE CONTRACTOR IS STILL RESPONSIBLE FOR PROVIDING ANY ITEMS THAT WERE SHOWN AS PART OF THE ORIGINAL BID SET THAT MAY HAVE BEEN OVERLOOKED AND NOT INCLUDED IN THIS SET.

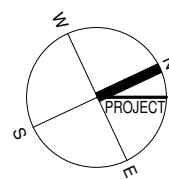

# University of Louisville - Student Recreation Center (Phase #3 - Construction Set) Louisville, Ky

Drawing Name:	OVERALL MEZZANINE FLOOR FRAMING PLAN
U of L Project Number:	Omni - 1105.00
Project Number:	Cannon - 03667.00
Date:	March 02, 2012
Drawn By:	VPP
Checked By:	ANTHONY



**Omni** ARCHITECTS  
212 North Upper Street  
Lexington, Kentucky 40507-1001  
p 859.252.6664 f 859.253.2358  
www.omniarchitects.com


**CANNONDESIGN**

**PD&A**

**RANGASWAMY AND ASSOC., INC.**  
Suite 402, The Landmark Building  
Louisville, Kentucky 40202  
p 502.586.2244 f 502.586.2245  
Fax: 1 502.586.2240 : www.rangaswamy.com

S0120



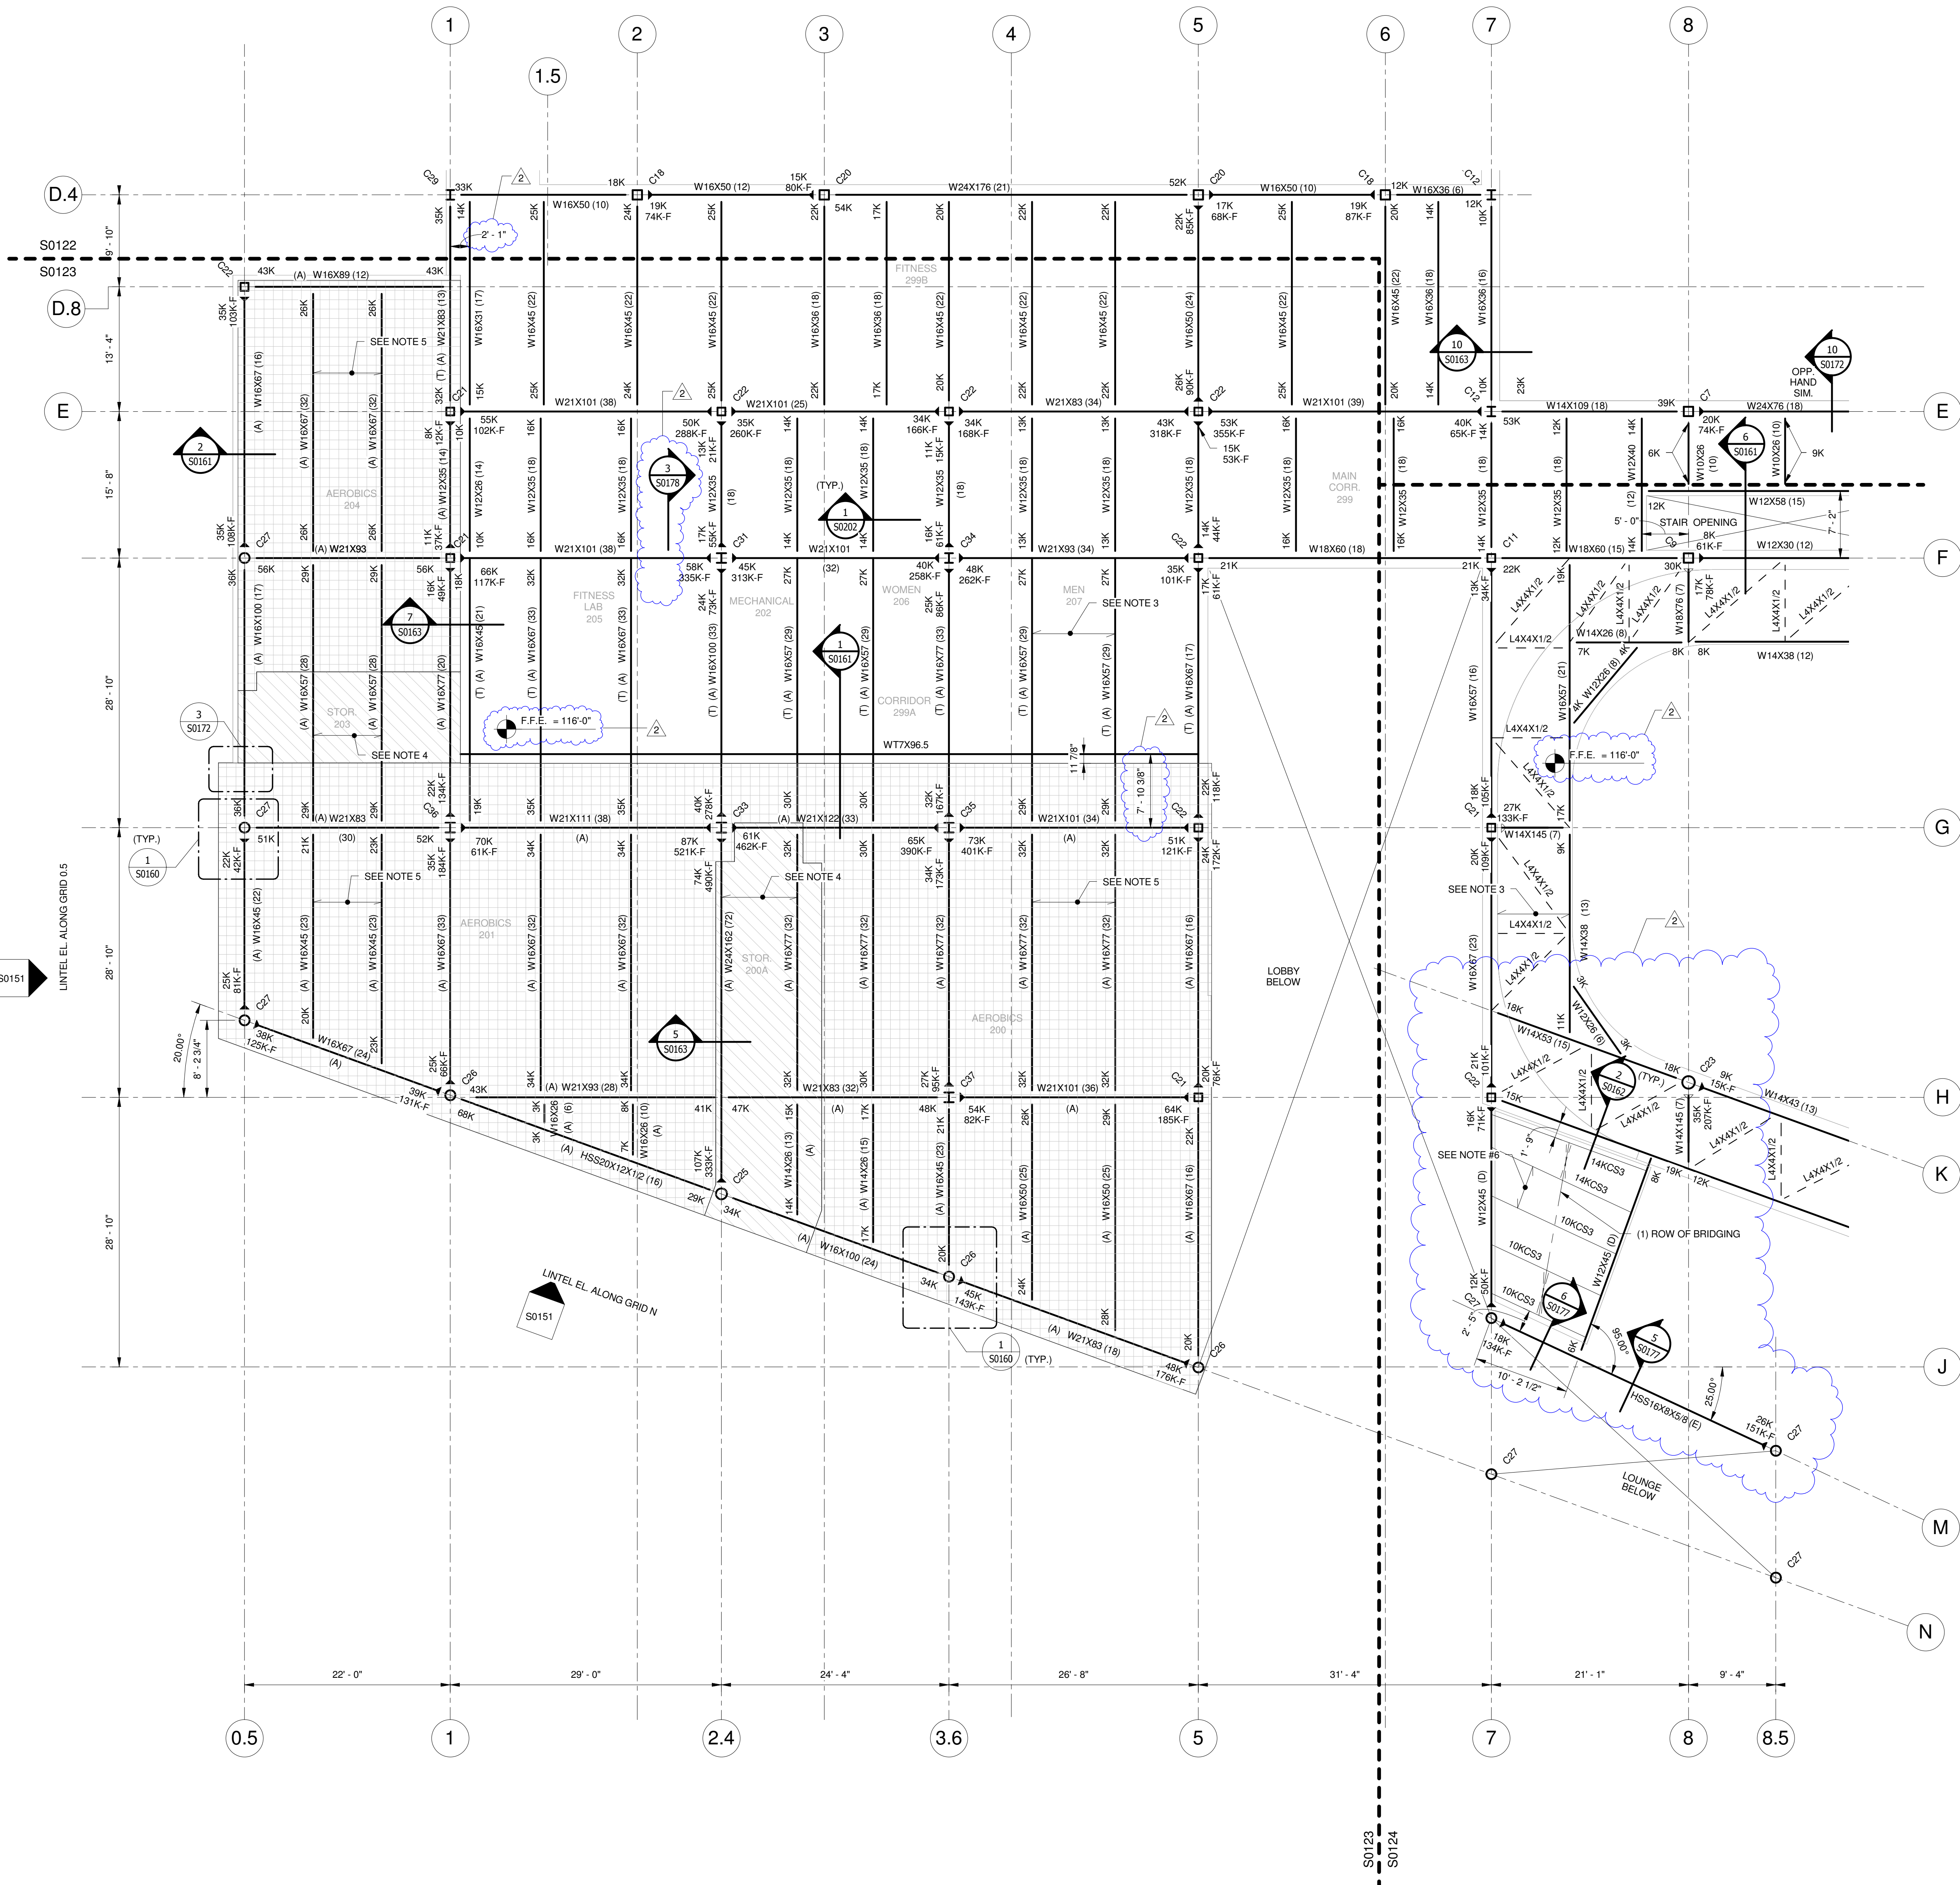

MEZZANINE FLOOR FRAMING PLAN- AREA-C

SCALE: 1/8" = 1'-0"

1

S0123

DISCLAIMER NOTE:

THIS SET OF CONSTRUCTION DRAWINGS HAS BEEN UPDATED TO INCLUDE ANY CHANGES ISSUED THROUGH ADDENDUM OR OTHER MEANS. EVERY EFFORT HAS BEEN TAKEN TO INCLUDE ALL CHANGES TO DATE. THE CONTRACTOR IS STILL RESPONSIBLE FOR PROVIDING ANY ITEMS THAT WERE SHOWN AS PART OF THE ORIGINAL BID SET THAT MAY HAVE BEEN OVERLOOKED AND NOT INCLUDED IN THIS SET.

MEZZANINE FLOOR FRAMING NOTES:

- ESTABLISHED ELEVATIONS:  
F.F.E. 116'-0" UNO  
TOP OF BEAM EL. 115'-5 3/4" UNO  
ELEVATIONS ARE TO BE AS INDICATED ABOVE, UNLESS OTHERWISE NOTED +/- INCHES ABOVE/BELOW.
- MAXIMUM SPACING BETWEEN FLOOR BEAMS, AND BETWEEN ALL OTHER FLOOR BEARING MEMBERS, SHALL NOT EXCEED 11'-0" C/C.
- TYPICAL FLOOR SLAB (6 1/4" TOTAL DEPTH) 3 1/4" LIGHT WEIGHT CONCRETE W/FIBERMESH ON 3 VLL 18 GAGE GALVANIZED METAL DECK BY VULCRAFT OR APPROVED EQUIVALENT (TYP., U.N.O.).
- FLOOR SLAB (6 1/4" TOTAL DEPTH) 3 1/4" MIN. LIGHT WEIGHT CONCRETE W/FIBERMESH ON 3 VLL 18 GAGE GALVANIZED METAL DECK BY VULCRAFT OR APPROVED EQUIVALENT (TYP., U.N.O.) AND 4" TOPPING SLAB W/FIBERMESH CONCRETE ABOVE INSULATION. SEE DETAIL (5/S0163).
- FLOOR SLAB (6 1/4" TOTAL DEPTH) 3 1/4" MIN. LIGHT WEIGHT CONCRETE W/FIBERMESH ON 3 VLL 18 GAGE GALVANIZED METAL DECK BY VULCRAFT OR APPROVED EQUIVALENT (TYP., U.N.O.) AND 4" TOPPING SLAB W/FIBERMESH CONCRETE ABOVE INSULATION. SEE DETAIL (5/S0163).
- REFER TO ARCHITECTURAL, MECHANICAL, PLUMBING AND ELECTRICAL DRAWINGS FOR HOUSEKEEPING AND/OR EQUIPMENT PADS, CURB SIZES AND LOCATIONS. SIZES AND LOCATIONS OF PAD SHALL BE VERIFIED WITH APPROVED MANUFACTURER'S EQUIPMENT SHOP DRAWING PRIOR TO CONSTRUCTION.
- ALL FLOOR DRAINS MAY NOT BE SHOWN. COORDINATE EXACT LOCATIONS AND QUANTITIES WITH THE PLUMBING DRAWING. PROVIDE POSITIVE SLOPES (WARPS) IN T.O. FLOOR SLAB IN ORDER TO PROVIDE REQUIRED DRAINAGE. COORDINATE FLOOR FINISHES WITH THE ARCHITECT.
- ALL BEAMS HAVE 1 ROW OF STUDS (UNO).  
NUMBER OF STUDS PER BEAM DENOTED THUS ( )
- COLUMN CALLOUT DENOTED THUS:  
Cxx COLUMN DESIGNATION  
[SEE COLUMN SCHEDULE]
- PROVIDE #4@12" o.c. TOP TRANSVERSE, OVER ALL BEAMS W/#4@12" o.c. LONGIT. (TYP.) SEE TYPICAL COMPOSITE SLAB REINF. DETAIL (1/S0202).
- REFER TO ARCHITECTURAL DRAWINGS AND MEP DRAWINGS FOR SLAB OPENINGS AND PENETRATIONS.
- REFER TO ARCHITECTURAL DRAWINGS FOR STAIR DIMENSION AND CONSTRUCTION. SLAB DEPRESSIONS AND ELEVATOR OPENINGS.
- SEE STRUCTURAL LINTEL ELEVATION SHEETS FOR LINTEL BEAMS AND METAL PANEL FRAMING DETAILS.
- PROVIDE 1/4" THICK BENT PLATE OR 1/4" THICK ANGLE FOR ALL DECK EDGE FRAMING. IF THE CANT. LENGTH IS LESS THAN OR EQUAL TO 1'-0", FOR COMPOSITE DECK EDGE DETAIL SEE 2/S0202.
- PROVIDE ADD'L REINF. (2) #5 BENEATH NON-LOAD BEARING CMU WALLS FOUNDED ON FLOOR SLAB.
- PROVIDE SLIP CONNECTION PER DETAIL 2/S0200 FOR BEAMS BEARING ON MASONRY.
- COORDINATE WITH ARCH. FOR SLAB EDGE / BOUNDARY DETAILS.


ROOF FRAMING NOTES:

- #1. [Symbol] INDICATES JOIST BOTTOM CHORD EXTENSION. MAKE FINAL ATTACHMENT TO COLUMN ONLY WHEN ALL ROOF DEAD LOADS ARE IN PLACE. JOISTS LOCATED ON COLUMN LINES SHALL ALWAYS BE "KCS" SERIES JOISTS AND THE JOIST END MOMENT SHALL BE 75% OF THE JOIST MOMENT CAPACITY.
- #2. MAXIMUM SPACING BETWEEN STEEL BAR JOISTS SHALL NOT EXCEED 5'-0" C/C, U.N.O.
- #3. UNLESS NOTED OTHERWISE, ALL ROOF JOIST SEATS SHALL BE 4" DEEP.
- #4. TERMINATE ALL S.J.I. BRIDGING LINES AS SHOWN ON DETAILS 5/S0200 (SIMILAR), 12/S0200 & 10/S0201.
- #5. ALL JOISTS SHALL BEAR ON STEEL BEAMS OR STEEL PLATES THAT ARE SOLIDLY GROUTED INTO CMU. DO NOT BEAR JOISTS ON HOLLOW CMU BLOCKS, WOOD, ETC. UNLESS APPROVED BY THE ARCHITECT. WELD OR BOLT JOISTS TO BEARING STEEL PER THE JOIST SUPPLIER'S SHOP DRAWING DETAILS.
- #6. TYPICAL ROOF DECK TYPE B, 1 1/2" DEEP 20 GAGE G-90 DECKING BY VULCRAFT OR APPROVED EQUIVALENT. (TYP., U.N.O.)
- #7. FIELD MODIFICATIONS TO BAR JOISTS SHALL ONLY BE PERFORMED WITH THE PERMISSION OF THE JOIST SUPPLIER.
- #8. ALL OPENINGS THROUGH THE ROOF THAT EXCEED 6" DIAMETER OR 30 SQUARE INCHES SHALL HAVE THE DECK SUPPORTED USING STEEL MEMBERS, JOIST HEADERS, ETC. - SEE DETAIL 7/S0201.
- #9. WELD OR SCREW METAL DECK TO SUPPORTS PER THE DECKING SUPPLIER'S SHOP DRAWING DETAILS. DECKING SUPPLIER MUST GRANT PERMISSION FOR ANY CHANGES TO THE ATTACHMENT METHODS.
- #10. ALL WATER PIPES OVER 3" IN DIAMETER SHALL BE HUNG FROM JOIST PANEL POINTS OR JOIST CHORDS SHALL BE REINFORCED PER TYPICAL DETAIL 4/S0200.
- #11. MECHANICAL EQUIPMENT HANGING UNDER THE ROOF JOISTS SHALL BE SUPPORTED BY AT LEAST THREE JOISTS. SEE TYPICAL DETAILS FOR JOIST REINFORCEMENT REQUIREMENTS. STRUCTURAL IS NOT RESPONSIBLE FOR THE DESIGN OF THE ACTUAL MEMBERS USED TO DISTRIBUTE, SUPPORT AND ISOLATE THE ACTUAL EQUIPMENT AND ITS LOADS.
- #12. MECHANICAL EQUIPMENT SITTING ON THE ROOF SHALL BE LOCATED SO THAT RELATIVE ROOF OPENINGS FOR THE EQUIPMENT DO NOT INTERFERE WITH JOISTS OR BRIDGING LINES. SEE DETAIL 7/S0201 FOR DECK SUPPORT AT ROOF OPENINGS.
- #13. RD INDICATES ROOF DRAIN. ALL ROOF DRAINS MAY NOT BE SHOWN. COORDINATE EXACT LOCATIONS AND QUANTITIES WITH THE PLUMBING DRAWINGS. PROVIDE POSITIVE SLOPES/WARPS TO THE ROOF IN ORDER TO PROVIDE REQUIRED DRAINAGE. COORDINATE ROOF FINISHES WITH THE ARCHITECT.

LEGENDS:

- [Symbol] = 12" REINFORCED CMU w/(2) #6 IN EACH CORE
- [Symbol] = 12" REINFORCED CMU w/(2) #7 IN EACH CORE
- [Symbol] = LOAD BEARING CMU WALL AND/OR EXTERIOR CMU WALL ABOVE
- [Symbol] = ADDITIONAL VERTICAL CMU REINF. REQUIRED (SEE TYPICAL DETAIL)
- [Symbol] = LOAD BEARING CMU WALL AND/OR EXTERIOR CMU WALL BELOW
- [Symbol] = STANDARD S.J.I. BRIDGING
- [Symbol] = INDICATES MOMENT CONNECTION BY OTHERS
- [Symbol] = INDICATES CANTILEVER MOMENT CONNECTION BY OTHERS.
- [Symbol] = REFER TYPICAL DETAIL 14/S0200 FOR BEAM AND COLUMN CONNECTION. (U.N.O.)
- (A) = INDICATES TOP OF STEEL ELEVATION 114'-10"
- (B) = INDICATES TOP OF STEEL ELEVATION 115'-3 7/8"
- (C) = INDICATES TOP OF STEEL ELEVATION 137'-1 1/2"
- (D) = INDICATES TOP OF STEEL ELEVATION 115'-1 3/4"
- (E) = INDICATES TOP OF STEEL ELEVATION 113'-4 3/8"
- (T) = INDICATES W77X96.5 ABOVE BEAM, T.O.S. EL. 115'-5 3/4"
- (H1) = INDICATES HSS3X3X1/4 ABOVE ROOF BEAM, T.O.S. EL. VARIES, SEE PLAN
- (H2) = INDICATES HSS5X2 1/2X3/16 ABOVE FLOOR BEAM, T.O.S. EL. 137'-1 1/2"
- (H3) = INDICATES HSS8X8X1/2 ABOVE ROOF BEAM, T.O.S. EL. VARIES, SEE PLAN
- (H4) = INDICATES HSS10X10X1/2 ABOVE ROOF BEAM, T.O.S. EL. VARIES, SEE PLAN
- [Symbol] = AEROBICS STORAGE FLOOR SLAB - 7 3/4" DEPRESSION
- [Symbol] = AEROBICS FLOOR SLAB - 7 3/4" DEPRESSION
- [Symbol] = RACQUET BALL FLOOR SLAB - 1 7/8" DEPRESSION
- [Symbol] = GYM FLOOR SLAB - 2 1/2" DEPRESSION
- [Symbol] = CLOUDED ITEMS WHERE CHANGED PER ADDENDUM
- [Symbol] = ADDENDUM NUMBER

Keyplan

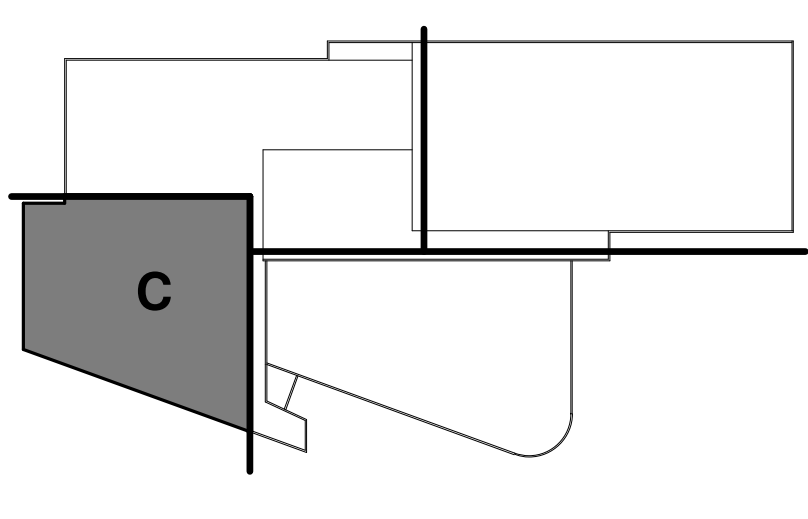

University of Louisville - Student Recreation Center (Phase #3 - Construction Set) Louisville, Ky

212 North Upper Street  
Lexington, Kentucky 40507-1001  
p 859.252.6664 f 859.253.2358  
www.omniarchitects.com

Omni  
ARCHITECTS



UNIVERSITY OF  
LOUISVILLE

#

Revision Date

2

Jan 24, 2012

MEZZANINE FLOOR FRAMING PLAN- AREA-C

U of L Project Number:

Omni - 1105.00

Project Number:

Cannon - 03667.00

Date:

March 02, 2012

Drawn By:


VPP

Checked By:

ANTHONY



S0123



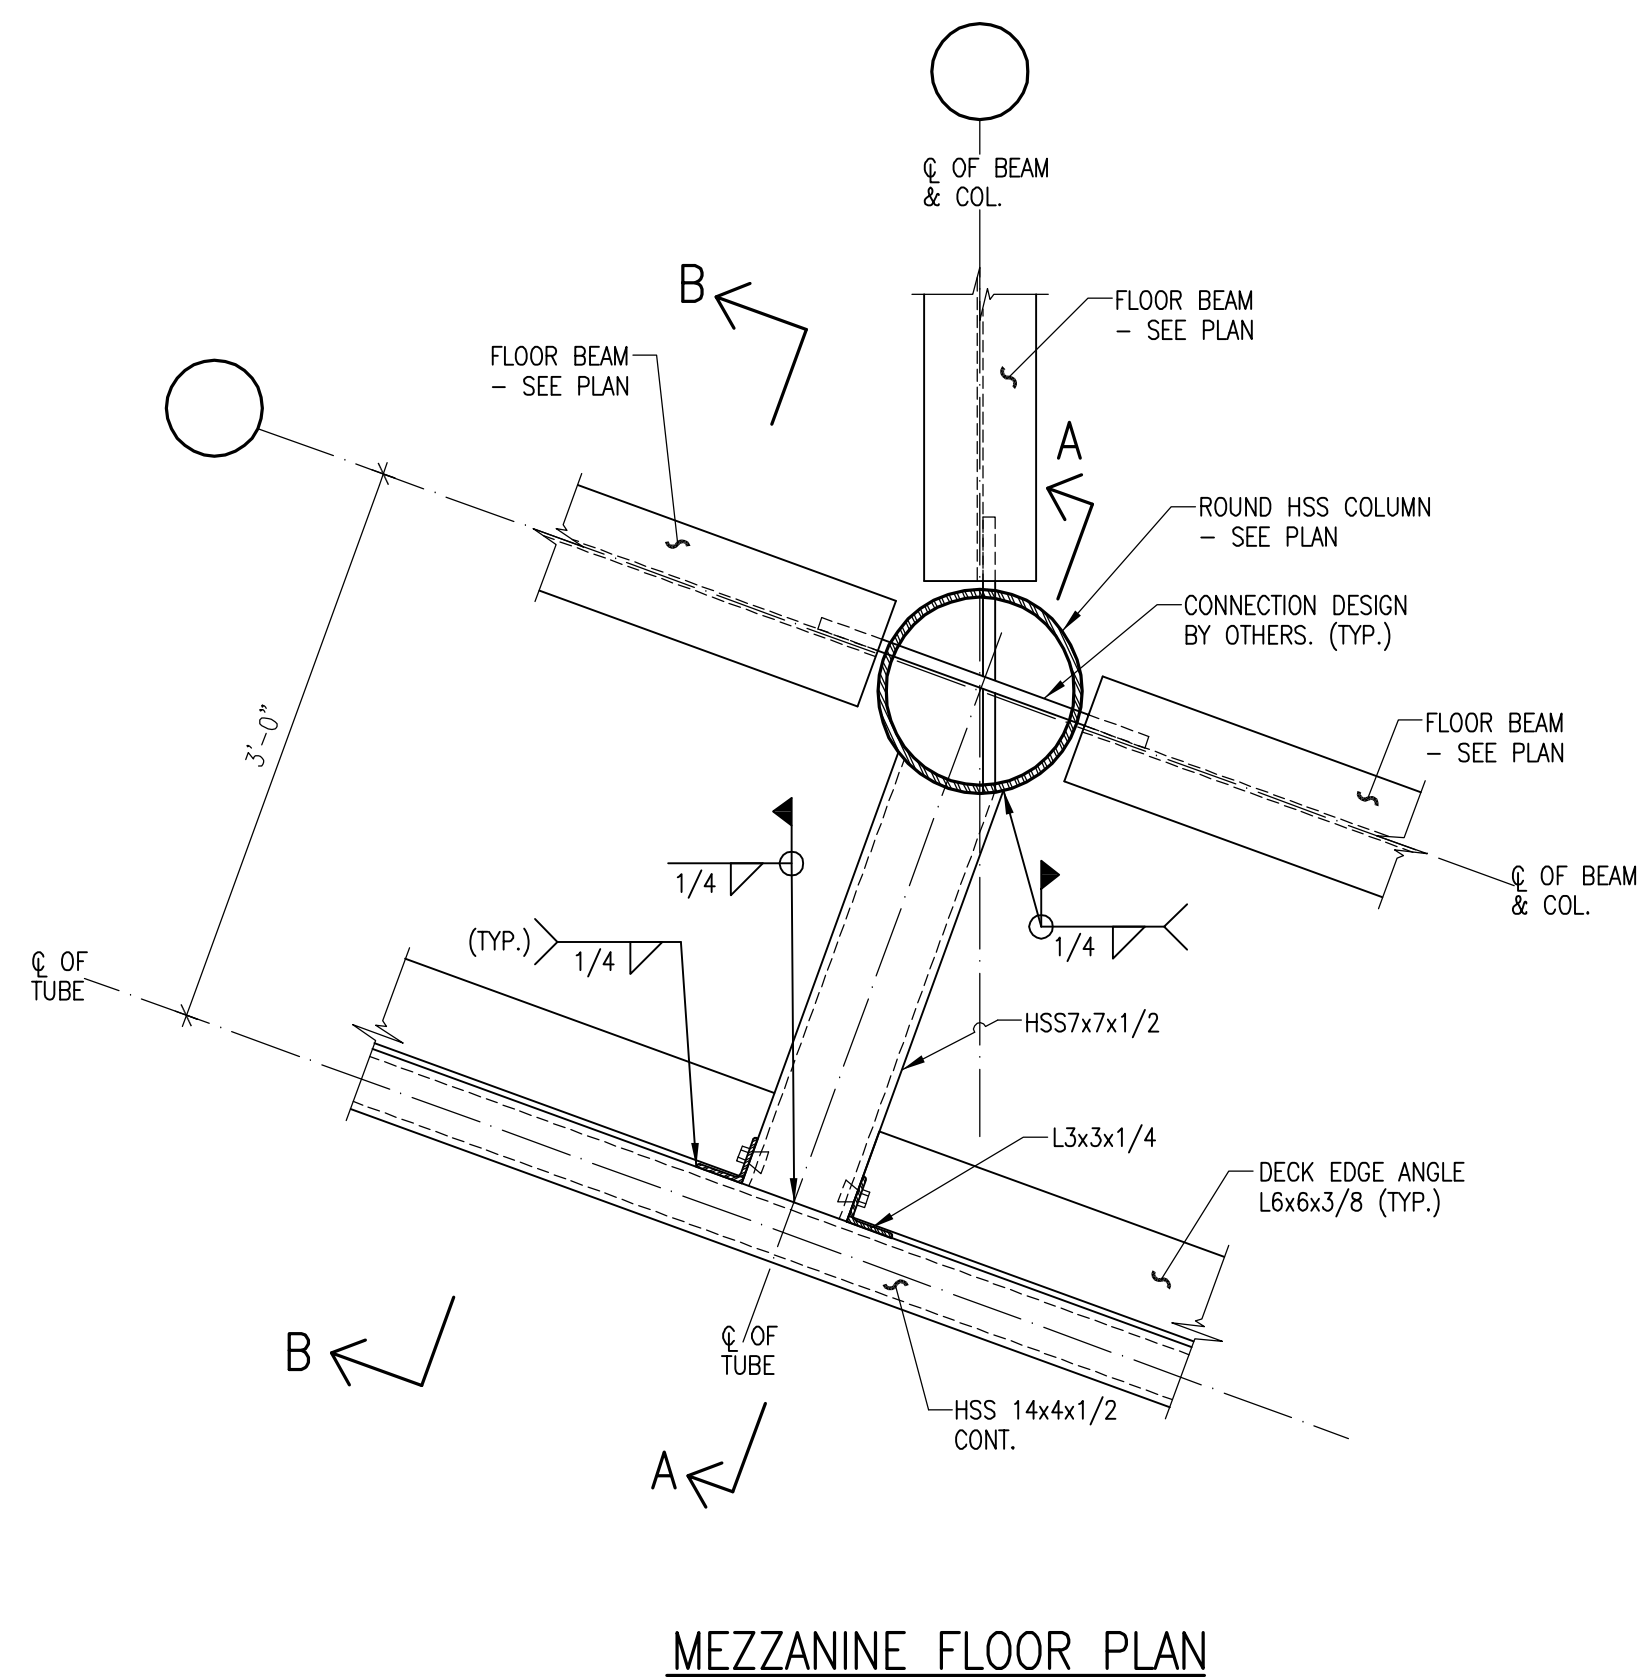


- NOTES:
- DECK NOT SHOWN FOR CLARITY. DECK SUPPORT AT COL. LOCATIONS REFER TYP. DETAIL 10/S0202
  - MOMENT CONNECTIONS ARE INDICATED ON PLAN THUS: —●—
  - MOMENT CONNECTION DETAIL BY OTHERS.

DETAIL  
SCALE: 1"=1'-0"


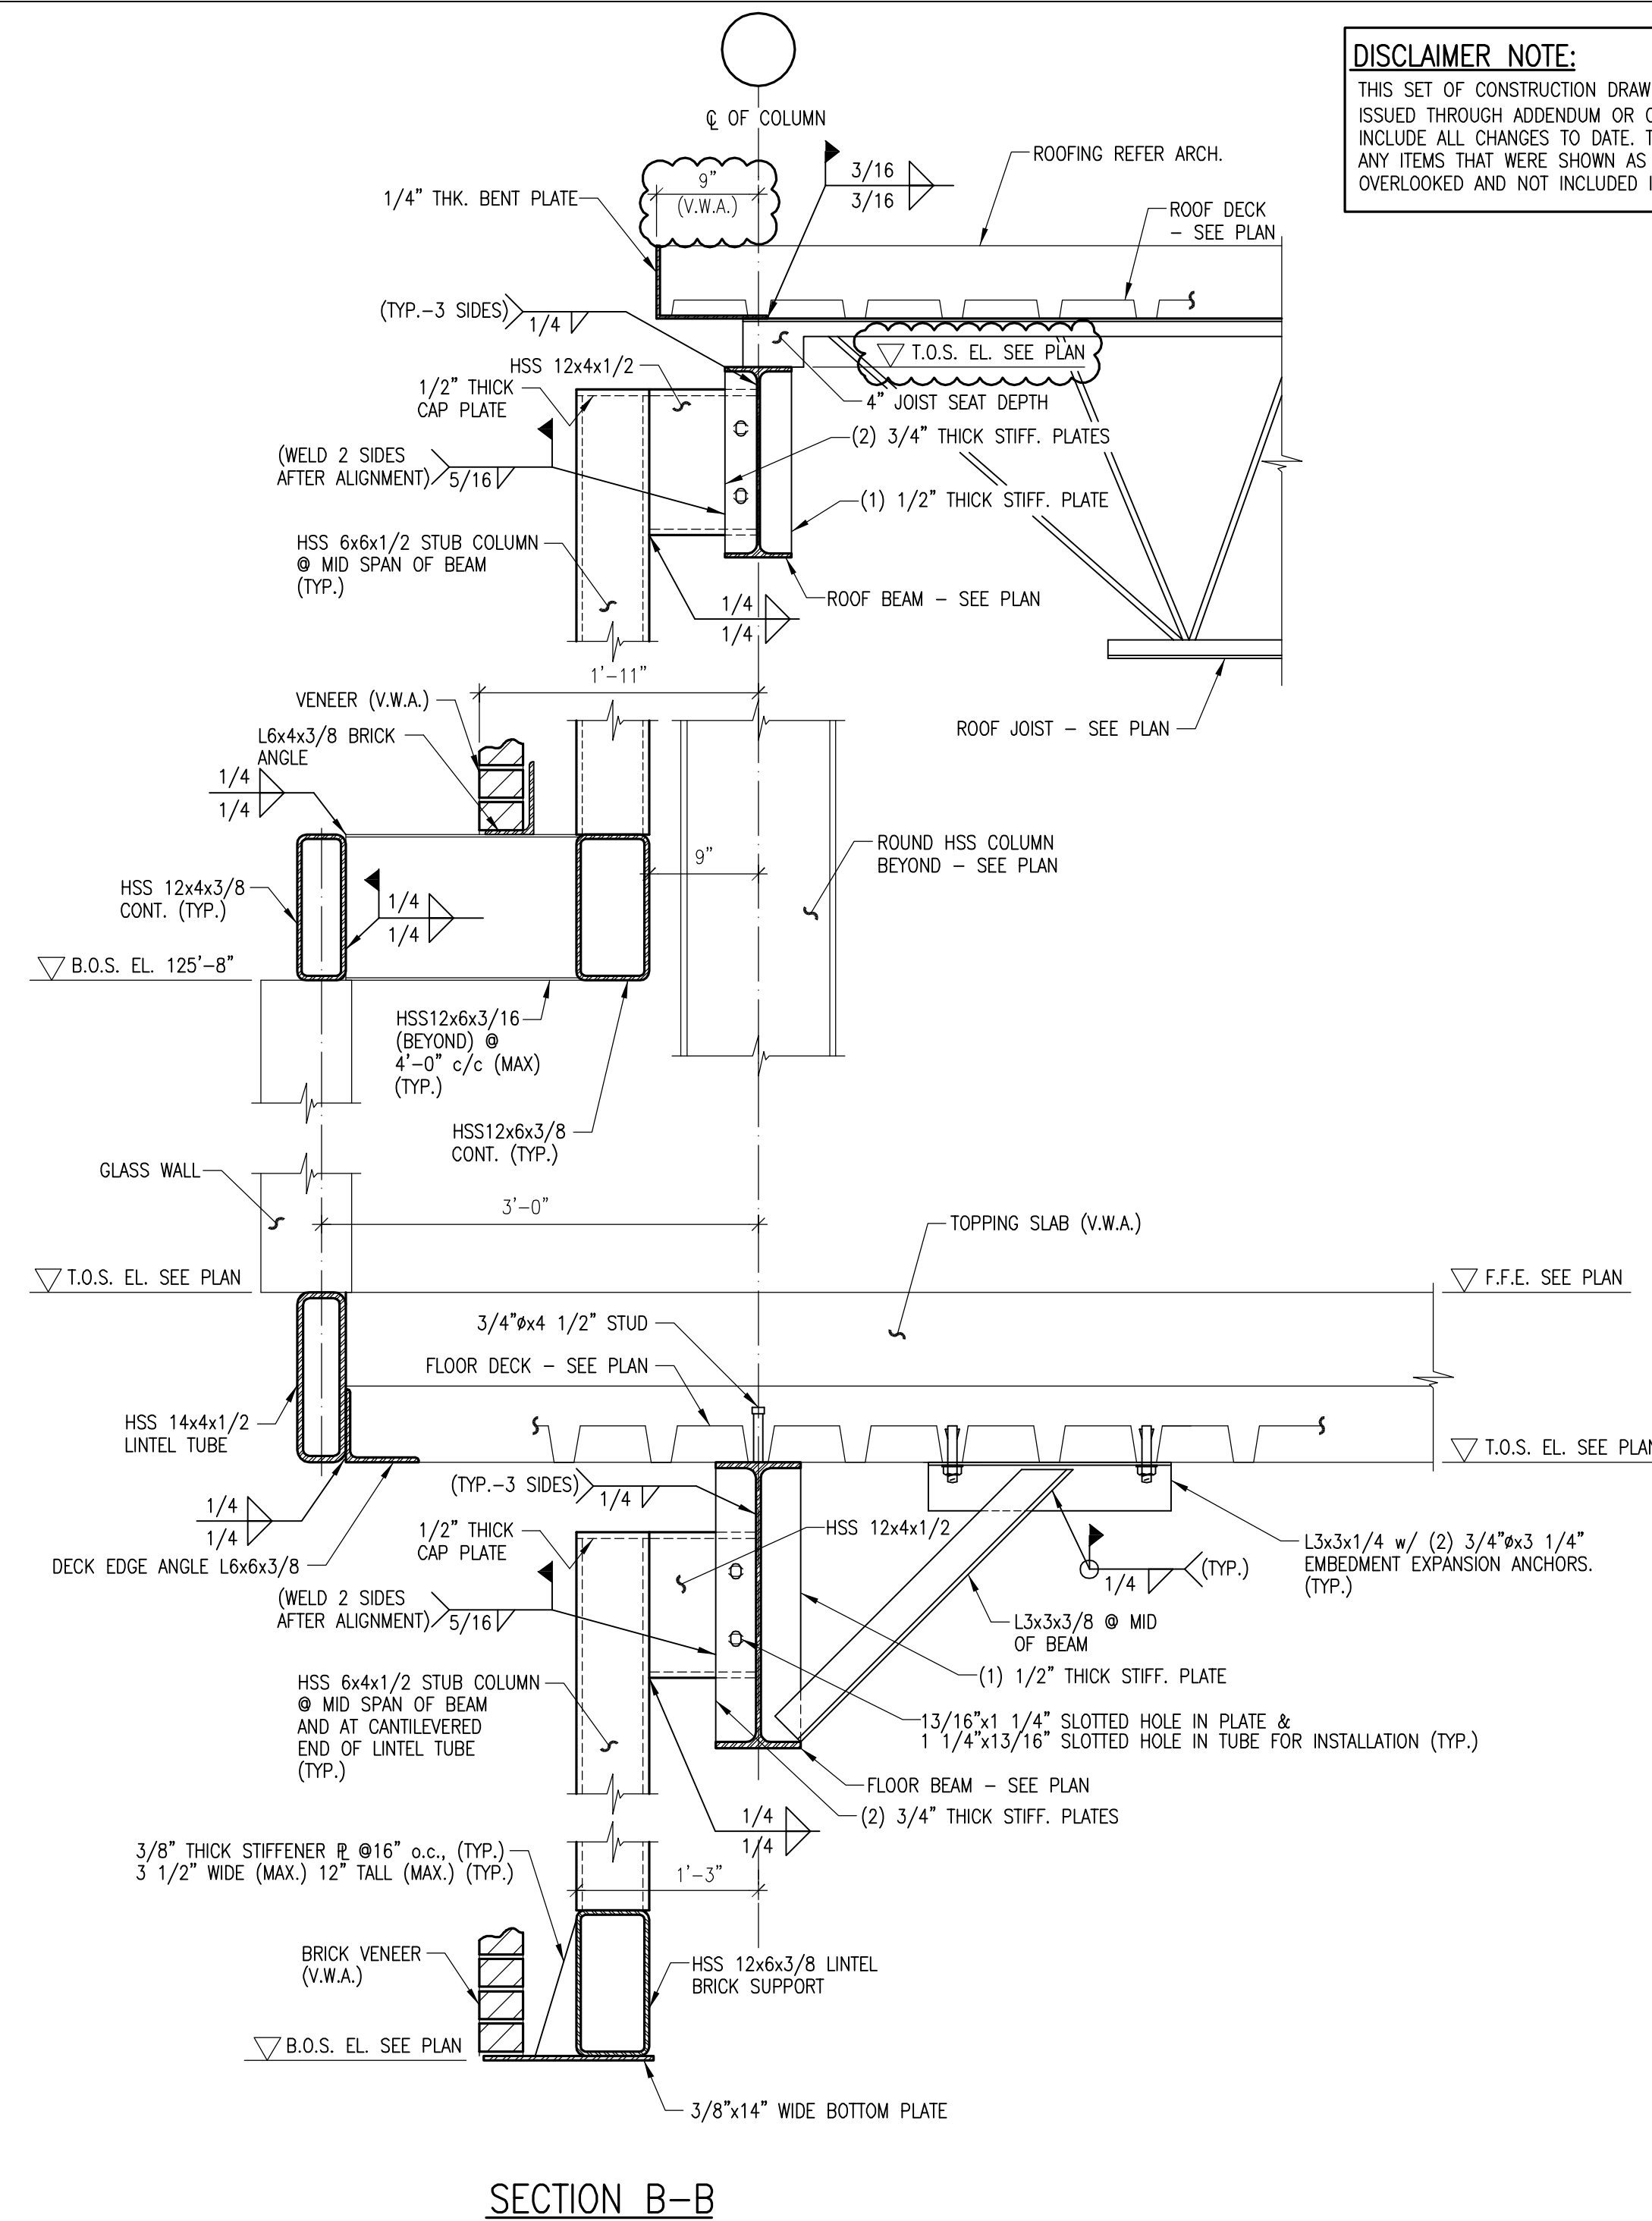
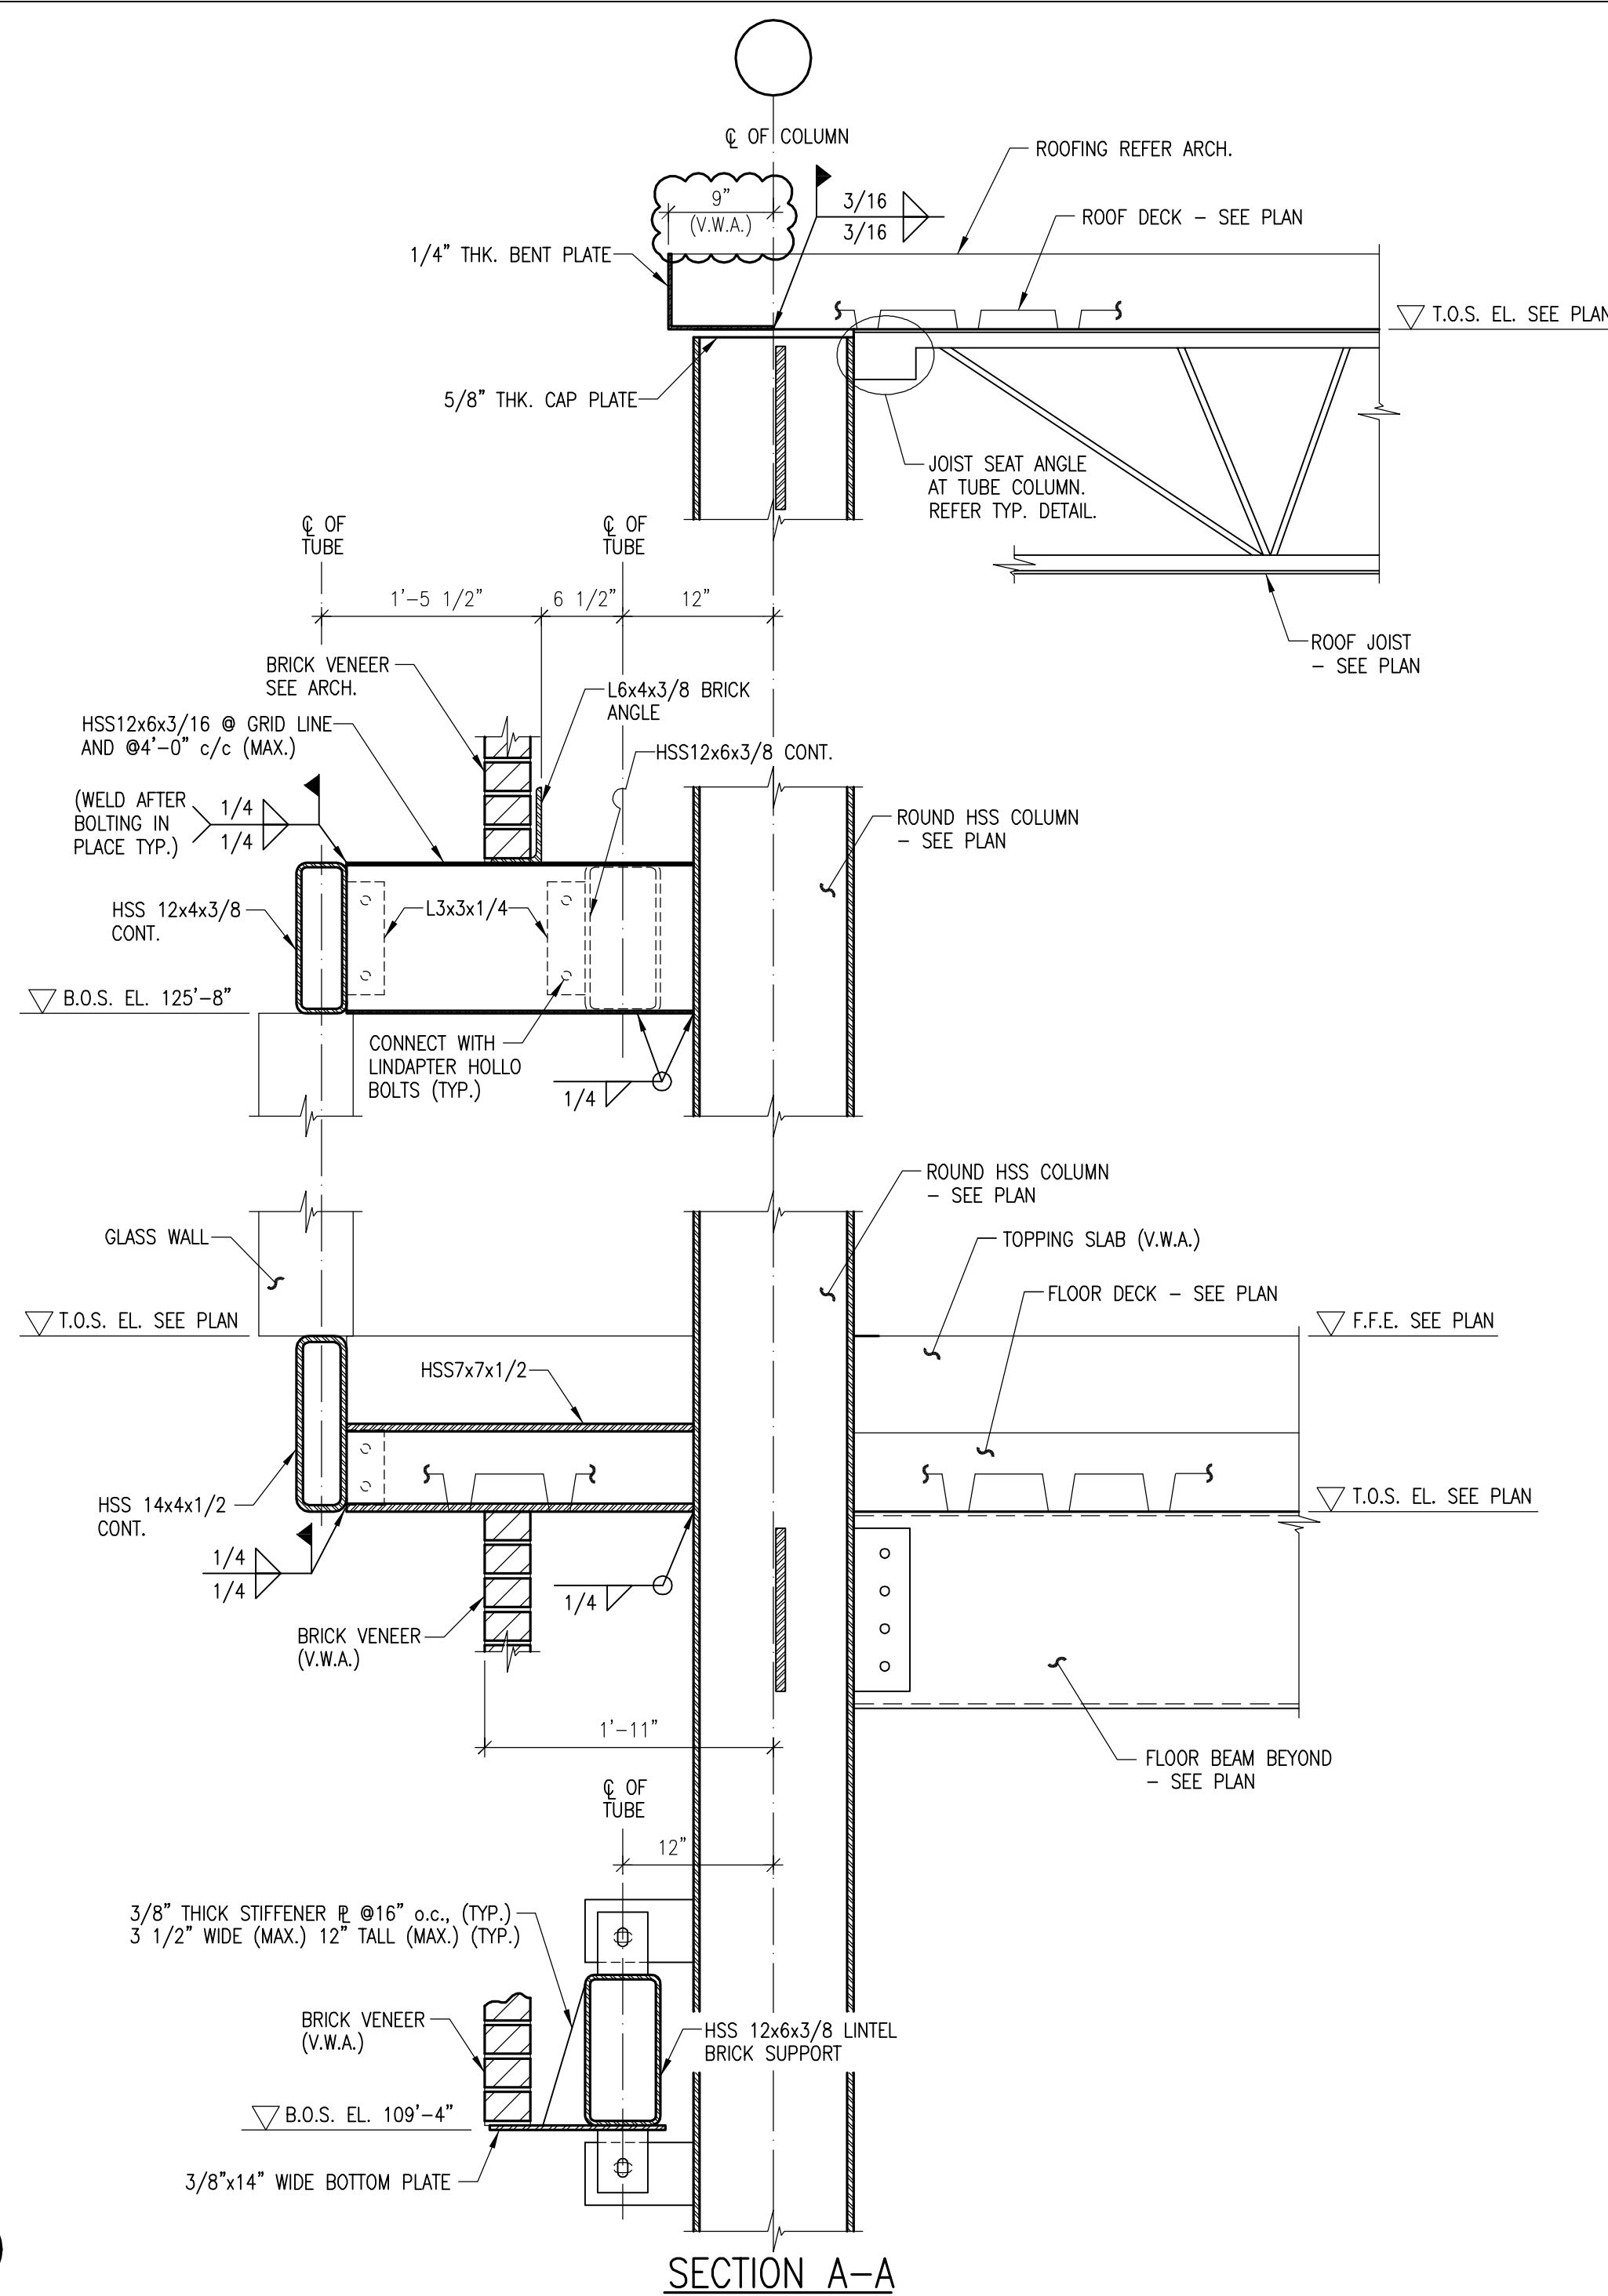


DISCLAIMER NOTE:  
THIS SET OF CONSTRUCTION DRAWINGS HAS BEEN UPDATED TO INCLUDE ANY CHANGES ISSUED THROUGH ADDENDUM OR OTHER MEANS. EVERY EFFORT HAS BEEN TAKEN TO INCLUDE ALL CHANGES TO DATE. THE CONTRACTOR IS STILL RESPONSIBLE FOR PROVIDING ANY ITEMS THAT WERE SHOWN AS PART OF THE ORIGINAL BID SET THAT MAY HAVE BEEN OVERLOOKED AND NOT INCLUDED IN THIS SET.

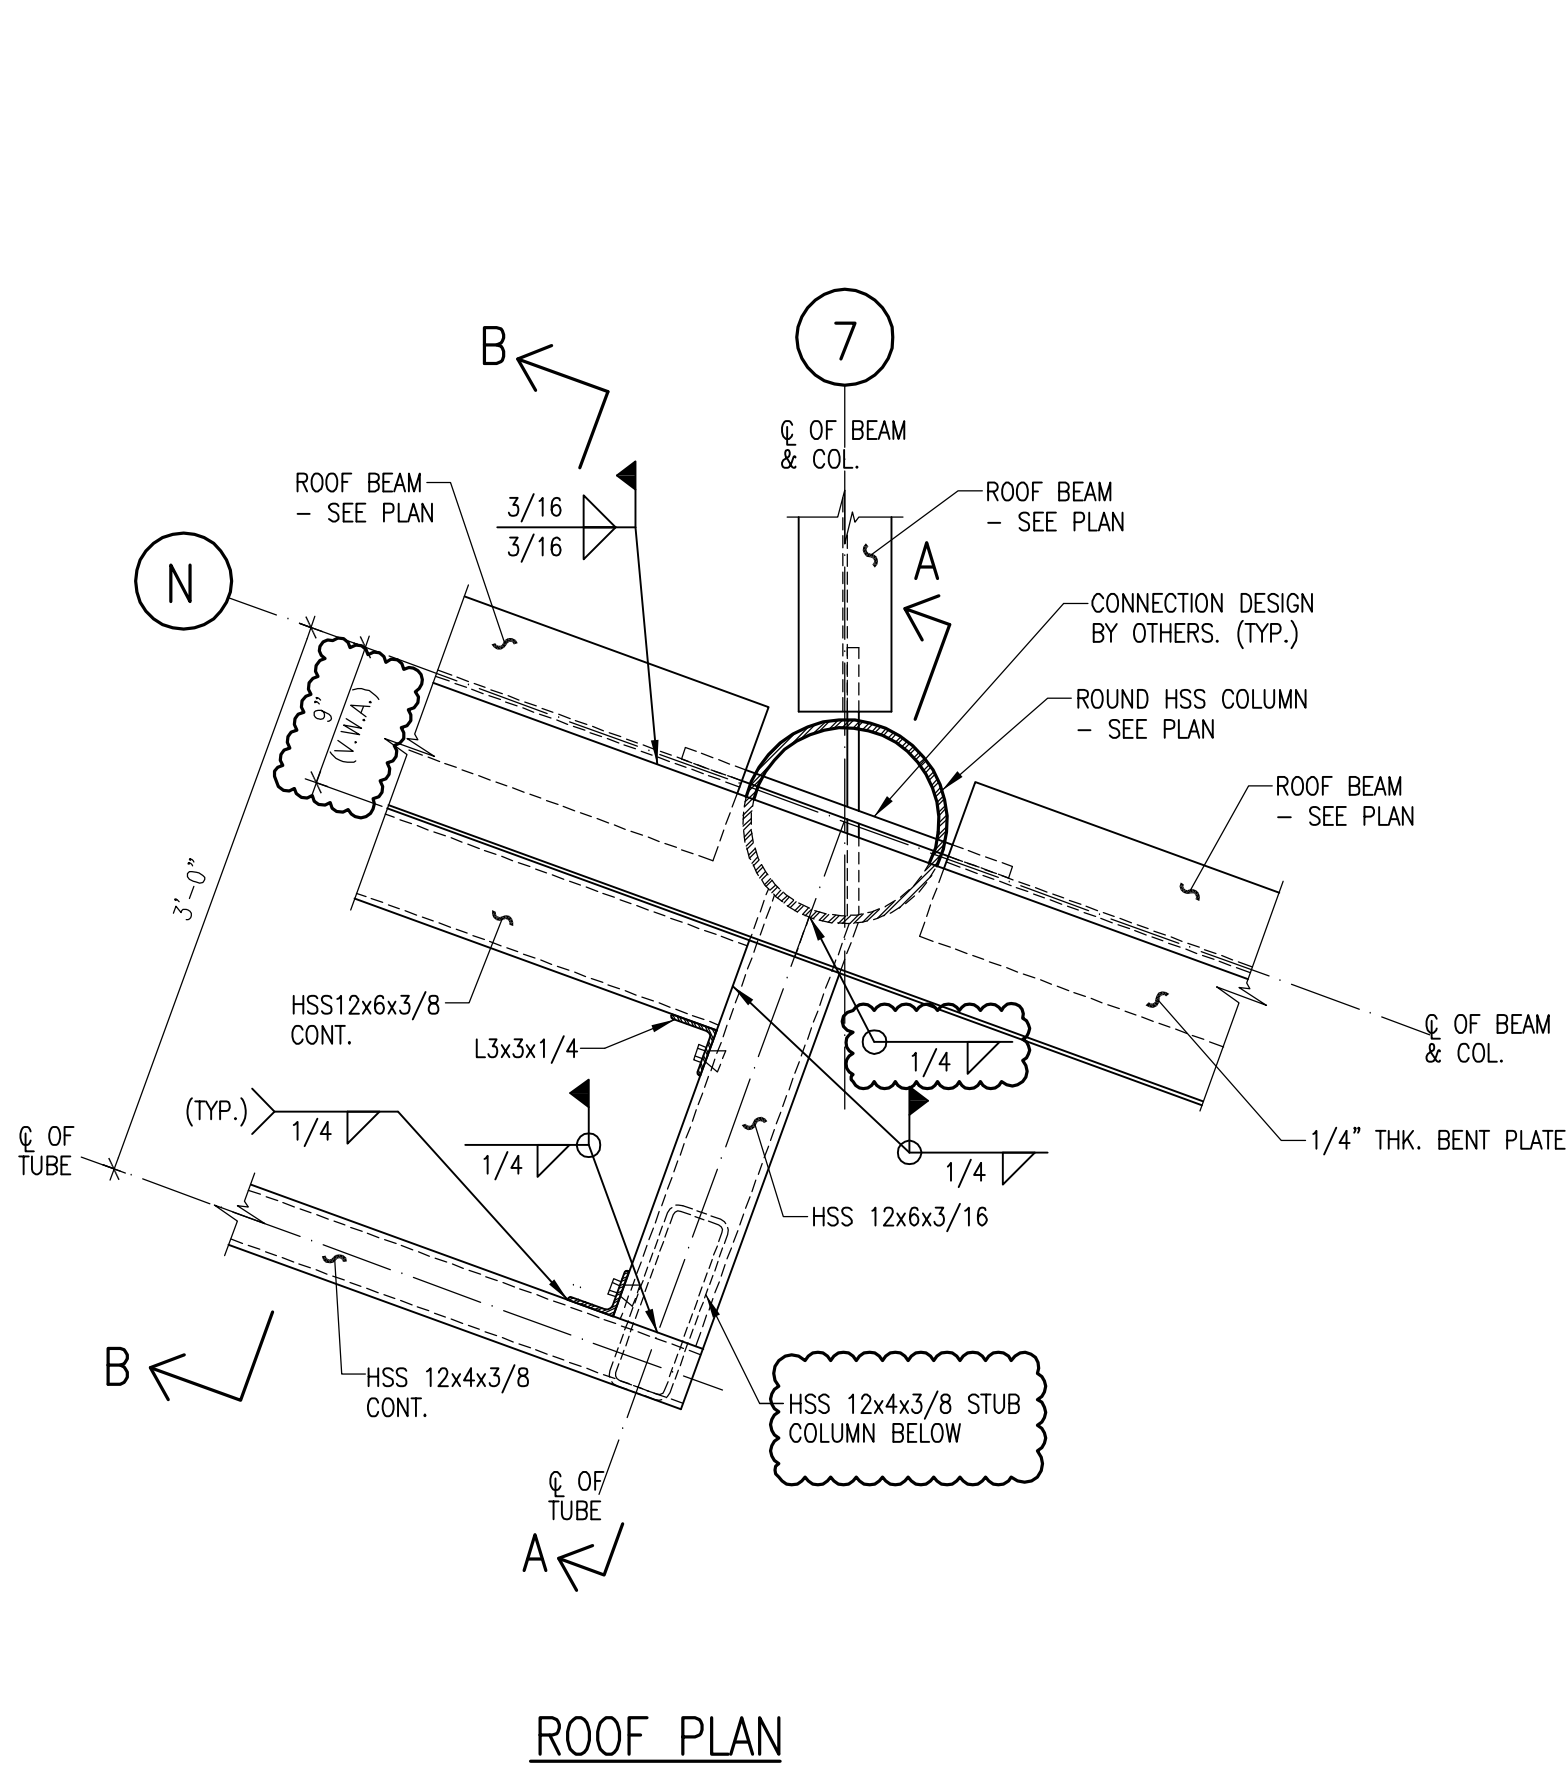

- NOTES:
- DECK NOT SHOWN FOR CLARITY. DECK SUPPORT AT COL. LOCATIONS REFER TYP. DETAIL 10/S0202
  - MOMENT CONNECTIONS ARE INDICATED ON PLAN THUS: —●—
  - MOMENT CONNECTION DETAIL BY OTHERS.

DETAIL  
SCALE: 1"=1'-0"

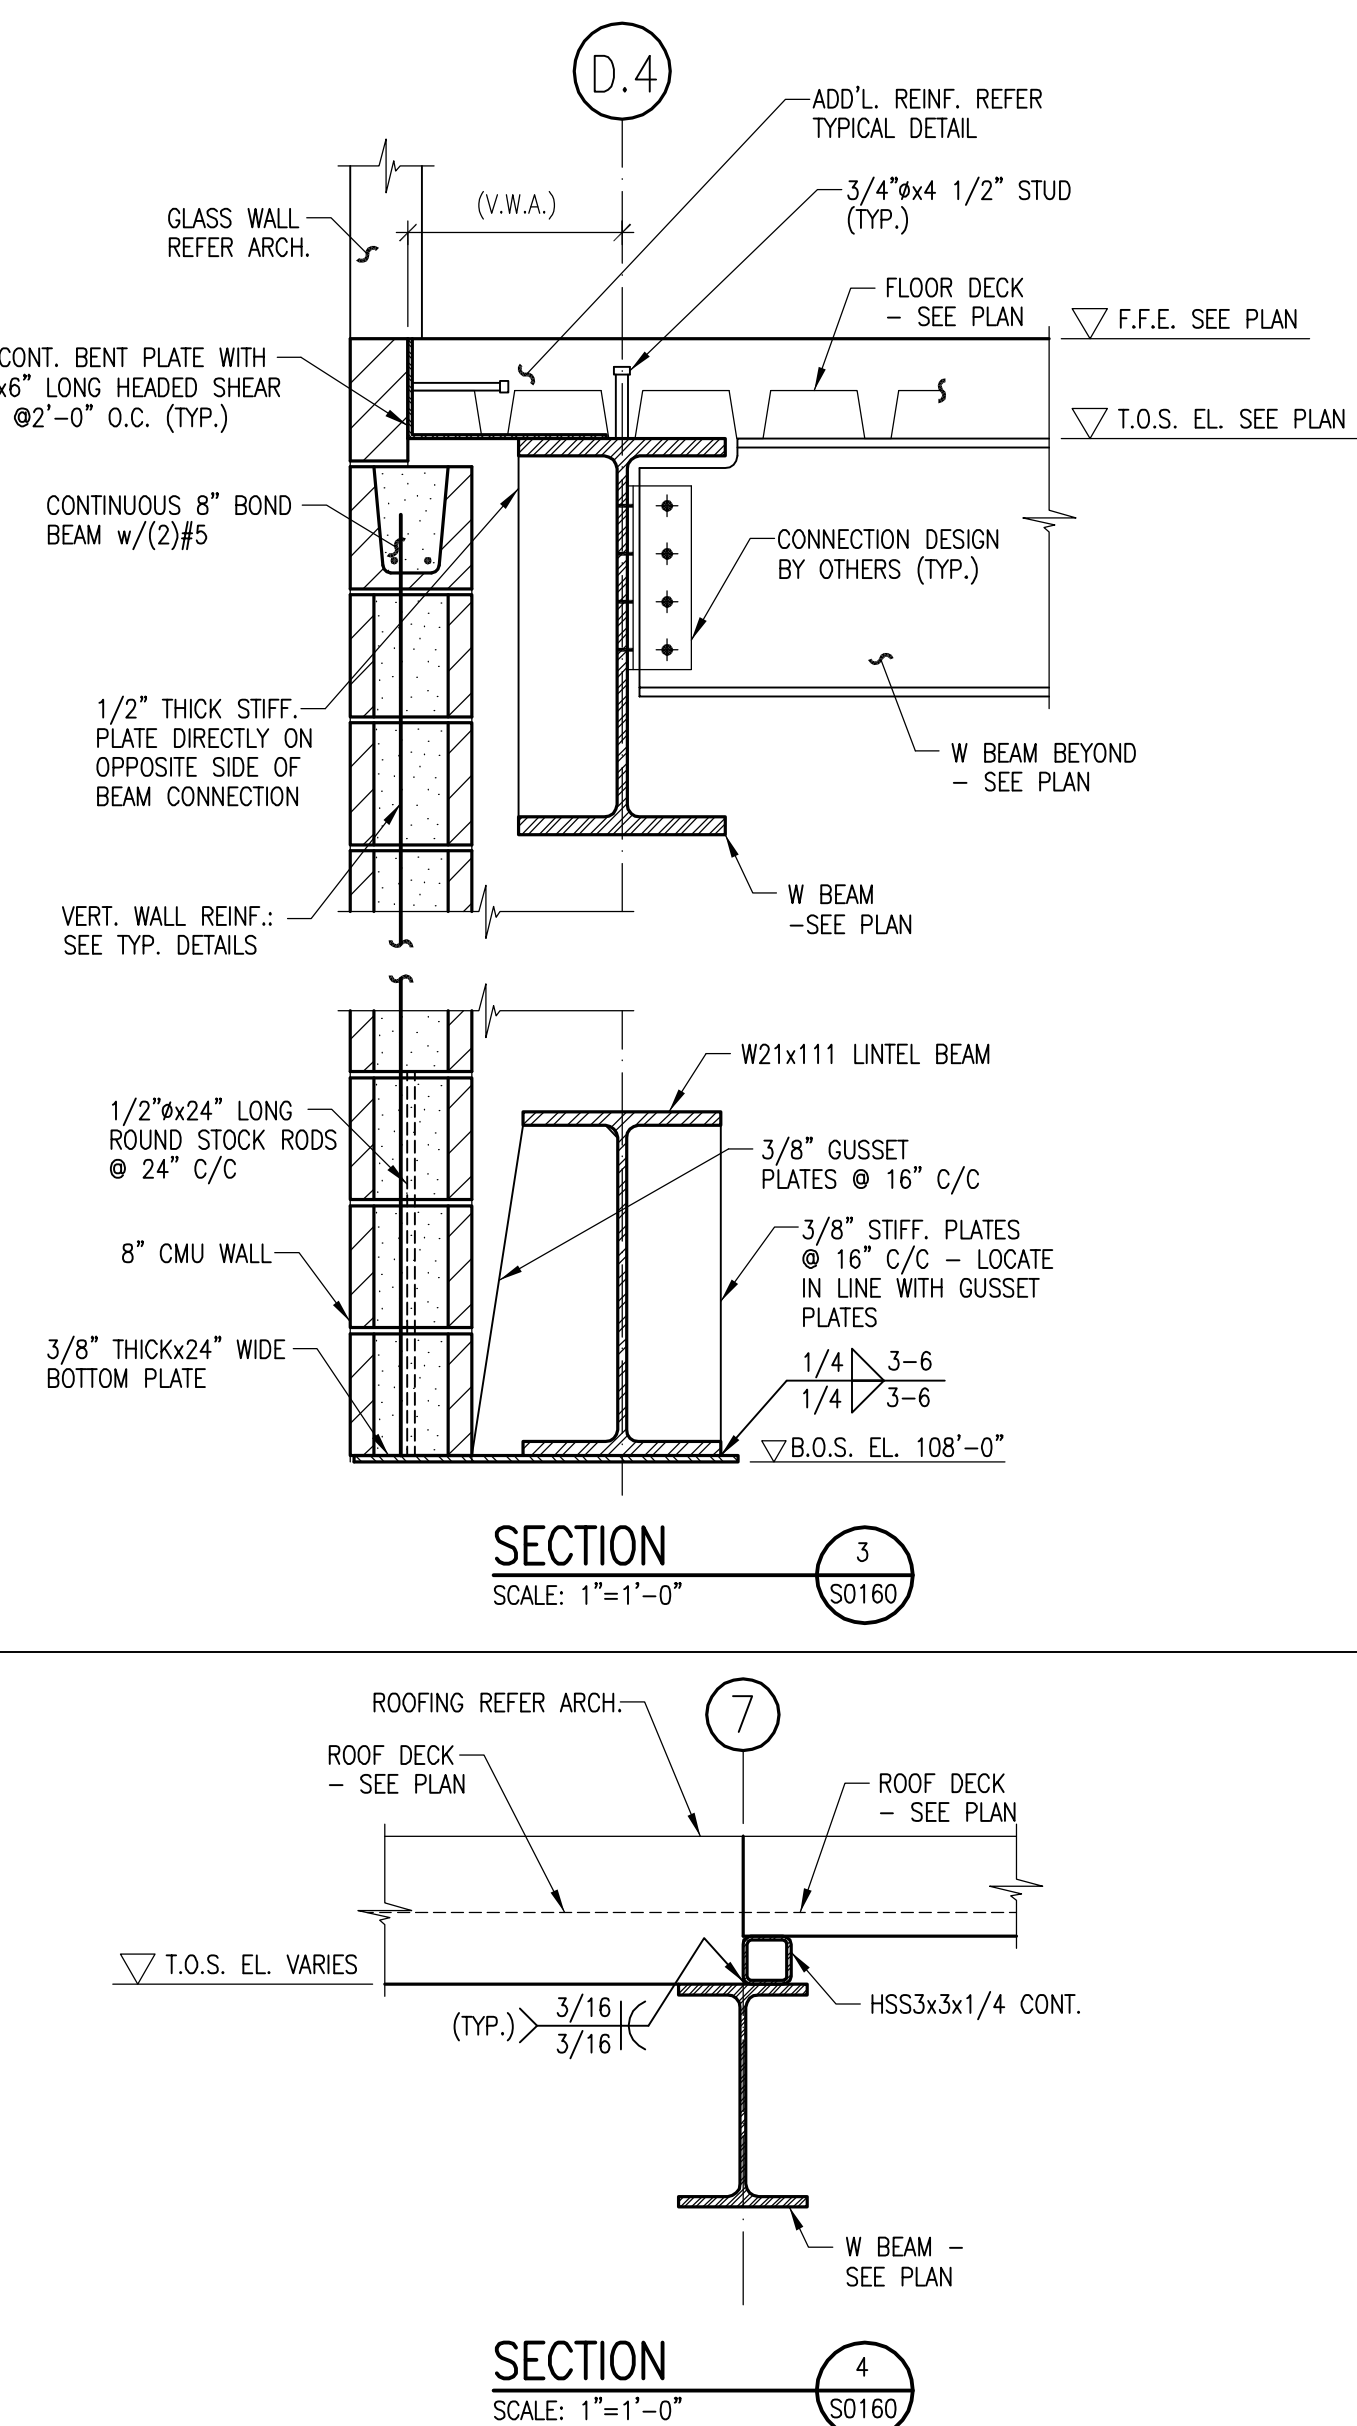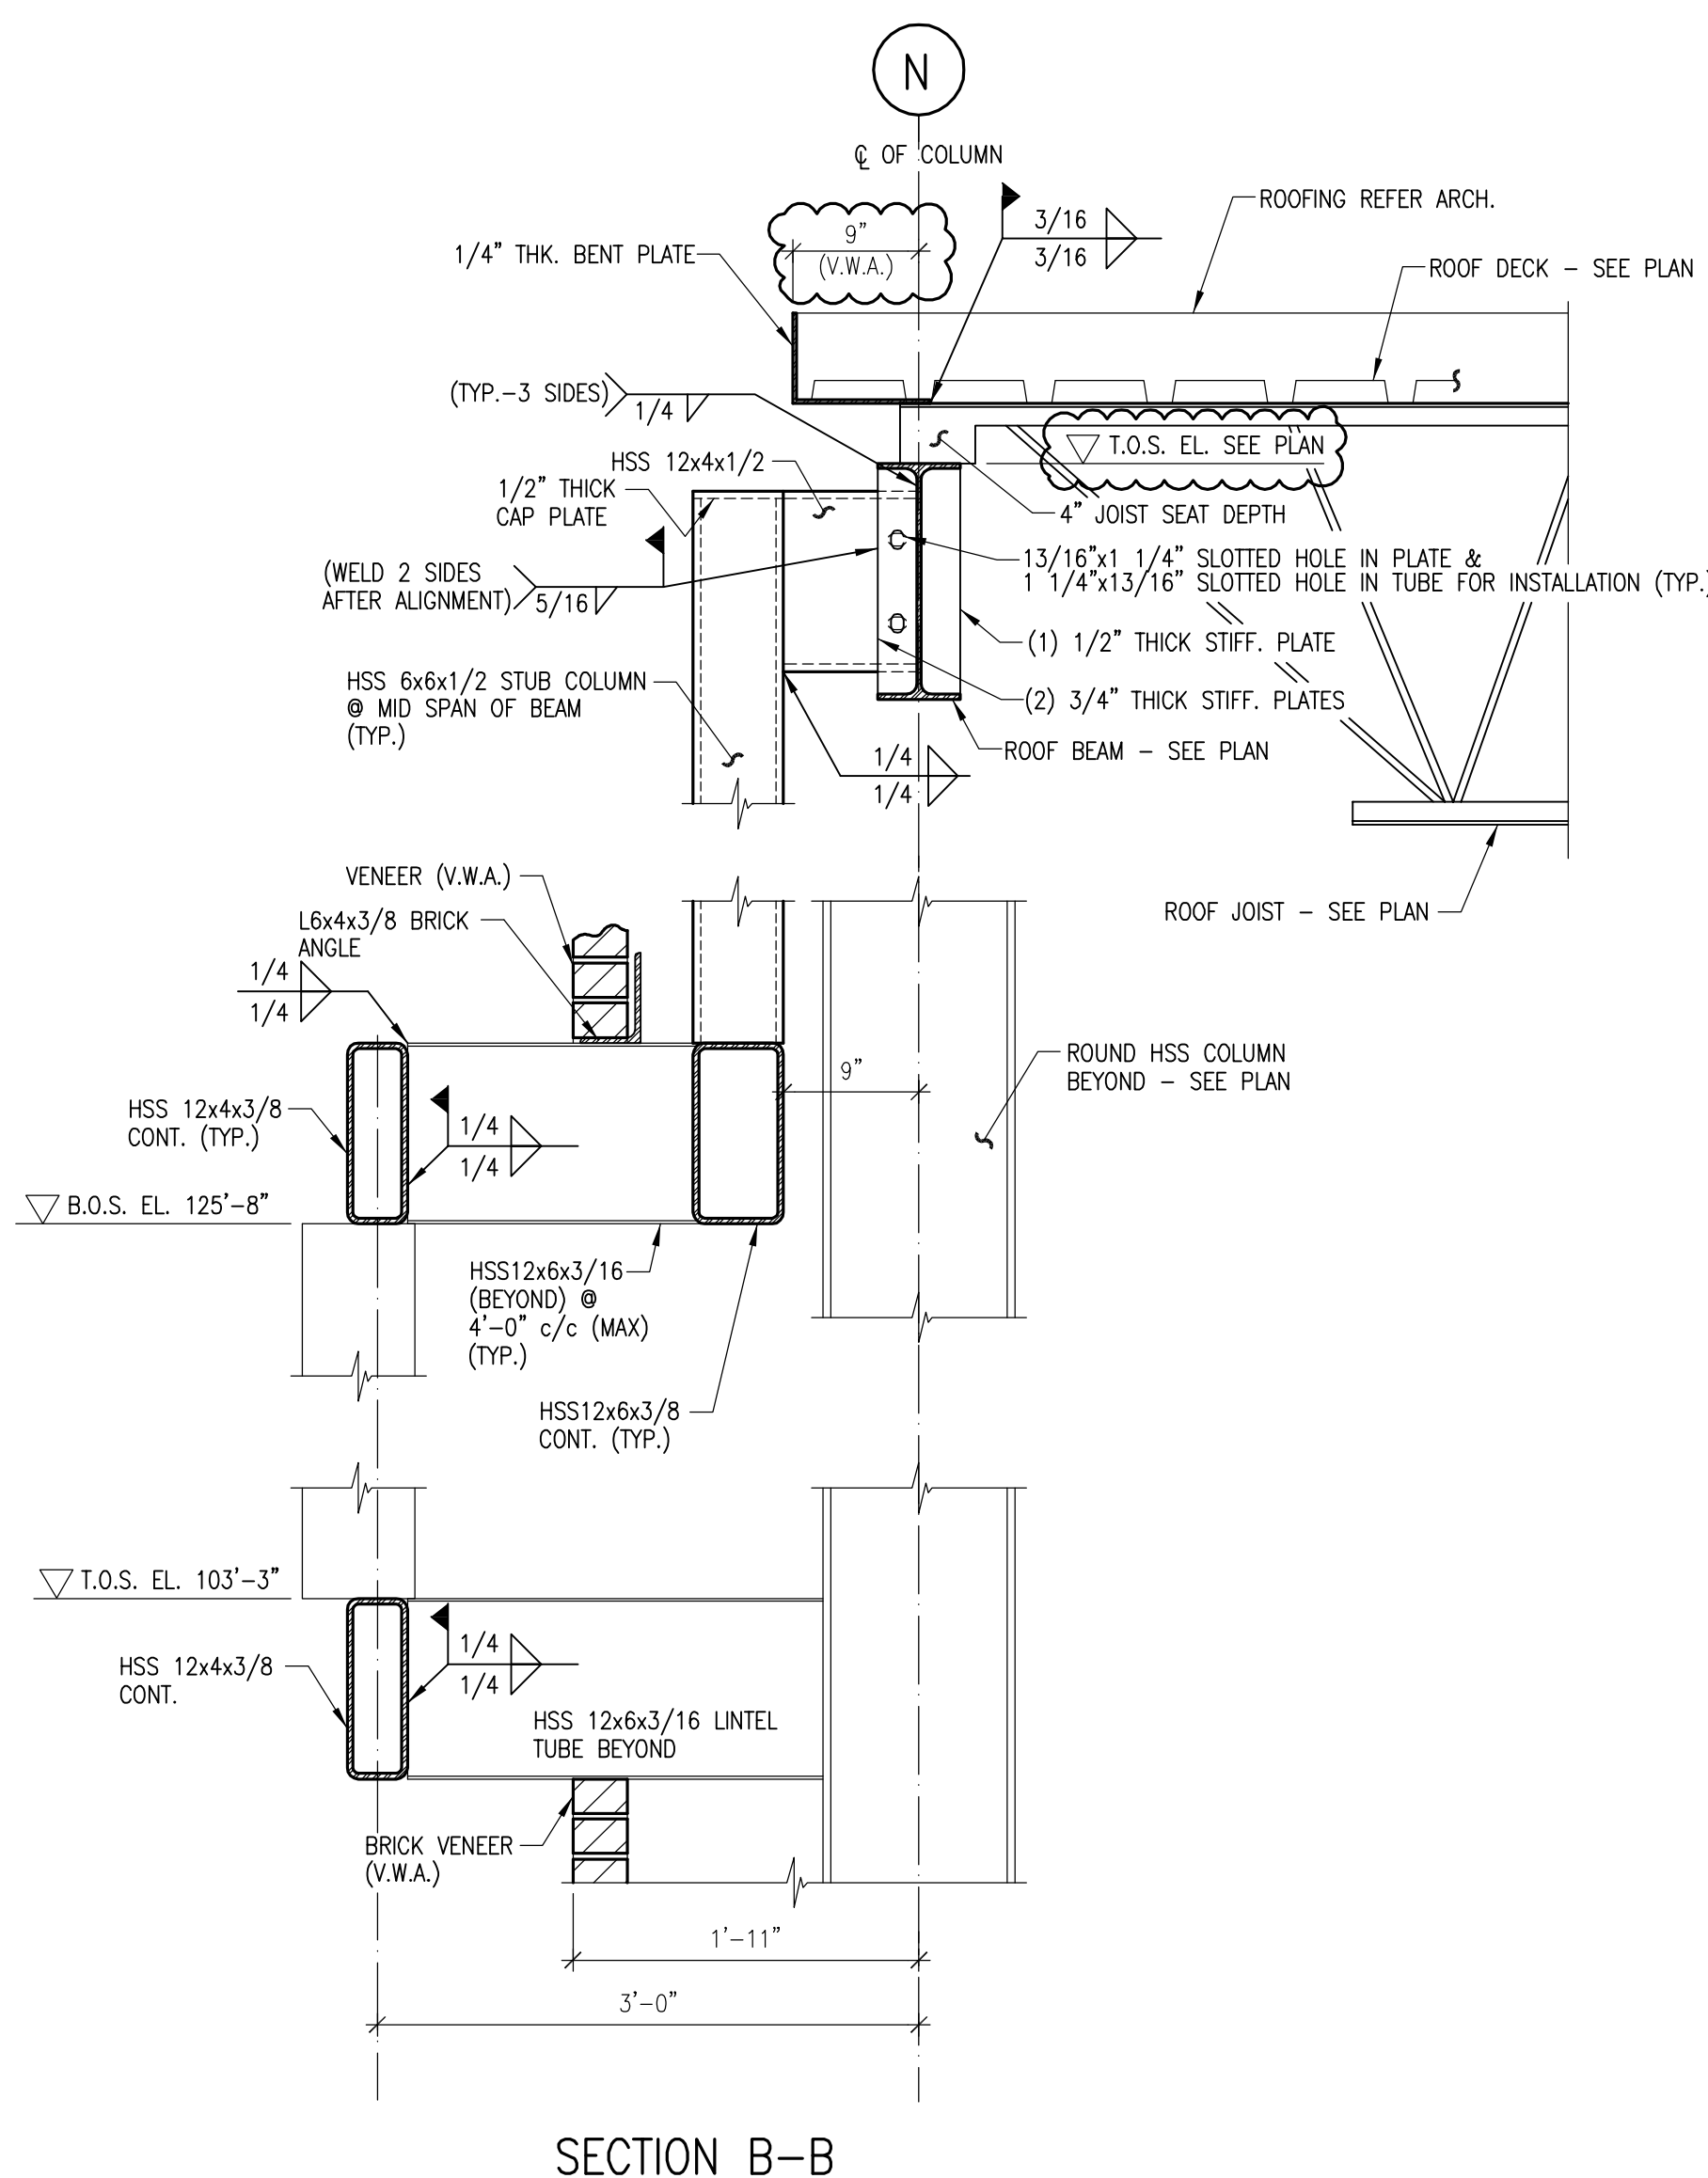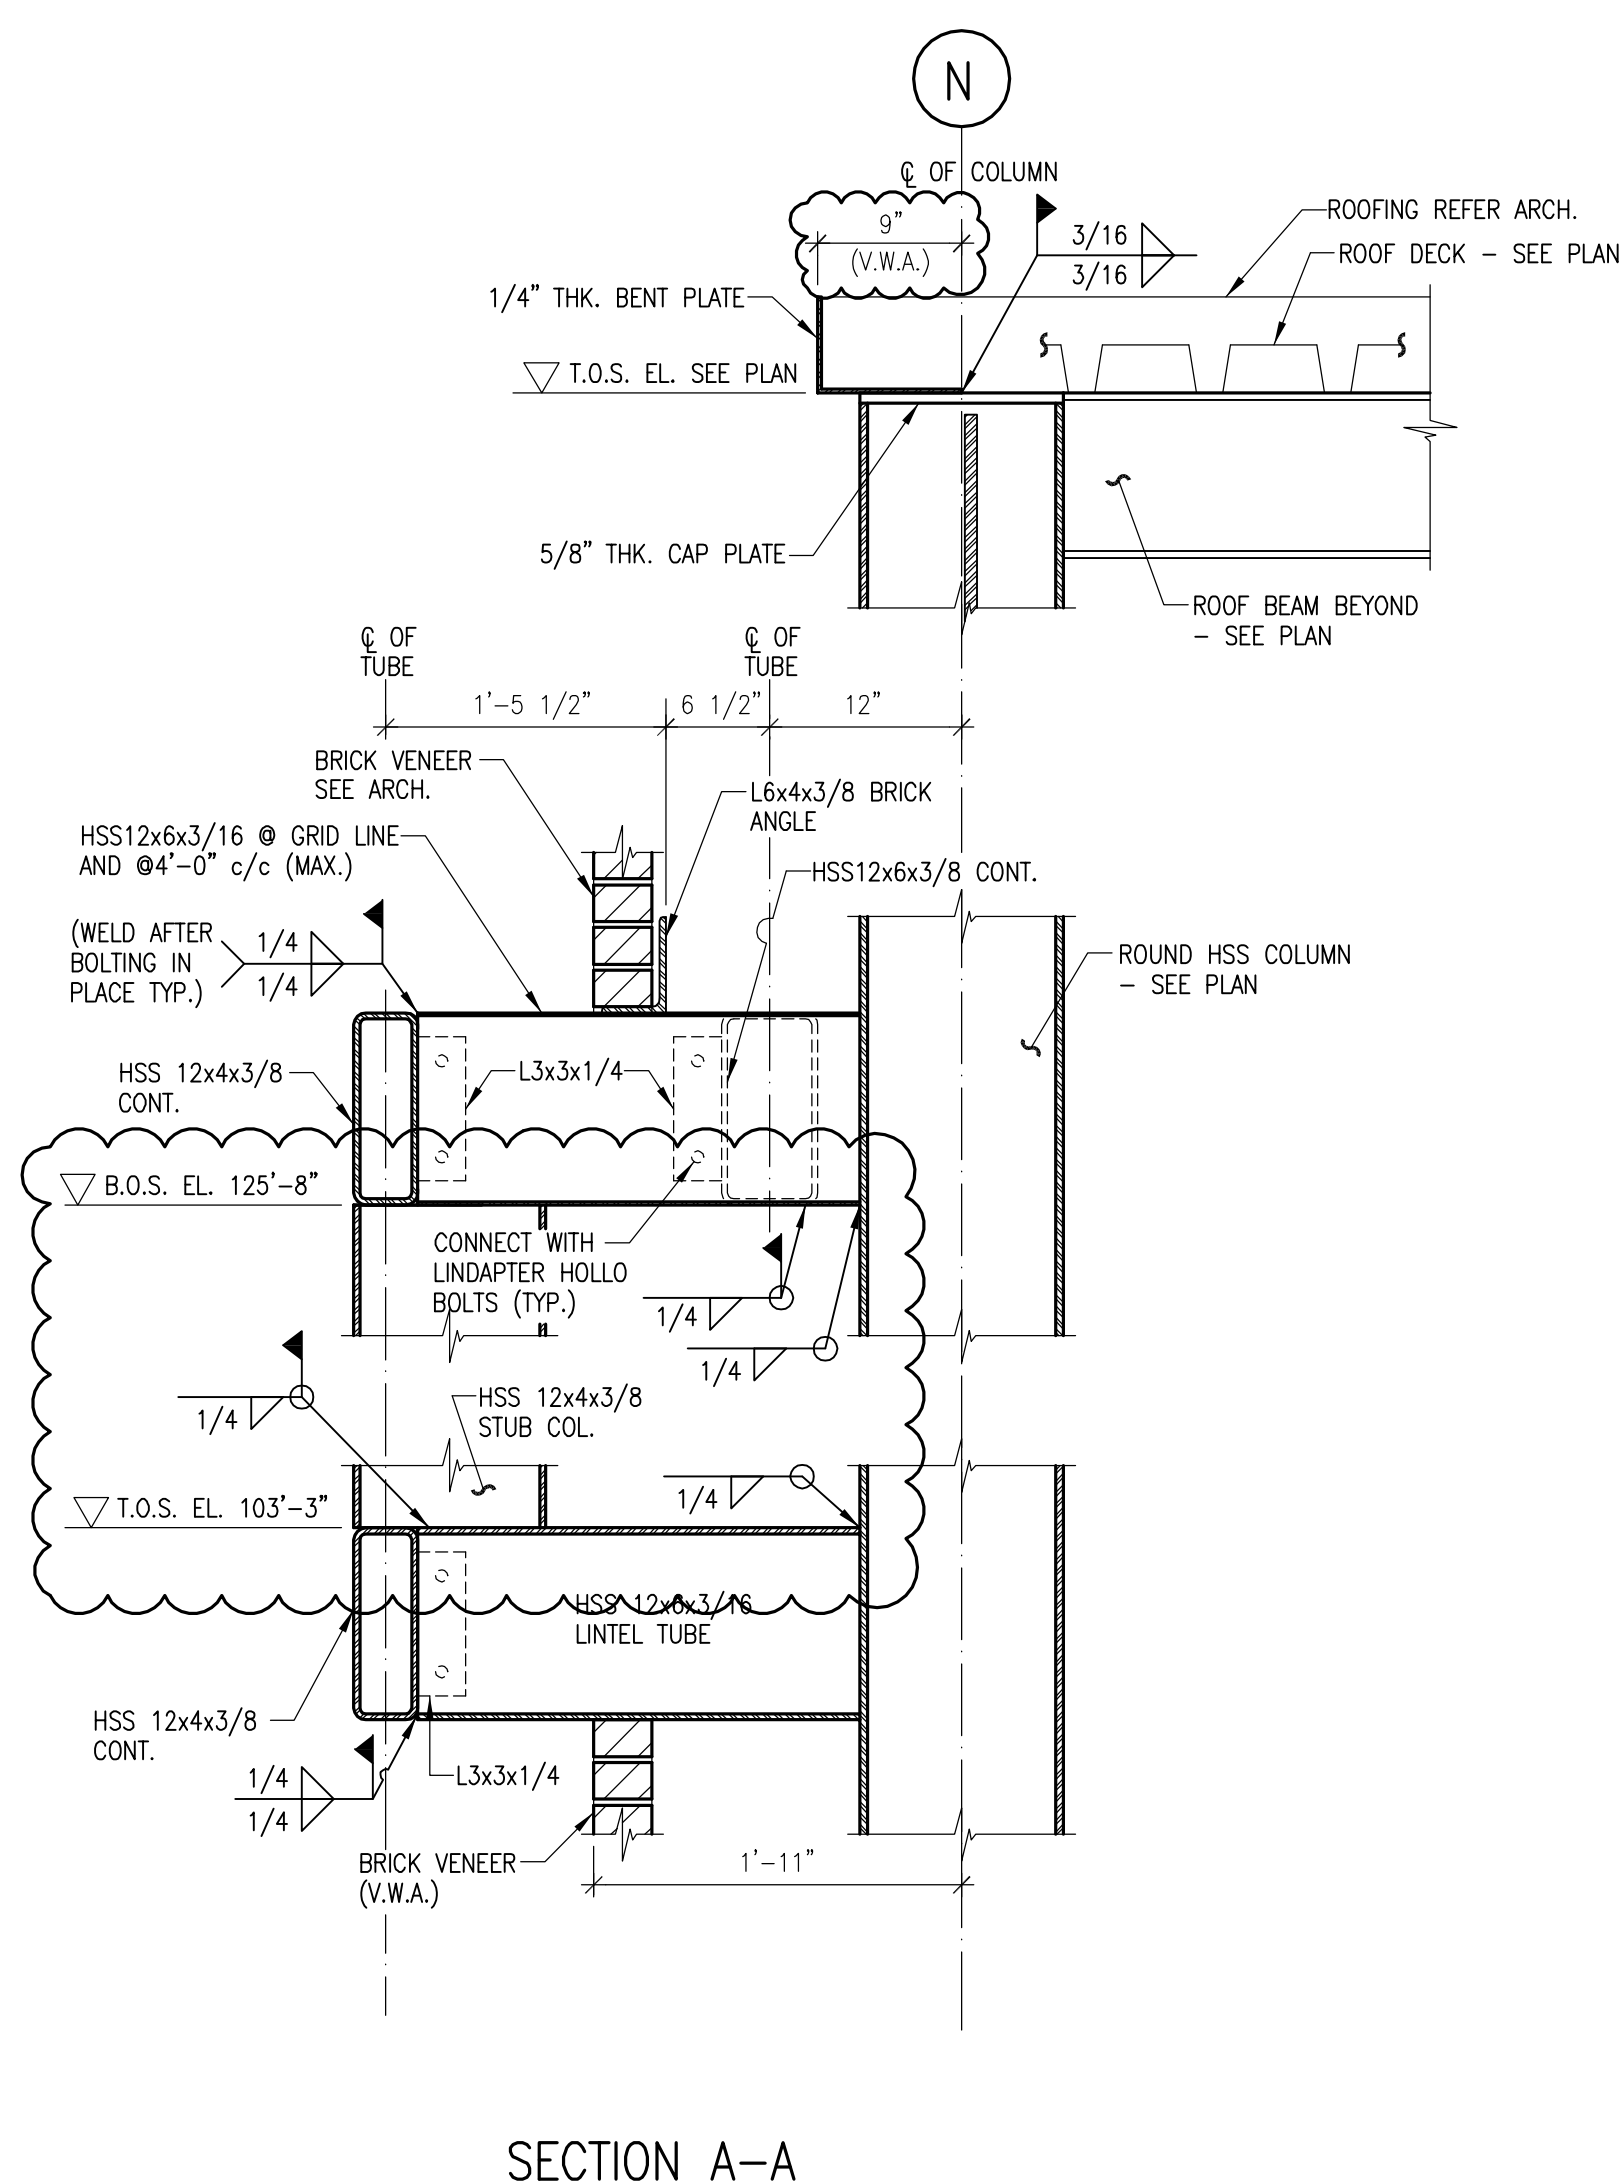

SECTIONS AND DETAILS		Revision Date	
Drawing Name:	#		
U of L Project Number:			
Project Number:			
Date:			
Drawn By:			
Checked By:			


U of L Project Number: 03667.00  
Project Number: 1105.00  
Date: March 02, 2012  
Checked By: ANTHONY

**Omni** ARCHITECTS  
212 North Upper Street  
Lexington, Kentucky 40507-1001  
p 859.252.6664 f 859.253.2358  
www.omniarchitects.com

**CANNONDESIGN**

**RGA**  
CONSULTING ENGINEERS  
Suite 402, The Landmark Building  
1000 S. Third Street  
Louisville, KY 40202  
phone: (502) 582-2212  
fax: (502) 582-2240  
www.rangaswamy.com

**RANGASWAMY AND ASSOC., INC.**

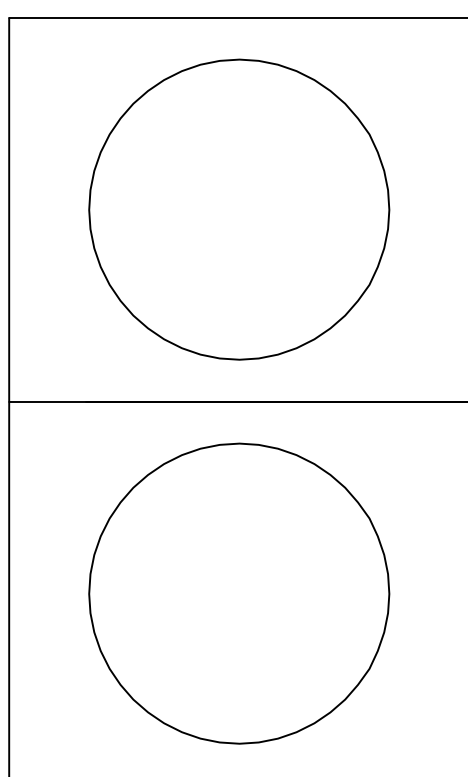

COLUMN SCHEDULE																										
MARK		C1	C2	C3	C4	C5	C6	C7	C8	C9	C10	C11	C12	C13	C14	C15	C16	C17	C18	C19	C20	C21	C22	C23	C24	C25
LEVEL																										
HIGH ROOF																										
EL. SEE PLAN																										
RACQUETBALL COURT ROOF																										
EL. SEE PLAN																										
LEVEL 02																										
EL. SEE PLAN		HSS12x12x5/8	HSS12x12x5/8	HSS12x12x1/2	HSS12x12x5/8	HSS16x12x5/8	HSS16x12x5/8	HSS12x12x5/8	HSS12x12x5/8	HSS12x12x1/2	HSS12x12x1/2	HSS10x10x5/8	WT2x53	WT2x58	WT2x72	WT2x79	WT2x106	WT4x99								
LOW ROOF																										
EL. SEE PLAN																			HSS12x12x1/2	HSS12x12x3/8	HSS12x12x5/8	HSS10x10x5/8	HSS10x10x1/2	HSS16x16x5/8	HSS16x16x5/8	HSS14x14x5/8
MEZZANINE																										
EL. SEE PLAN																										
LEVEL 01																										
EL. SEE PLAN																										
FITNESS TIER 1																										
EL. SEE PLAN																										
FITNESS TIER 2																										
EL. SEE PLAN																										
BASE PLATE	SIZE AxBxT	(19"x19"x2.25")	(19"x19"x1.75")	(19"x19"x1.75")	(19"x19"x1.75")	(19"x23"x2.25")	(19"x23"x2.25")	(19"x19"x1.75")	(19"x19"x1.75")	(19"x19"x1.75")	(19"x19"x1.75")	(17"x17"x1.75")	(17"x19"x1.75")	(17"x20"x1.75")	(19"x20"x1.75")	(19"x20"x1.75")	(20"x20"x1.75")	(22"x22"x1.75")	(19"x19"x1.75")	(19"x19"x1.75")	(19"x19"x1.75")	(17"x17"x1.75")	(17"x17"x1.75")	(23"x23"x1.75")	(23"x23"x1.75")	(21"x21"x1.75")
	ANCHOR RODS	-	-	-	-	-	-	-	-	-	-	-	-	-	-	-	-	-	-	-	-	-	-	-	-	-
REMARKS	SEE NOTE 6	SEE NOTE 6	SEE NOTE 6	SEE NOTE 6	SEE NOTE 6	SEE NOTE 6	SEE NOTE 6	SEE NOTE 6	SEE NOTE 6	SEE NOTE 6	SEE NOTE 6	SEE NOTE 6	SEE NOTE 7	SEE NOTE 7	SEE NOTE 7	SEE NOTE 7	SEE NOTE 7	SEE NOTE 7	SEE NOTE 6	SEE NOTE 6	SEE NOTE 6	SEE NOTE 6	SEE NOTE 6	SEE NOTE 6	SEE NOTE 6	SEE NOTE 6
COLUMN LOCATIONS	13/A 15/A 13/E 14/E 15/E	14/A 16/A 17/A 18/A 19/A 20/A 21/A	11/E 12/E 16/E 17/E 18/E 19/E 20/E 21/E	22/A 22/E	23/A 23/B,9 23/D,1 23/E	12/C	12/D	8/E 9/E 10/E 11/F	12,2/F 13,2/F	8/F 9/F 10/F	14,3/F 15,2/F	7/F	7/D,4 7/E	7/D	9,1/D 10/D 11/B	8/D	11/C 11/D	11/A	1,5/B 2/D,4 6/D,4	2/B 3/B 4/B 5/B 6/B	3/D,4 5/D,4	1/E 1/F 7/G 5/H	0,5/D,8 2,4/E 3,6/E 5/F 5/G 7/H	8/K 9/K 10/K 11/K 12,2/K	13,2/K 14,3/K 15,2/J 15,2/H 15,2/G	2,4/N


COLUMN SCHEDULE													
MARK LEVEL	C26	C27	C28	C29	C30	C31	C32	C33	C34	C35	C36	C37	C38
HIGH ROOF EL. SEE PLAN													HSS8x8x3/8
RACQUETBALL COURT ROOF EL. SEE PLAN													
LEVEL 02 EL. SEE PLAN													
LOW ROOF EL. SEE PLAN	HSS12.75x10x.500	HSS12.75x10x.375	WT2x53	WT2x58	WT2x65	WT2x72	WT10x77	WT2x106					
MEZZANINE EL. SEE PLAN									WT2x58	WT2x72	WT2x79	WT2x87	
LEVEL 01 EL. SEE PLAN													
FITNESS TIER 1 EL. SEE PLAN													
FITNESS TIER 2 EL. SEE PLAN													
BASE PLATE	SIZE AxBxT	(20"x20"x1.75")	(20"x20"x1.75")	(17"x19"x1.75")	(17"x20"x1.75")	(19"x20"x1.75")	(19"x20"x1.75")	(18"x18"x1.75")	(20"x20"x2.25")	(17"x20"x1.75")	(19"x20"x1.75")	(20"x20"x1.75")	(15"x8"x0.75")
	ANCHOR RODS	-	-	-	-	-	-	-	-	-	-	-	-
REMARKS	SEE NOTE 6	SEE NOTE 6	SEE NOTE 7	SEE NOTE 7	SEE NOTE 7	SEE NOTE 7	SEE NOTE 7	SEE NOTE 7	SEE NOTE 7	SEE NOTE 7	SEE NOTE 7	SEE NOTE 7	SEE NOTE 6
COLUMN LOCATIONS	1/N 3,6/N 5/N	0,5/F 0,5/G 0,5/N 7/N 7/M 8,5/N 8,5/M	7/B 8/B 10/B	1/D,4 7/C 9/B	9,1/C 10,1/C	2,4/F 8/C	1/C,6	2,4/G	3,6/F	3,6/G	1/G	3,6/H	12/A

NOTES:

1. REFER STRUCTURAL STEEL GRADES FOR GENERAL PROVISION.
2. SEE PLAN AND DETAILS FOR COLUMN ORIENTATION.
3. SEE PLAN AND DETAILS FOR TOP ELEVATIONS OF COLUMN.
4. ALL COLUMNS SHALL BE CENTERED ON COLUMN REFERENCE LINES UNLESS NOTED OTHERWISE.
5. FOR BASE PLATE AND ANCHOR BOLT DETAIL -- REFER TYPICAL DETAILS.
6. HSS SQUARE, RECTANGULAR AND ROUND HSS TUBES PAINTED WITH INTUMESCENT PAINT.
7. FOR WIDE FLANGE COLUMN PROVIDE SPRAY ON FIREPROOFING.


DISCLAIMER NOTE:

THIS SET OF CONSTRUCTION DRAWINGS HAS BEEN UPDATED TO INCLUDE ANY CHANGES ISSUED THROUGH ADDENDUM OR OTHER MEANS. EVERY EFFORT HAS BEEN TAKEN TO INCLUDE ALL CHANGES TO DATE. THE CONTRACTOR IS STILL RESPONSIBLE FOR PROVIDING ANY ITEMS THAT WERE SHOWN AS PART OF THE ORIGINAL BID SET THAT MAY HAVE BEEN OVERLOOKED AND NOT INCLUDED IN THIS SET.

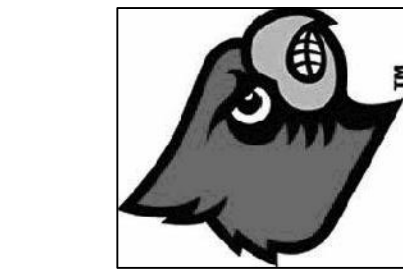


UNIVERSITY OF  
LOUISVILLE

**Omni**  
ARCHITECTS  
212 North Upper Street  
Lexington, Kentucky 40507-1001  
p 859.252.6664 f 859.253.2358  
www.omniarchitects.com

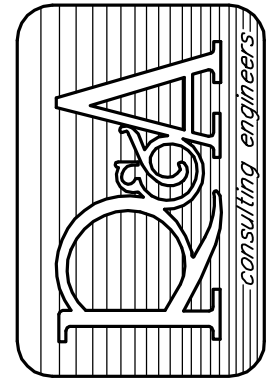

**RANGASWAMY AND ASSOC., INC.**  
Suite 420, The Landmark Building  
1000 W. Main Street  
Louisville, KY 40202  
phone : (502) 582-2212  
Fax : (502) 582-2240 : www.rangaswamy.com

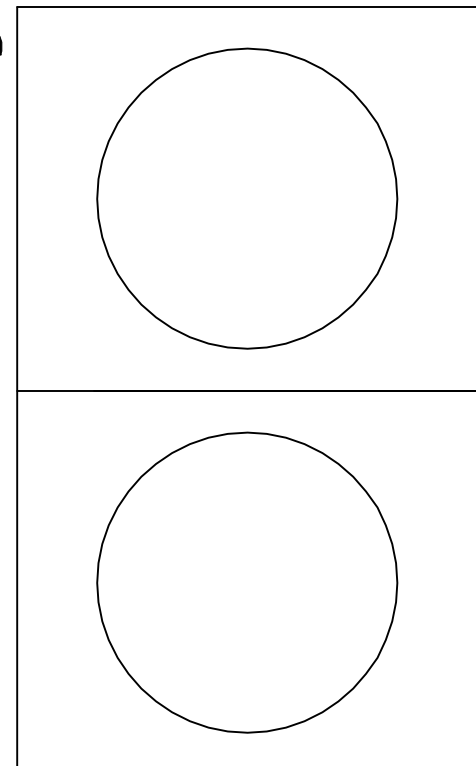

Drawing Name:	COLUMN SCHEDULE			
	U of L Project Number:			
	Project Number:		0mml – 1105.00	Cannon – 03667.00
	Date:		March 02, 2012	
Drawn By:	vpp	Checked By:	ANTHONY	

S0171