




1
A1.10 PEDESTRIAN NORTH ENTRANCE PLAN 1/8" = 1'-0"

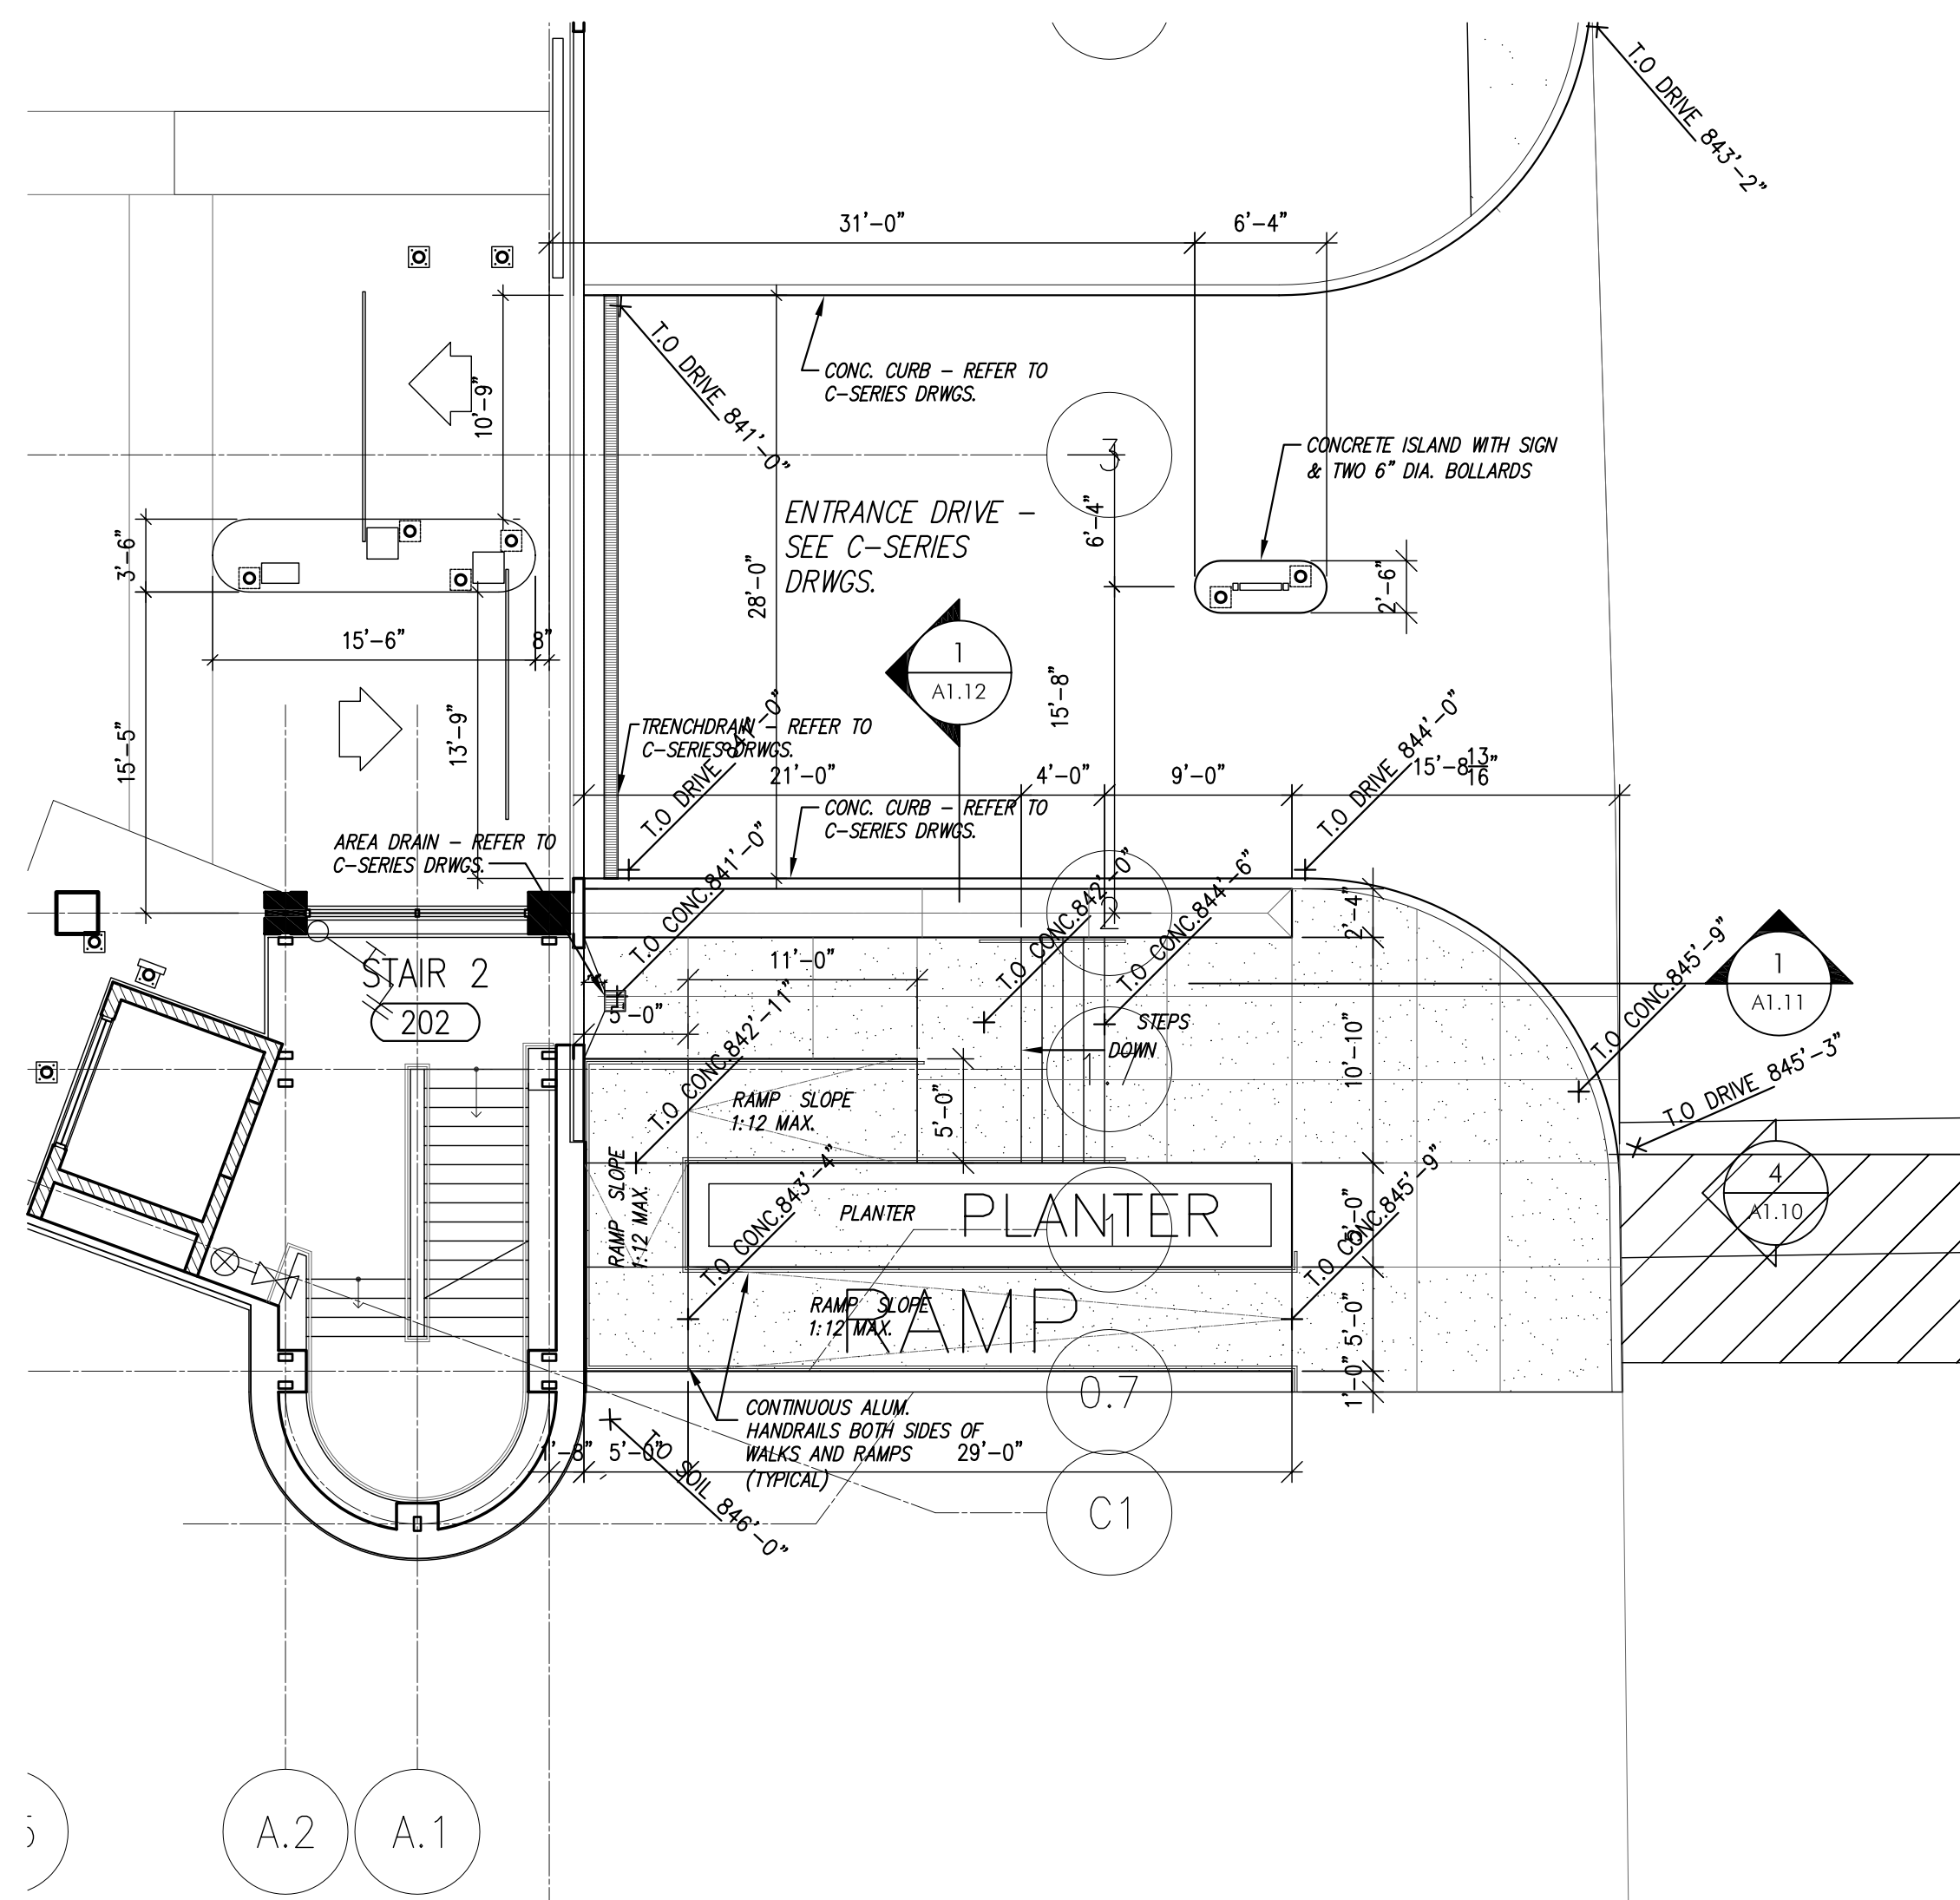


2
A1.10 PEDESTRIAN SOUTH ENTRANCE PLAN 1/8" = 1'-0"

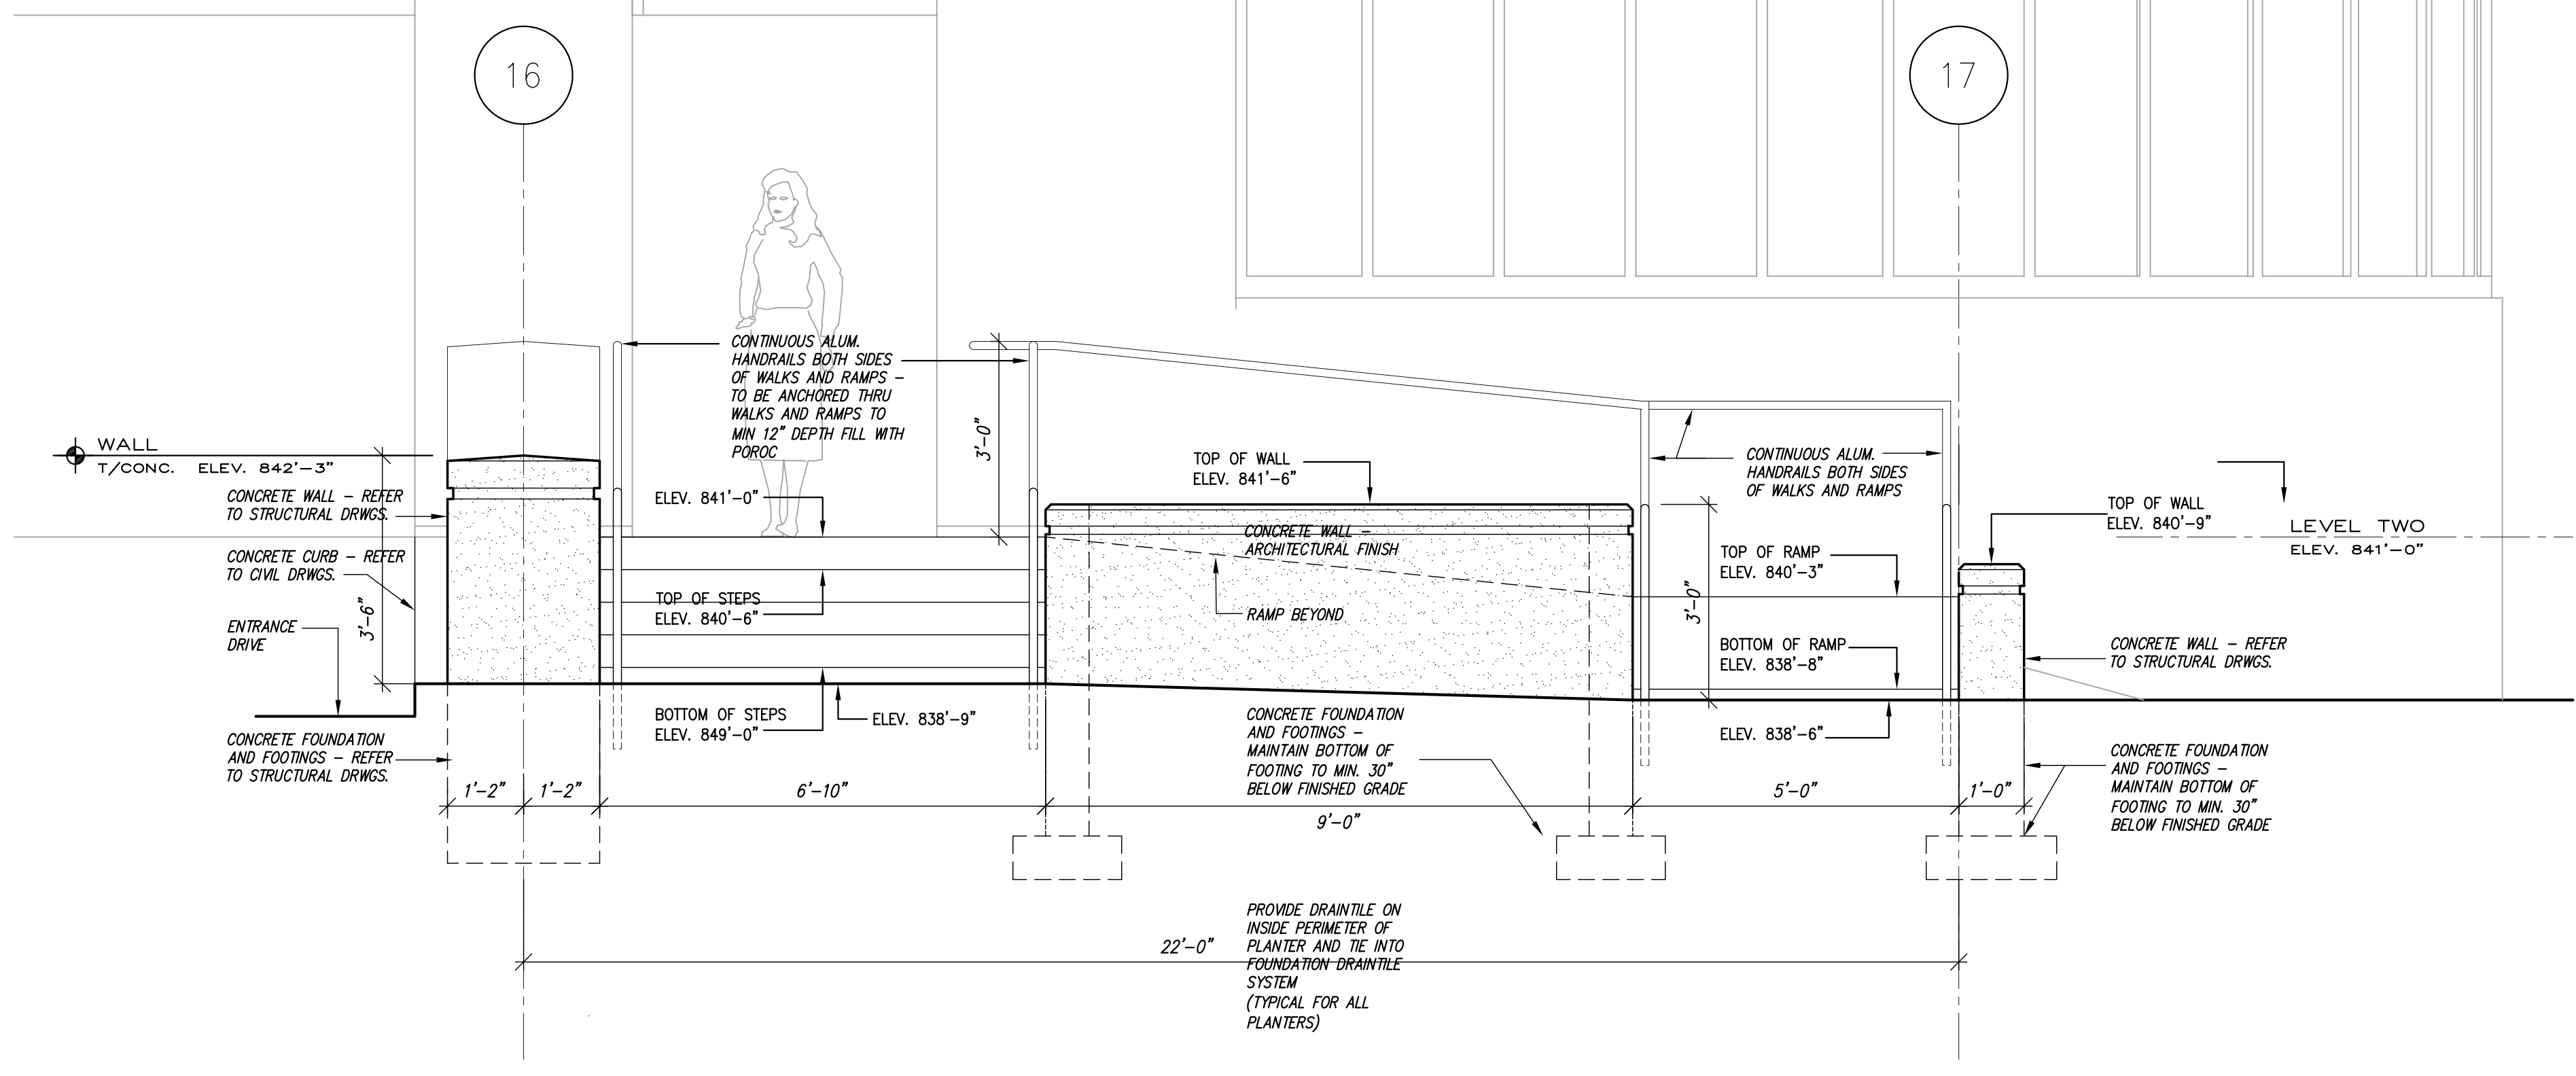

3
A1.10 PEDESTRIAN NORTH ENTRANCE ELEVATION 1/2" = 1'-0"

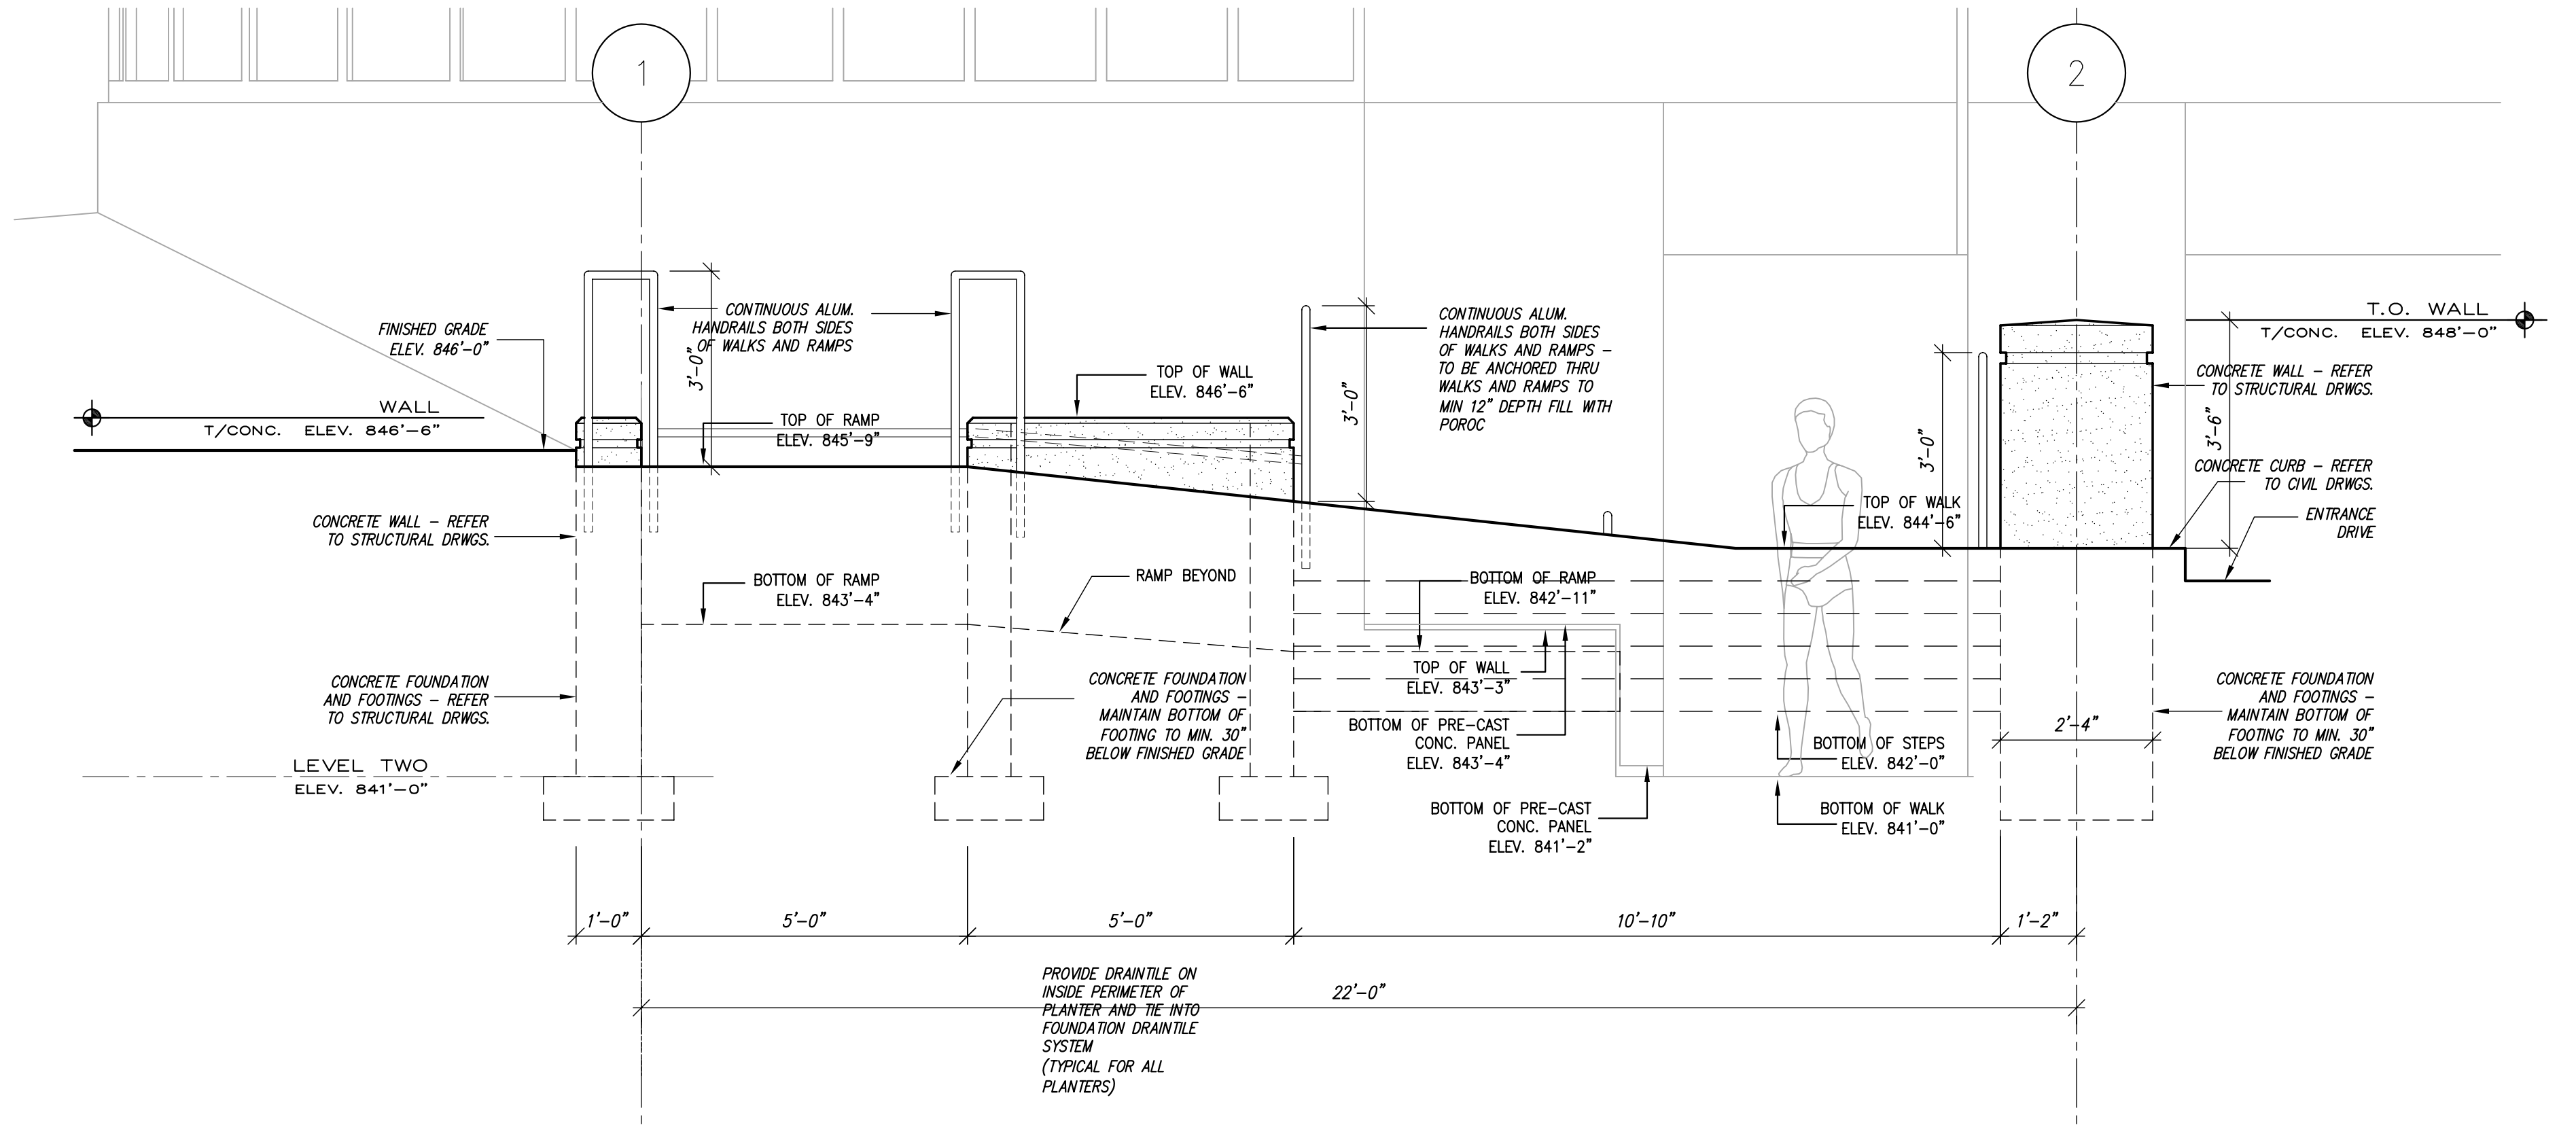

4
A1.10 PEDESTRIAN SOUTH ENTRANCE ELEVATION 1/2" = 1'-0"

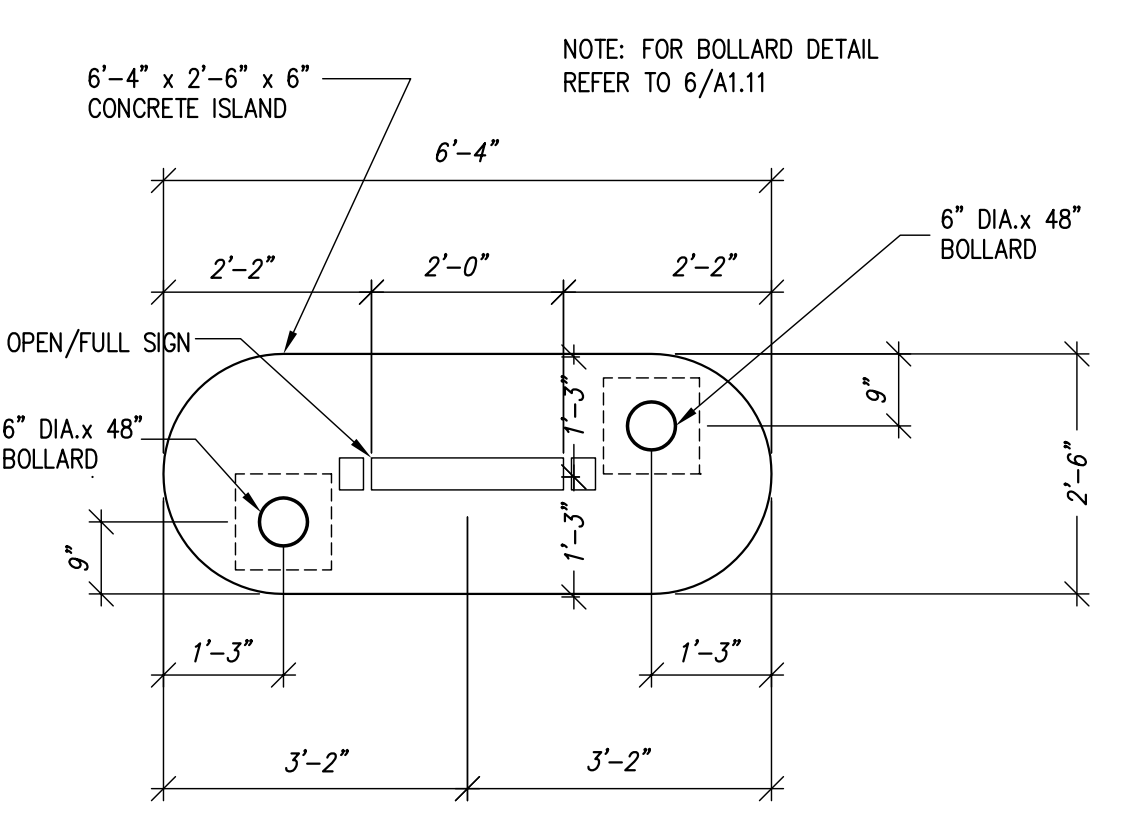

5
A1.10 TYPICAL 'SIGN' ISLAND 1/2" = 1'-0"

		PARKING GARAGE No. 2 NORTHERN KENTUCKY UNIVERSITY HIGHLAND HEIGHTS, KENTUCKY	
J. L. Wyler 3636 J. Tepe Wurttemberg 3719		PEDESTRIAN ENTRANCE PLANS AND ELEVATIONS COMMONWEALTH OF KENTUCKY FINANCE AND ADMINISTRATION CABINET DEPARTMENT FOR FACILITIES MANAGEMENT DIVISION OF ENGINEERING FRANKFORT, KENTUCKY	
REVISIONS 1 RECORD DRAWINGS 6/20/05 2 AS NOTED 3 4 5 6 7 8		RECORD DATE DRAWN BY CHECKED BY AKE FILE NO. 280-00 SCALE AS NOTED DATE 10/30/2003	
AGENCY AUTHORIZED AGENT DIVISION OF ENGINEERING		DRAWING NO. A1.10 REVIEWED DIV. OF ENGR. FOR INTENT ONLY ENGR. FILE NO. PNKU0590	
APPROVED FOR PROGRAM CONCEPT ONLY		DATE	
APPROVED FOR PROGRAM CONCEPT ONLY		DATE	

24/17/2005-00 Parking Garage/Entrance Plans/10-A1-11-A1-12.dwg Job: 05_2004-4-10pm - (C) Champlin/Haupt - ase