
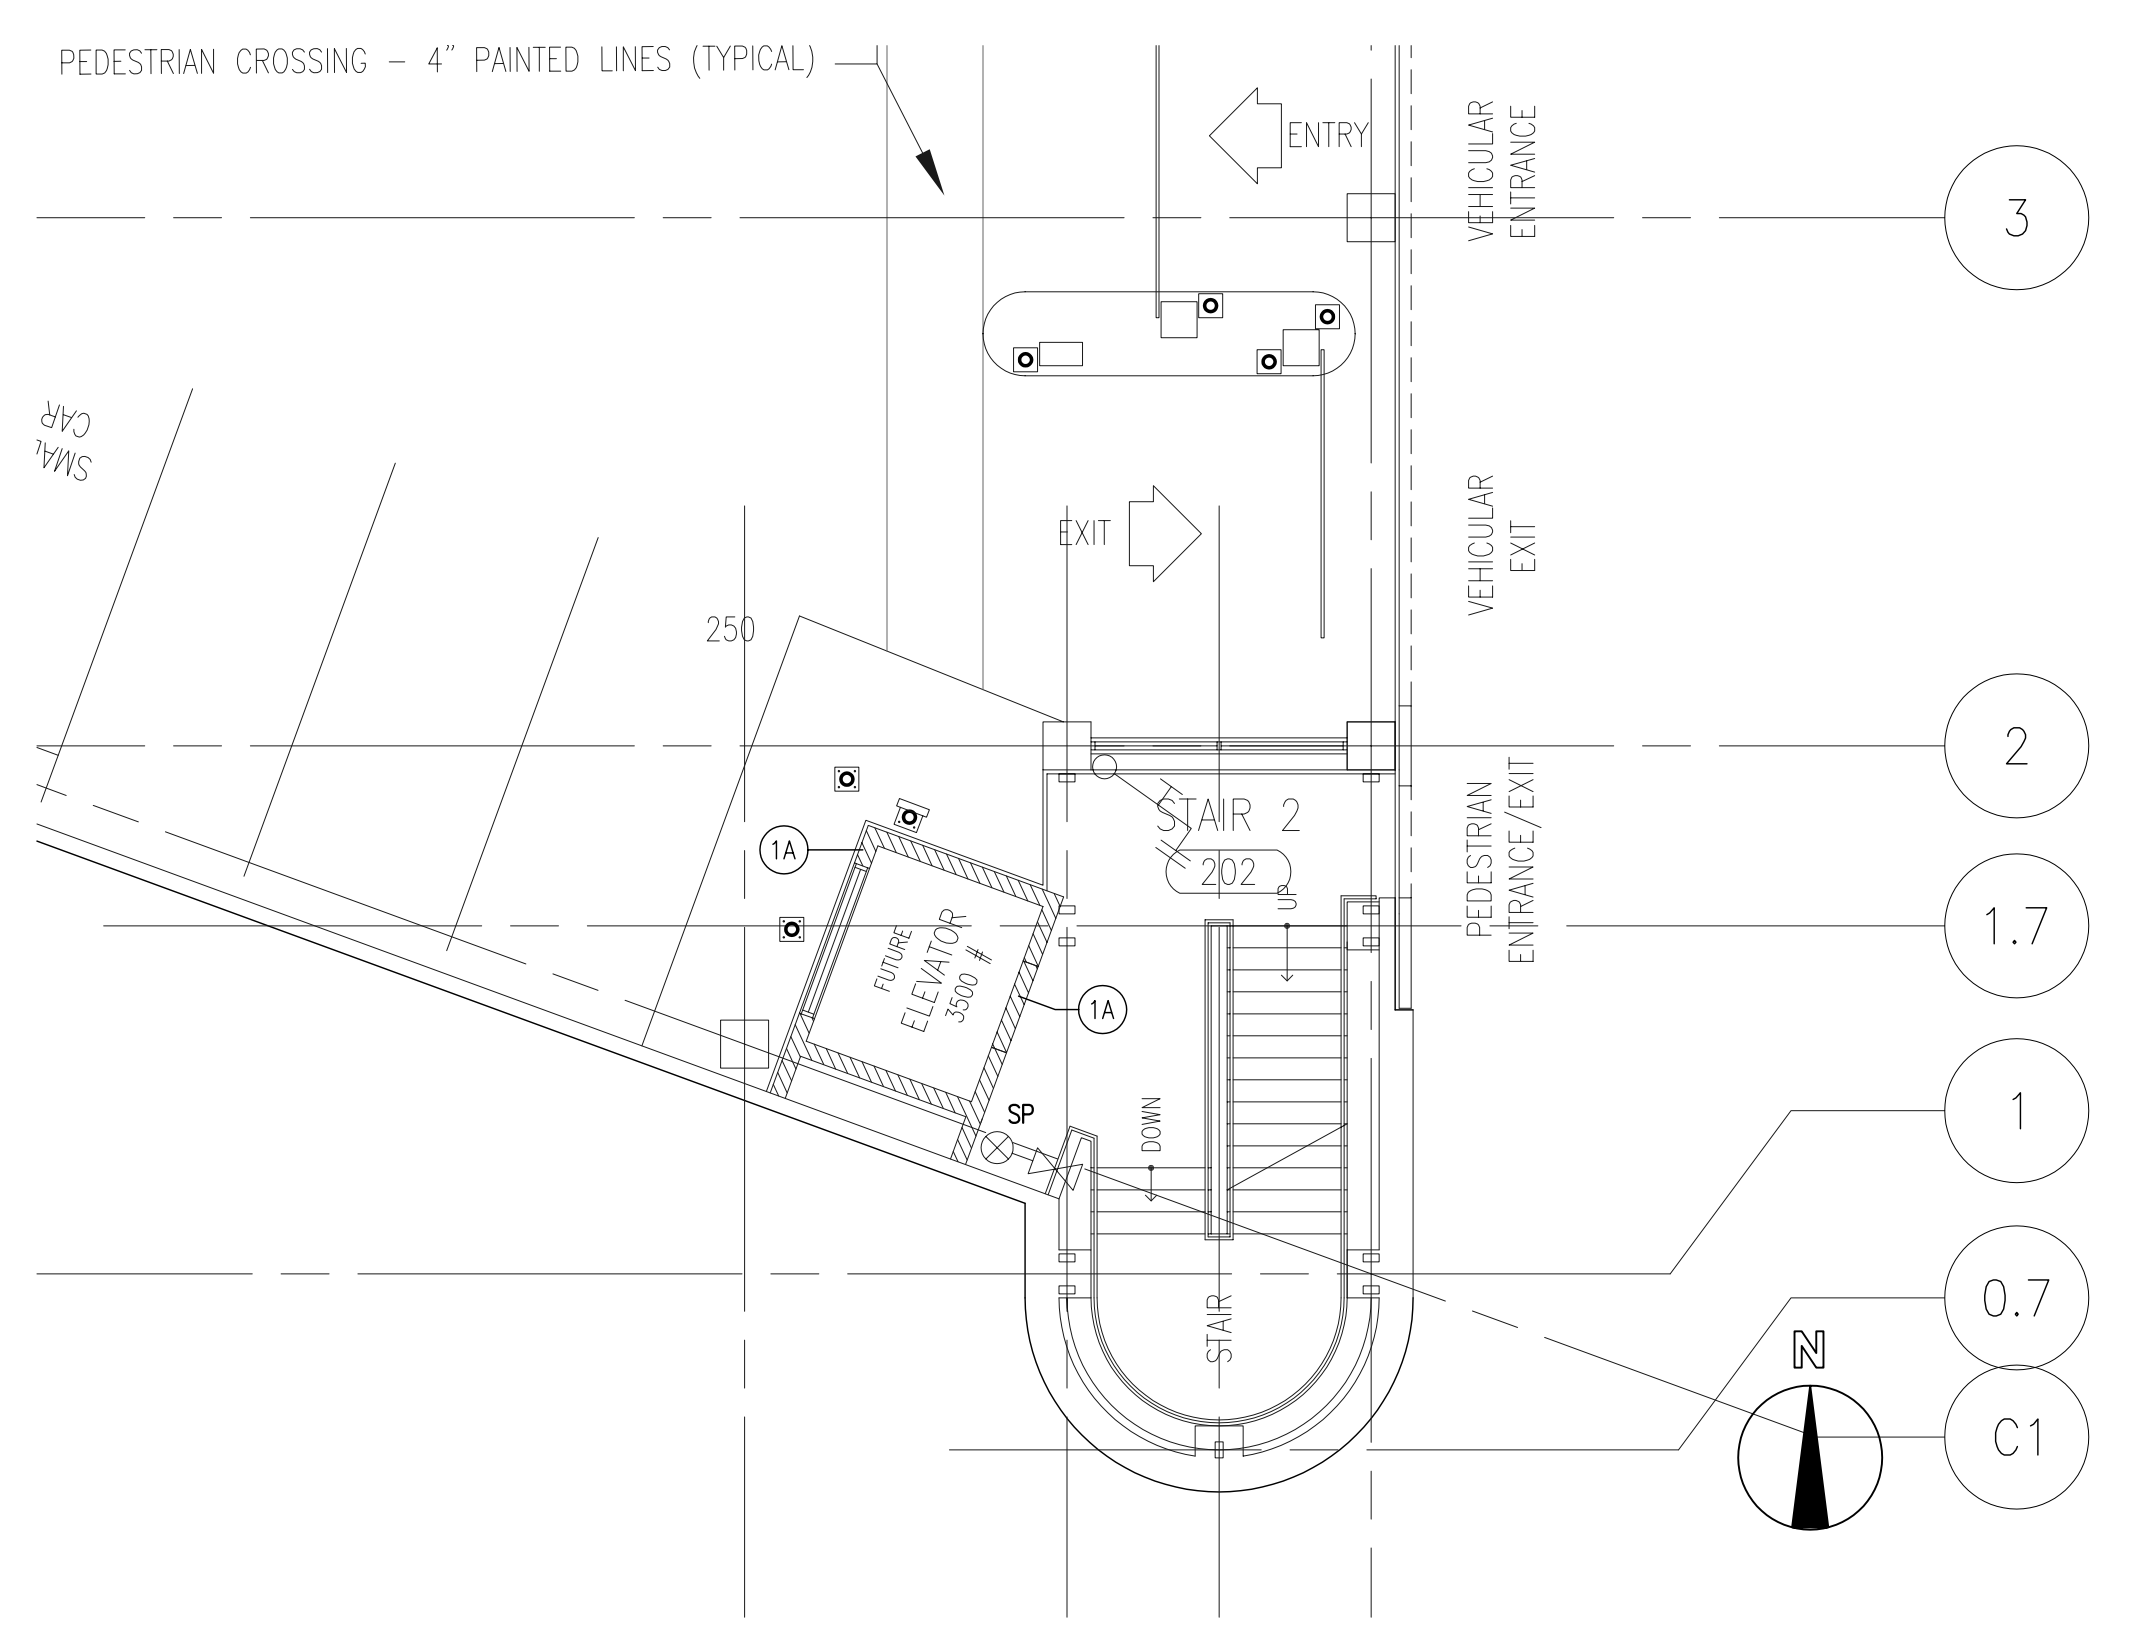




**1**  
A2.00 **LEVEL ONE - FIRE SEPARATION PLAN** 1/8" = 1'-0"

PARTITION TYPES SCHEDULE			
<b>NOTES:</b>			
1. ALL INTERIOR PARTITIONS SHOWN ON PLANS ARE TO BE PARTITION TYPE 2, UNLESS NOTED OTHERWISE.			
2. ALL RATED BLOCK PARTITIONS TO CONTINUE TO UNDERSIDE OF DECK.			
3. ALL OUTSIDE EDGE CORNERS ON BLOCK WALLS TO HAVE A BULLNOSE.			
4. UL NUMBERS ARE REFERENCED FROM UL 1999 EDITION.			
SYMBOL	GRAPHICS - PLAN VIEW	FIRE RATING	DESCRIPTION
1		2 HR UL-L UL-L	8" NOMINAL NORMAL WEIGHT CONCRETE MASONRY UNITS MEETING UL CLASSIFICATION 0-2 (2HR) - CONTINUE TO UNDERSIDE OF CONCRETE DECK. PROVIDE 1" SOFT JOINT AT TOP OF WALL SYSTEM, BETWEEN TOP OF CMU AND BOTTOM OF CONCRETE STRUCTURE. THE JOINT IS TO BE FILLED WITH A 2HR. FIRE RATED CAULK SYSTEM ON BOTH SIDES OF THE WALL.
1A		---	SAME AS PARTITION TYPE 1, UNLESS NOTED OTHERWISE.
			3

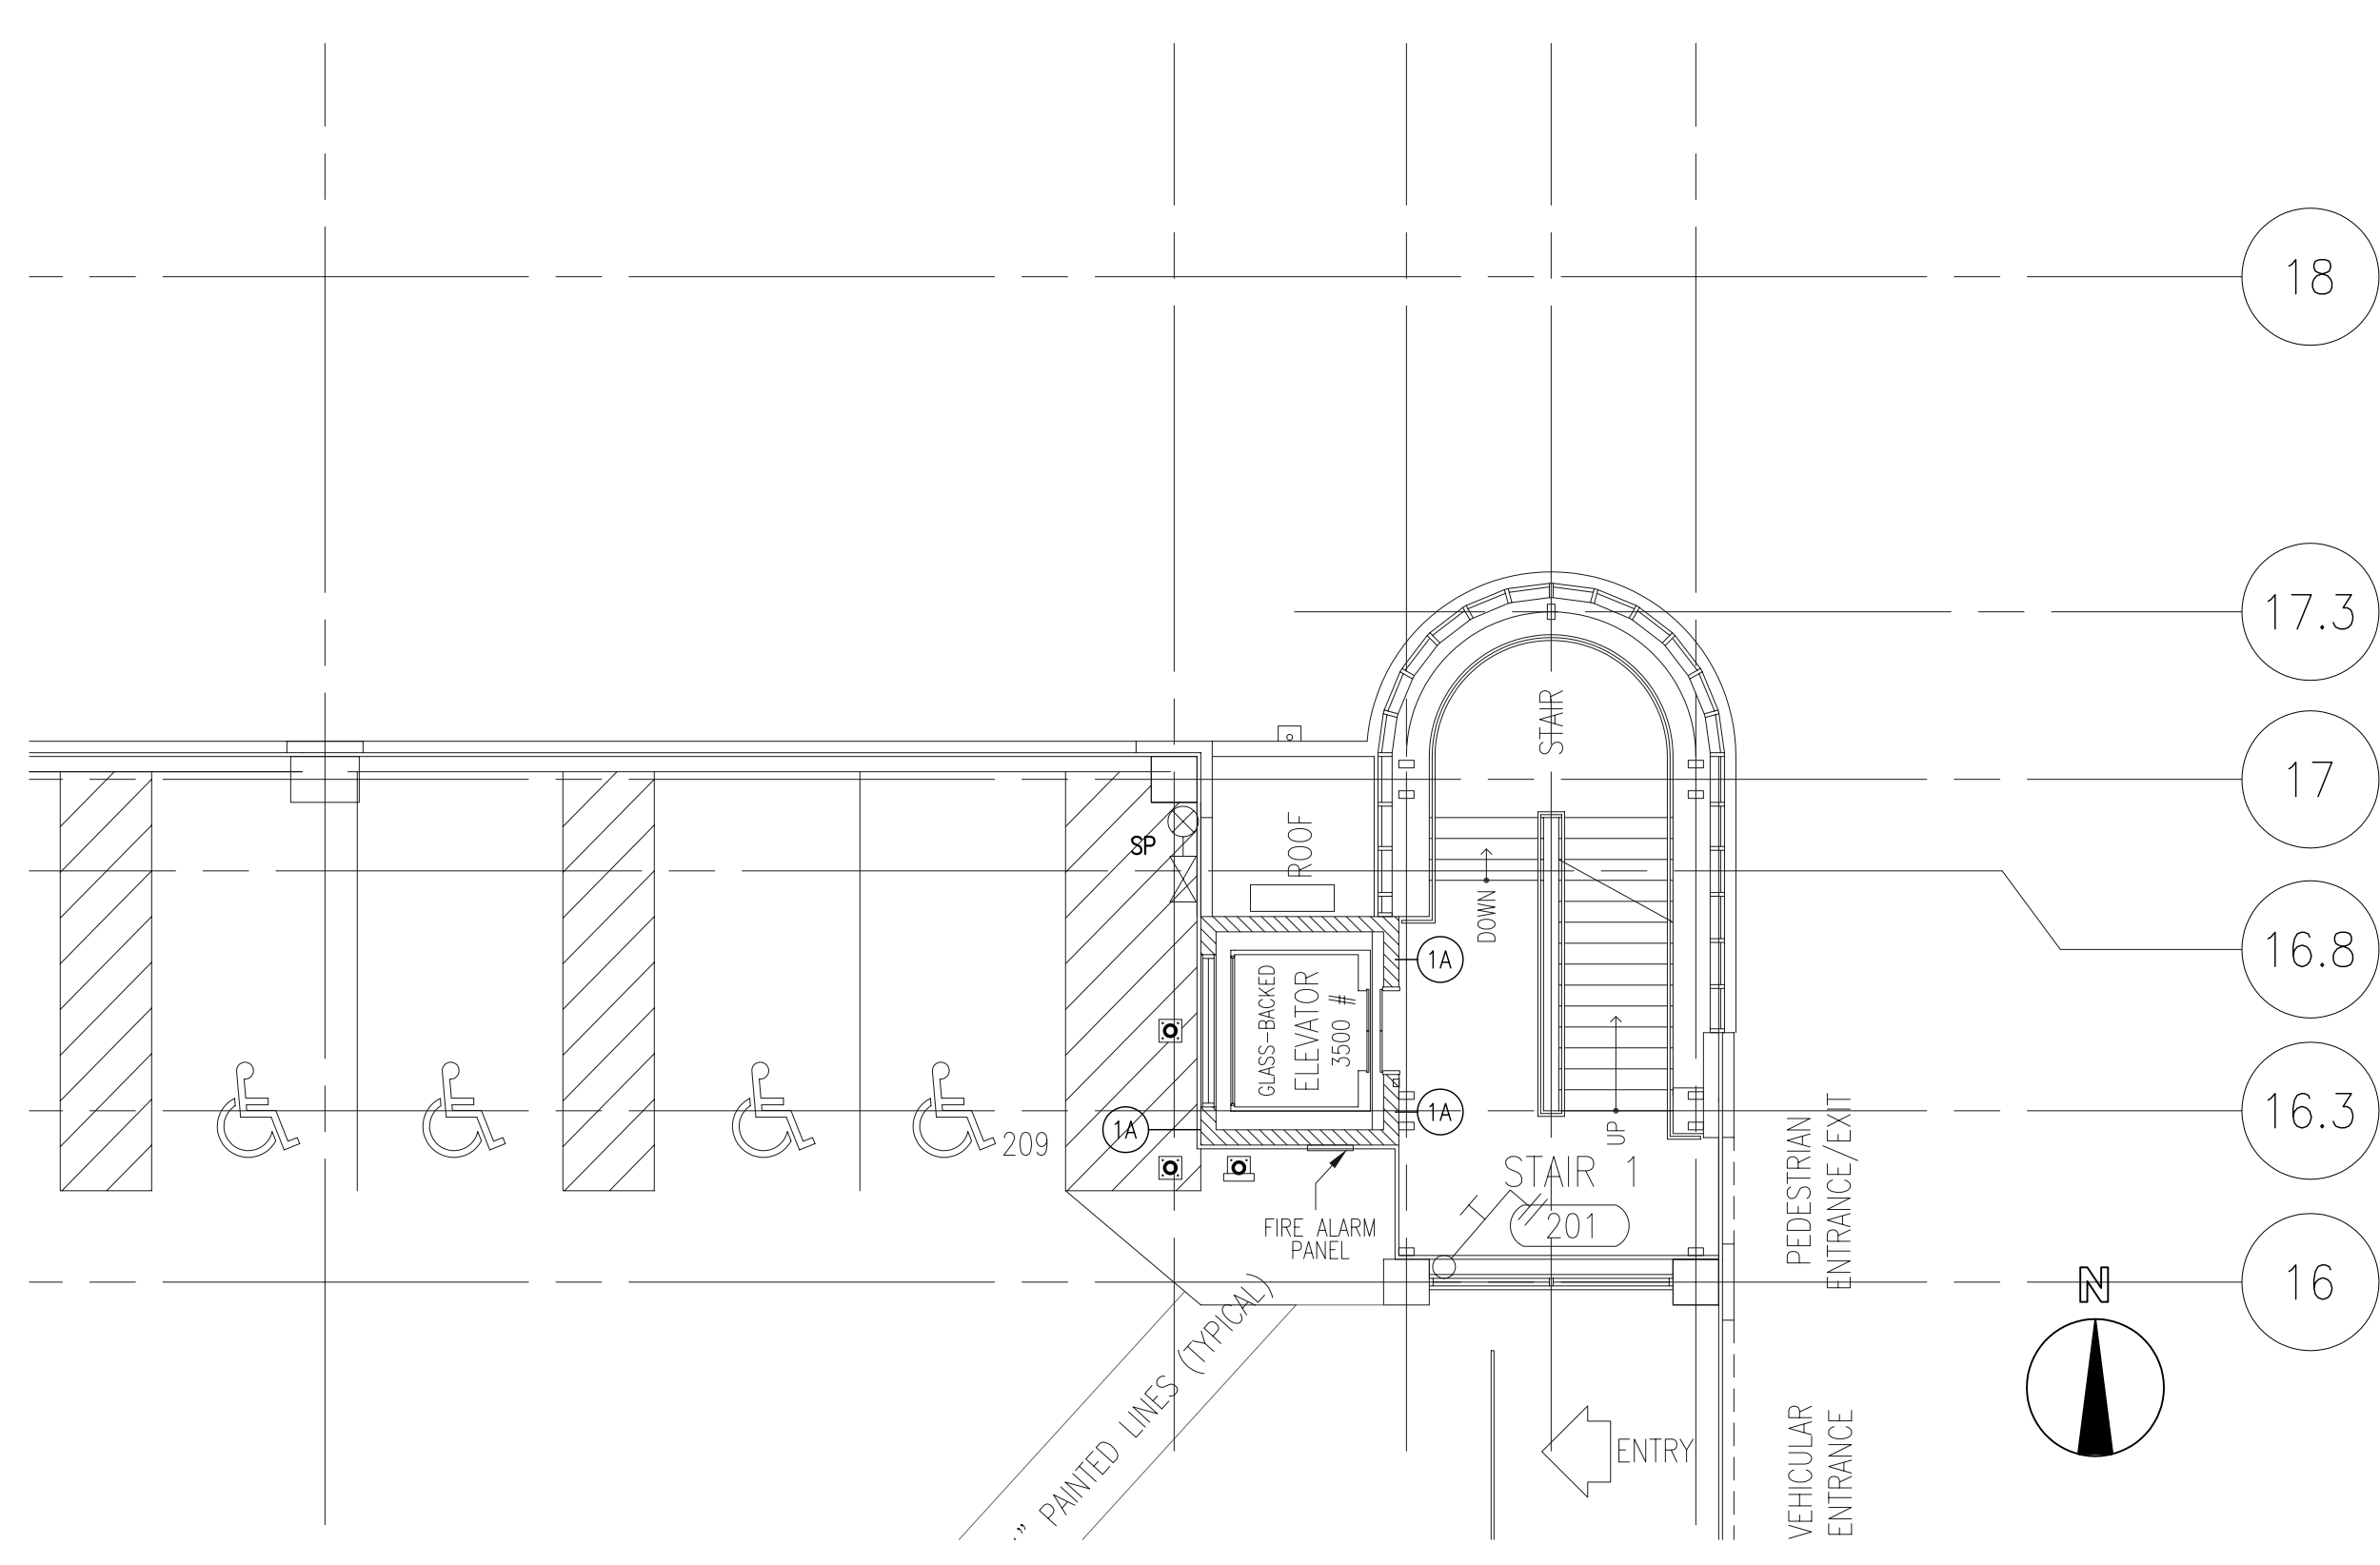

**2**  
A2.00 **LEVEL TWO - FIRE SEPARATION PLAN** 1/8" = 1'-0"

**4**  
A2.00 **PARTITION TYPES**

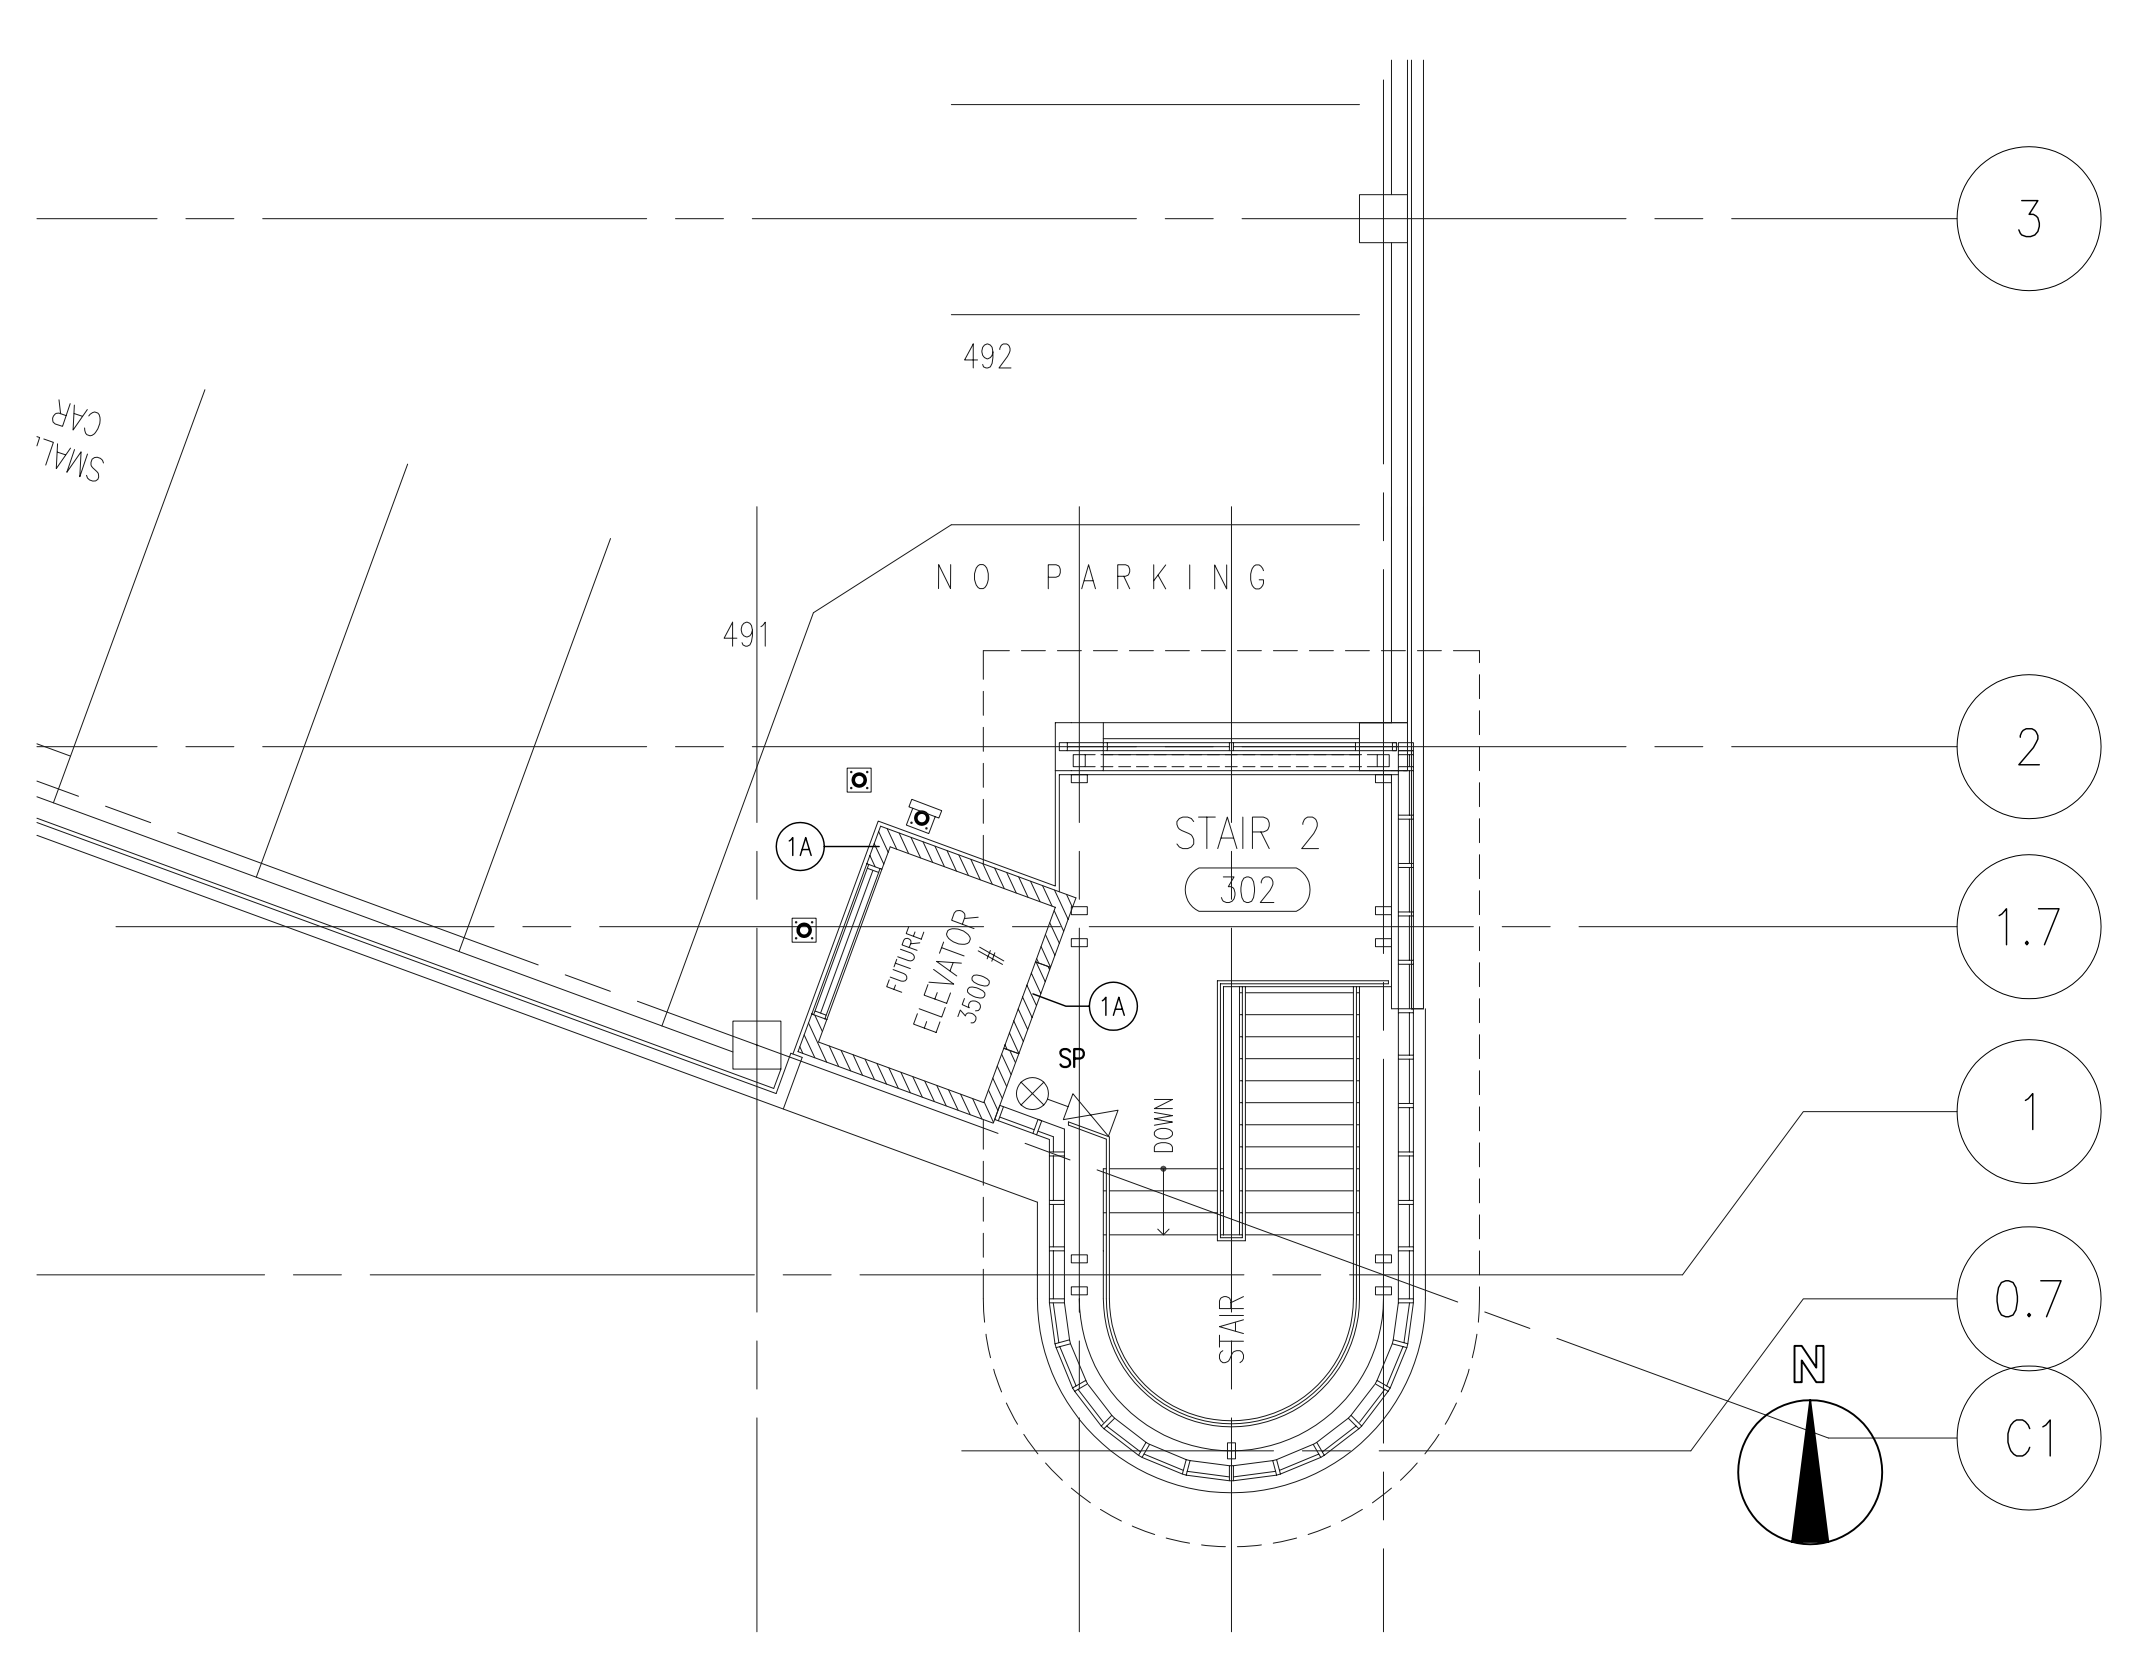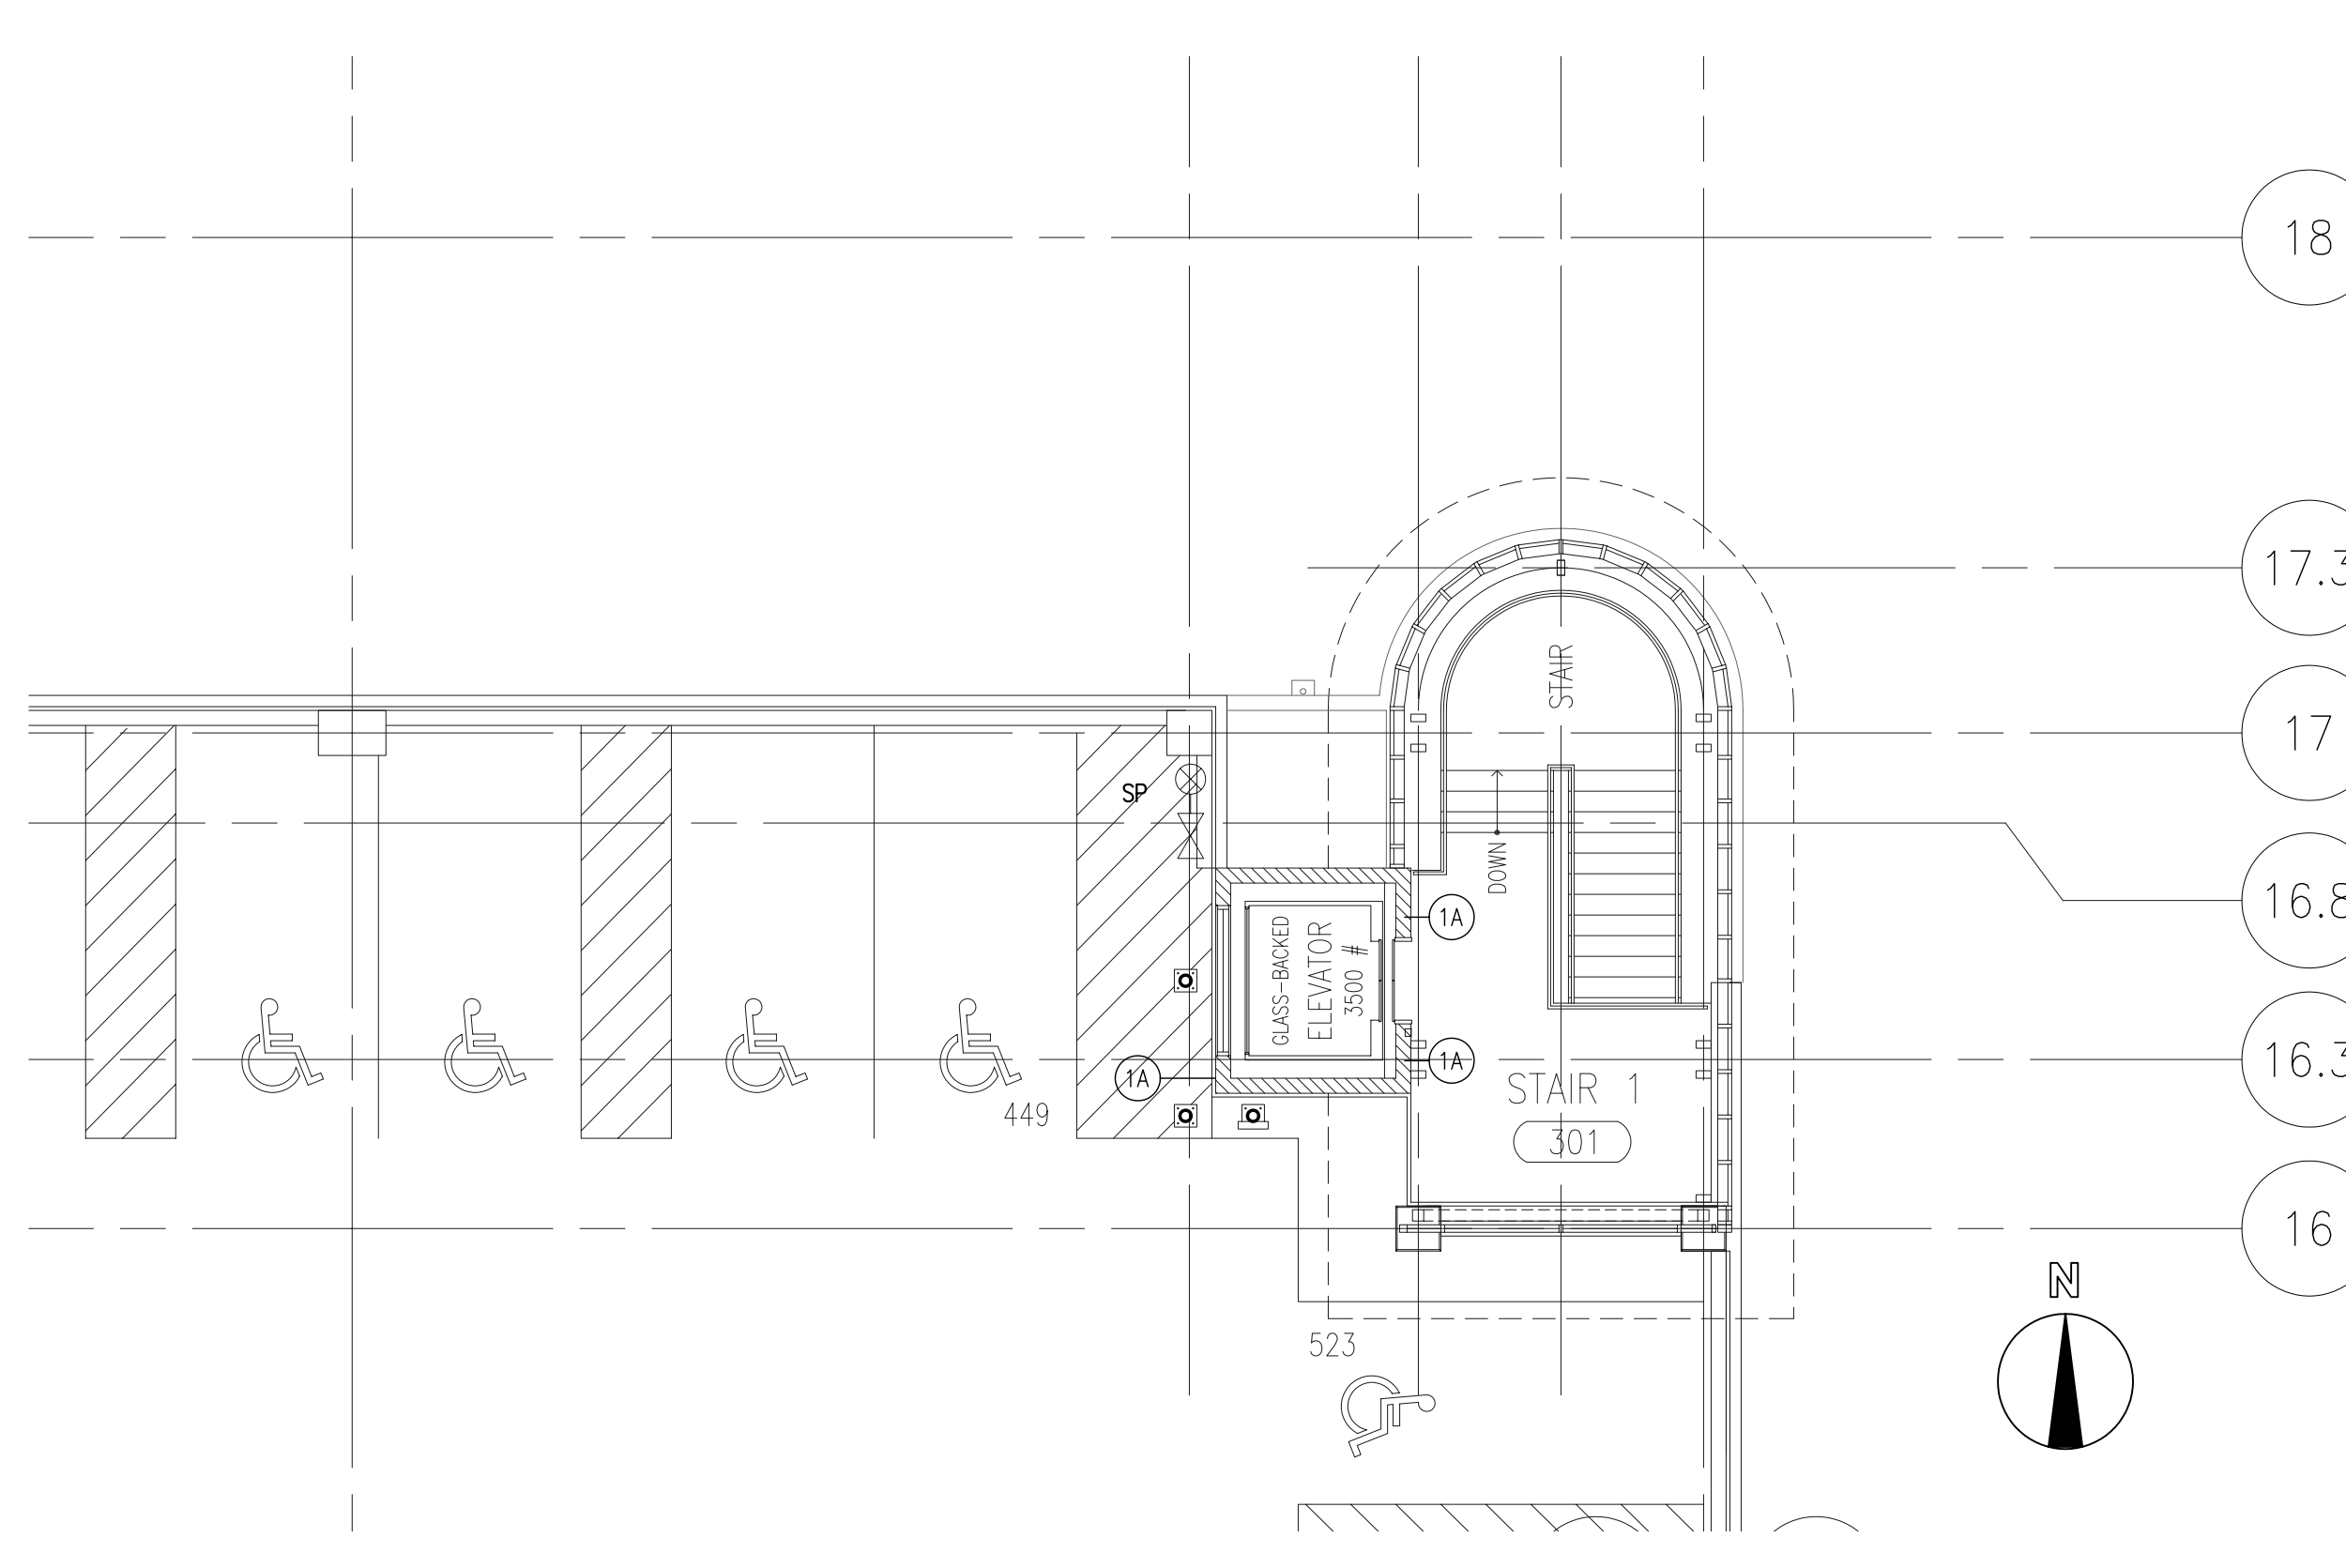

**3**  
A2.00 **LEVEL THREE - FIRE SEPARATION PLAN** 1/8" = 1'-0"

**LEGEND**

- 2 HOUR FIRE SEPARATION
- FE FIRE EXTINGUISHER
- FVC FIRE VALVE CABINET
- SP STANDPIPE

		<b>PARKING GARAGE No. 2</b> <b>NORTHERN KENTUCKY UNIVERSITY</b> HIGHLAND HEIGHTS, KENTUCKY		DRAWING NO. <b>A2.00</b>
REVISIONS      DATE 1 RECORD DRAWINGS      6/20/05 2 3 4 5 6 7 8		RECORD DATE DRAWN BY CHECKED BY A&E FILE NO. SCALE AS NOTED DATE 10/20/2003		REVIEWED DIV. OF ENGR. FOR INTENT ONLY ENGR. FILE NO. PNKU0590
AGENCY AUTHORIZED AGENT APPROVED FOR PROGRAM CONCEPT ONLY		DATE		DIVISION OF ENGINEERING APPROVED FOR PROGRAM CONCEPT ONLY

J:\173280-00 Parking Garage\Phase 2 Drawings\A2-00.dwg Jan 05, 2006-3:23pm - (C) Champin/Haupt - gpc