



PLAN - SUNSCREEN COLUMN BASE


ADD ALTERNATE #2

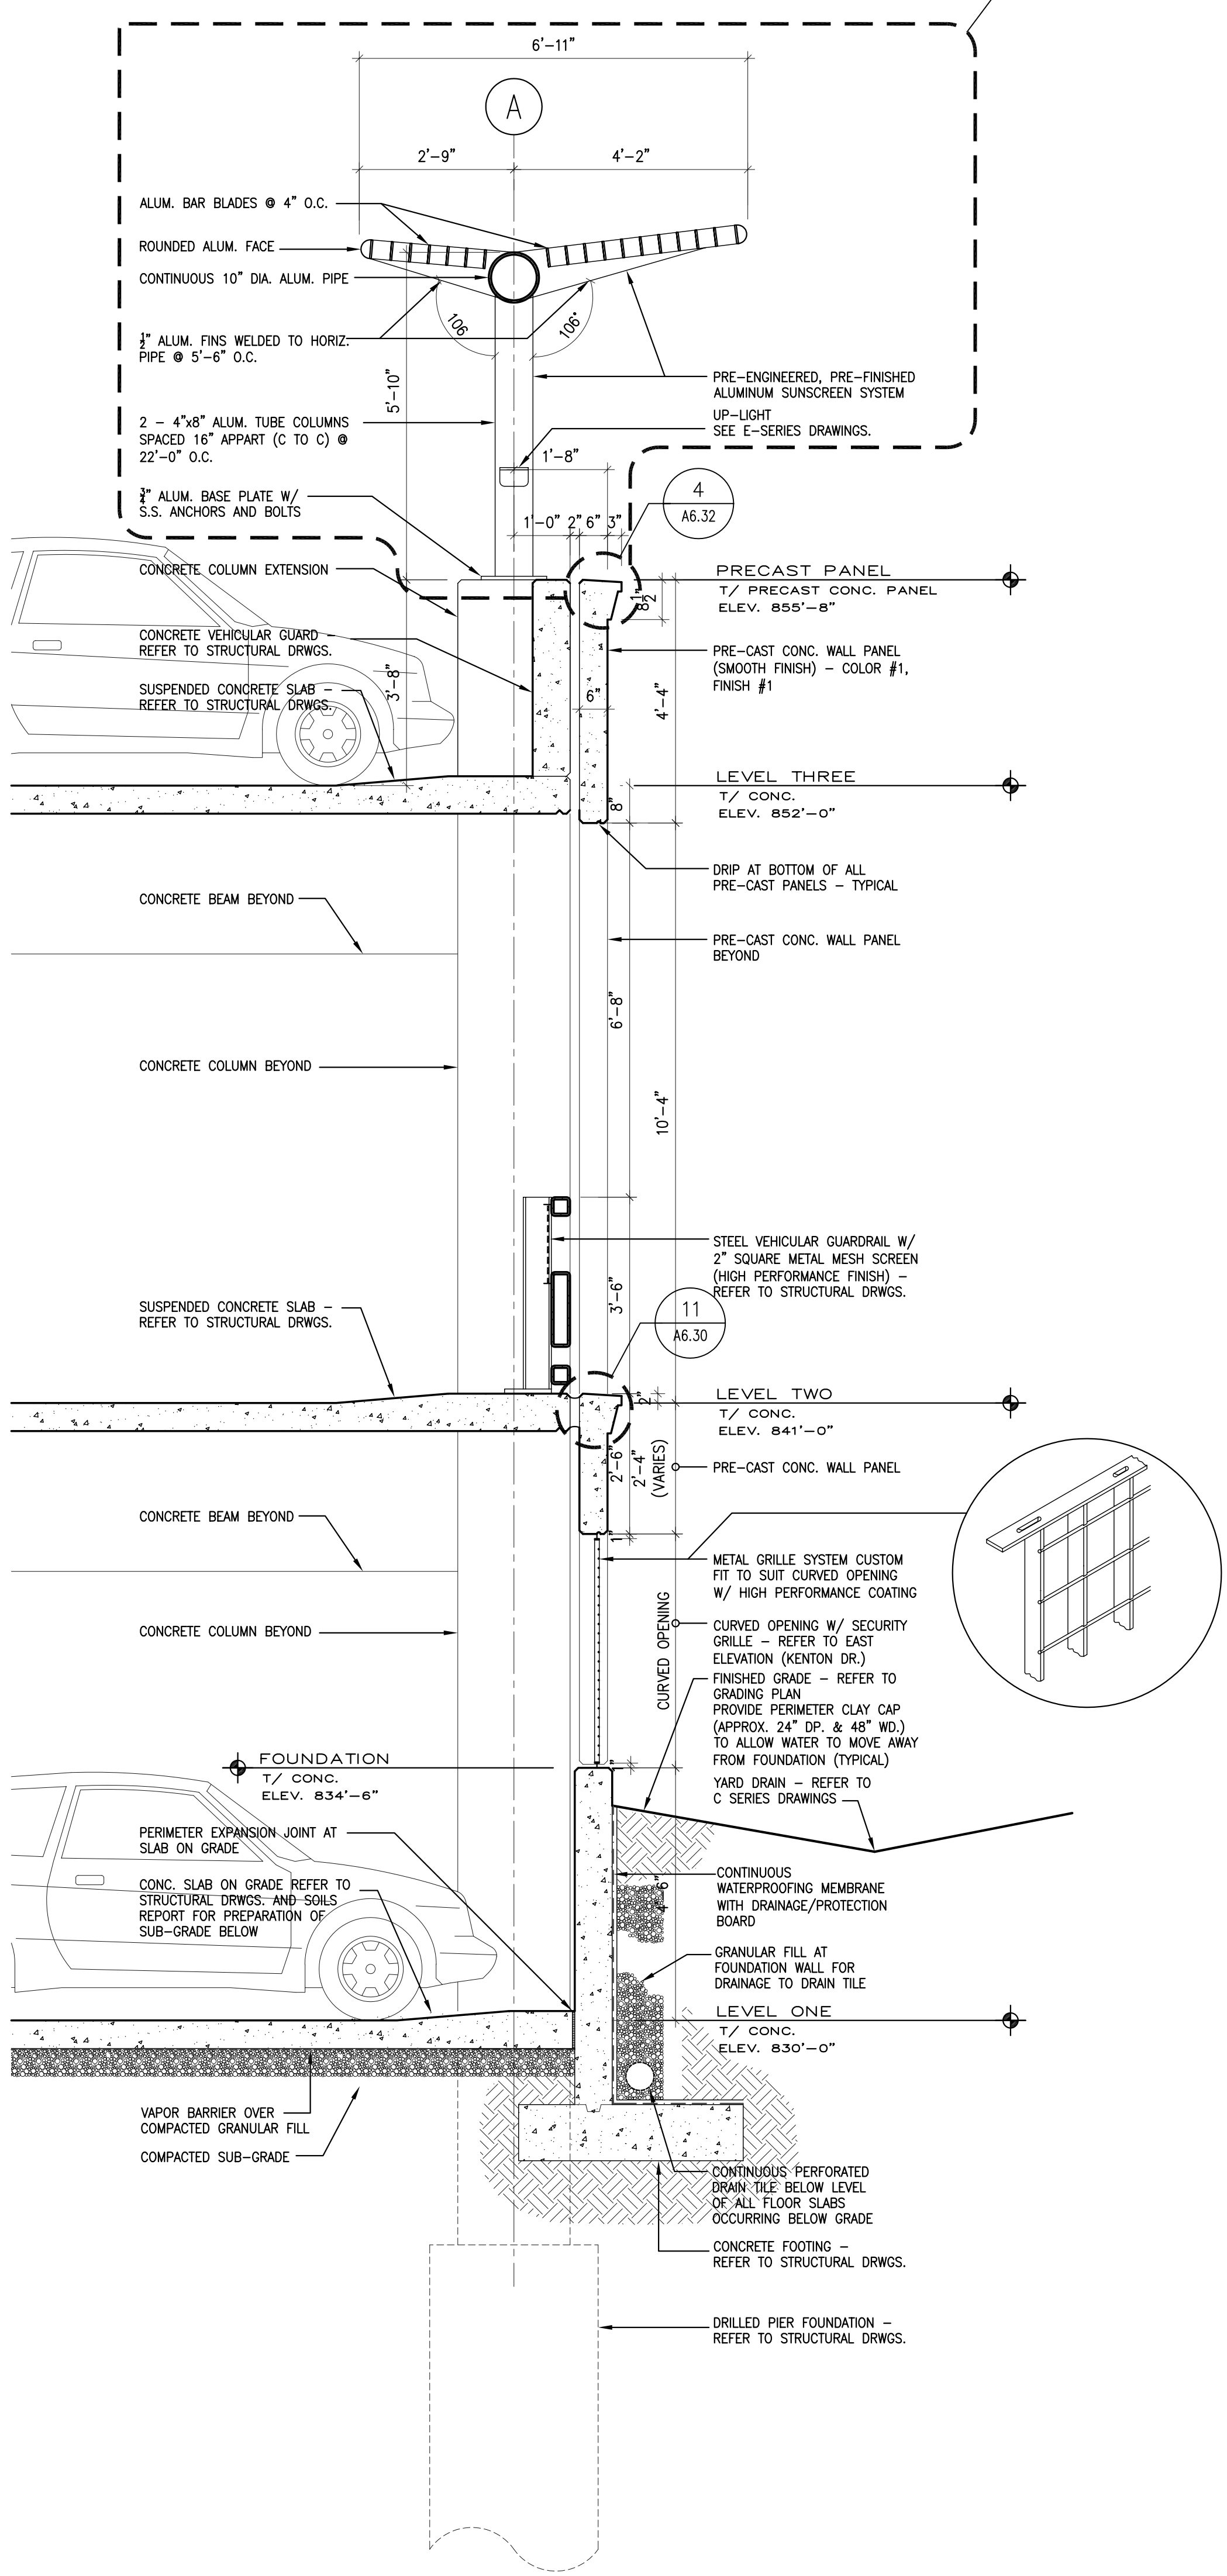

3 WALL SECTION 1/2" = 1'-0"

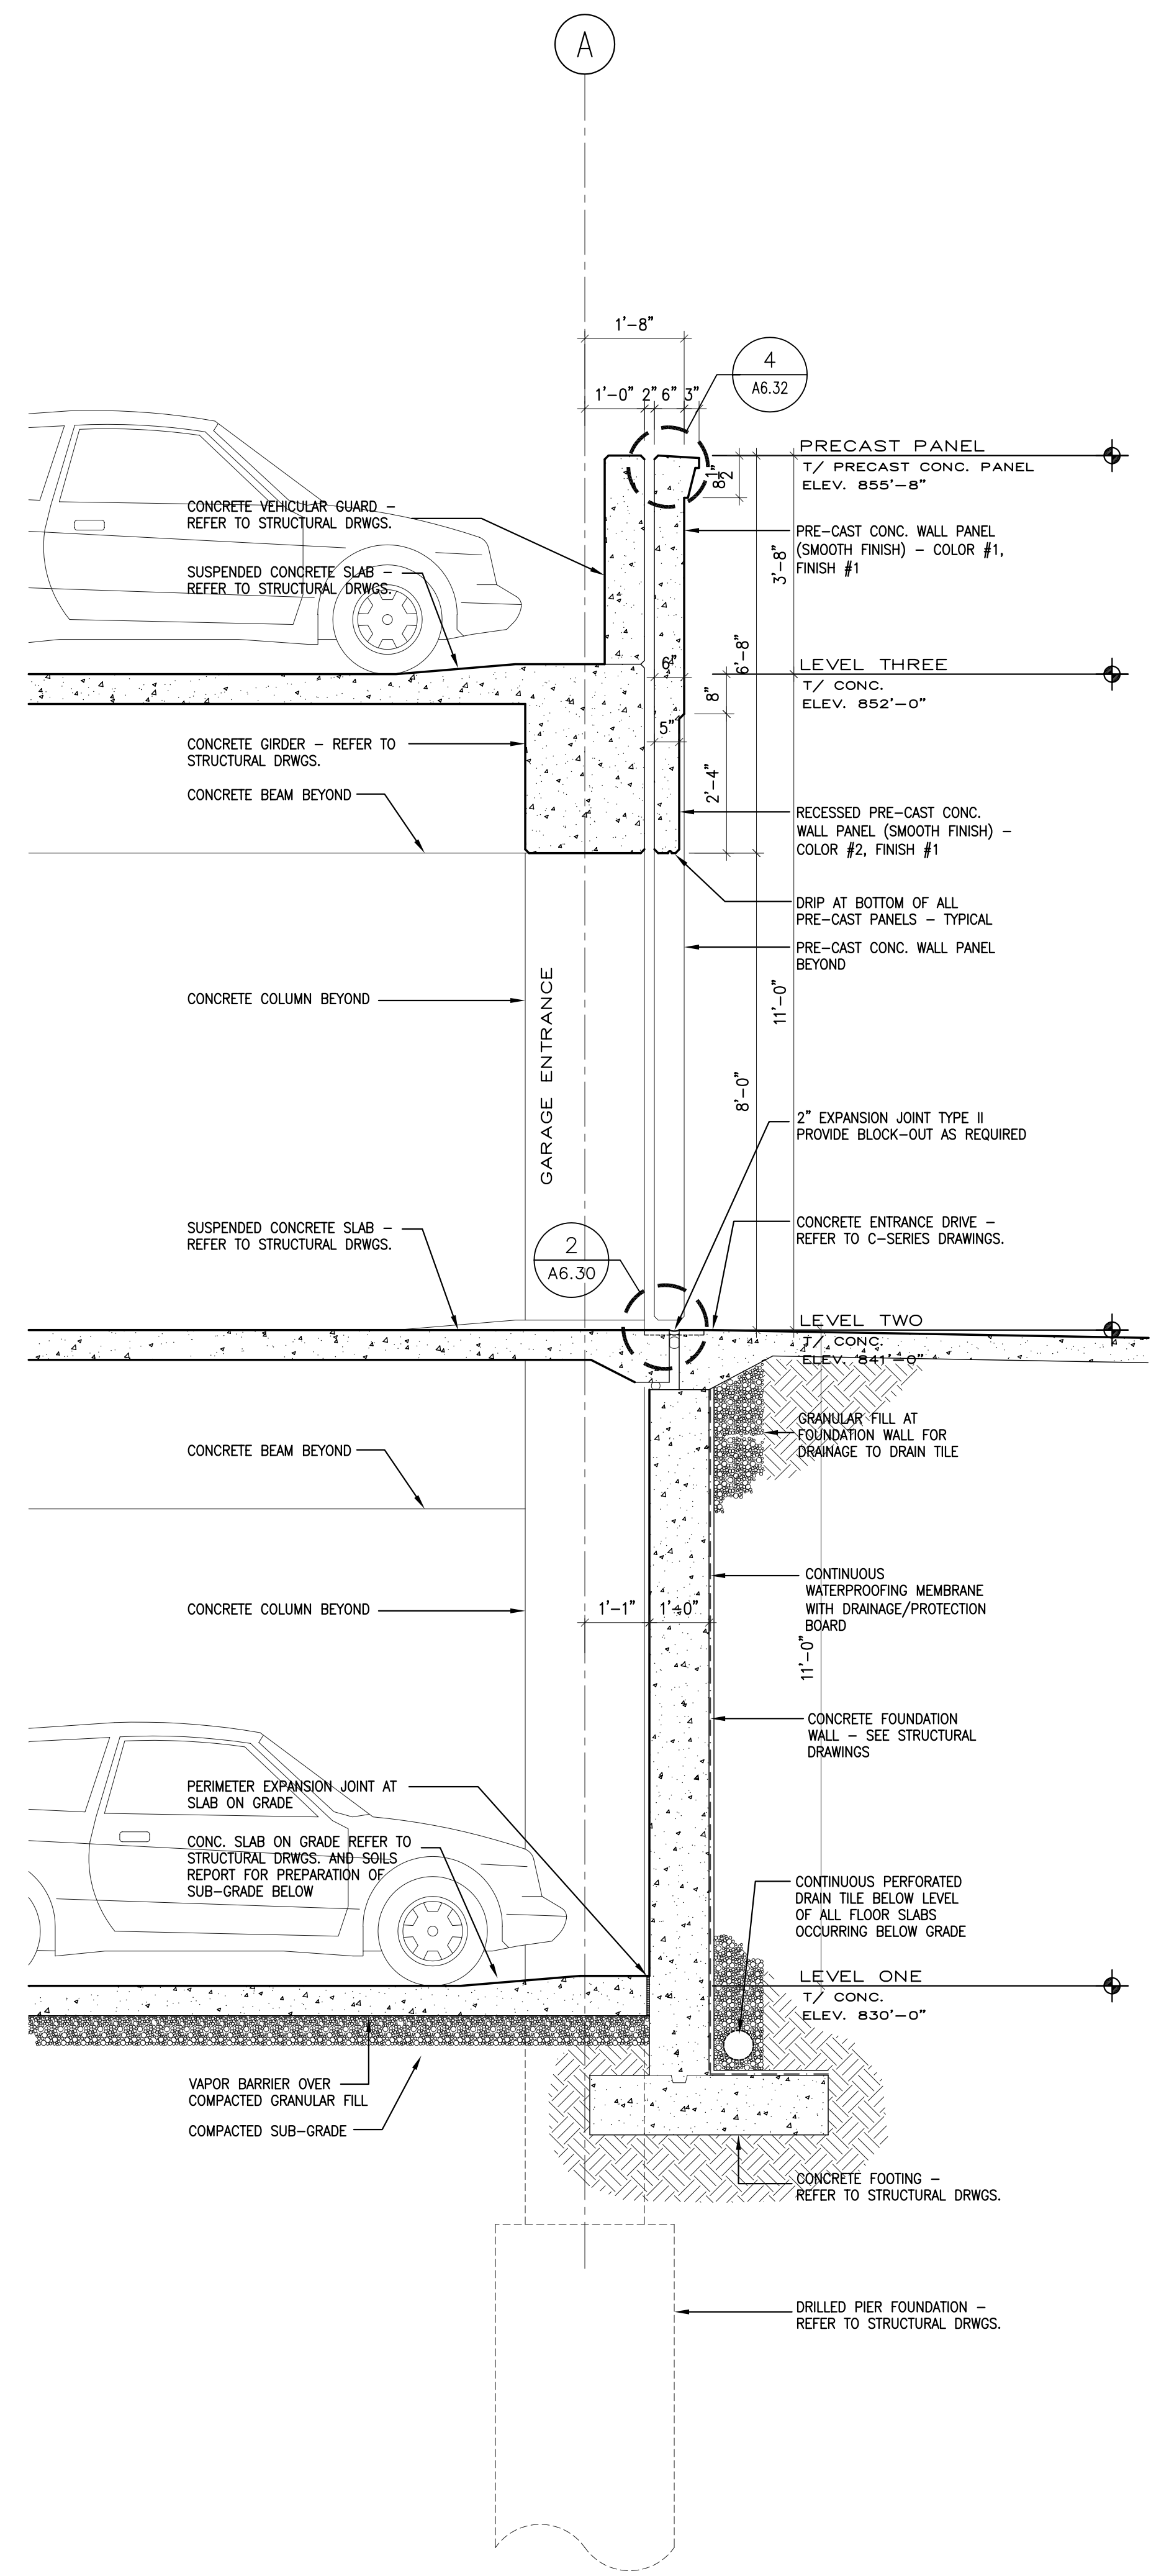

2 WALL SECTION 1/2" = 1'-0"

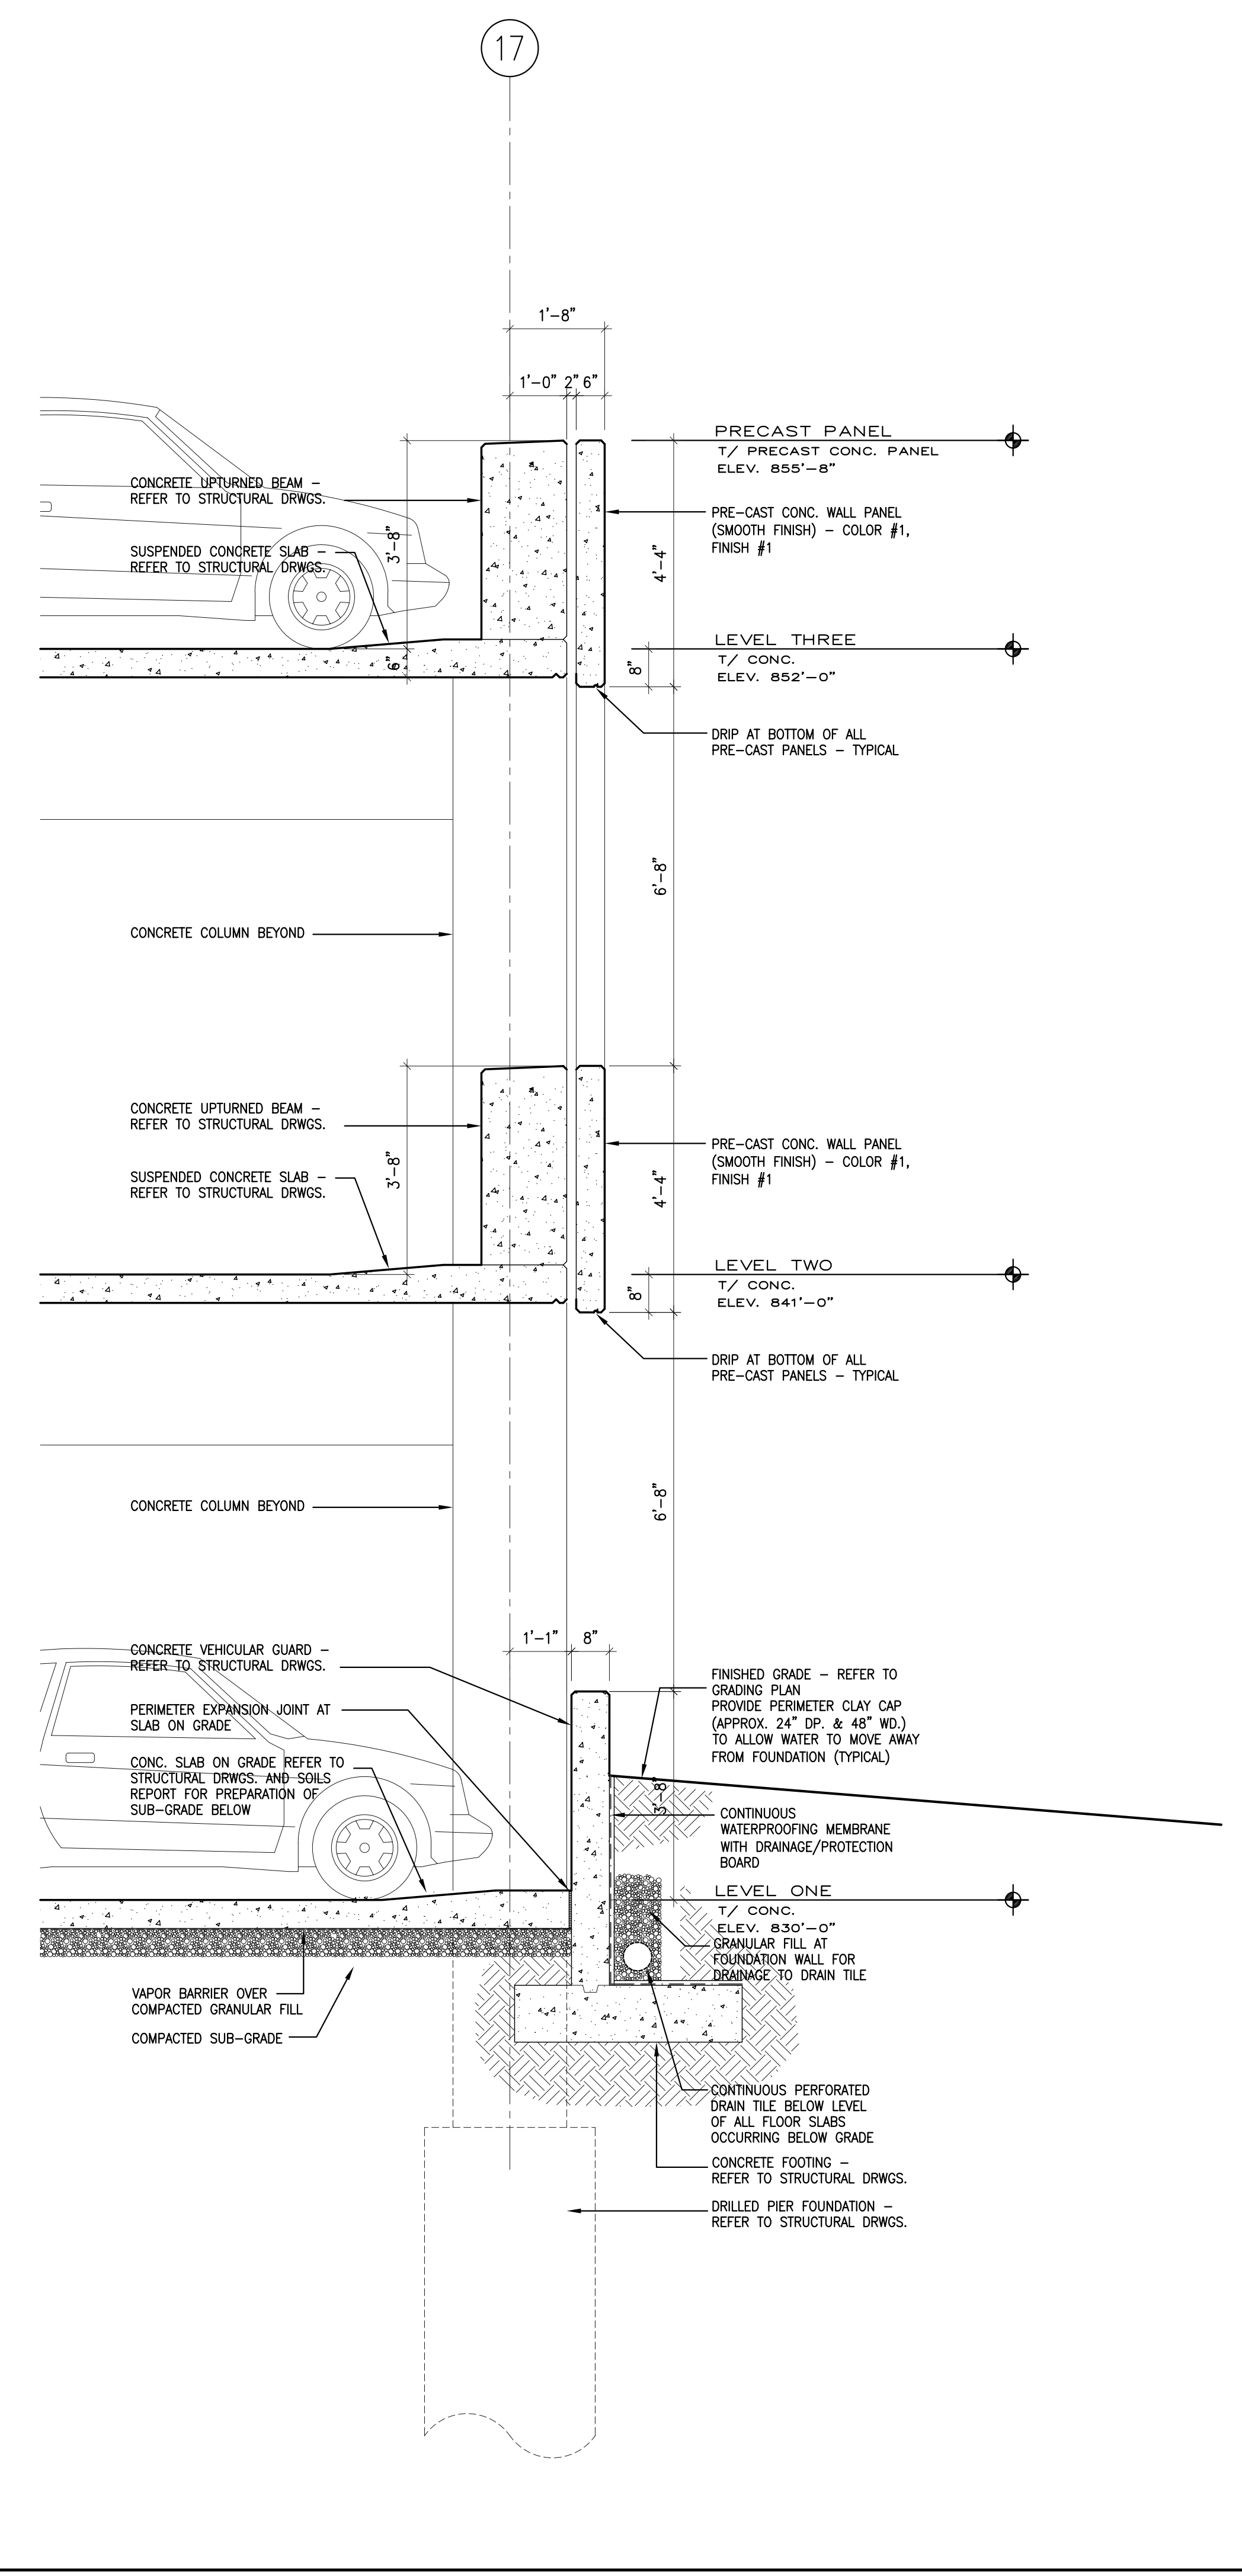

1 A4.20		WALL SECTION		1/2" = 1'-0"	
BID PACKAGE	ISSUED	BID PACKAGE	ISSUED	RECORD DATE	
				DRAWN BY	
				CHECKED BY	
				A&E FILE NO.	
				SCALE	
				DATE	
				AGENCY AUTHORIZED AGENT	
				DIVISION OF ENGINEERING	
		J. L. Wyler 3596 J. Tepe Wurtzberger 3719		COMMONWEALTH OF KENTUCKY FINANCE AND ADMINISTRATION CABINET DEPARTMENT FOR FACILITIES MANAGEMENT DIVISION OF ENGINEERING FRANKFORT, KENTUCKY	
REVISIONS		DATE		DRAWING NO.	
1	RECORD DRAWINGS	6/20/05	A4.20		
2			REVIEWED		
3			DIV. OF ENGR.		
4			ENGR. FILE NO.		
5			PNK10590		
6			DATE		
7			DATE		
8			DATE		

J:\17\2880-00 Parking Garage\phase 4\drawings\A4-20.dwg Jun 05, 2006 - 14:55pm (C) Champ/Haupt - 098