
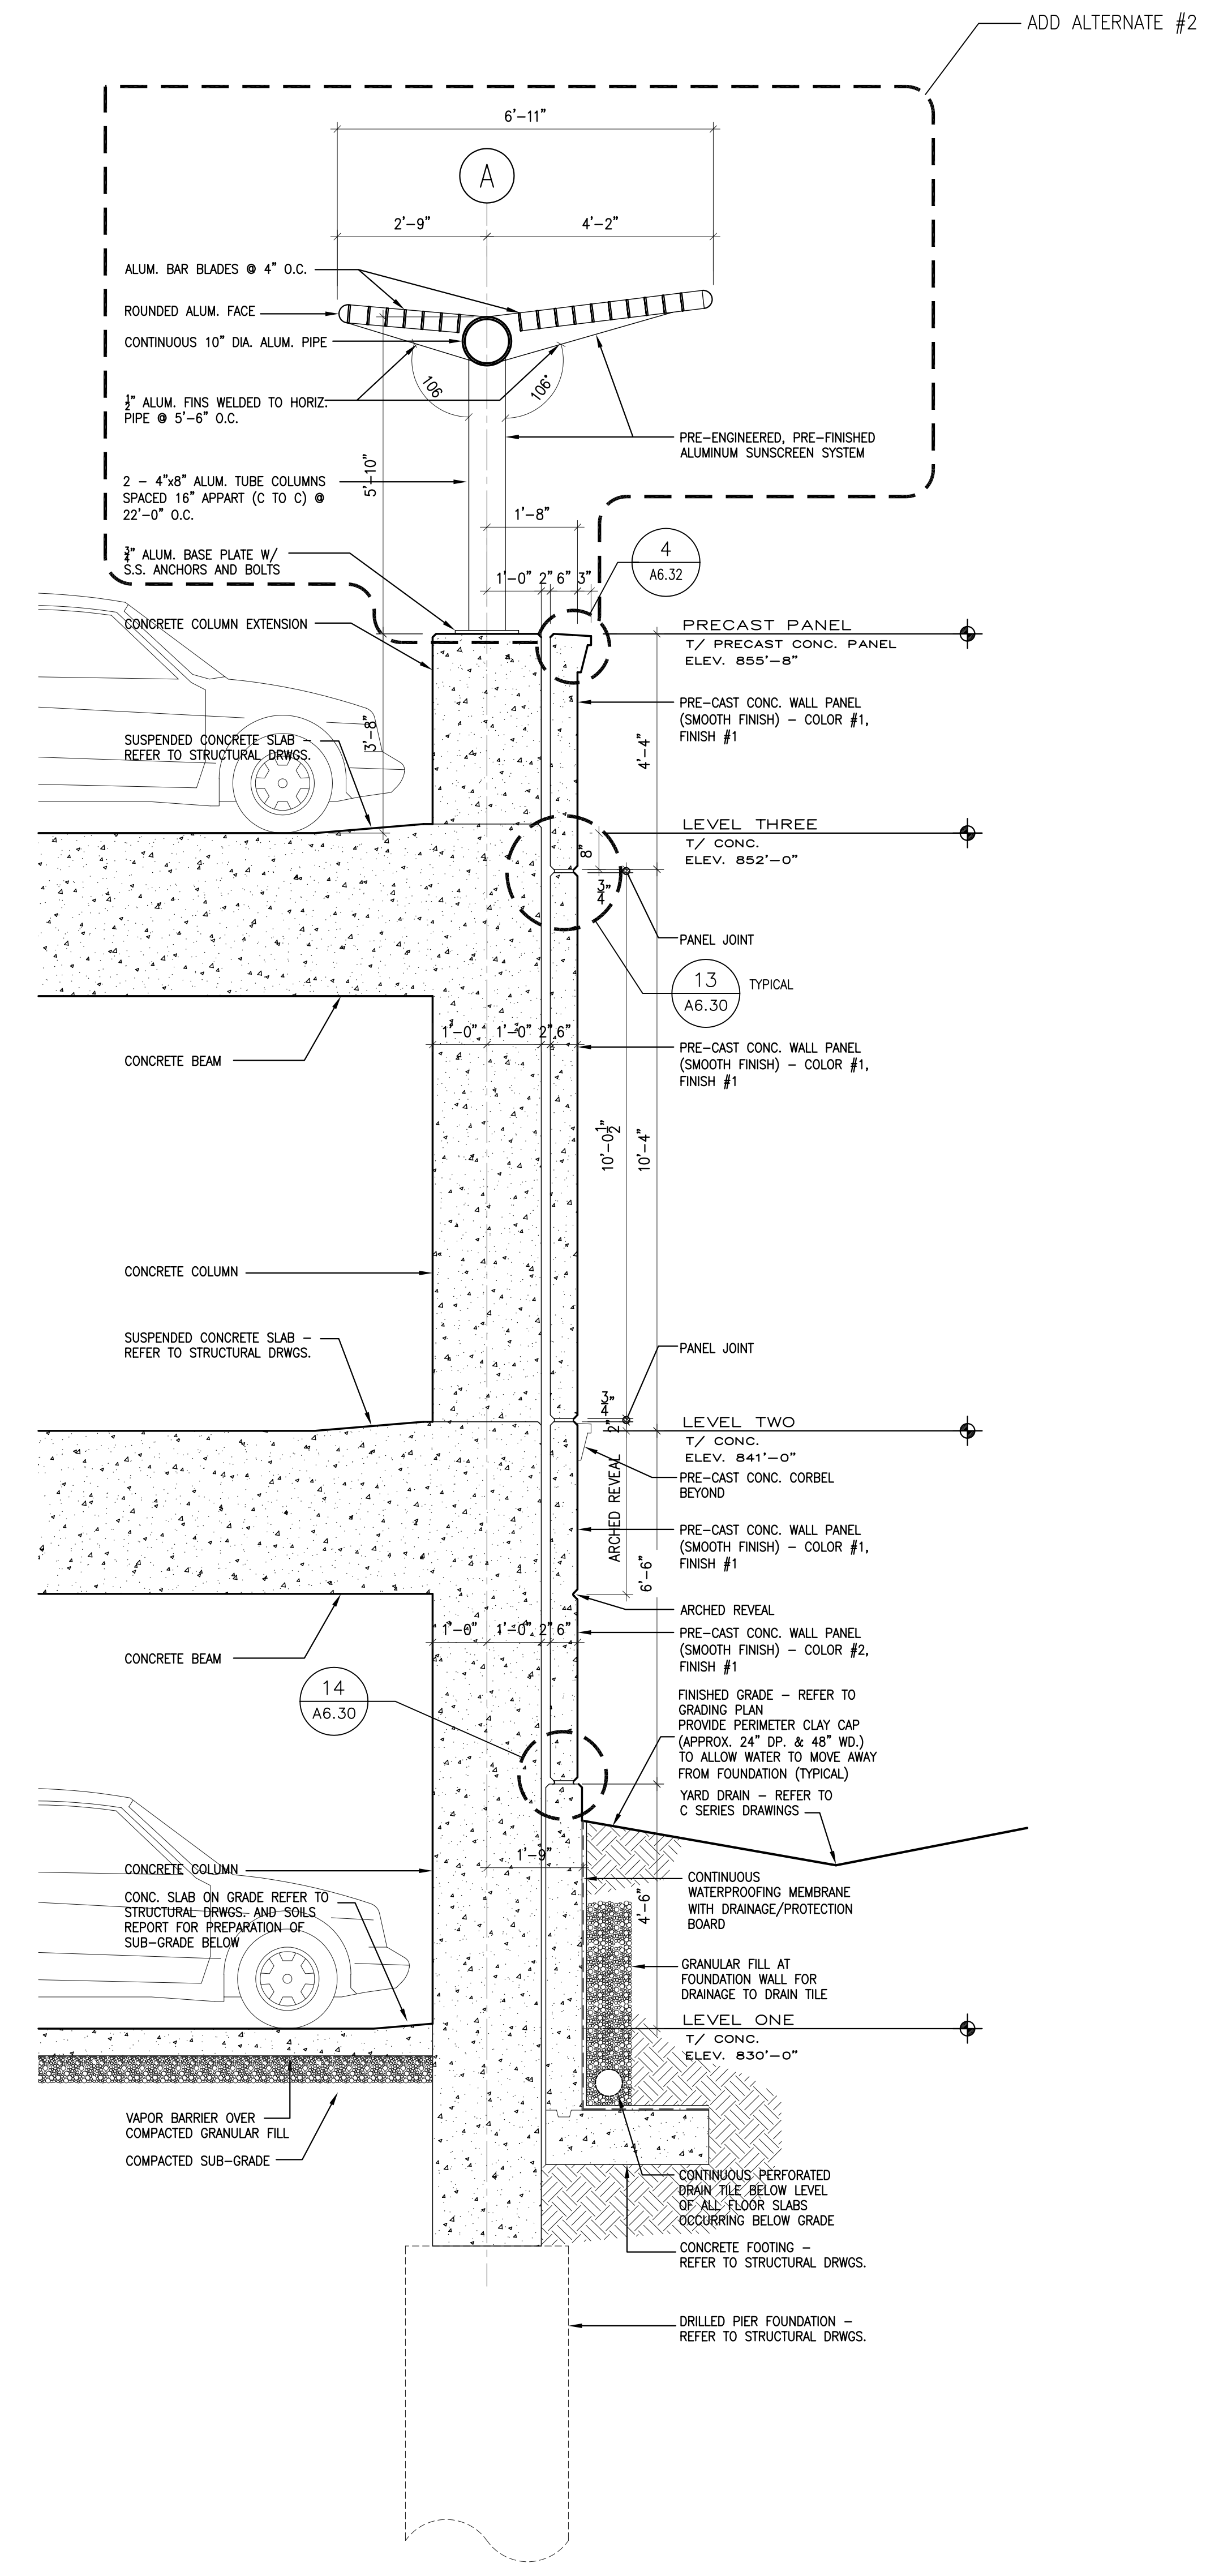


J:\17\2880-00 Parking Garage\chase\Drawings\A4-24.dwg Jun 05, 2006 - 14:59m - (C) Champlin/Haupt - .ppt

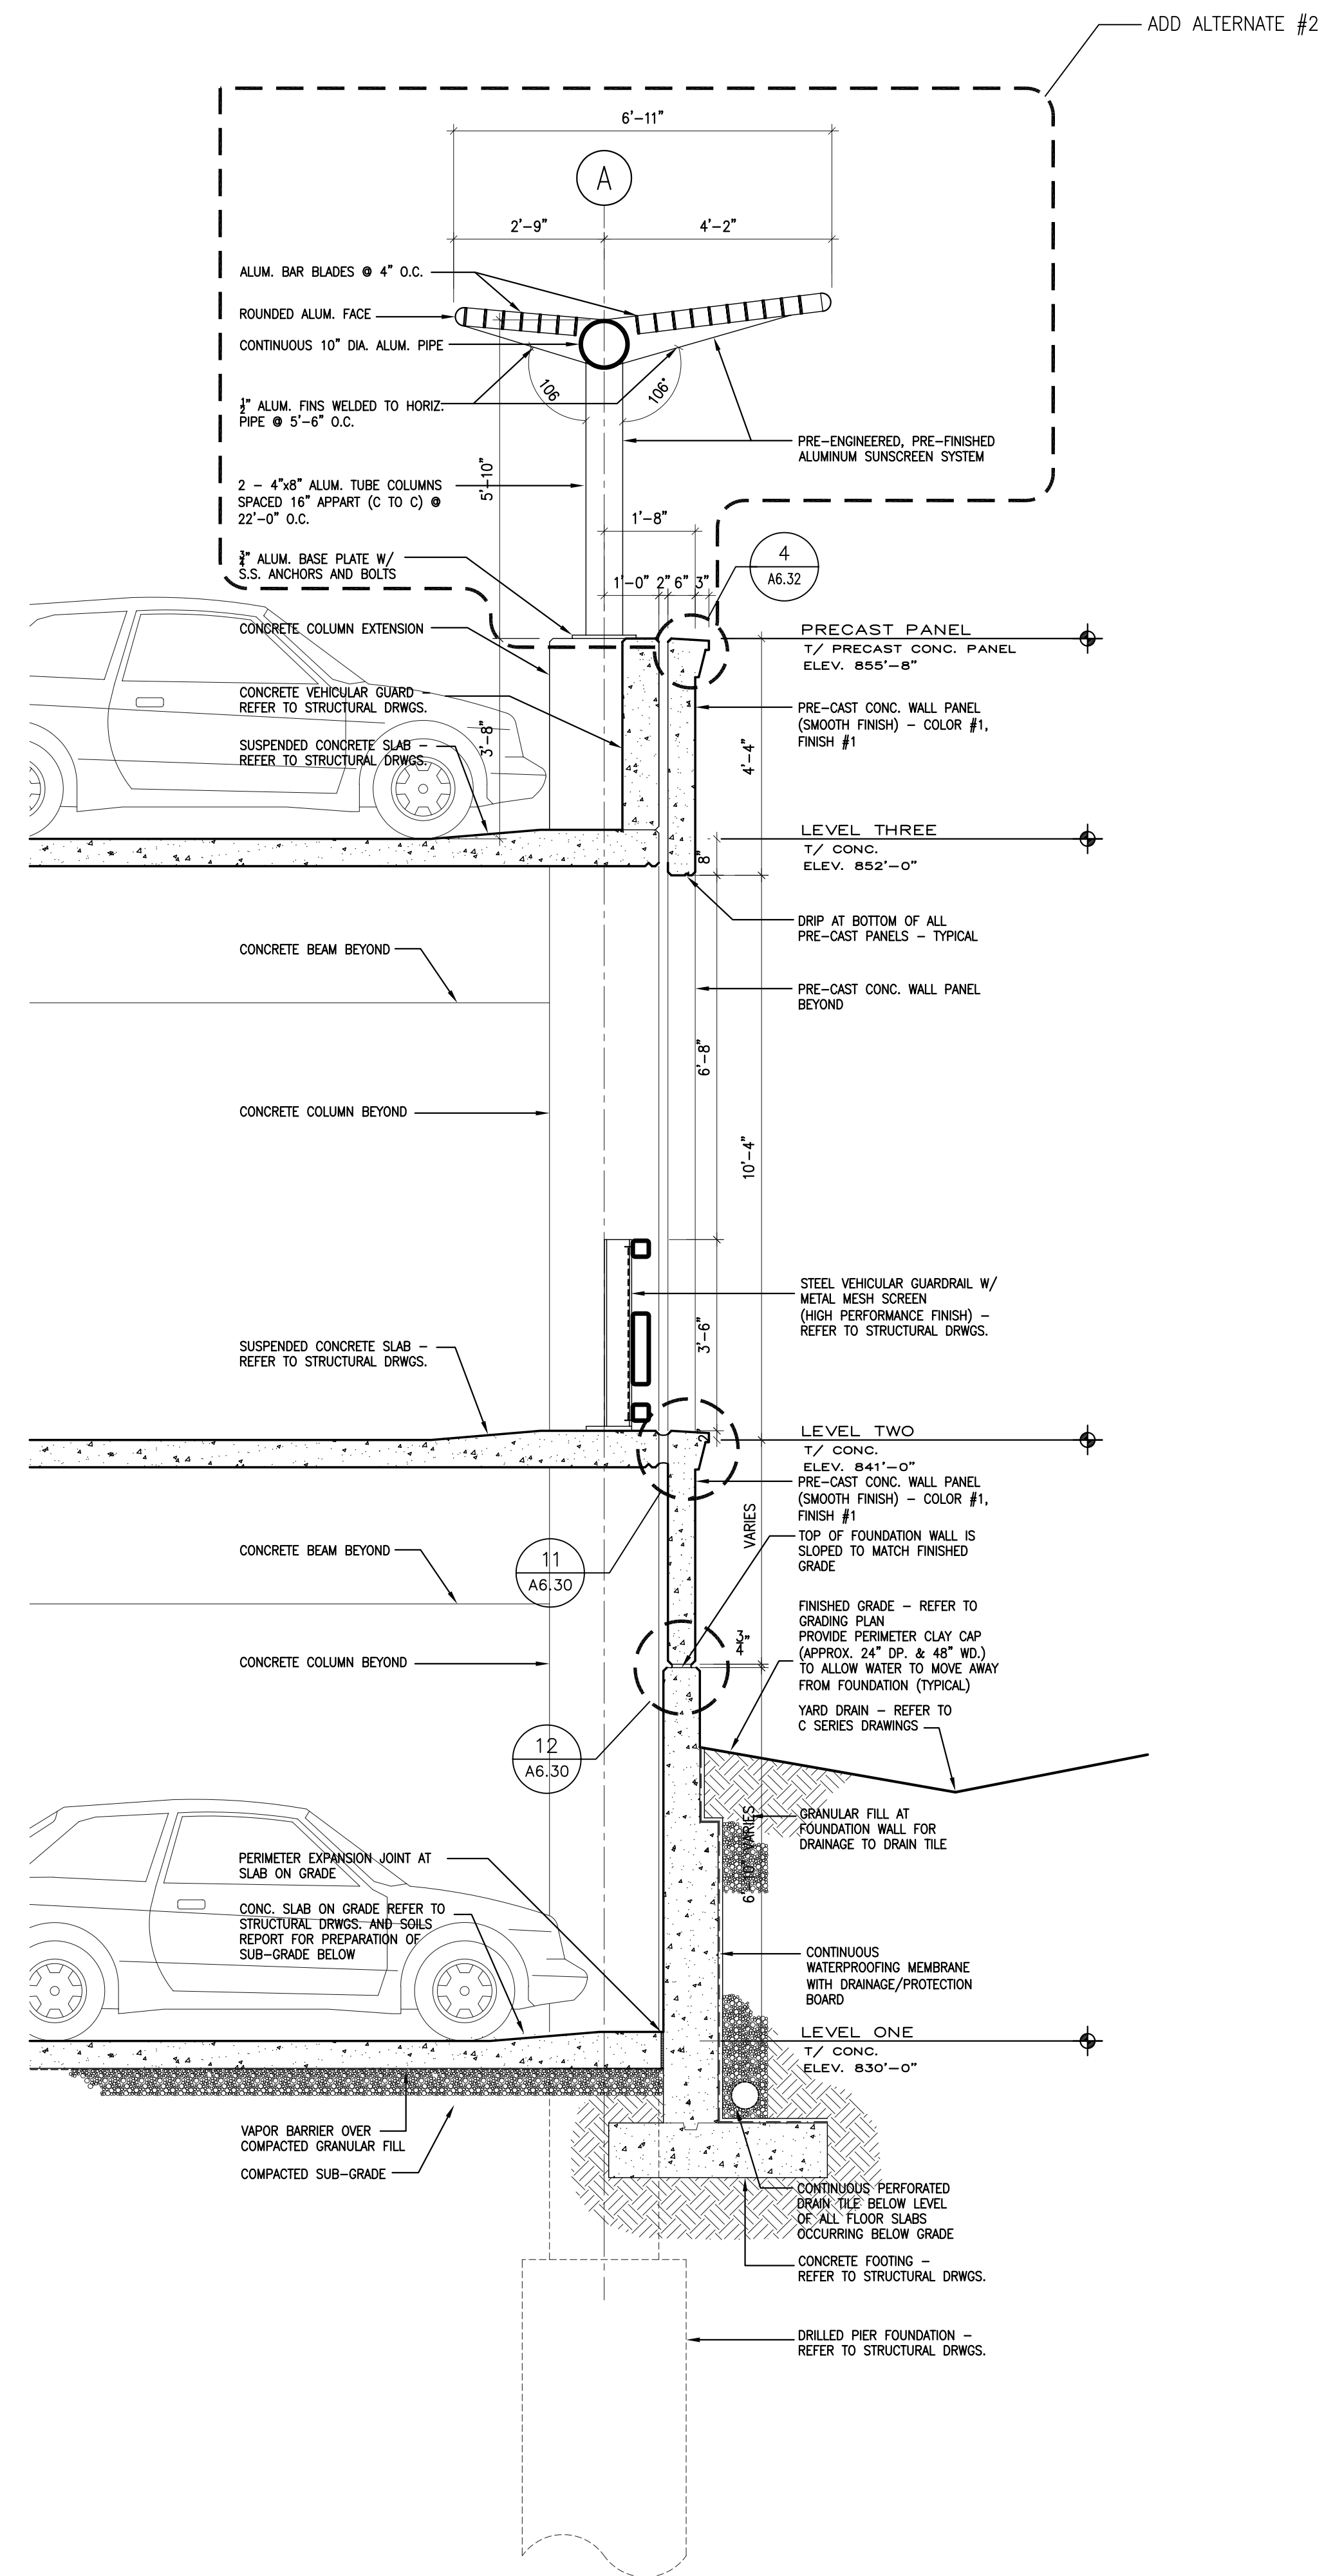

NOT USED

2
A4.24 WALL SECTION

1/2" = 1'-0"

1 A4.24		WALL SECTION		1/2" = 1'-0"	
BID PACKAGE ISSUED BID PACKAGE ISSUED		RECORD DATE DRAWN BY CHECKED BY A&E FILE NO. SCALE DATE		PARKING GARAGE No. 2 NORTHERN KENTUCKY UNIVERSITY HIGHLAND HEIGHTS, KENTUCKY WALL SECTIONS COMMONWEALTH OF KENTUCKY FINANCE AND ADMINISTRATION CABINET DEPARTMENT FOR FACILITIES MANAGEMENT DIVISION OF ENGINEERING FRANKFORT, KENTUCKY CHAMPLIN/HAUPT INC. ARCHITECTS 202 Farmington Drive, Ste. 101 Louisville, KY 40117 Tel: (502) 331-5900 Fax: (502) 331-5999	
REVISIONS 1 RECORD DRAWINGS 6/20/05 2 3 4 5 6 7 8		DRAWING NO. A4.24 REVIEWED DIV. OF ENGR. ENGR. FILE NO. PNK100590		AGENCY AUTHORIZED AGENT APPROVED FOR PROGRAM CONCEPT ONLY DATE DIVISION OF ENGINEERING APPROVED FOR PROGRAM CONCEPT ONLY DATE	

