




LEVEL 3 WEST ELEV.

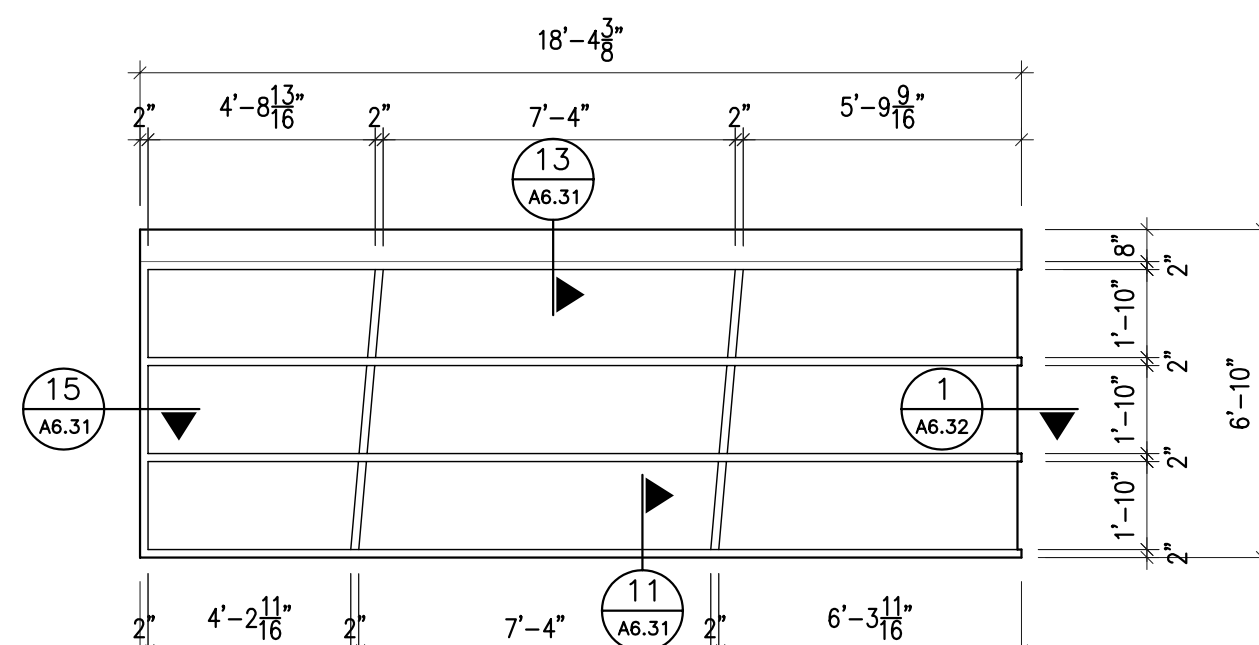


LEVEL 3 NORTH ELEV.

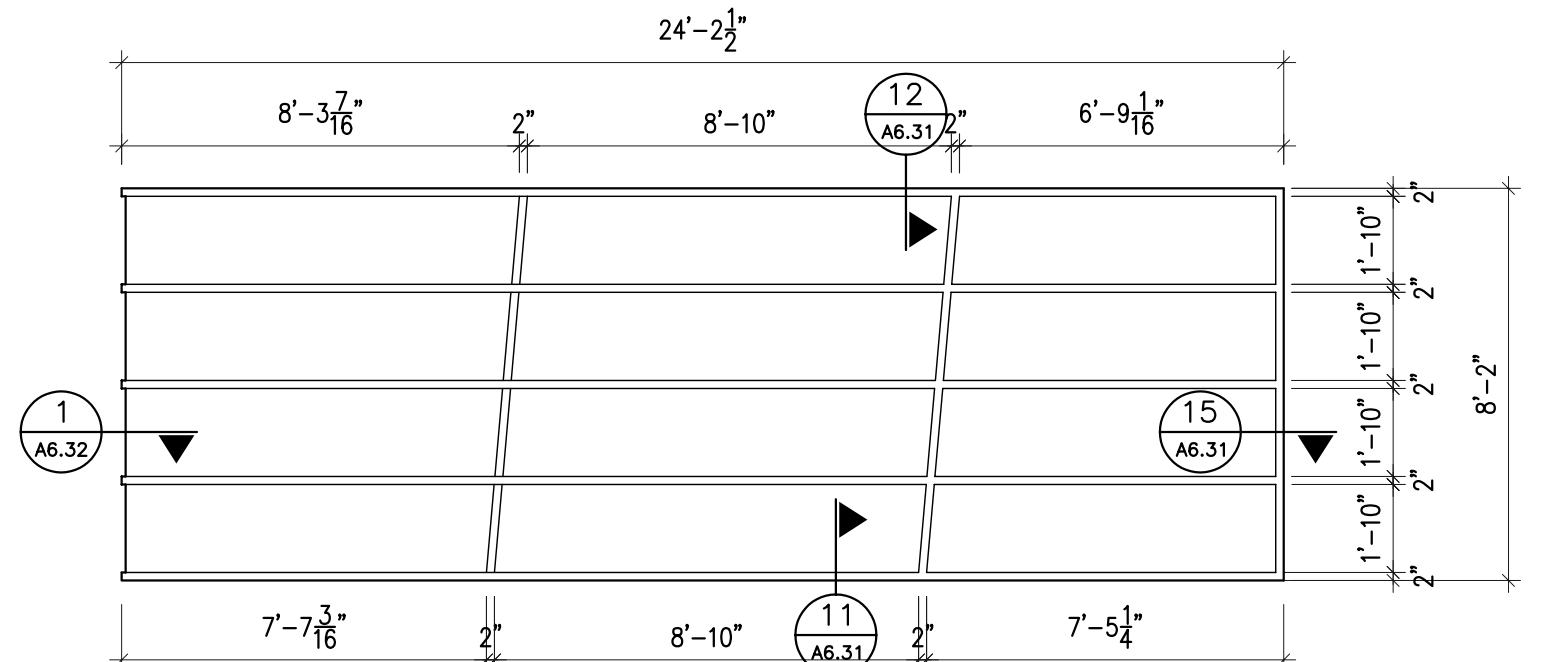


LEVEL 2 WEST ELEV.

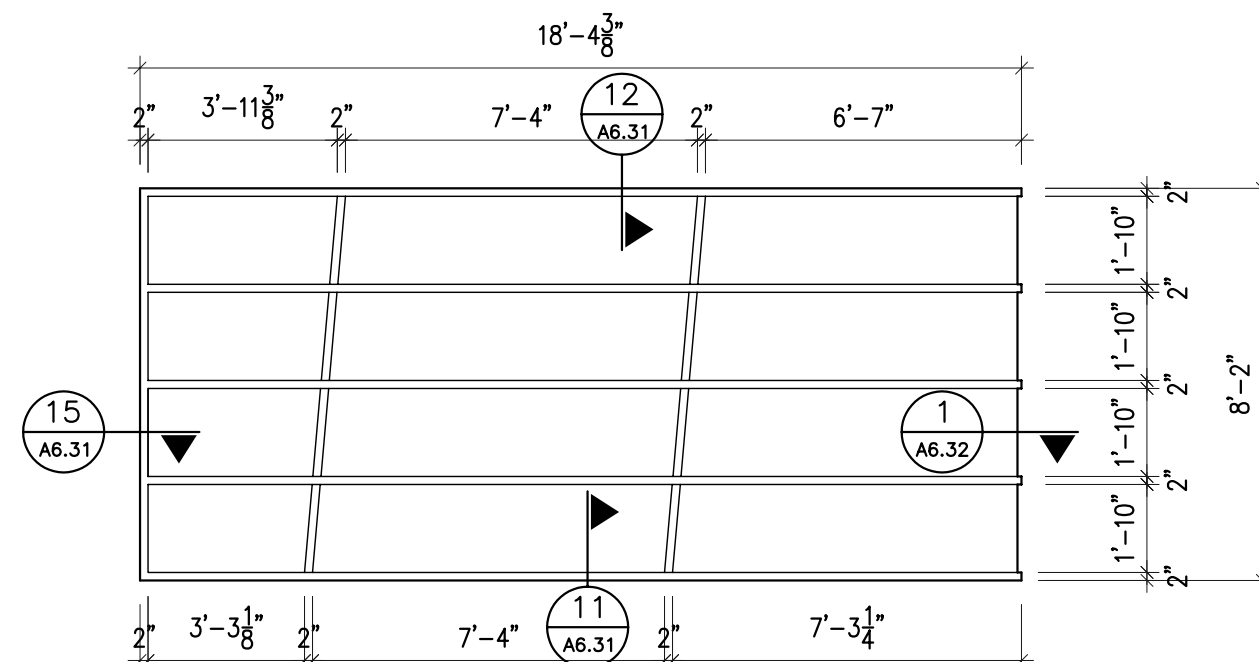

LEVEL 2 NORTH ELEV.

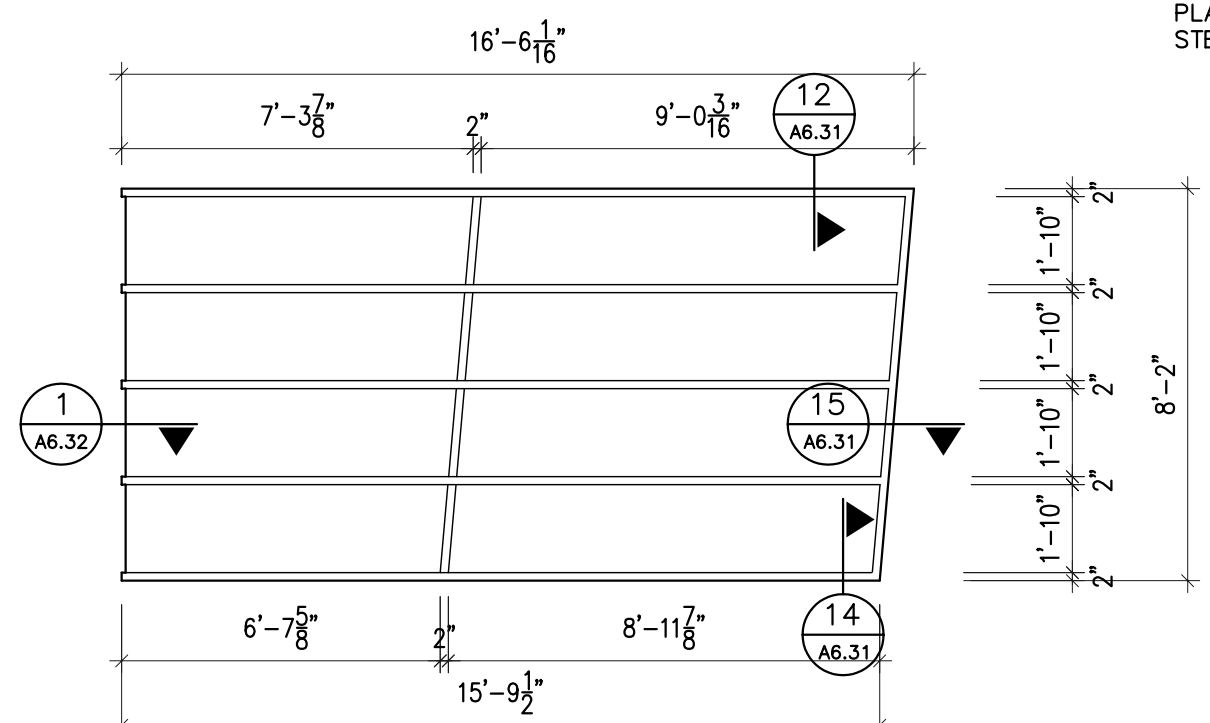


LEVEL 1 WEST ELEV.

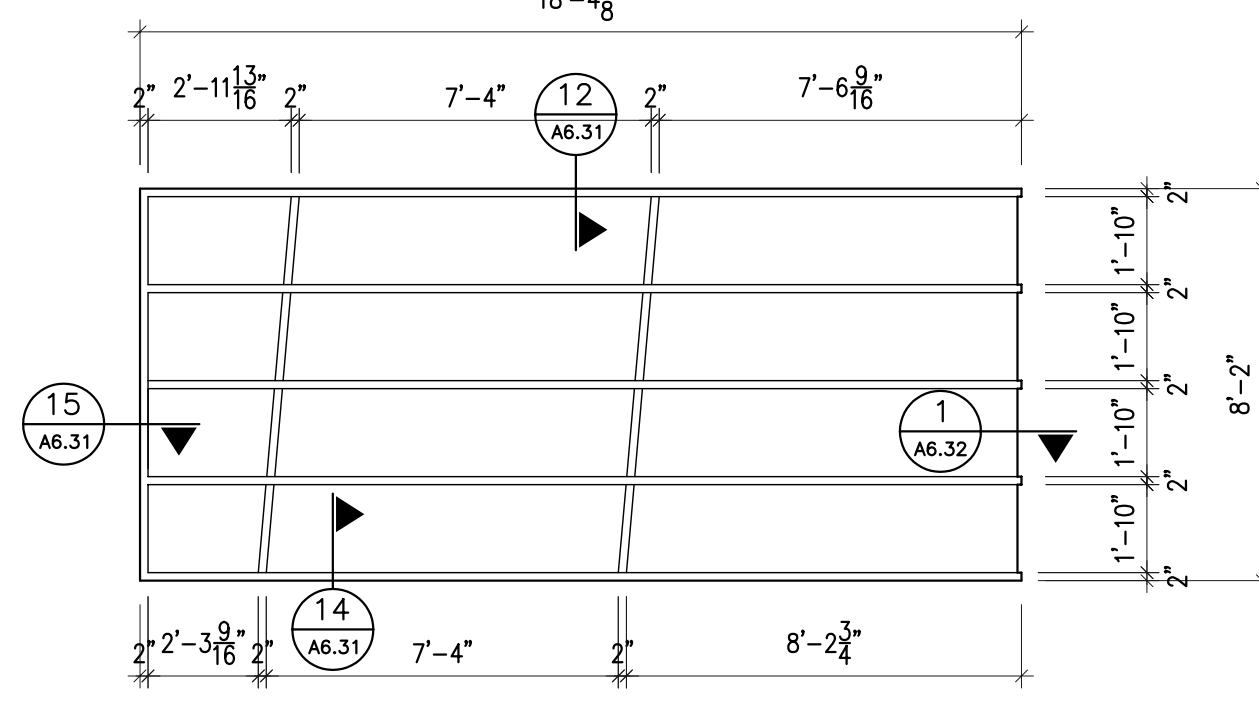


LEVEL 1 NORTH ELEV.


NOTE: CURTAINWALL SYSTEM ANCHORED TO PRE-CAST CONCRETE PANELS. CURTAINWALL MANUFACTURER TO COORDINATE ANCHOR LOCATIONS WITH PRECASTER. ALL ANCHOR PLATES AND HARDWARE TO BE STAINLESS STEEL.

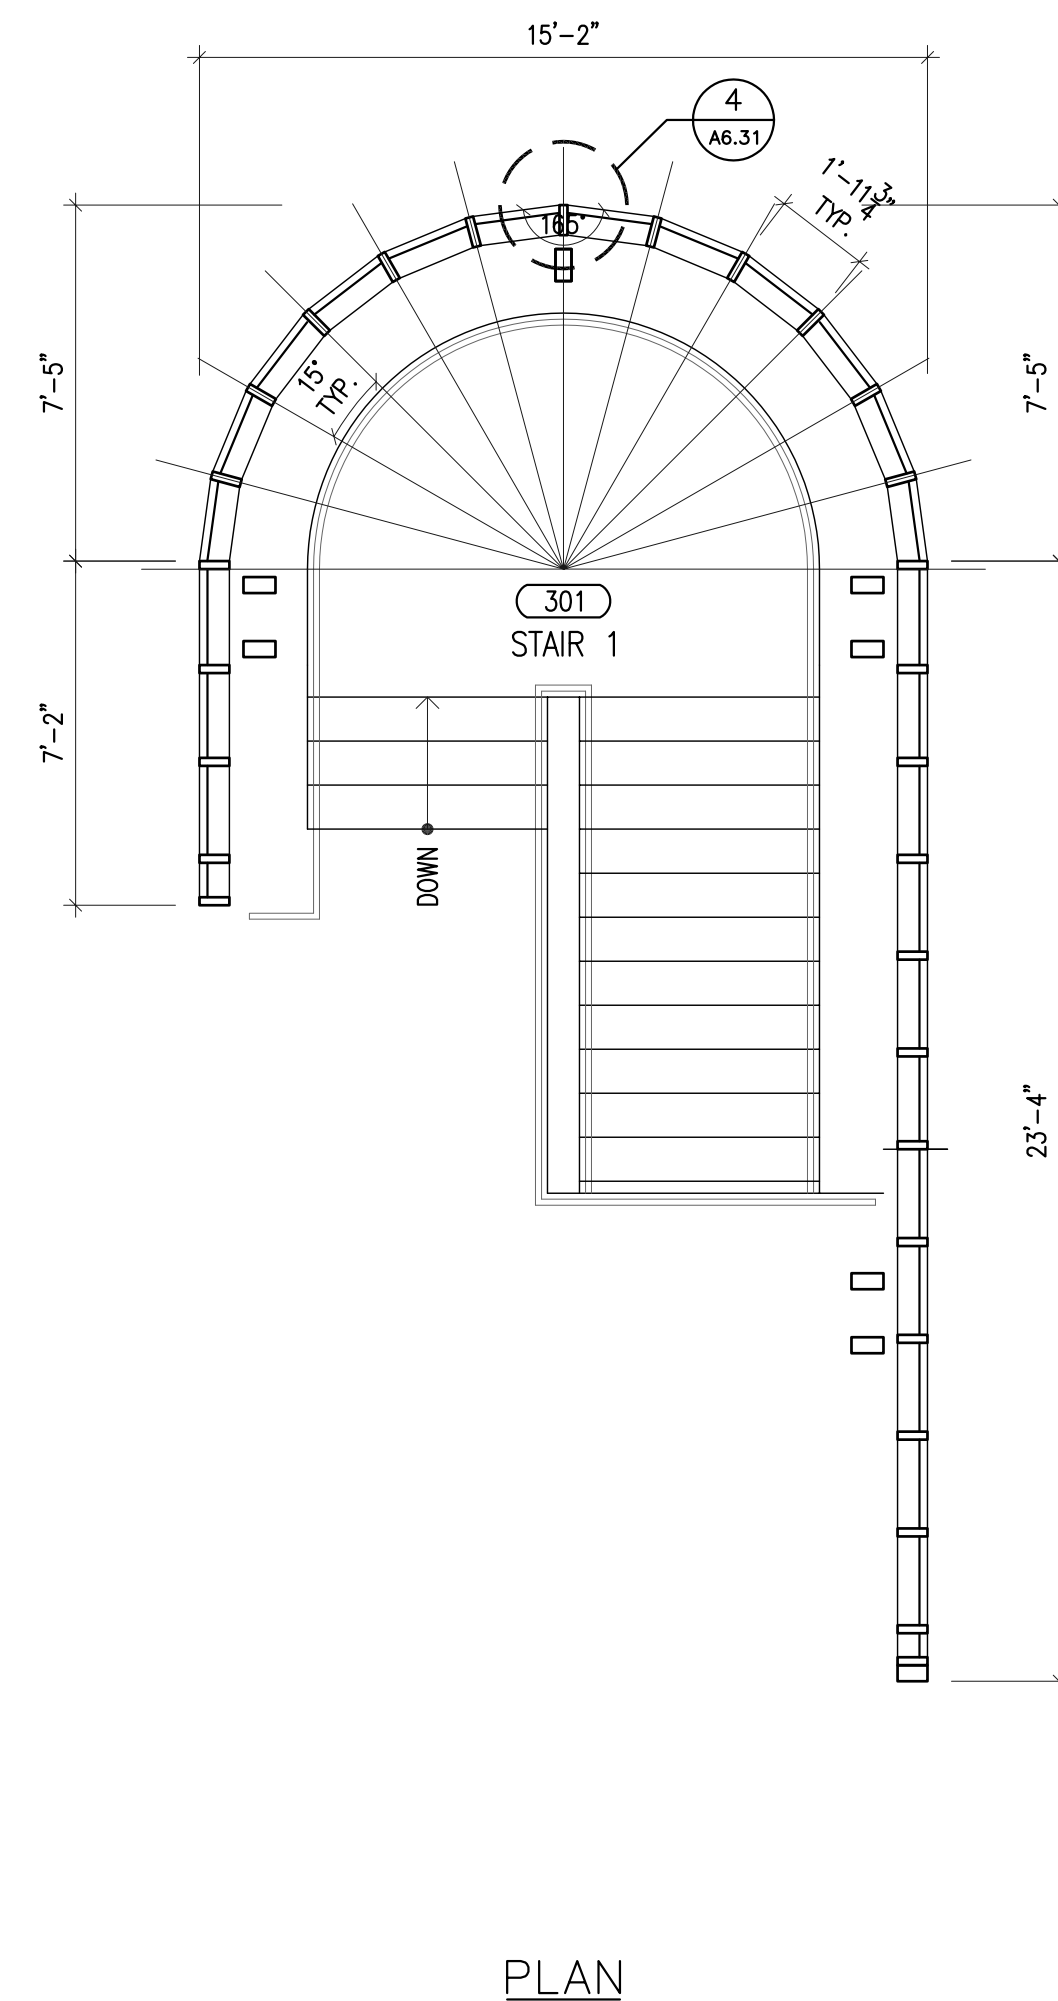


PLAN

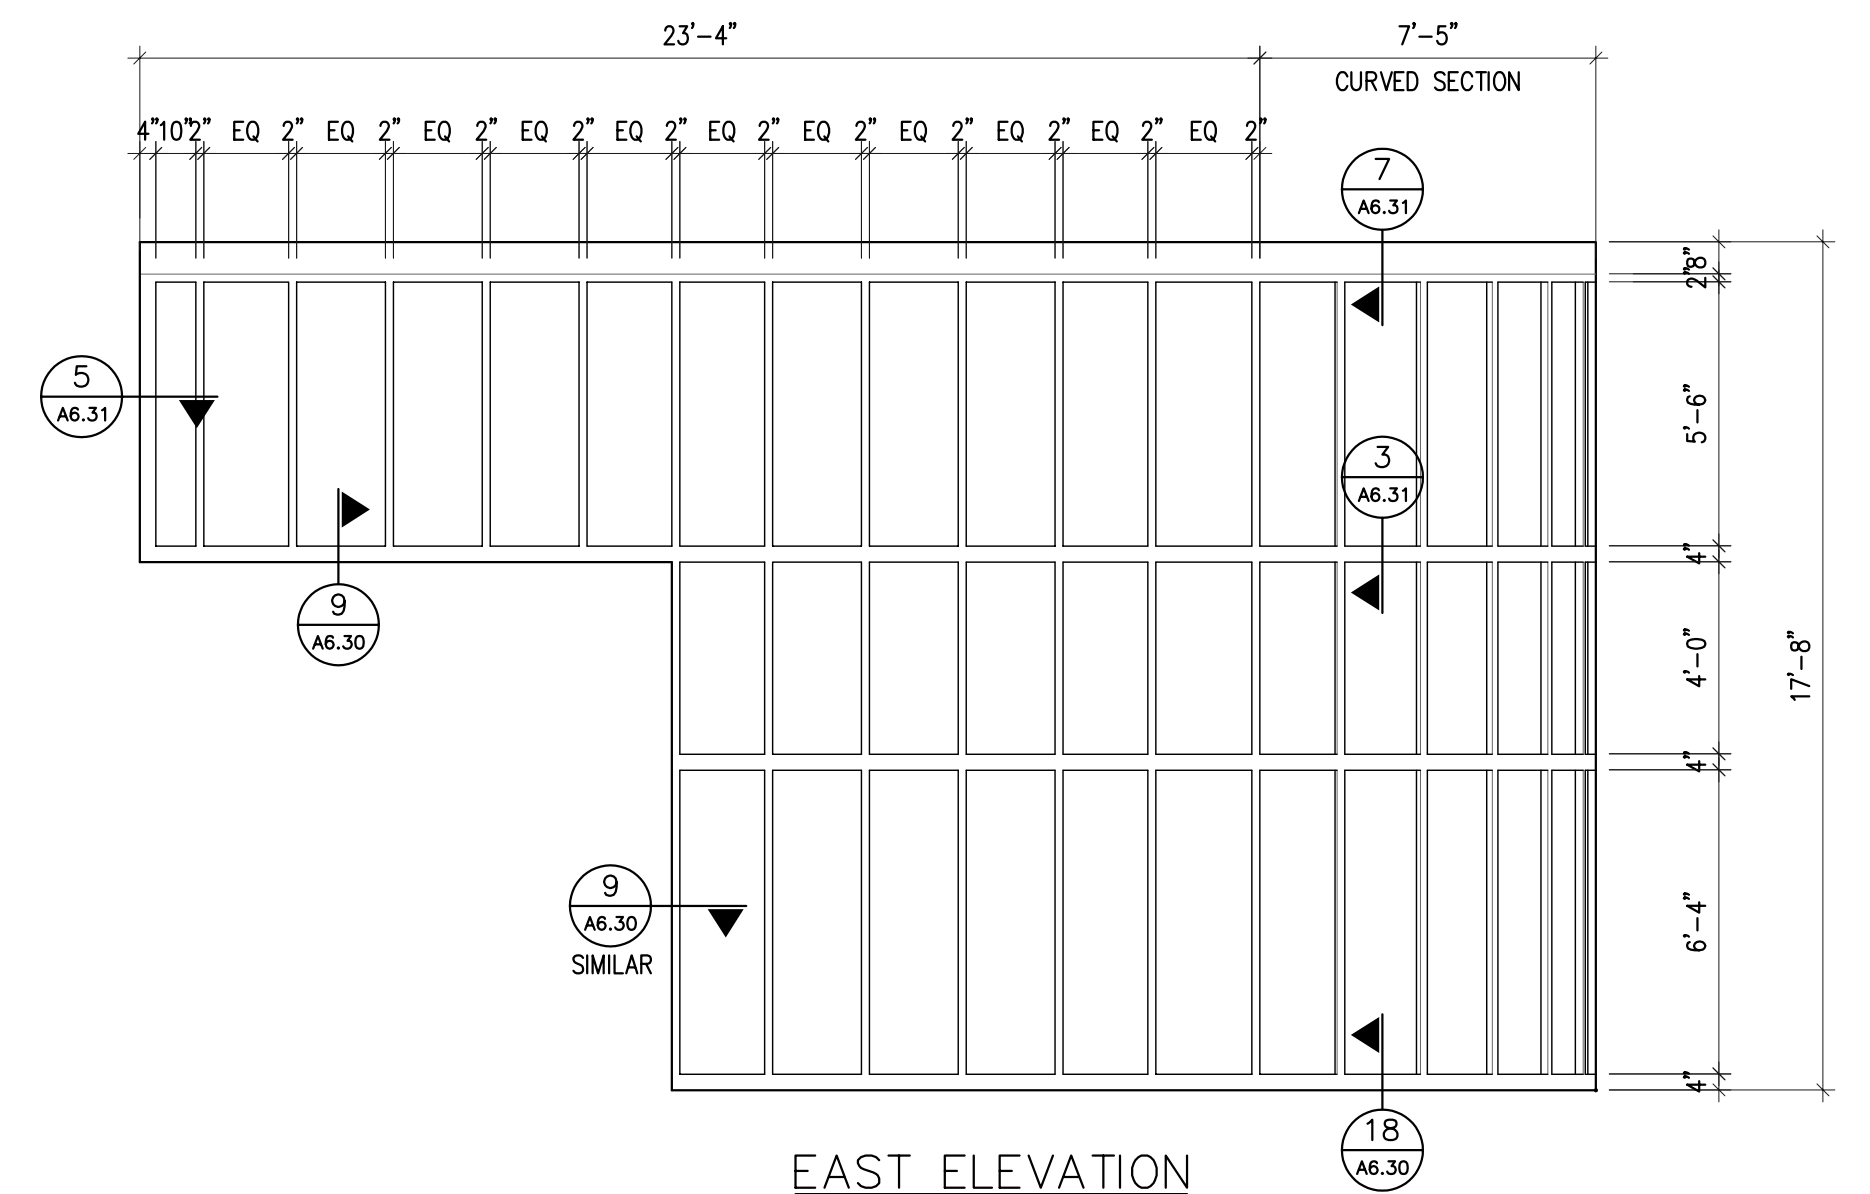

EAST ELEVATION

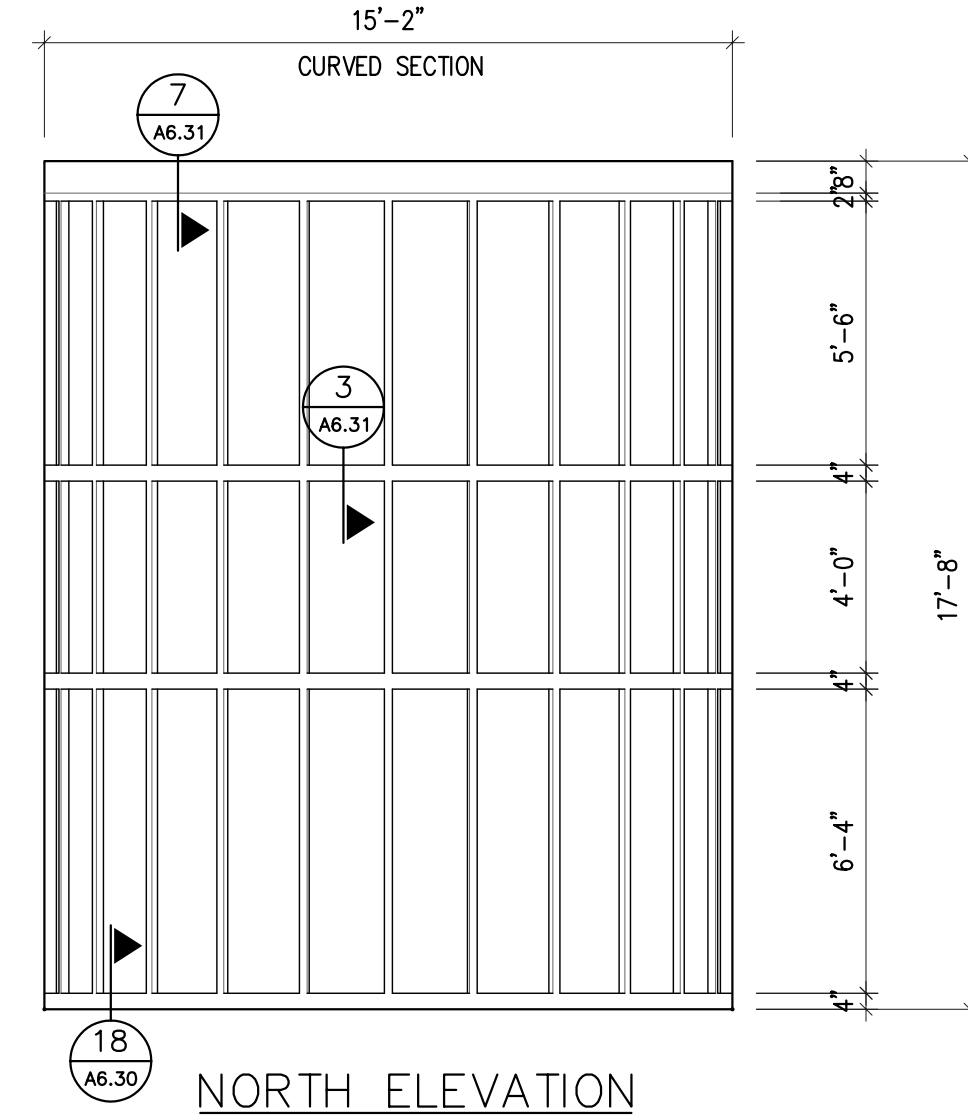

NORTH ELEVATION

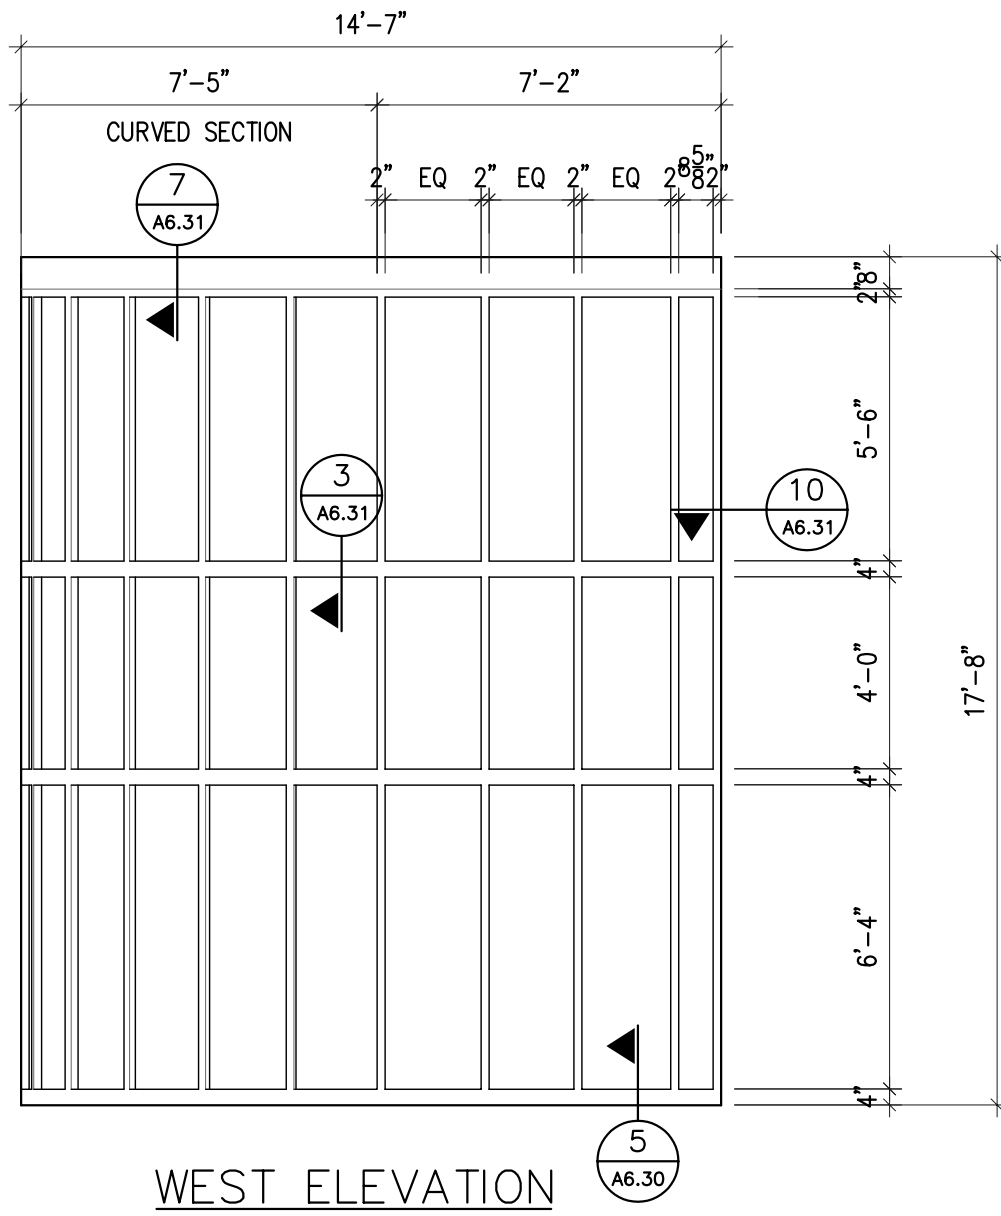


WEST ELEVATION

2 CURTAINWALL ELEVATIONS - STAIR #3


1/4" = 1'-0"

1 CURTAINWALL ELEVATIONS - STAIR #1


1/4" = 1'-0"

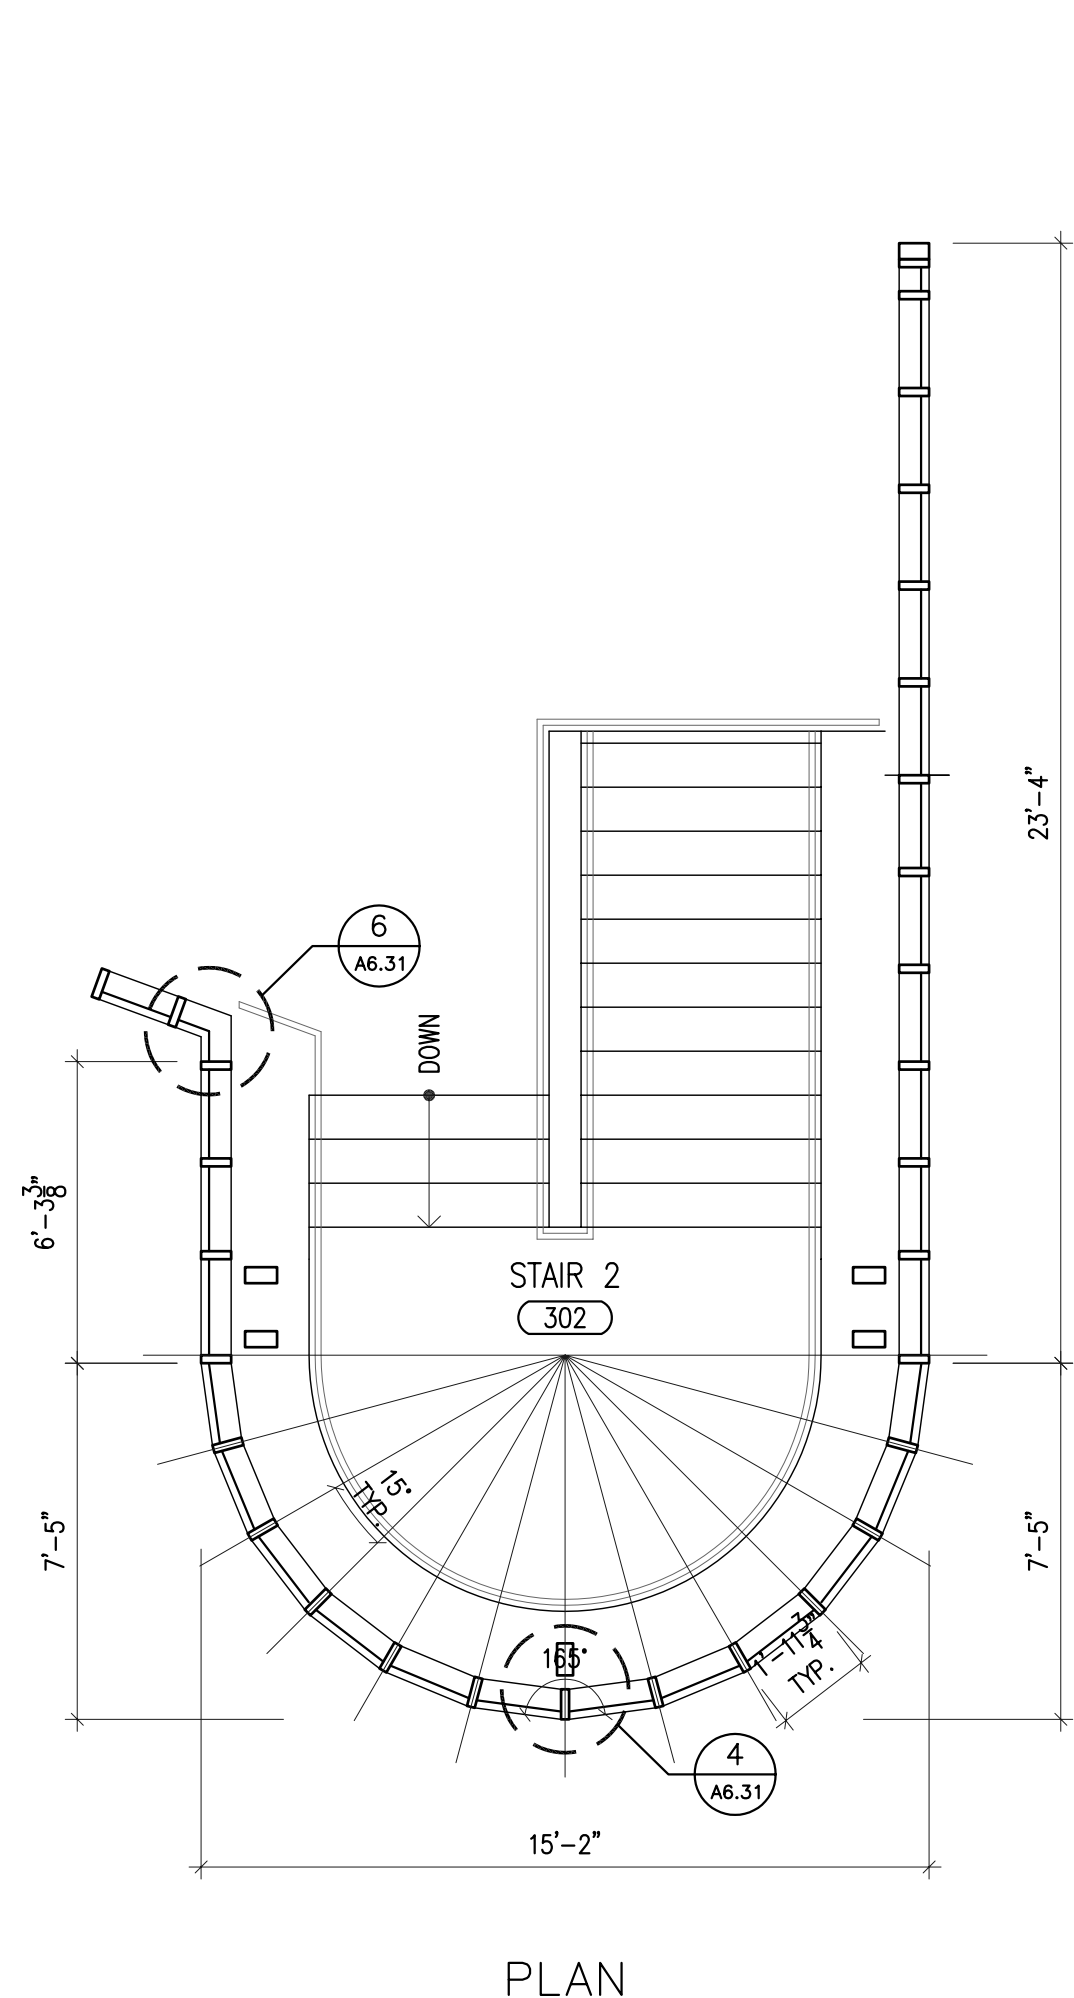


PLAN

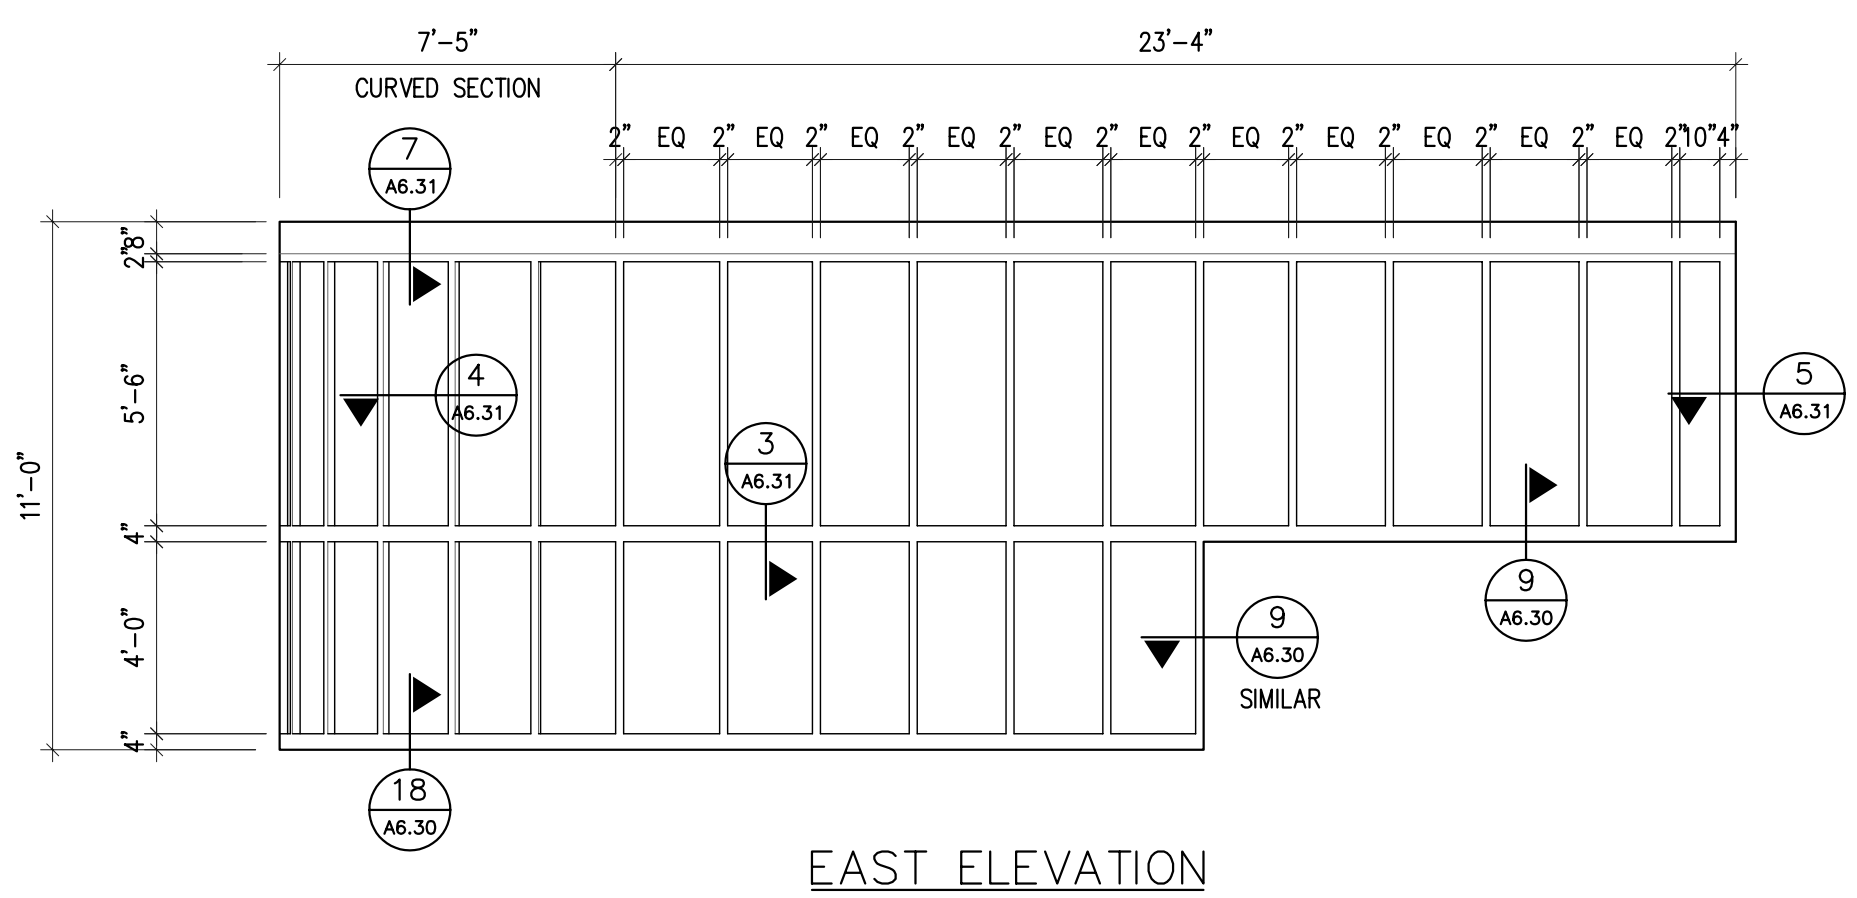


EAST ELEVATION

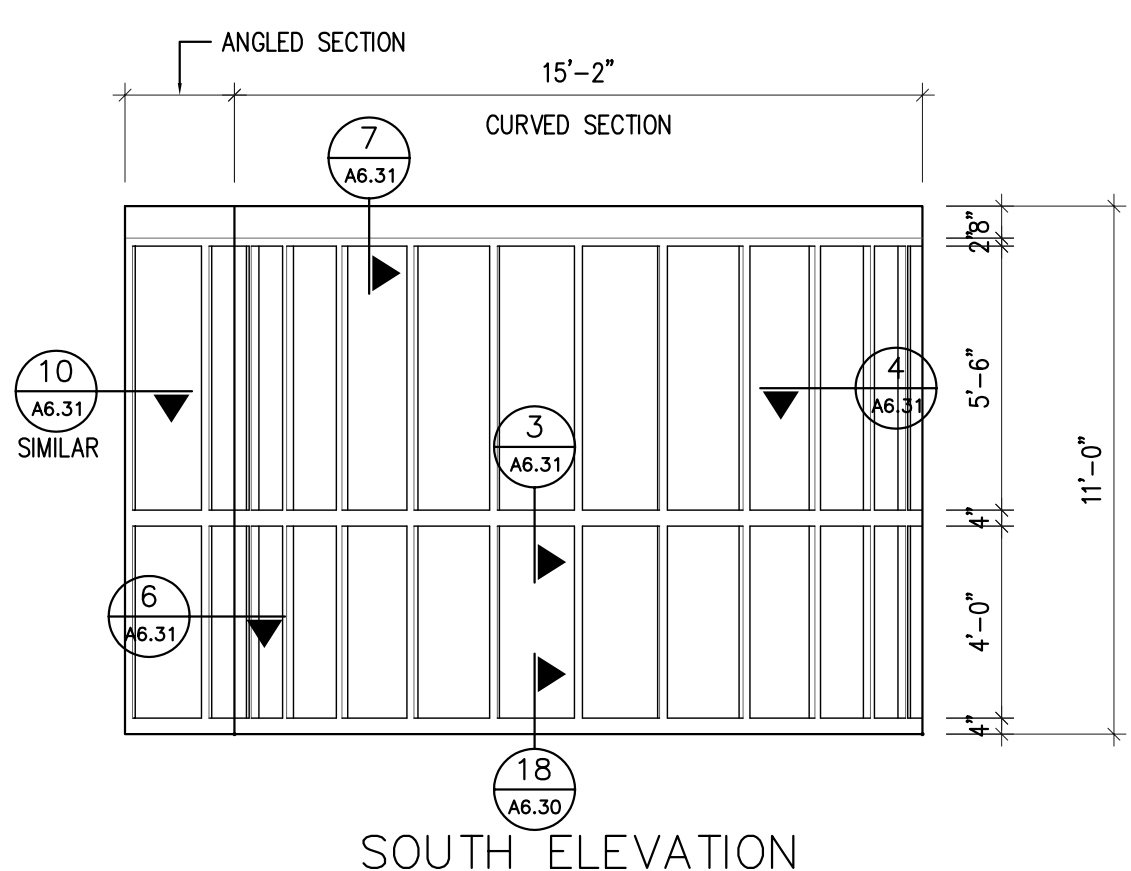

SOUTH ELEVATION

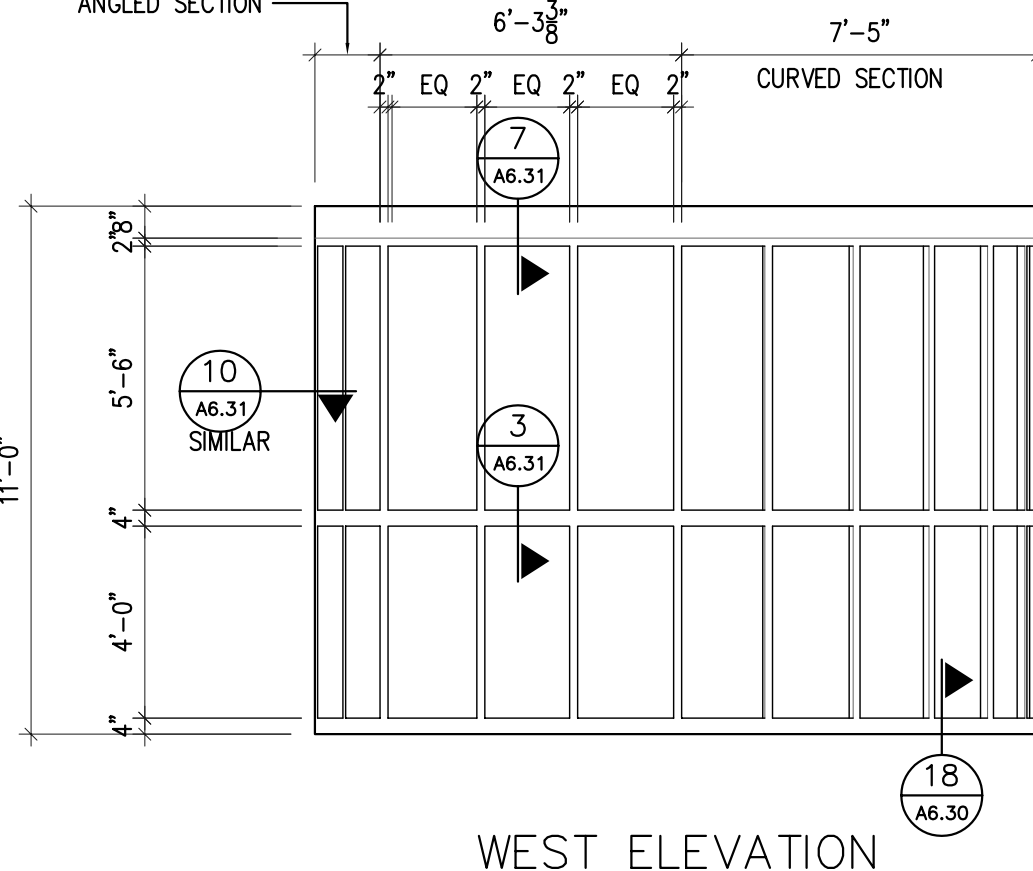

WEST ELEVATION

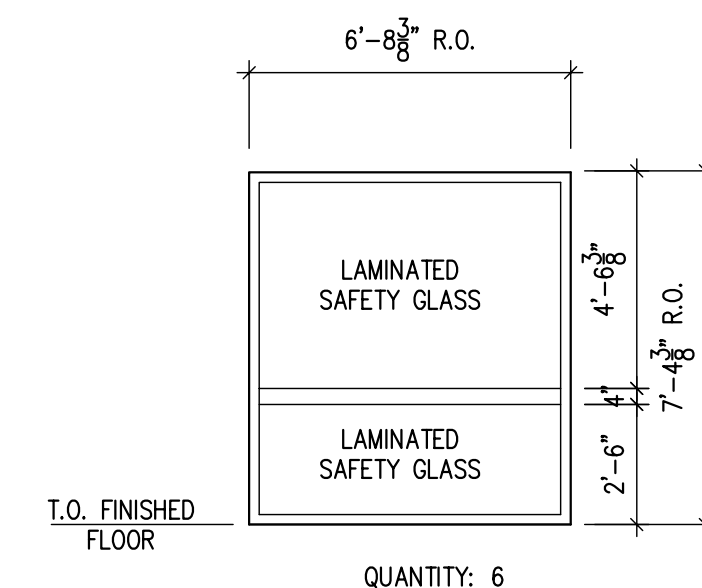


QUANTITY: 6

4 CURTAINWALL ELEVATION - ELEVATOR HOISTWAY 1/4" = 1'-0"

3 CURTAINWALL ELEVATIONS - STAIR #2

1/4" = 1'-0"

BID PACKAGE ISSUED		BID PACKAGE ISSUED		RECORD DATE	DRAWING NO.
COMMONWEALTH OF KENTUCKY FINANCE AND ADMINISTRATION CABINET DEPARTMENT FOR FACILITIES MANAGEMENT DIVISION OF ENGINEERING FRANKFORT, KENTUCKY					
CURTAINWALL ELEVATIONS COMMONWEALTH OF KENTUCKY FINANCE AND ADMINISTRATION CABINET DEPARTMENT FOR FACILITIES MANAGEMENT DIVISION OF ENGINEERING FRANKFORT, KENTUCKY				REVIEWED DIV. OF ENGR. FOR INTENT ONLY ENGR. FILE NO. PKR10590	
A&E FILE NO. 2012-06 SCALE AS NOTED DATE 10/30/2013				Champlin/Haupt Inc. Architects 202 Farmington Drive, Ste. 101 Louisville, KY 40203 Tel: (502) 331-9999 Fax: (502) 331-9995	
REVISIONS 1 RECORD DRAWINGS 6/20/05 2 3 4 5 6 7 8				AGENCY AUTHORIZED AGENT APPROVED FOR PROGRAM CONCEPT ONLY DATE DIVISION OF ENGINEERING APPROVED FOR PROGRAM CONCEPT ONLY DATE	

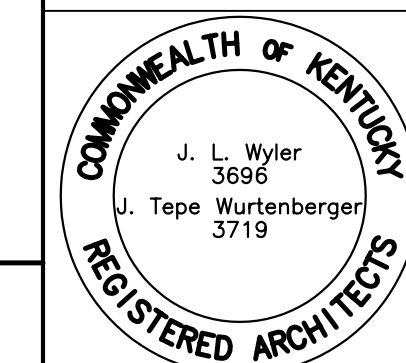

J:\17\2880-00 parking garage\phase 0\Drawings\A6-10 & A6-11.dwg Jan 05, 2006-15:54pm (C) Champlin/Haupt - gpc