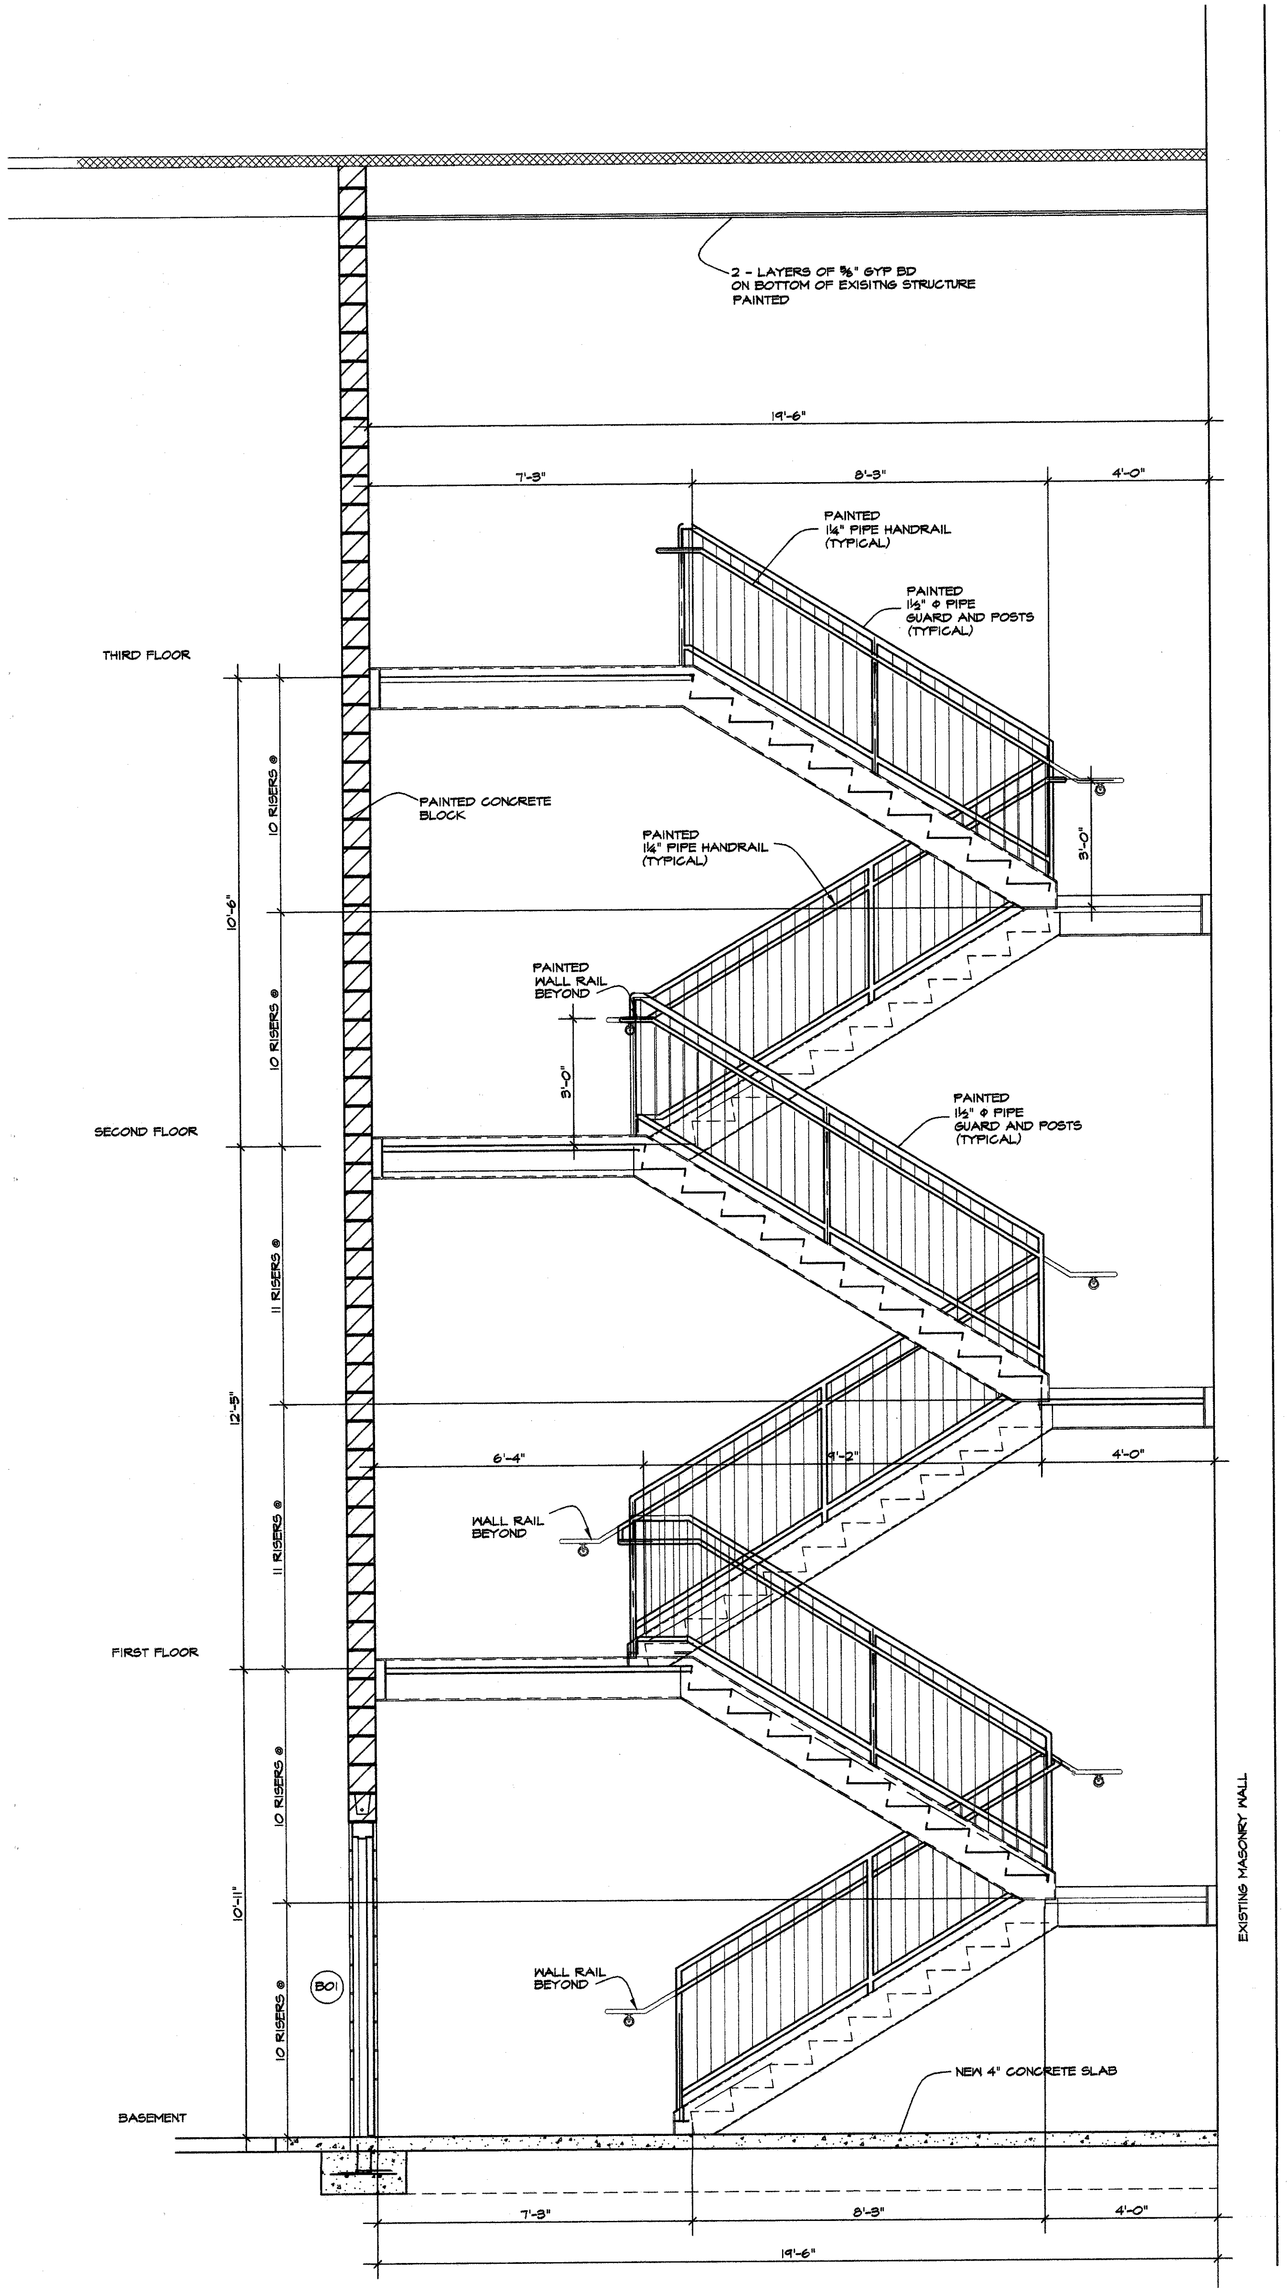

STAIR SECTION - STAIR #1 (A)

SCALE: ½" - 1'-0"

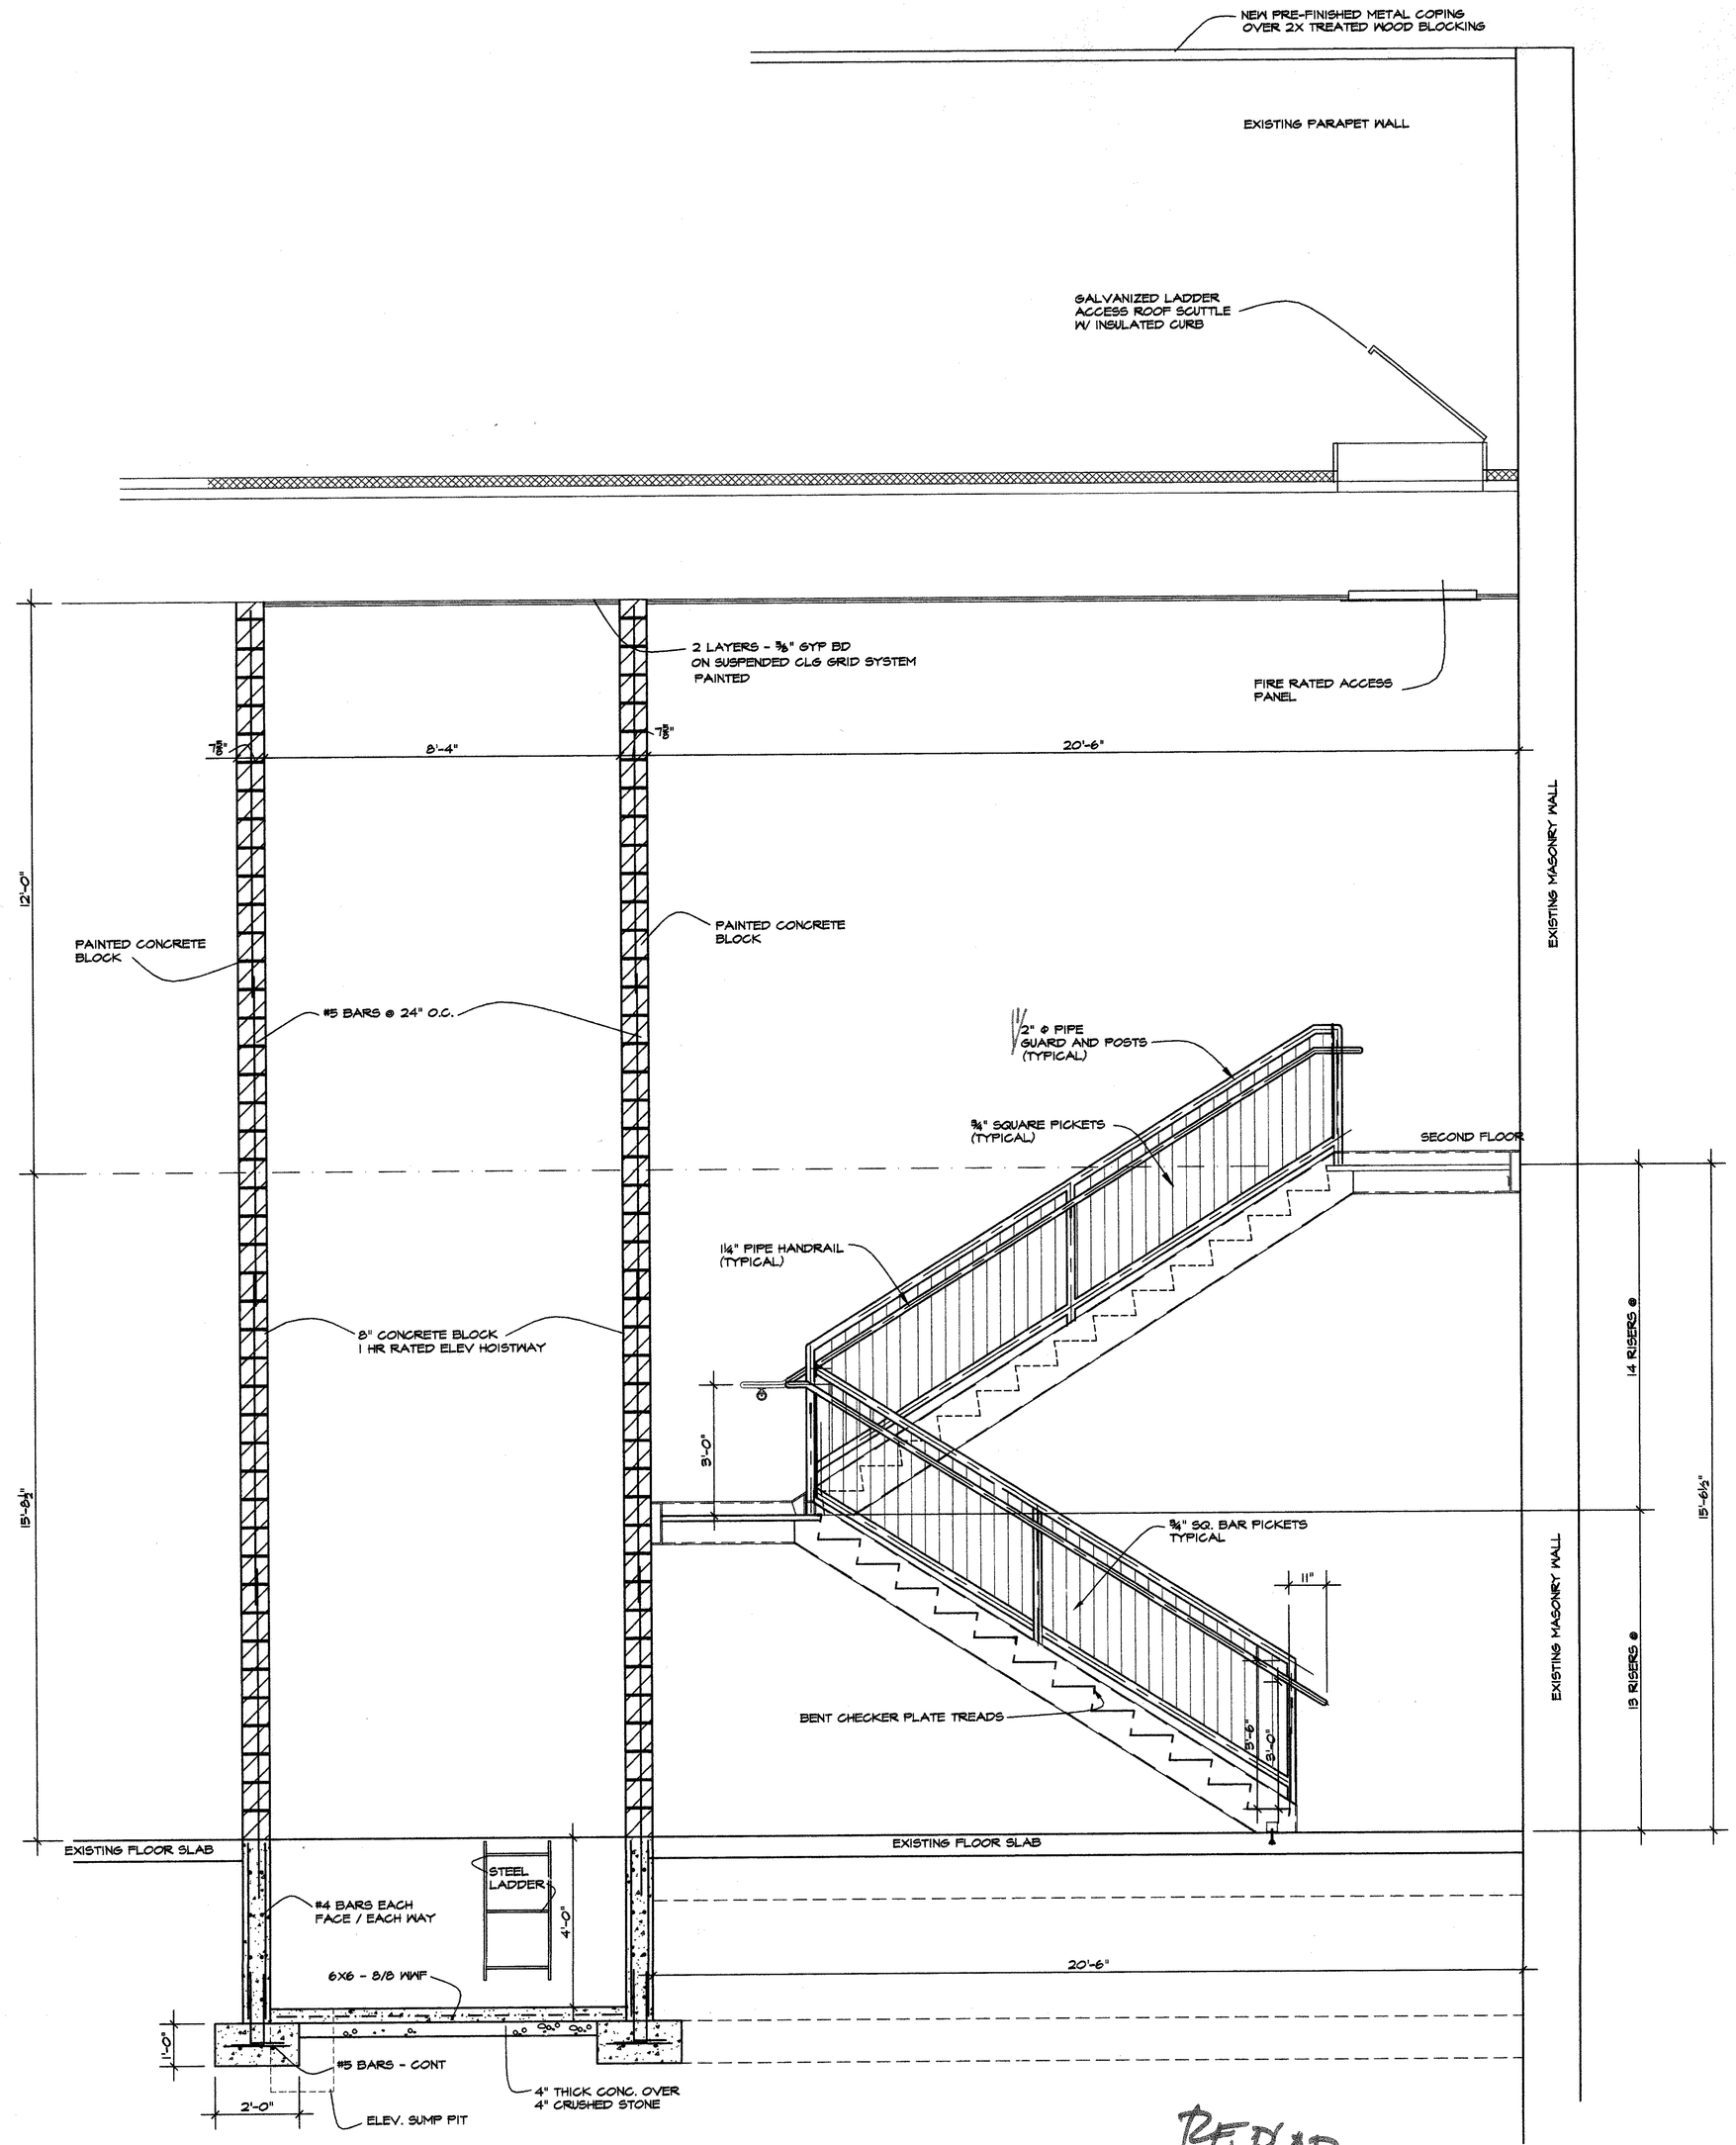

STAIR SECTION - STAIR #2 (B)

SCALE: ½" - 1'-0"

REPLOT.
ADD STAIR #2 REVISIONS SHEET.

MICHAEL L. KNOLL
REGISTERED ARCHITECT
COMMONWEALTH OF KENTUCKY

MICHAEL L KNOLL
ARCHITECT
Phone: 859-873-1900
349 South Main Street
Versailles, Kentucky 40383

HERRICK & ASSOCIATES
Consulting Engineers
859 271 0483
LEXINGTON KY
DESIGN-ENGINEERING
601 BROOKFARM COURT
LEXINGTON, KY 40517
O. DAVID PRESTON, P.E.

The McGoodwin Company
Commercial Real Estate

PROJECT:
LEXINGTON LOFTS
200 BOLIVAR STREET
LEXINGTON, KENTUCKY

DRAWING:
STAIR SECTIONS

DATE: 9/05/02
DRAWN BY: MLK
REVISIONS:
10/1/02
1/10/03

HUD Project No.

SHEET NO.
A-11