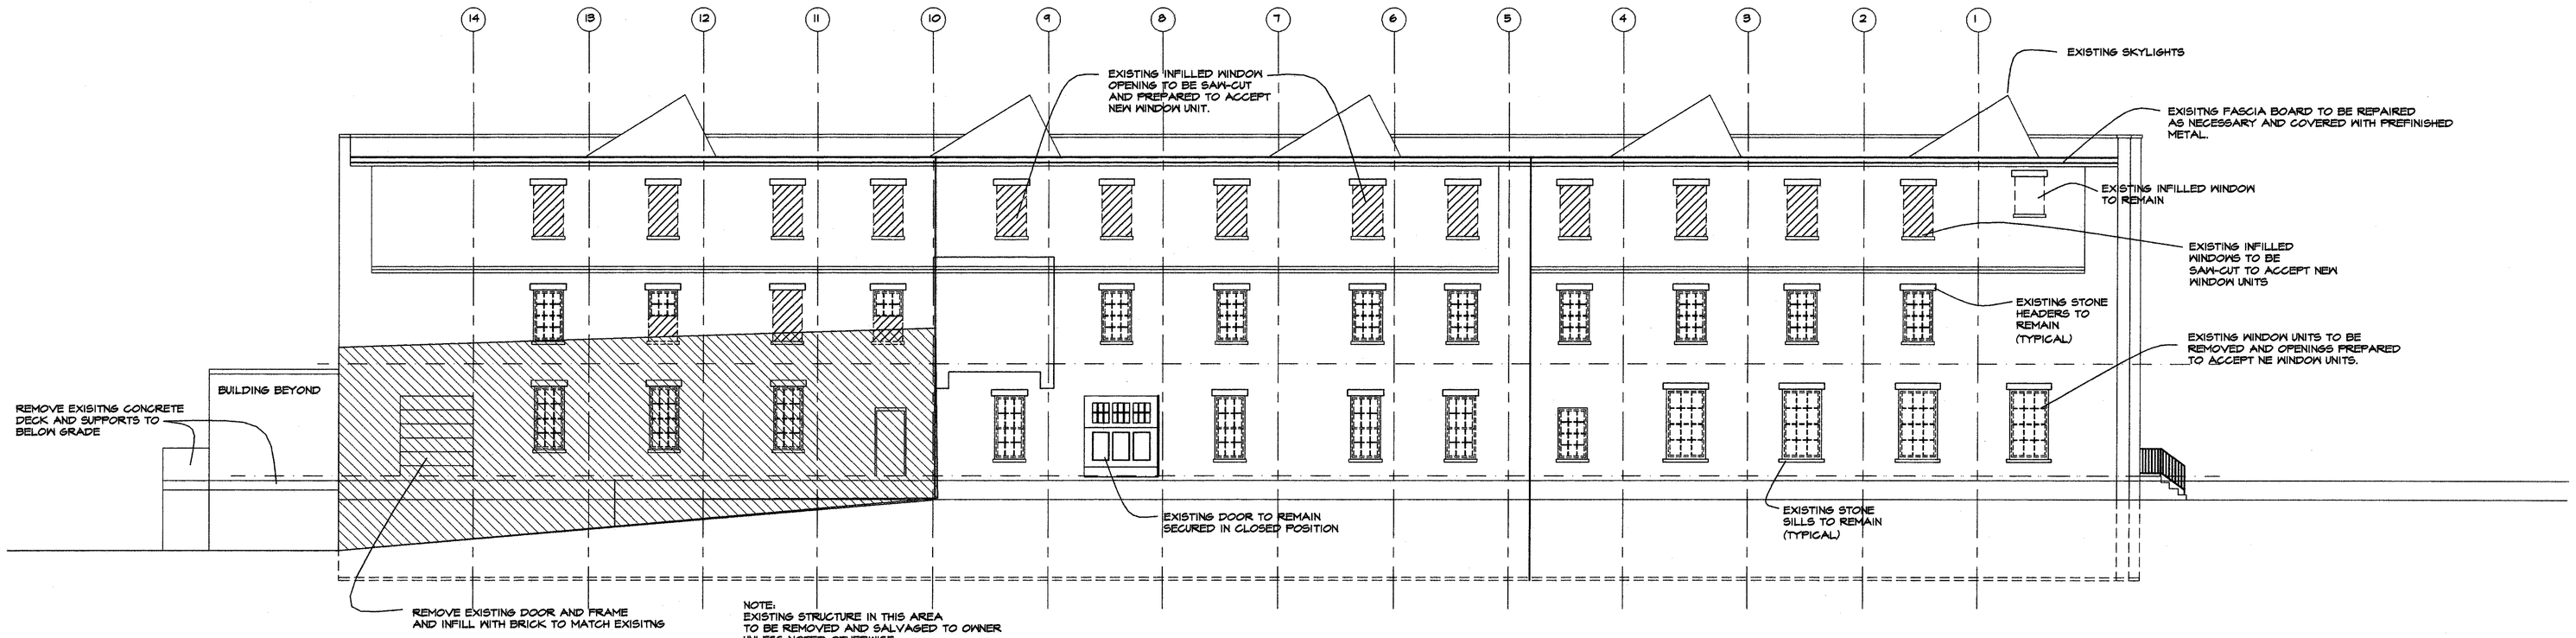

LEFT ELEVATION

SCALE: 1/8" = 1'-0"

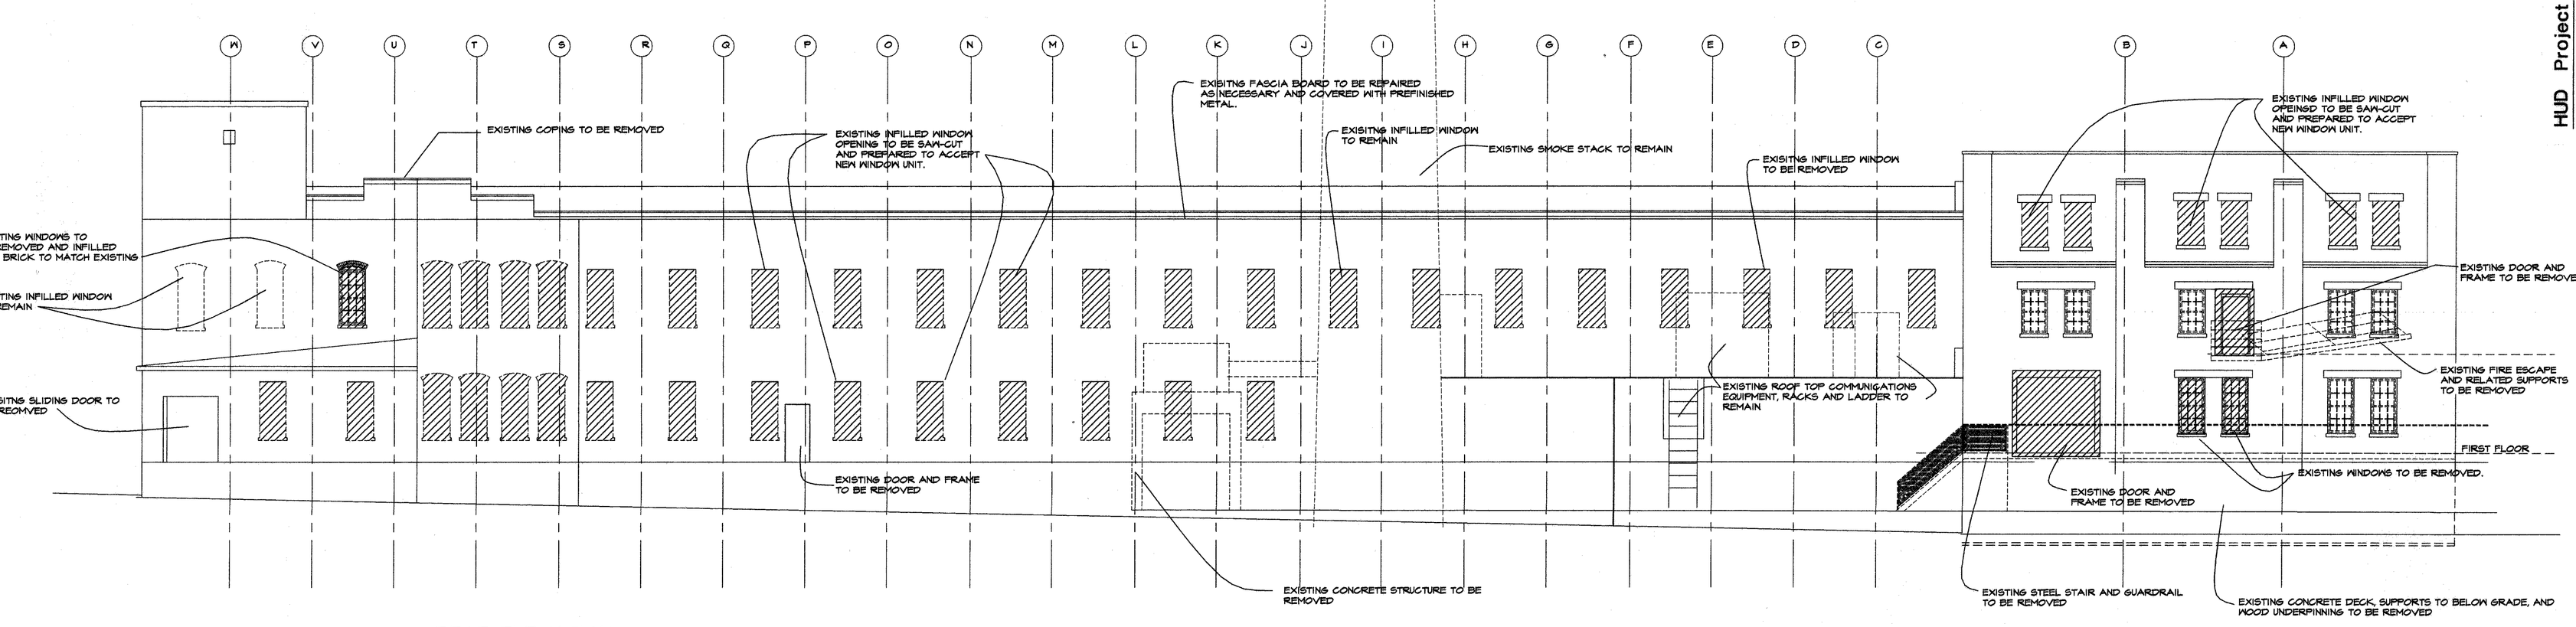

REAR ELEVATION

SCALE: 1/8" = 1'-0"

AS-BUILT DRAWING

MICHAEL L KNOLL
ARCHITECT
348 South Main Street
Versailles, Kentucky 40383
Phone: 859-873-1900
Email: Smicknoll@gte.net

HERRICK & ASSOCIATES
Consulting Engineers
LEXINGTON KY
859 271 0483
DESIGN – ENGINEERING
501 BROOKFARM COURT
LEXINGTON, KY 40511
O. DAVID PRESTON, P.E.

HUD Project No.

The McGoodwin Company
Commercial Real Estate

PROJECT:
LEXINGTON LOFTS
200 BOLIVAR STREET
LEXINGTON, KENTUCKY

DRAWING:
EXTERIOR ELEVATIONS

DATE: 9/05/02
DRAWN BY: MLK
REVISIONS:
10/1/02
1/10/03
8/25/04

SHEET NO.
A-7