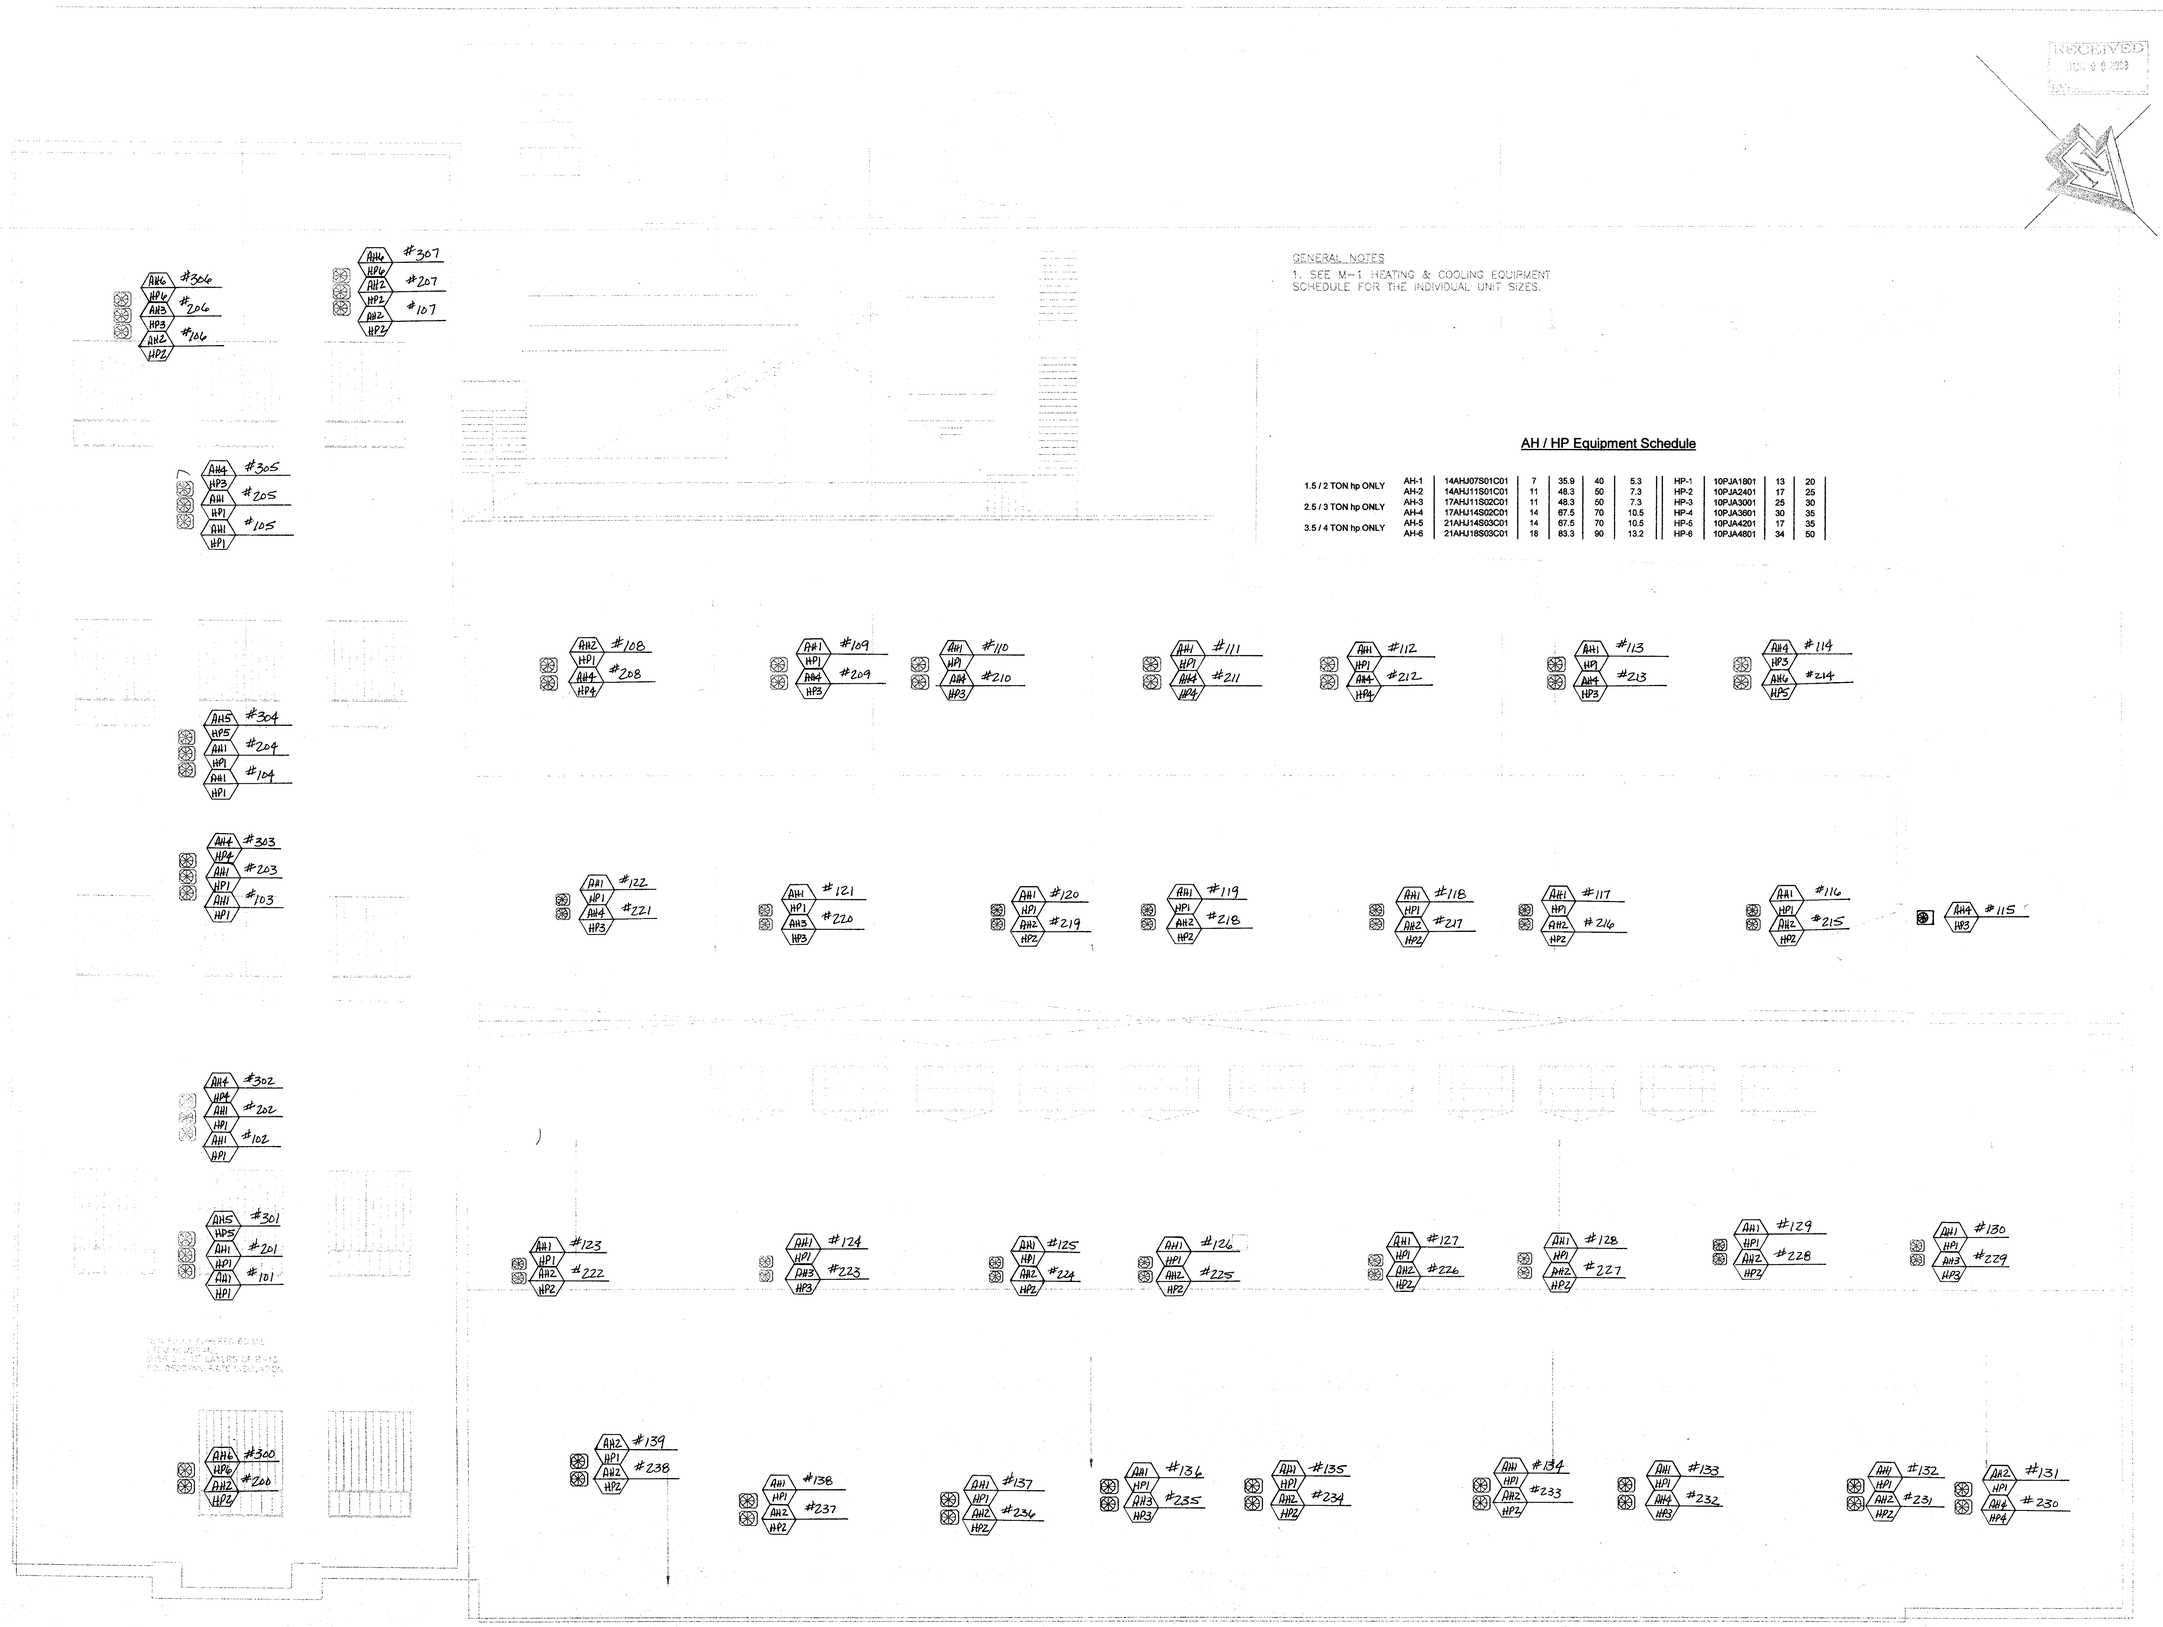

GENERAL NOTES

1. SEE M-1 HEATING & COOLING EQUIPMENT SCHEDULE FOR THE INDIVIDUAL UNIT SIZES.

AH / HP Equipment Schedule

1.5 / 2 TON hp ONLY	AH-1	14AHJ07S01C01	7	35.9	40	5.3	HP-1	10PJA1801	13	20
	AH-2	14AHJ11S01C01	11	48.3	50	7.3	HP-2	10PJA2401	17	25
2.5 / 3 TON hp ONLY	AH-3	17AHJ11S02C01	11	48.3	50	7.3	HP-3	10PJA3001	25	30
	AH-4	17AHJ14S02C01	14	67.5	70	10.5	HP-4	10PJA3601	30	35
3.5 / 4 TON hp ONLY	AH-5	21AHJ14S03C01	14	67.5	70	10.5	HP-5	10PJA4201	17	35
	AH-6	21AHJ18S03C01	18	83.3	90	13.2	HP-6	10PJA4801	34	50

AS-BUILT DRAWING

HVAC SECOND FLOOR

1/8" = 1' | M

RECEIVED

MICHAEL L. KNOLL
ARCHITECT
346 South Main Street
Versailles, Kentucky 40383
Phone: 859-873-1900

HERRICK & ASSOCIATES
859 271 0483
DESIGN-ENGINEERING
501 JRODKFARM COURT
LEXINGTON, KY 40517

The McGoodwin Company
Commercial Real Estate

PROJECT: McGOODWIN DEVELOPMENT
LEXINGTON LOFTS
200 BOLIVAR STREET
LEXINGTON, KENTUCKY

DRAWING: ROOF PLAN FOR HEAT PUMPS

DATE: 1/10/03
DRAWN BY: MLK
REVISIONS:

SHEET NO. M-5

Cab # 234 Slot C-1 Document # 34227