

MICHAEL L. KNOLL
ARCHITECT
346 South Main Street
Versailles, Kentucky 40383
Phone: 855-872-1000
Email: mknoll@tscnet.net

HBRICK & ASSOCIATES
Consulting Engineers
LEWINGTON KY
DESIGN-ENGINEERING
552 271 0483
501 BUCKHORN COURT, SUITE 107
O. DAVID PRESTON, P.E.


The McGoodwin Company
Commercial Real Estate

PROJECT:
MCGOODWIN DEVELOPMENT
LEXINGTON LOFTS
200 BOLIVAR STREET
LEXINGTON, KENTUCKY
DRAWING:
FIRST FLOOR SANITARY SEWER PLAN

DATE: 1/10/03
DRAWN BY: MLK
REVISIONS:

SHEET NO.
P-2

Doc # Slot Document #
234 C-1 24220

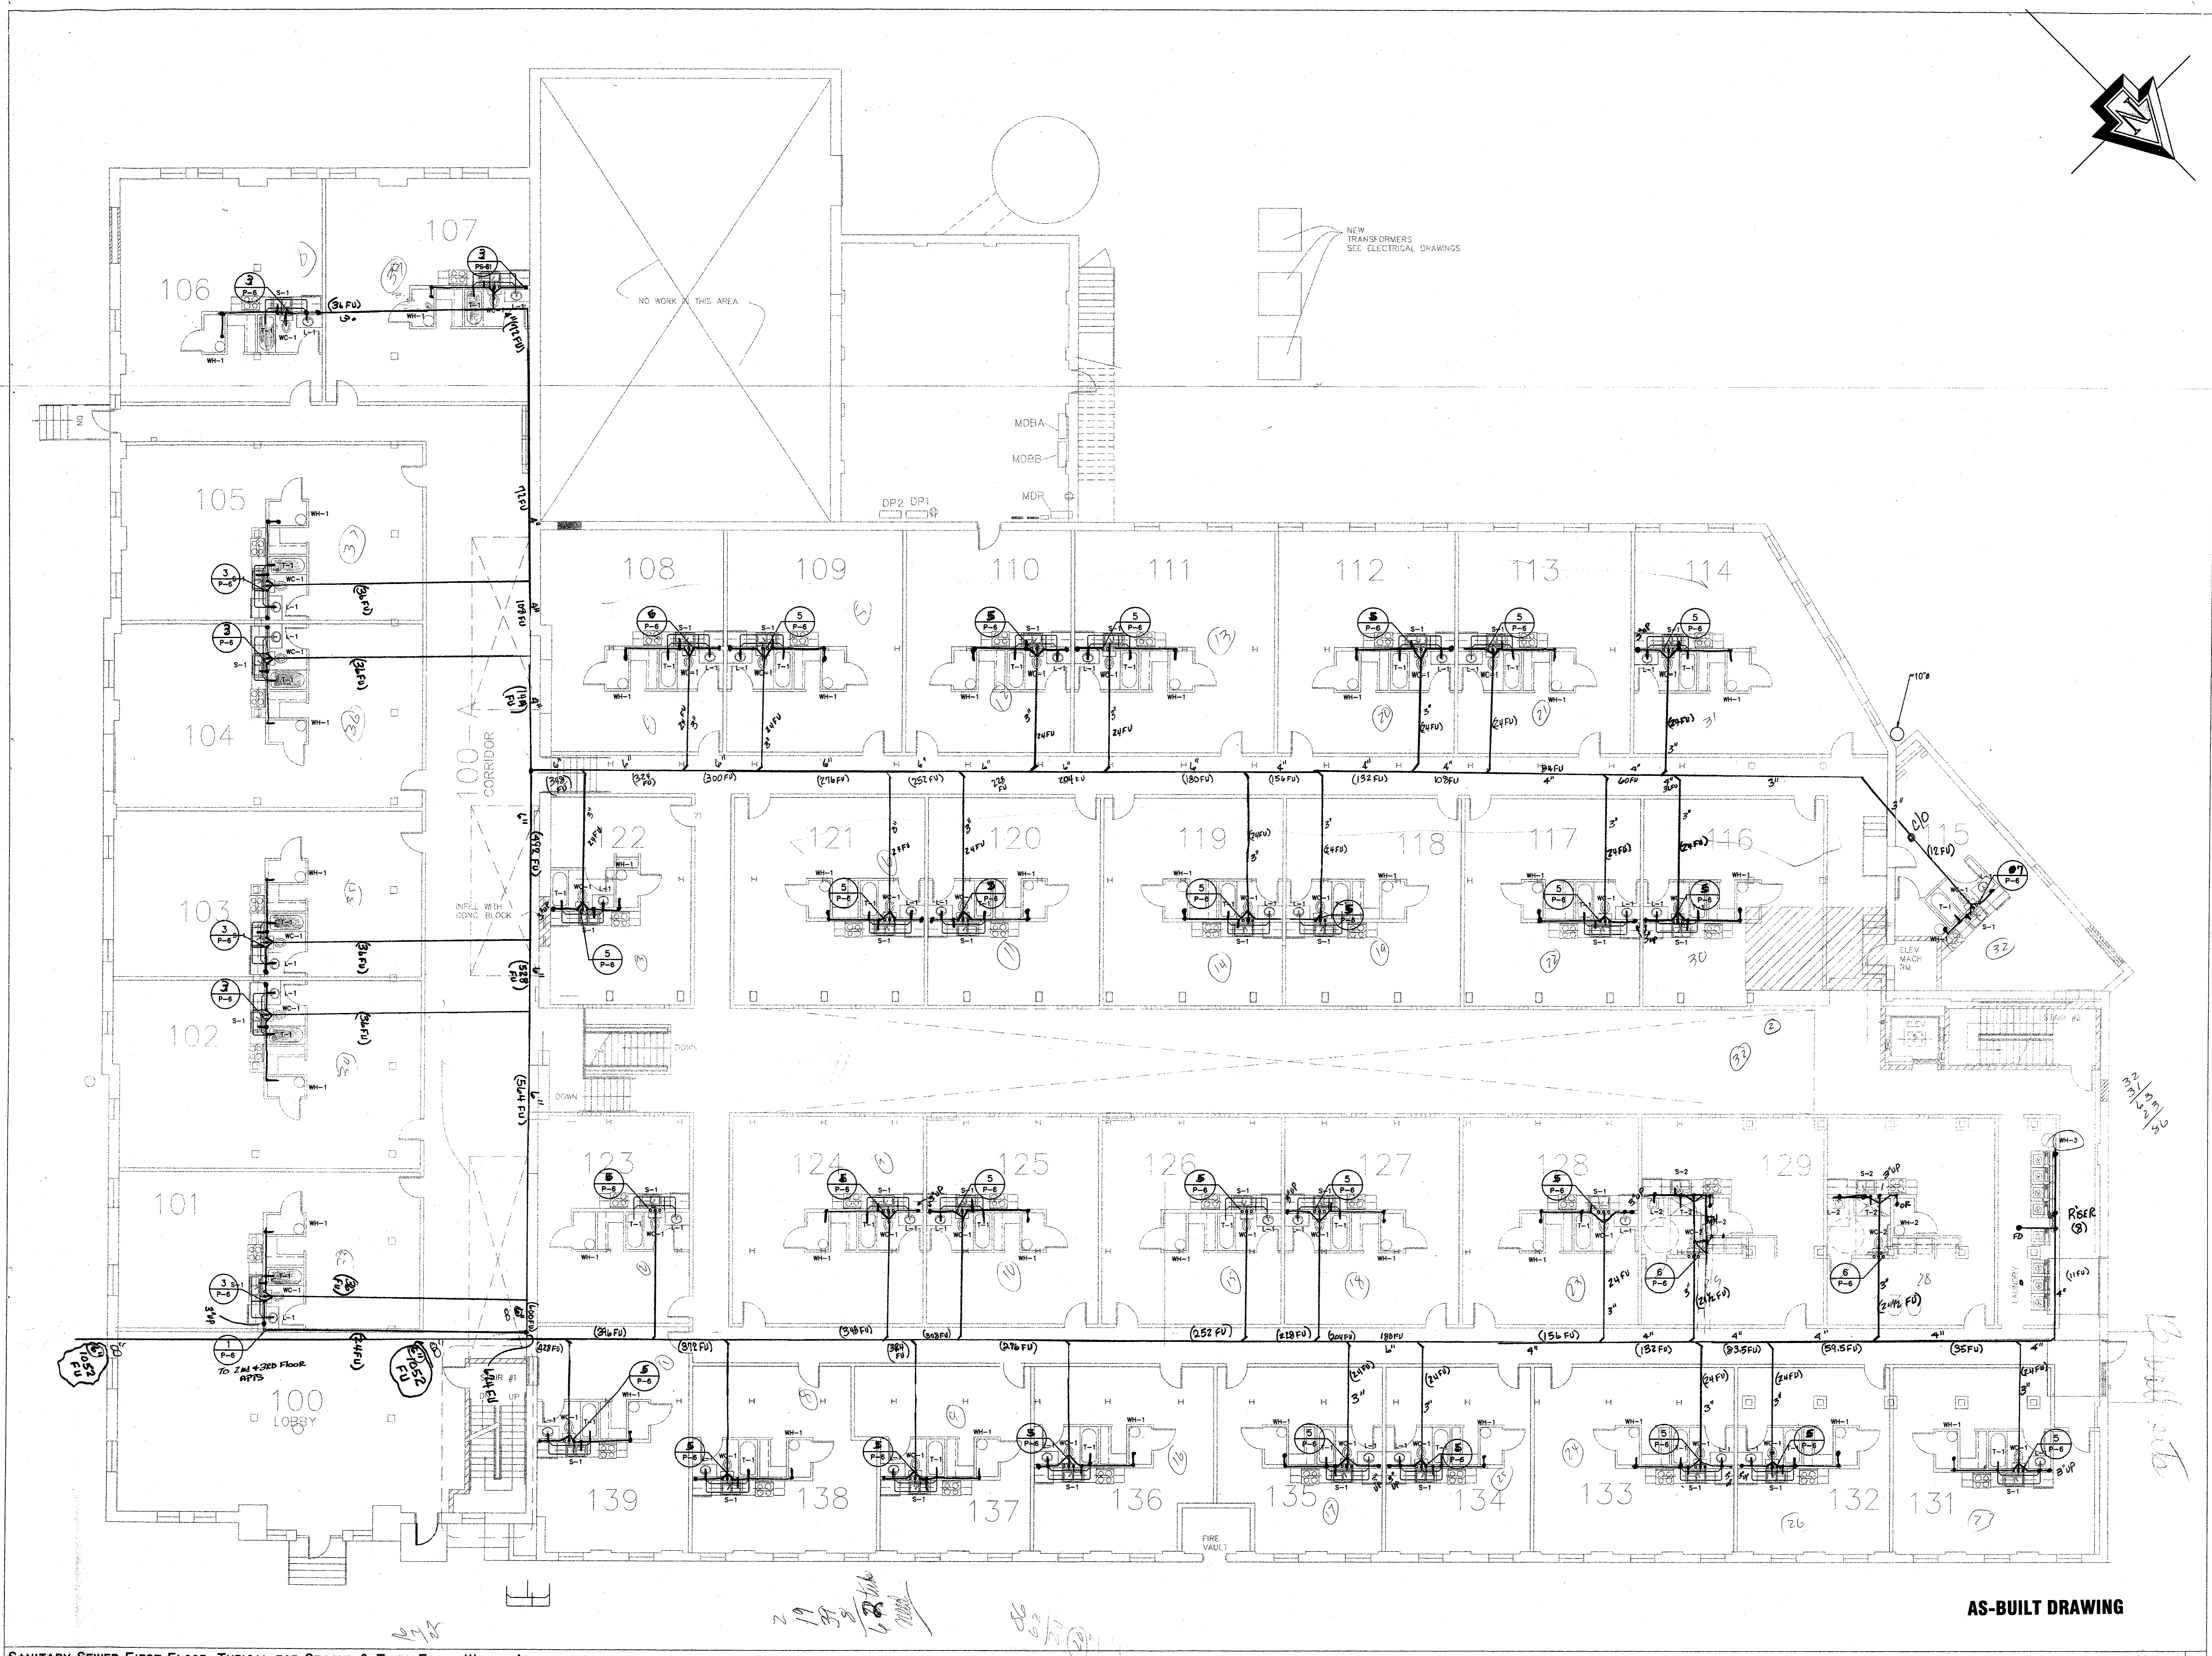

SANITARY SEWER FIRST FLOOR, TYPICAL FOR SECOND & THIRD FLOOR WHERE APPLICABLE

AS-BUILT DRAWING

1/8" = 1' S