GENERAL LANDSCAPE NOTES:

1. IT IS THE CONTRACTOR'S RESPONSIBILITY TO VERIFY ALL PLANT QUANTITIES. SHOULD THERE BE A DISCREPANCY BETWEEN THE PLANTING SCHEDULE AND THE GRAPHIC SYMBOLS, THE SYMBOLS SHALL TAKE PRECEDENCE.
2. LOCATE ALL EXISTING AND PROPOSED UTILITIES PRIOR TO BEGINNING WORK.
3. FINISH GRADE IS TOP OF MULCH WHERE APPLICABLE.
4. MULCH IS TO BE SHREDDED HARDWOOD, 3" DEEP.
5. MASSES OF PLANTS SHALL BE MULCHED IN CONTINUOUS BEDS FOR EASE OF MOWING. INDIVIDUAL TREES SHALL RECEIVE MULCH SAUCERS WITH A DIAMETER TWICE THAT OF THE ROOTBALL.
6. SEE SHEET SD-3 FOR PLANTING DETAILS.
7. SEE SHEET SD-4 FOR PLANTING SCHEDULE.

PLANTING SCHEDULE

KEY	BOTANICAL NAME	COMMON NAME	QUAN.	SIZE	HT.	COMMENTS
TREES						
AR	Acer rubrum 'Armstrong'	Columnar Red Maple	16	2½"cal	12-14'	B&B, well matched
GT	Gleditsia triacanthos inermis 'Shademaster'	Honey Locust	7	2½"cal	12-14'	B&B, well matched
SHRUBS						
JC	Juniperus chinensis 'Sea Green'	Chinese Juniper	20		24"	B&B, well matched, plant @ 4' o.c.
SB	Spiraea x bumalda 'Anthony Waterer'	Spirea	74		24"	Well mtchd hedge, plant @ 3' o.c.
VJ	Viburnum x juddii	Judd Viburnum	12		3'	Well mtchd hedge, plant @ 4' o.c.
TURF	Approved Fescue	Sod all disturbed areas unless planted in groundcover or shrub mass.				

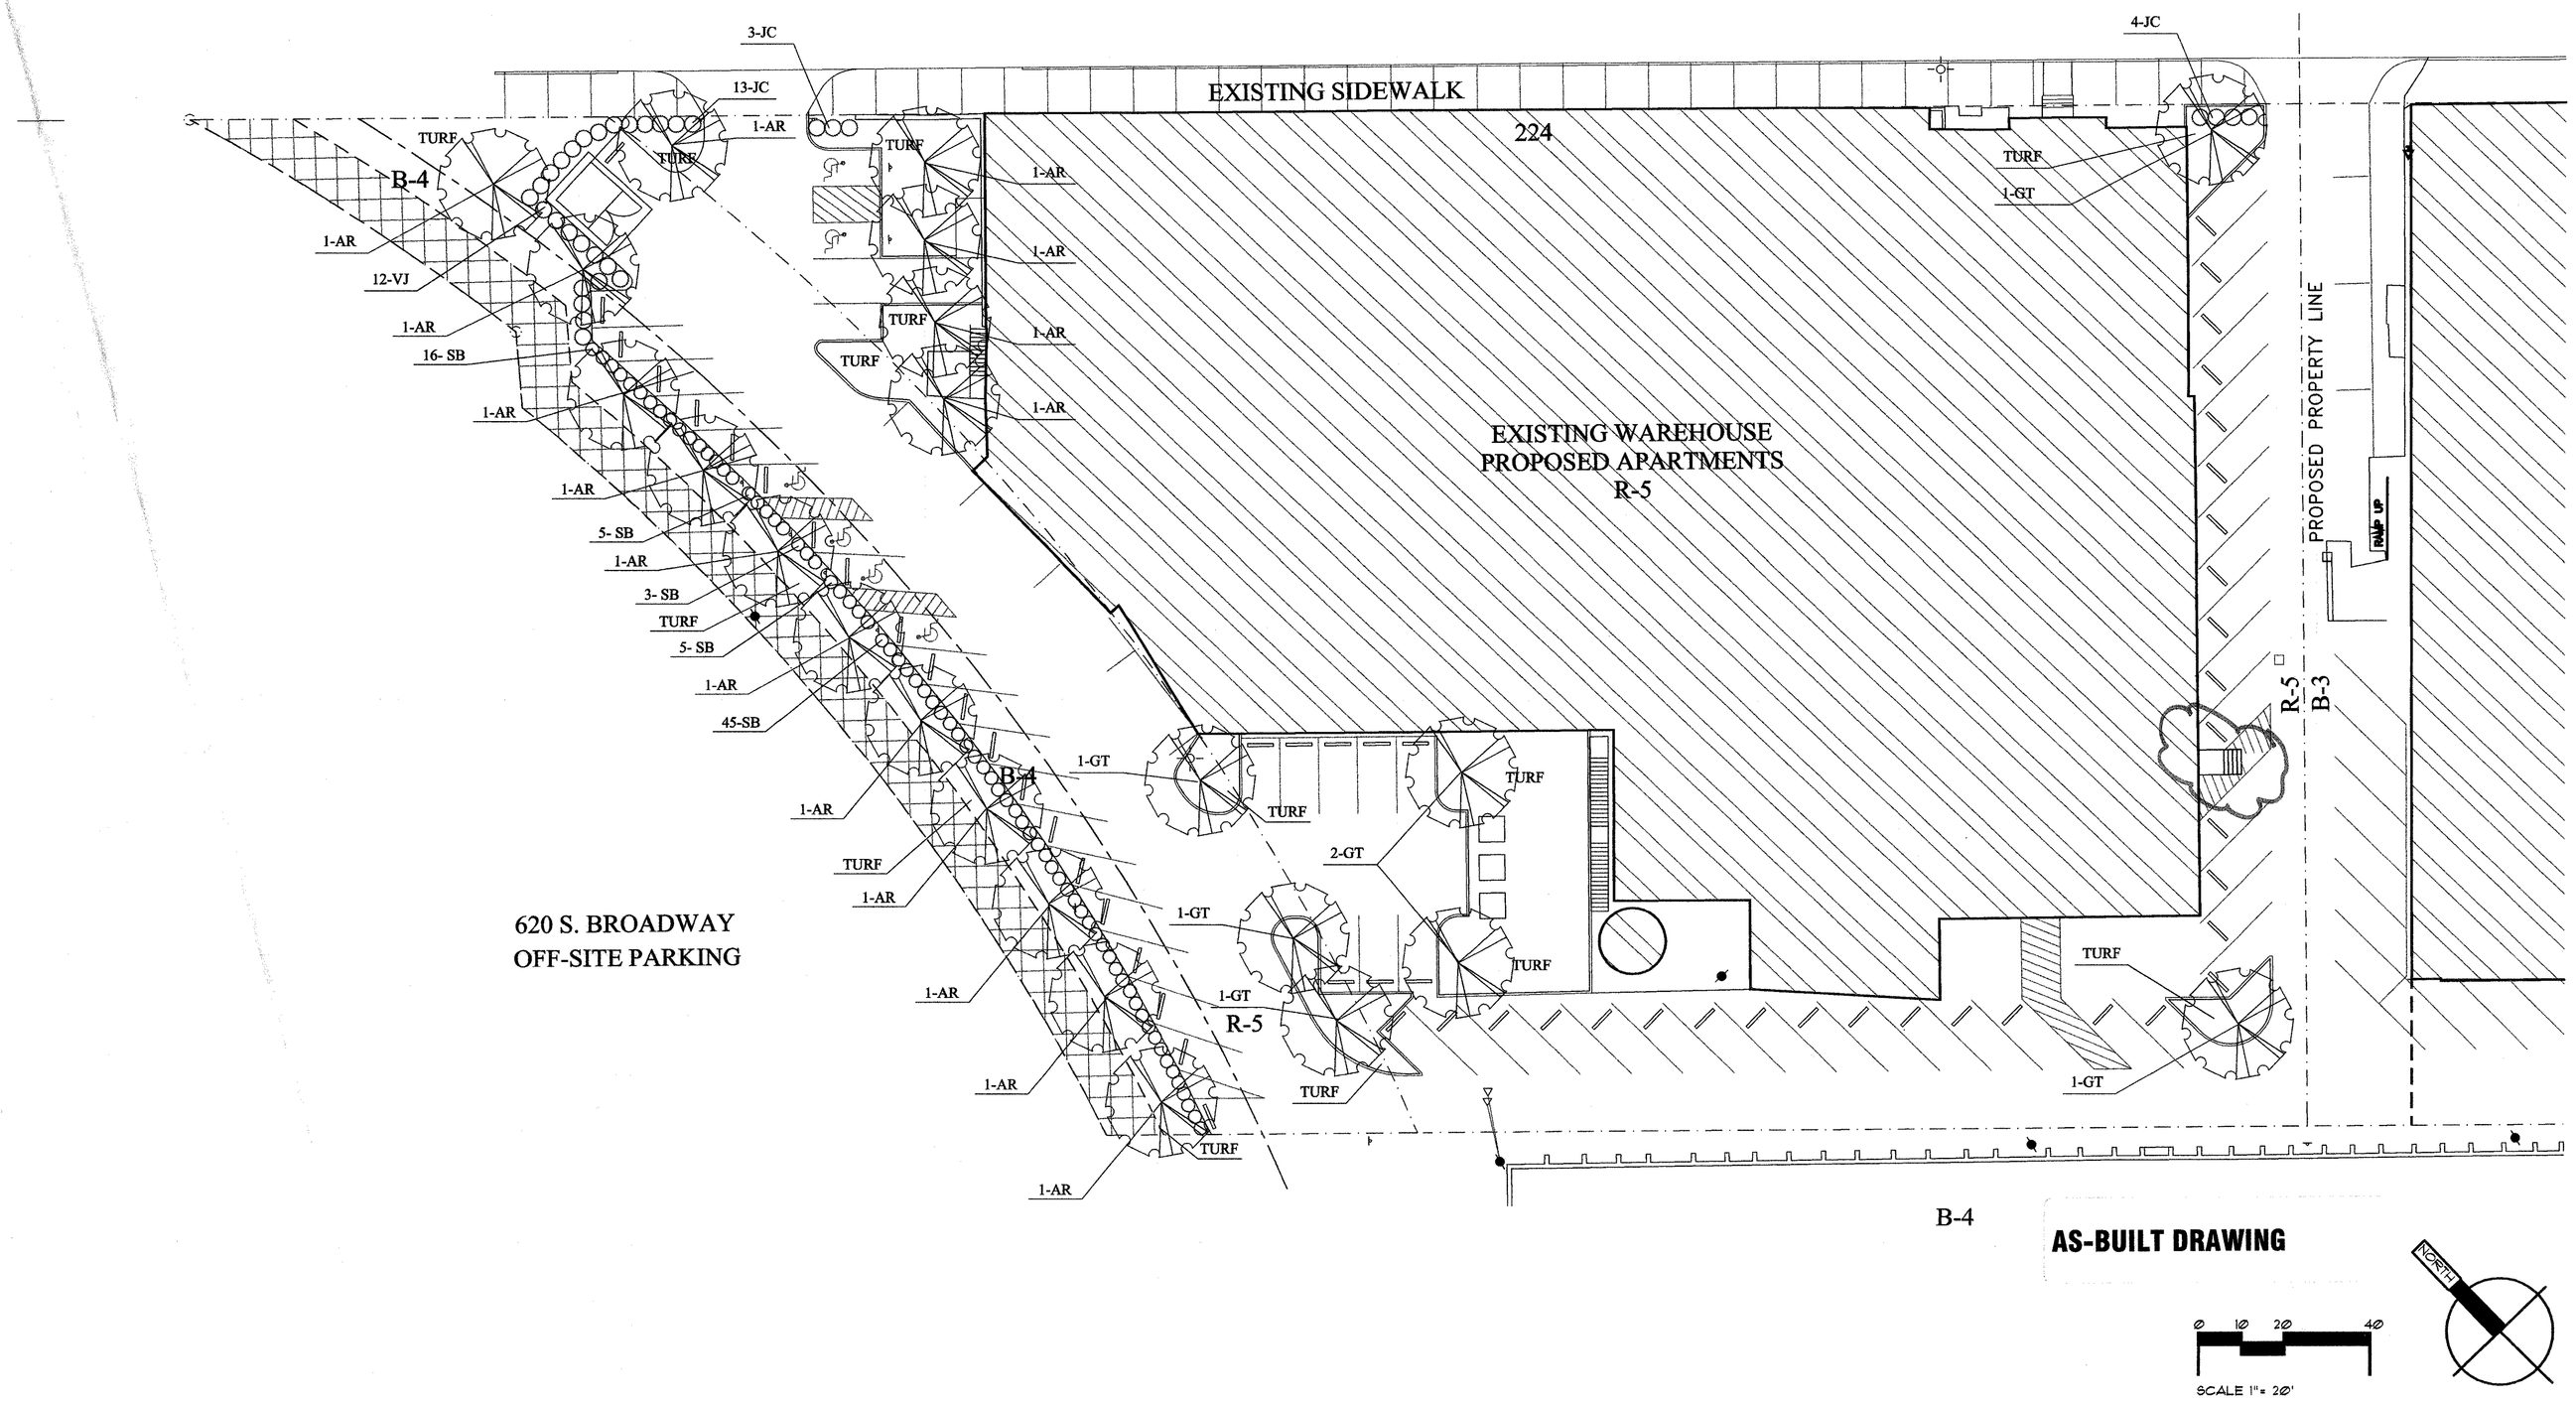

AS-BUILT DRAWING

FOR LOCATION OF UNDERGROUND UTILITIES, CALL B.U.D. 1-800-752-6007 2 WORKING DAYS IN ADVANCE OF DIGGING

LANDSCAPE PLAN

BOLIVAR DEVELOPMENT
200-224 & 245 Bolivar Street
Lexington, Kentucky

JOHN L. CARMAN & ASSOCIATES, INC.
310 Old East Vine Street
Lexington, Kentucky 40507 859/254-8803
Landscape Architecture • Planning • Site Engineering

DRAWN JD
DATE 10.28.02
CHECKED KWW
REVISED 1.9.03
1.13.03
JLC # 02-144

SHEET
SD-4