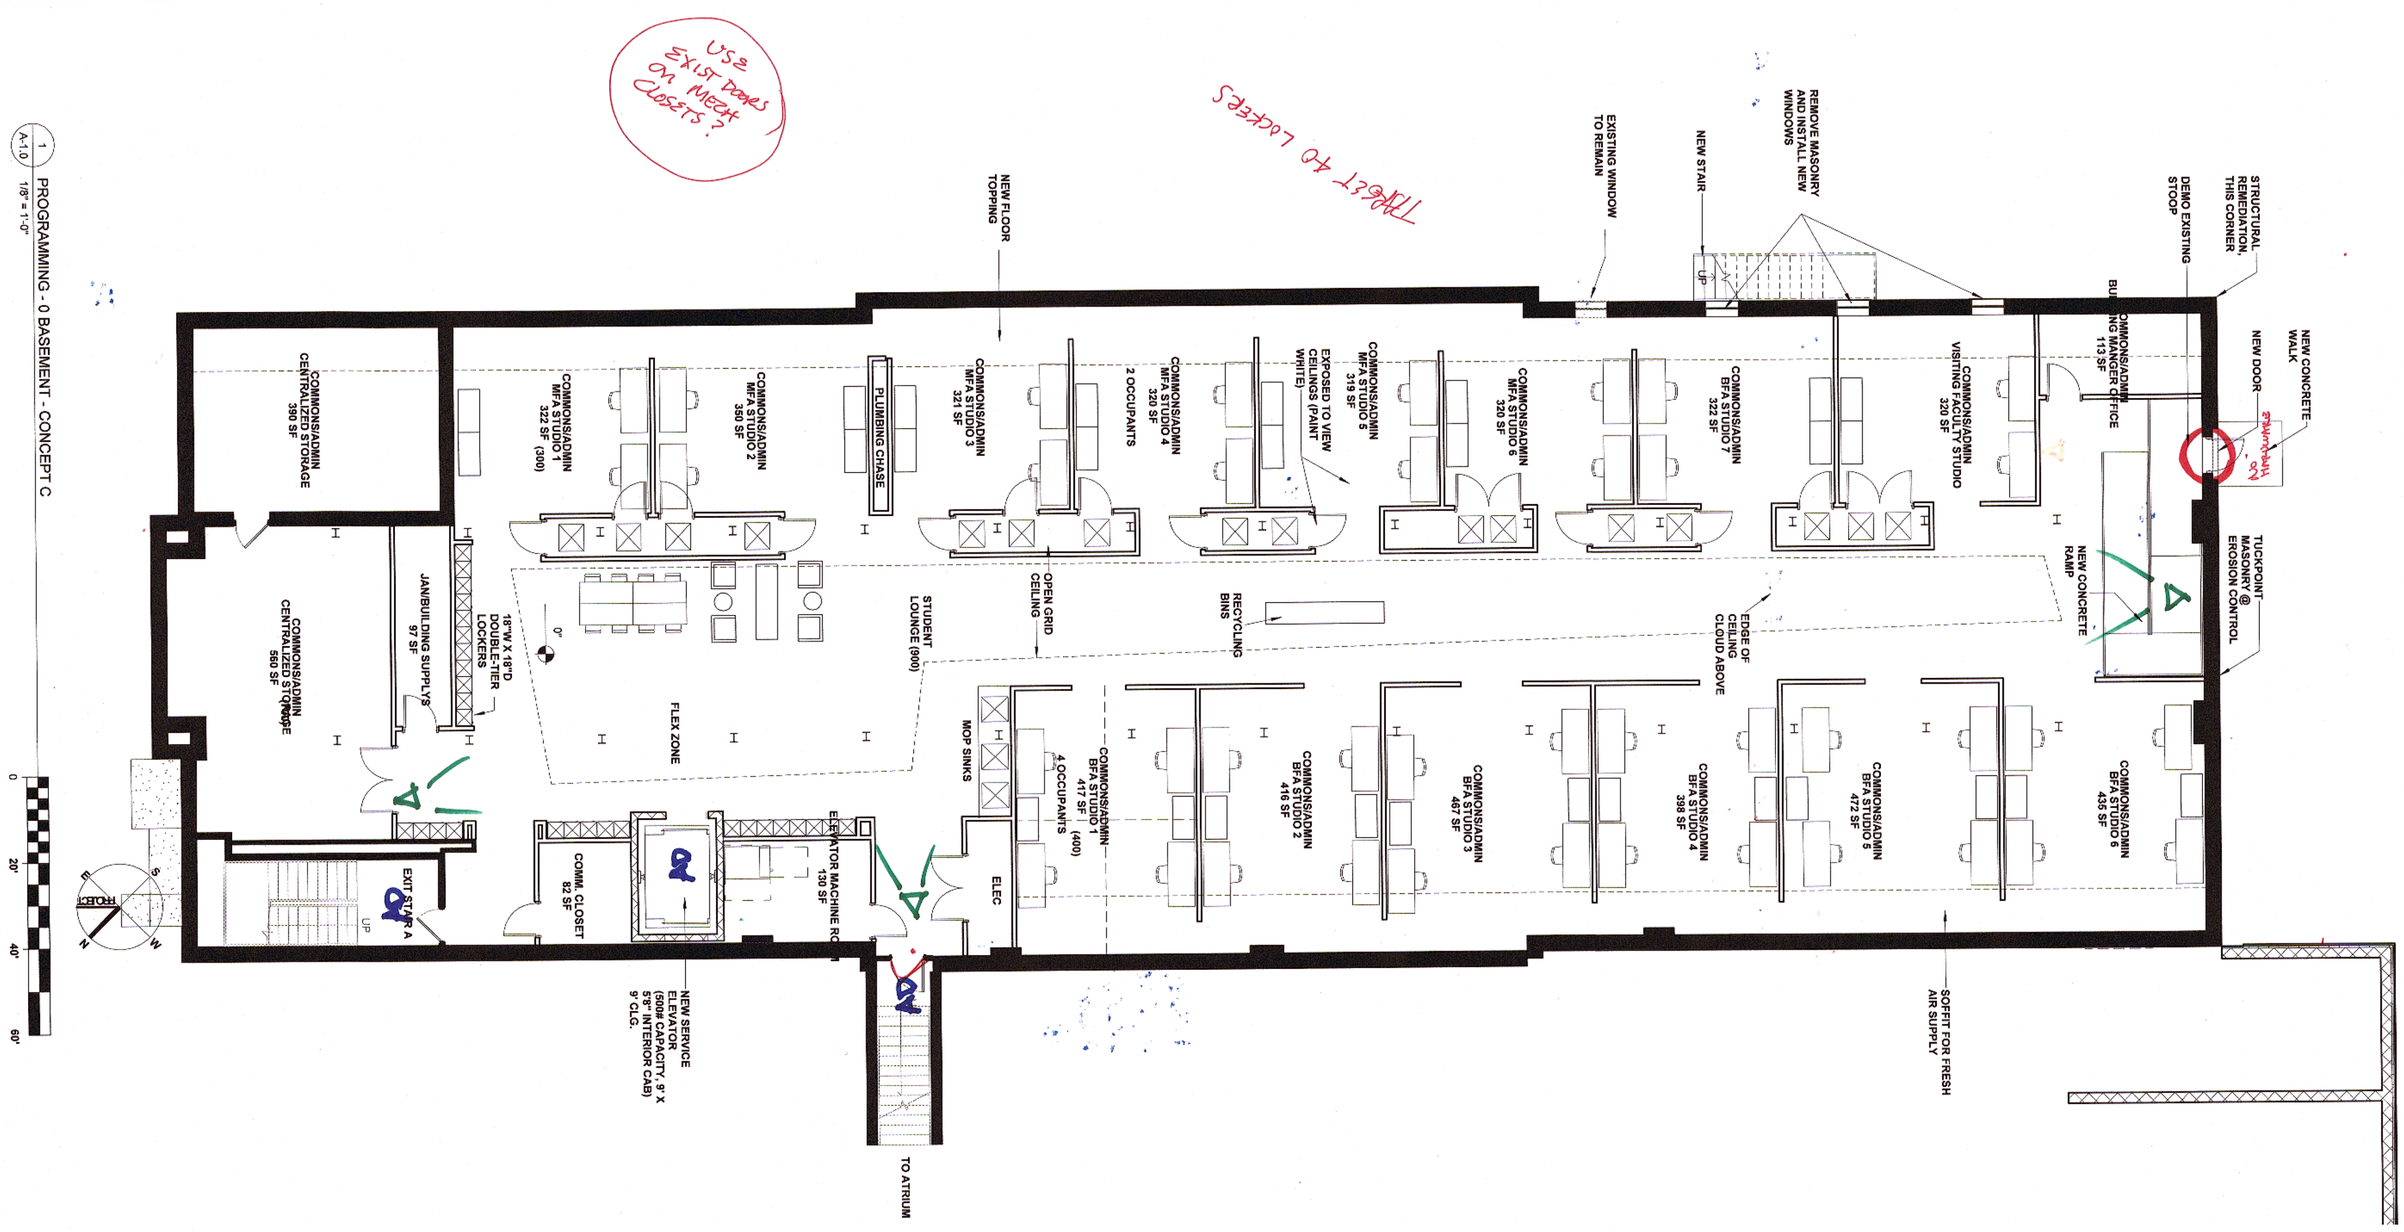

Net to Gross Comparison Basement

Number	Name	Level	Department	Area	Program Area
000F	ALCOVE	BASEMENT		72 SF	
000E	ALCOVE	BASEMENT		73 SF	
000D	ALCOVE	BASEMENT		103 SF	
0001	COMM. CLOSET	BASEMENT		82 SF	
0005	ELEC	BASEMENT		52 SF	
0003	ELEVATOR MACHINE ROOM	BASEMENT		130 SF	
STOOA	EXIT STAIR A	BASEMENT		185 SF	
0002	JANBUILDING SUPPLYS	BASEMENT		97 SF	
0016A	MECH	BASEMENT		50 SF	
0008A	MECH	BASEMENT		42 SF	
006A	MECH	BASEMENT		36 SF	
0012A	MECH	BASEMENT		21 SF	
0010A	MECH	BASEMENT		39 SF	
0018A	MECH	BASEMENT		20 SF	
0016B	MECH	BASEMENT		15 SF	
0020A	MECH	BASEMENT		31 SF	
0018B	MECH	BASEMENT		20 SF	
0013	BFA STUDIO 1	BASEMENT	COMMONS/ADMIN	417 SF	400
0015	BFA STUDIO 2	BASEMENT	COMMONS/ADMIN	416 SF	400
0017	BFA STUDIO 3	BASEMENT	COMMONS/ADMIN	467 SF	400
0019	BFA STUDIO 4	BASEMENT	COMMONS/ADMIN	398 SF	400
0021	BFA STUDIO 5	BASEMENT	COMMONS/ADMIN	472 SF	400
0023	BFA STUDIO 6	BASEMENT	COMMONS/ADMIN	435 SF	400
0018	BFA STUDIO 7	BASEMENT	COMMONS/ADMIN	322 SF	400
0022	BUILDING MANGER OFFICE	BASEMENT	COMMONS/ADMIN	113 SF	400
0004A	CENTRALIZED STORAGE	BASEMENT	COMMONS/ADMIN	390 SF	120
0004	CENTRALIZED STORAGE	BASEMENT	COMMONS/ADMIN	560 SF	700
0006	MFA STUDIO 1	BASEMENT	COMMONS/ADMIN	322 SF	300
0008	MFA STUDIO 2	BASEMENT	COMMONS/ADMIN	350 SF	300
0010	MFA STUDIO 3	BASEMENT	COMMONS/ADMIN	321 SF	300
0012	MFA STUDIO 4	BASEMENT	COMMONS/ADMIN	320 SF	300
0014	MFA STUDIO 5	BASEMENT	COMMONS/ADMIN	319 SF	300
0016	MFA STUDIO 6	BASEMENT	COMMONS/ADMIN	320 SF	300
0020	VISITING FACULTY STUDIO	BASEMENT	COMMONS/ADMIN	320 SF	300

UNIVERSITY LOFTS - Renovate Academic Facility UK School of Art & Visual Studies

Basement Plan

NOT FOR CONSTRUCTION Job Number: 1205 Date: 02/13/2013 Drawn By: MJ Checked By: EZ Revision:

A-1.0

DESIGN DEVELOPMENT

Omni ARCHITECTS
212 North Upper Street
Lexington, Kentucky 40507-1001
p 859.252.6664 f 859.253.2358
www.omniarchitects.com

This Drawing and the Design shown thereon are the property of Omni Architects. The reproduction, copying or other use of this Drawing or Design without the written consent of Omni Architects is prohibited.