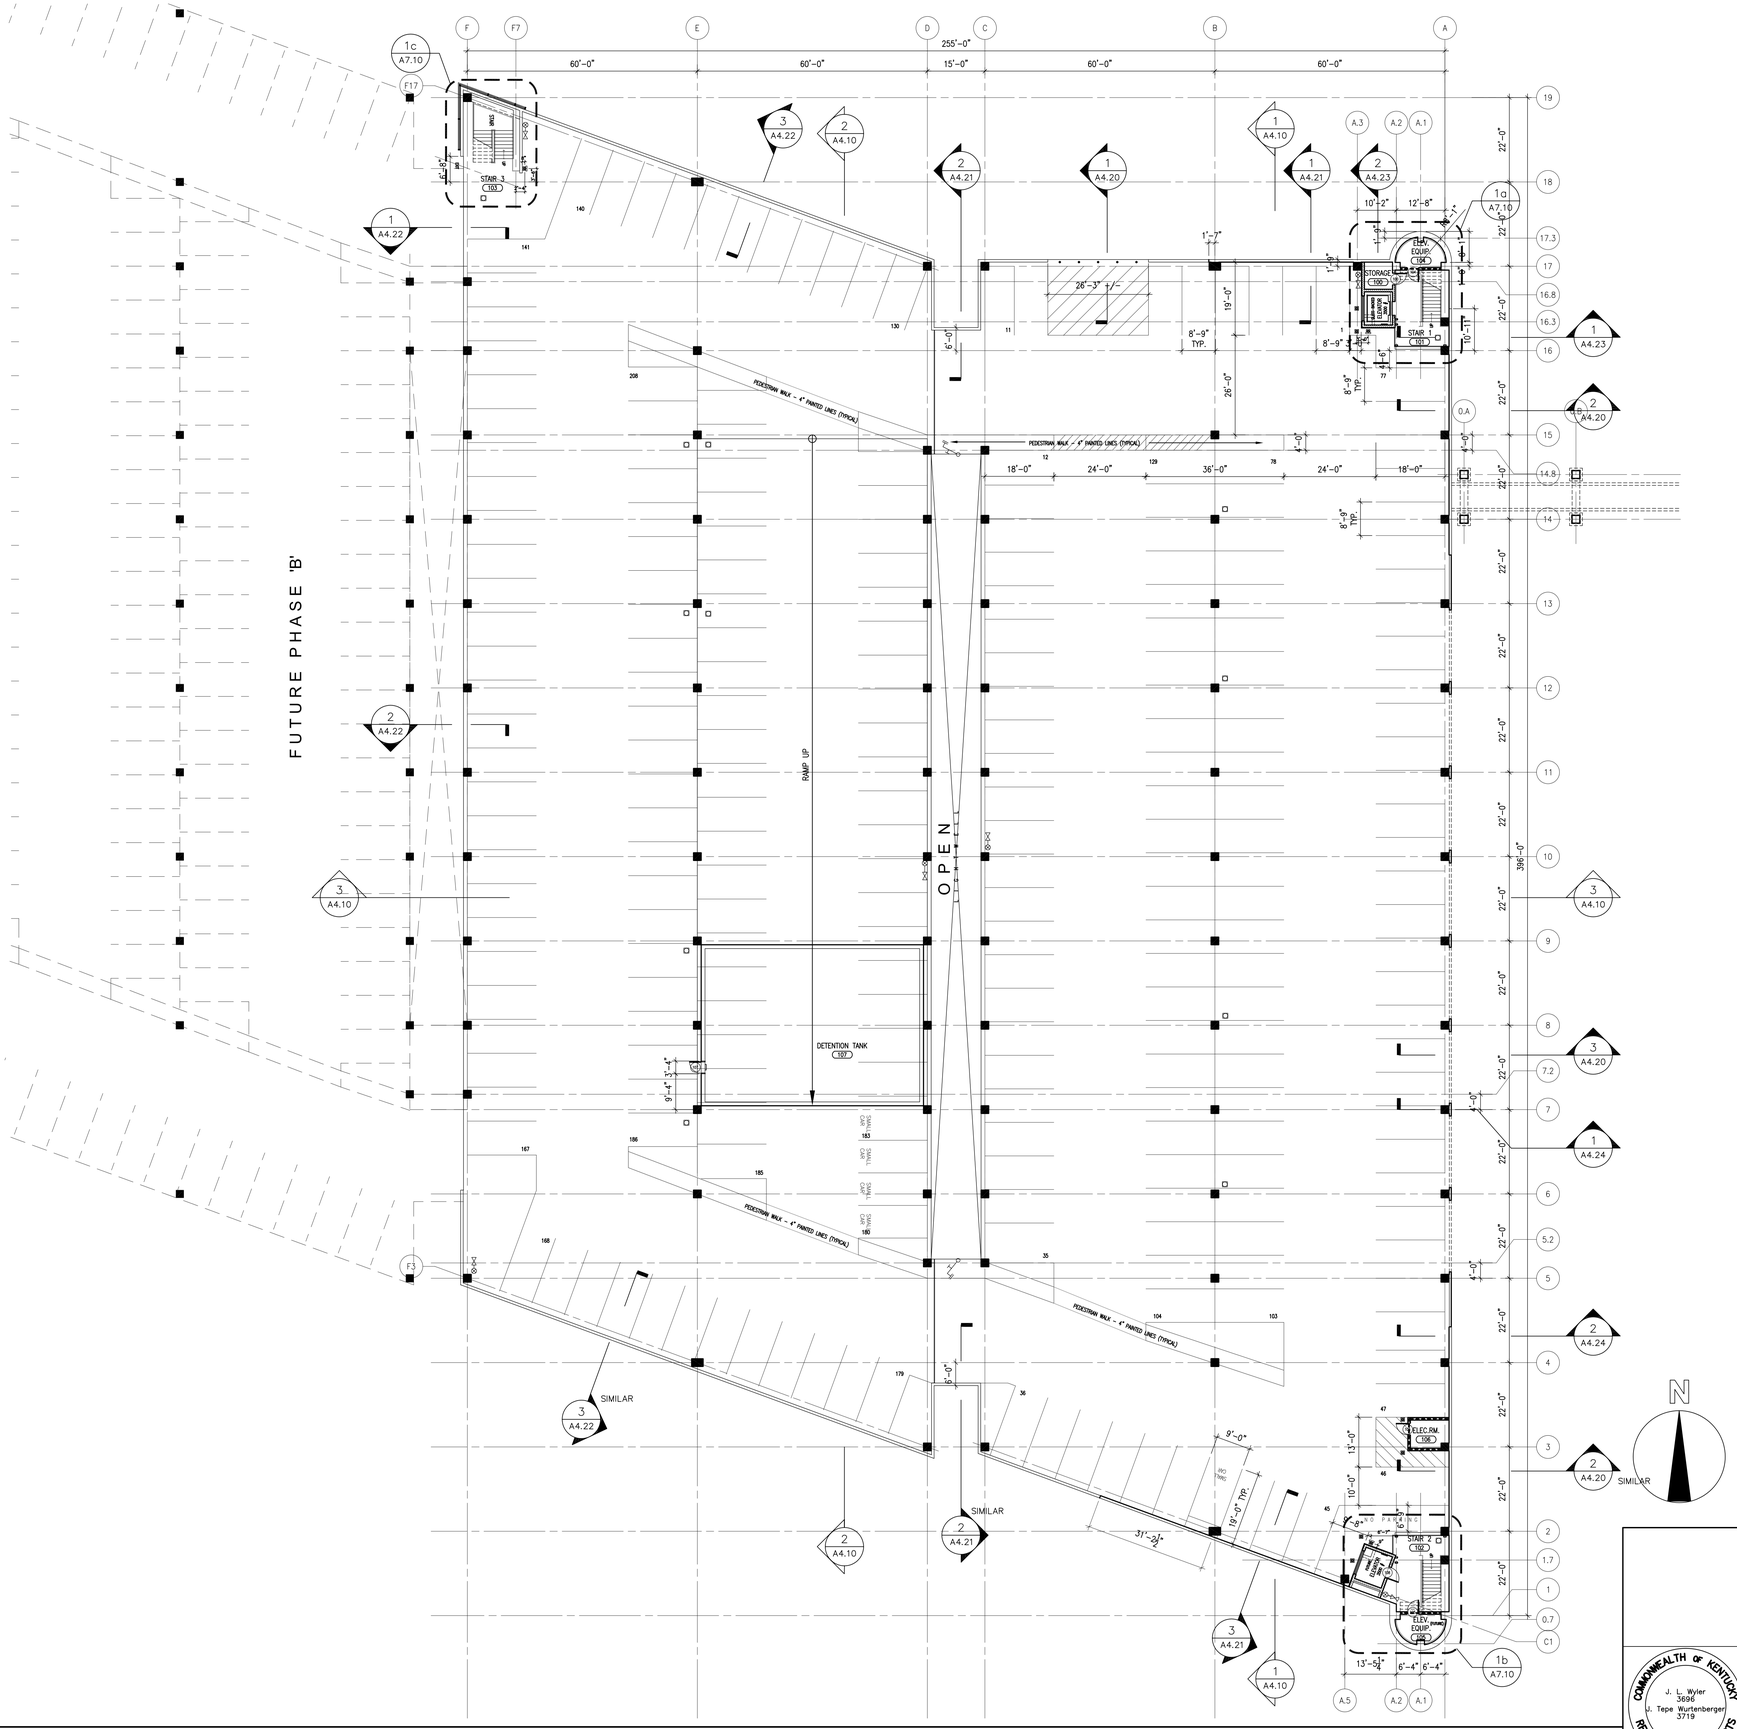

GENERAL NOTES:

1. PROTECT EXISTING AREAS TO REMAIN FROM DAMAGE AS A RESULT OF THIS CONTRACT.
2. REPAIR ITEMS DAMAGED BY THIS CONTRACT WHICH ARE SCHEDULED TO REMAIN.
3. CONTRACTOR SHALL REPORT DISCREPANCIES OF CONDITIONS SHOWN TO ARCHITECT FOR DIRECTION.
4. PROVIDE TEMPORARY BARRIERS FOR SECURITY.
5. PROVIDE TEMPORARY PROTECTION FROM THE WEATHER.
6. CONTRACTOR SHALL VISIT THE SITE TO VERIFY EXISTING CONDITIONS AND SHALL REPORT DISCREPANCIES TO THE ARCHITECT.
7. REFER TO MECHANICAL, ELECTRICAL AND PLUMBING FLOOR PLANS FOR EXACT LOCATION AND NUMBER OF FLOOR PENETRATIONS.

BID PACKAGE	ISSUED	BID PACKAGE	ISSUED

	REVISIONS	DATE
1	RECORD DRAWINGS	6/20/05
2		
3		
4		
5		
6		
7		
8		

COMMONWEALTH OF KENTUCKY
J. L. Wyler 3696
J. Tepe Wurtenberger 3719
REGISTERED ARCHITECTS

PARKING GARAGE No. 2
NORTHERN KENTUCKY UNIVERSITY
HIGHLAND HEIGHTS, KENTUCKY

RECORD DATE

LEVEL ONE PLAN

DRAWING NO. **A2.10**

DRAWN BY: JC
CHECKED BY: RKS

COMMONWEALTH OF KENTUCKY
FINANCE AND ADMINISTRATION CABINET
DEPARTMENT FOR FACILITIES MANAGEMENT
DIVISION OF ENGINEERING
FRANKFORT, KENTUCKY

A&E FILE NO. 2890-00
SCALE: AS NOTED
DATE: 10/30/2003

Champlin/Haupt Inc.
Architects
202 Farmington Drive, ste. 101
Lakeside Park, Kentucky 41017
Tel (859) 331-5995
Fax (859) 331-5996

REVIEWED DIV. OF ENGR.
FOR INTENT ONLY
ENGR. FILE NO. PNKU0590

AGENCY AUTHORIZED AGENT: APPROVED FOR PROGRAM CONCEPT ONLY — DATE
DIVISION OF ENGINEERING: APPROVED FOR PROGRAM CONCEPT ONLY — DATE

J:\417\2890-00 Parking Garage\phase d\drawings\A2-10 A2-11 A2-12.dwg jan 05, 2006-3:30pm - (C) Champlin/Haupt - ope