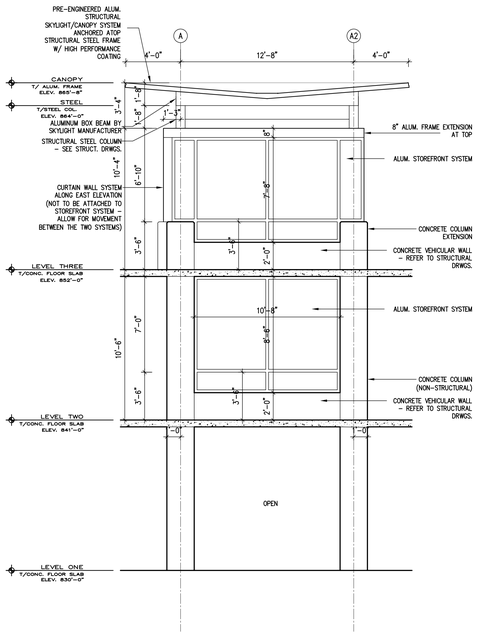

2 / A7.22 **S T A I R #2 - NORTH ELEVATION** 1/4" = 1'-0"

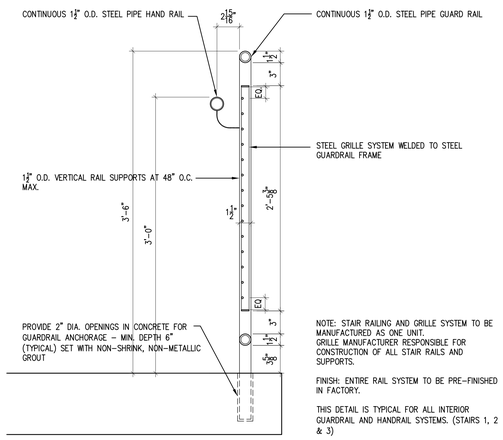

NOTE: STAIR RAILING AND GRILLE SYSTEM TO BE MANUFACTURED AS ONE UNIT. GRILLE MANUFACTURER RESPONSIBLE FOR CONSTRUCTION OF ALL STAIR RAILS AND SUPPORTS.

FINISH: ENTIRE RAIL SYSTEM TO BE PRE-FINISHED IN FACTORY.

THIS DETAIL IS TYPICAL FOR ALL INTERIOR GUARDRAIL AND HANDRAIL SYSTEMS. (STAIRS 1, 2 & 3)

3 / A7.22 **TYPICAL INTERIOR STAIR RAILING** 1-1/2" = 1'-0"

4 / A7.22 **NOT USED**

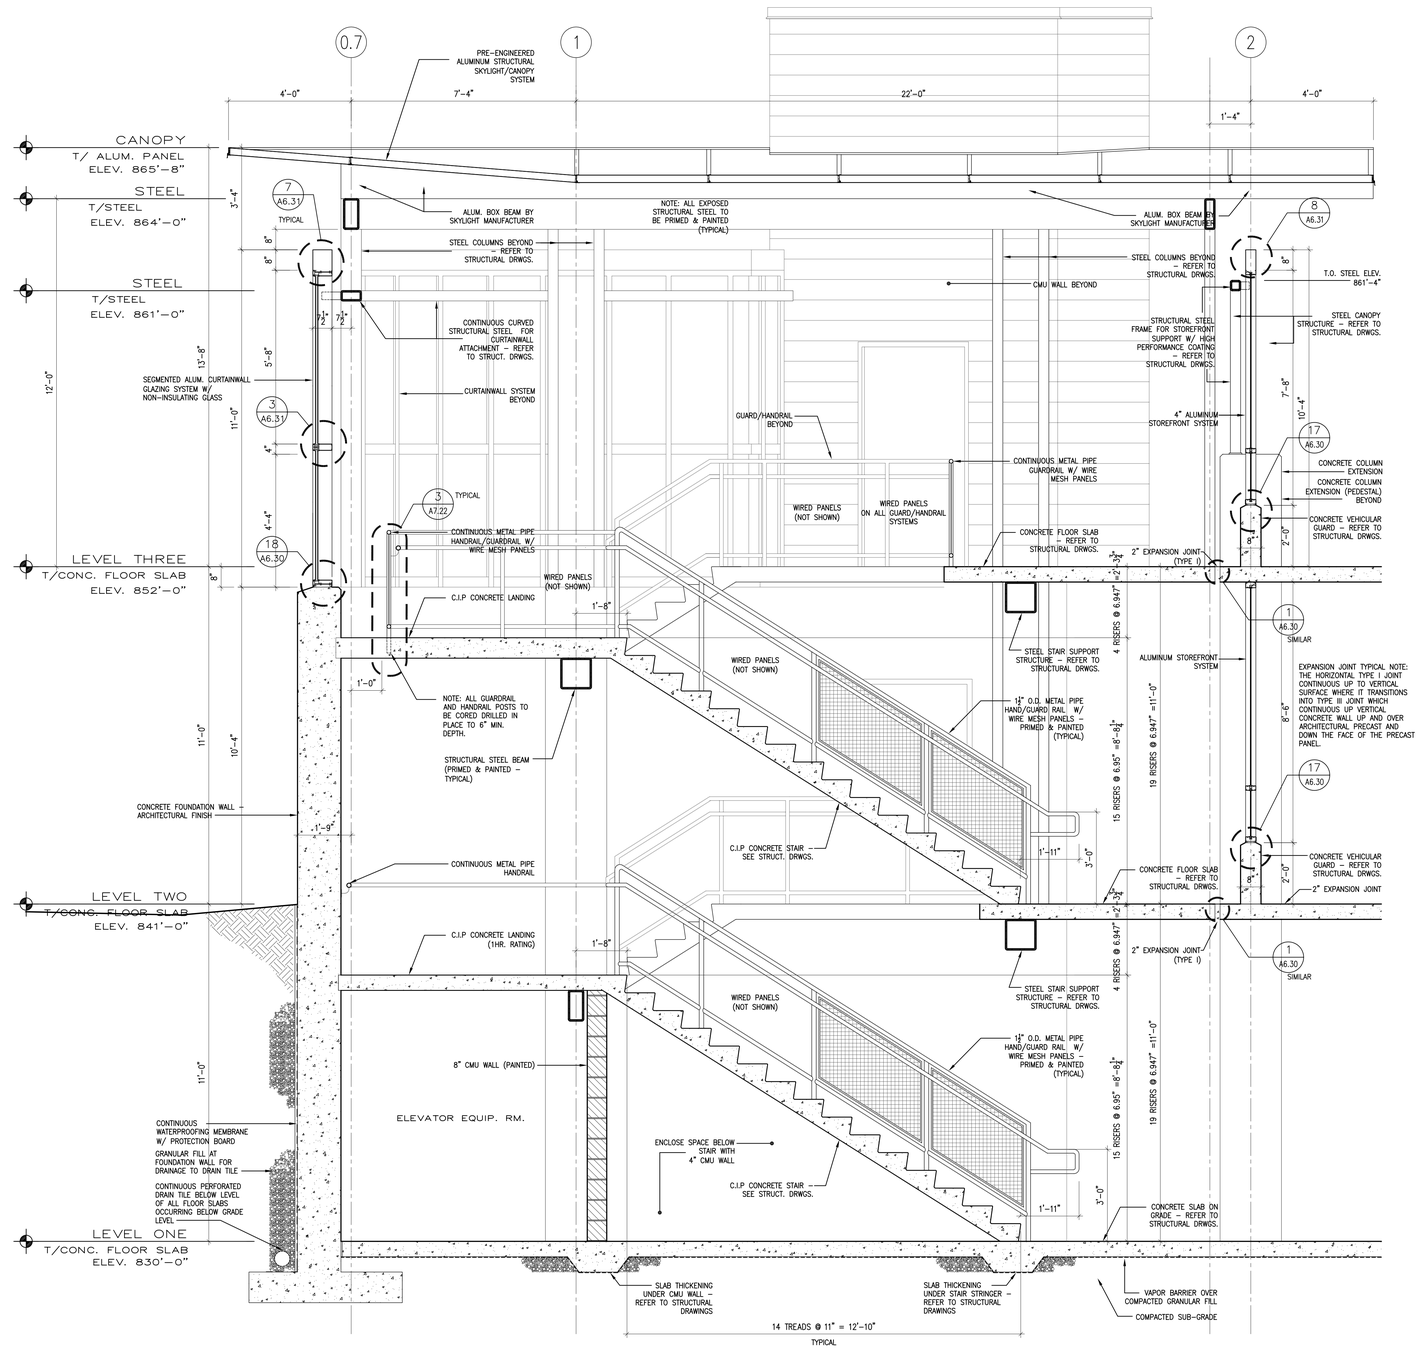

1 / A7.22 **S T A I R #2 S E C T I O N** 1/2" = 1'-0"

BID PACKAGE	ISSUED	BID PACKAGE	ISSUED

	REVISIONS	DATE
1	RECORD DRAWINGS	6/20/05
2		
3		
4		
5		
6		
7		
8		

COMMONWEALTH OF KENTUCKY
J. L. Wyler 3696
J. Tepe Wurtenberger 3719
REGISTERED ARCHITECTS

PARKING GARAGE No. 2
NORTHERN KENTUCKY UNIVERSITY
HIGHLAND HEIGHTS, KENTUCKY

RECORD DATE
DRAWN BY AE
CHECKED BY RAS
A&E FILE NO. 2002-00
SCALE AS NOTED
DATE 10/30/2003

STAIR #2 SECTION

COMMONWEALTH OF KENTUCKY
FINANCE AND ADMINISTRATION CABINET
DEPARTMENT FOR FACILITIES MANAGEMENT
DIVISION OF ENGINEERING
FRANKFORT, KENTUCKY

DRAWING NO. **A7.22**

Champlin/Haupt Inc.
Architects
202 Farmington Drive, ste. 101
Lakeside Park, Kentucky 41017
Tel (859) 331-5995
Fax (859) 331-5996

REVIEWED DIV. OF ENGR.
FOR INTENT ONLY
ENGR. FILE NO. PNKU0590

AGENCY AUTHORIZED AGENT _____ DATE _____
APPROVED FOR PROGRAM CONCEPT ONLY

DIVISION OF ENGINEERING _____ DATE _____
APPROVED FOR PROGRAM CONCEPT ONLY

J:\4171.2890-00 Parking Garage\phase d\drawings\A7-21 22 & 23.dwg Jun 05, 2006-4:12pm - (C) Champlin/Haupt - ape